


**AS BUILT**

**SP Design & Build Inc.**  
Consultant Engineers  
11500 N. Stemmons Freeway, Suite 138 Dallas, TX 75229  
Email: spham@spdb.net  
Tel. 972-241-4016  
Fax. 972-241-4018

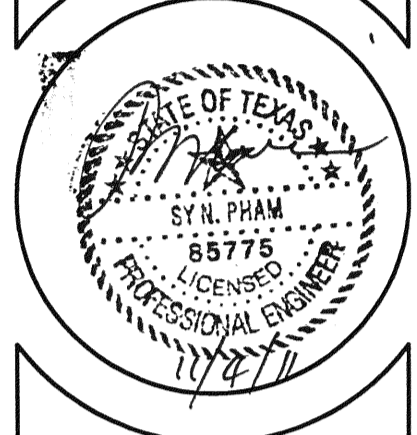

**205 PLAZA**  
2309 2319 S. GOLIAD  
ROCKWALL, TEXAS 75087

**PAVING PLAN**  
REVISIONS:  
1. 07-27-10 PER CITY & RACETRAC COOR.  
2. 08-02-10 PER CITY COMMENTS  
3. 09-28-11 AS BUILT

SHEET:  
**C4**  
JOB NO. 0710