



3 RETAINING WALL DETAIL
N.T.S.

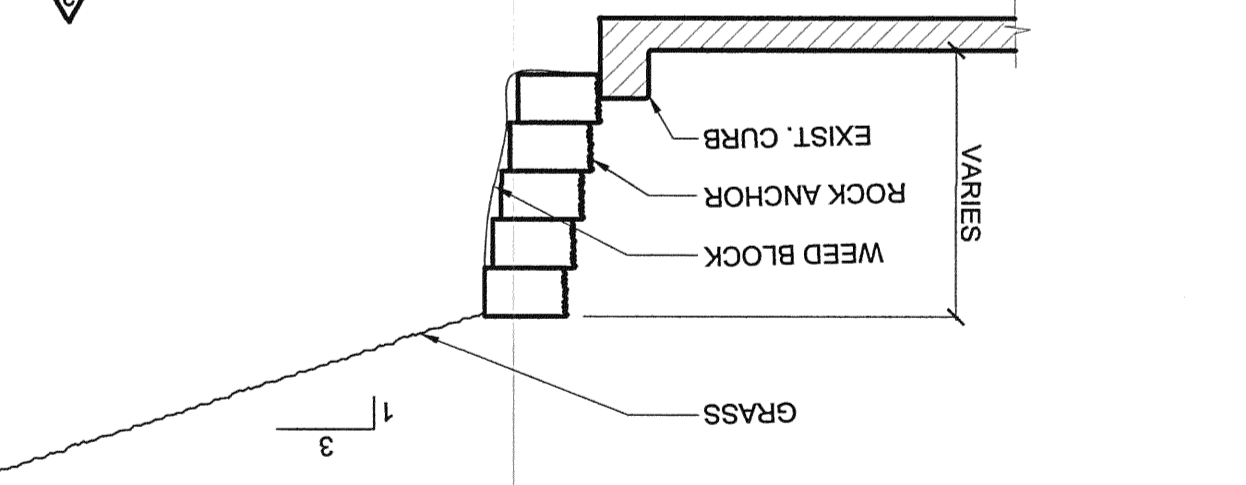

2 TRASH FRONT ELEVATION
N.T.S.

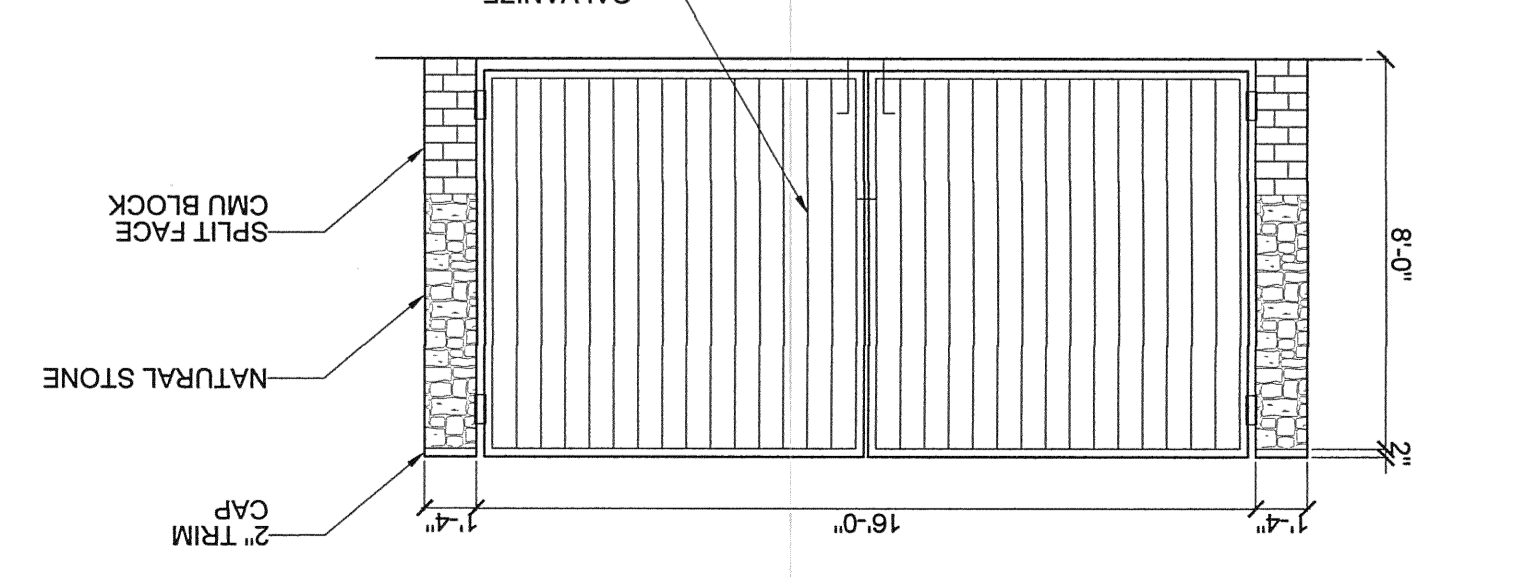

SITE PLAN
REVISIONS:
1. 01-21-10 PER CITY & RACETRAC COOR.
2. 08-02-10 PER CITY COMMENTS
3. 08-29-11 AS BUILT

205 PLAZA
2309-2319 S. GOLLADE
ROCKWALL, TEXAS 75087



S.P. Design & S.P. Build Inc.
Consultant Engineers
Email: spham@spdb.net
Tel. 972-241-4016
Fax. 972-241-4018
11500 N. Stemmons Freeway, Suite 139
Dallas, TX 75229

AS BUILT