# CONSTRUCTION PLANS

FOR

# 4649 HIGHWAY 276 STORAGE FACILITY

AN ADDITION TO THE CITY OF ROCKWALL, TEXAS

VALK 276 ADDITION, LOT 1, BLOCK A J.H. BAILEY SURVEY, ABSTRACT NO. 34 & 44

DRAWING INDEX

COVER SHEET PLAT  SP SITE PLAN GENERAL NOTES (1 OF 2) GENERAL NOTES (2 OF 2) C1.0 EXISTING CONDITIONS PLAN C2.0 DEMOLITION PLAN C3.0 PAVING PLAN C4.0 DIMENSION CONTROL PLAN C5.0 GRADING PLAN C6.0 EXISTING DRAINAGE AREA MAP C7.0 REGIONAL DRAINAGE AREA MAP C8.0 PROPOSED DRAINAGE AREA MAP C8.1 INLET CALCULATIONS C9.0 DETENTION PLAN (N) C9.1 DETENTION PLAN (N) C9.1 DETENTION PLAN (MID) C10.1 DETENTION PLAN (MID) C10.1 DETENTION PLAN (S) C11.0 DETENTION CALCULATIONS (MID) C12.0 STORM SEWER PLAN C12.1 STORM PROFILE C12.2 STORM PROFILE C12.3 STORM CALCULATIONS C13.0 STORM FLUME PLAN C13.1 FLUME SPREADER PLAN C14.0 WATER AND WASTEWATER PLAN C15.0 EROSION CONTROL PLAN C16.1 PUBLIC DETAILS 1 C16.1 PUBLIC DETAILS 2 C17.0 DETAILS (PRIVATE) 2		
SP SITE PLAN GENERAL NOTES (1 OF 2) GENERAL NOTES (2 OF 2) C1.0 EXISTING CONDITIONS PLAN C2.0 DEMOLITION PLAN C3.0 PAVING PLAN C4.0 DIMENSION CONTROL PLAN C5.0 GRADING PLAN C6.0 EXISTING DRAINAGE AREA MAP C7.0 REGIONAL DRAINAGE AREA MAP C8.0 PROPOSED DRAINAGE AREA MAP C8.1 INLET CALCULATIONS C9.0 DETENTION PLAN (N) C9.1 DETENTION CALCULATIONS (N) C10.0 DETENTION PLAN (MID) C10.1 DETENTION PLAN (MID) C11.0 DETENTION PLAN (S) C11.1 DETENTION CALCULATIONS (S) C12.0 STORM SEWER PLAN C12.1 STORM PROFILE C12.2 STORM PROFILE C12.3 STORM CALCULATIONS C13.0 STORM FLUME PLAN C13.1 FLUME SPREADER PLAN C14.0 WATER AND WASTEWATER PLAN C15.0 EROSION CONTROL PLAN C16.1 PUBLIC DETAILS 1 C16.1 PUBLIC DETAILS (PRIVATE) 1		COVER SHEET
GENERAL NOTES (1 OF 2) GENERAL NOTES (2 OF 2) C1.0 EXISTING CONDITIONS PLAN C2.0 DEMOLITION PLAN C3.0 PAVING PLAN C4.0 DIMENSION CONTROL PLAN C5.0 GRADING PLAN C6.0 EXISTING DRAINAGE AREA MAP C7.0 REGIONAL DRAINAGE AREA MAP C8.0 PROPOSED DRAINAGE AREA MAP C8.1 INLET CALCULATIONS C9.0 DETENTION PLAN (N) C9.1 DETENTION CALCULATIONS (N) C10.0 DETENTION PLAN (MID) C10.1 DETENTION PLAN (MID) C11.0 DETENTION PLAN (S) C11.1 DETENTION CALCULATIONS (S) C12.0 STORM SEWER PLAN C12.1 STORM PROFILE C12.2 STORM PROFILE C12.3 STORM CALCULATIONS C13.0 STORM FLUME PLAN C13.1 FLUME SPREADER PLAN C14.0 WATER AND WASTEWATER PLAN C15.0 EROSION CONTROL PLAN C16.1 PUBLIC DETAILS 1 C16.1 PUBLIC DETAILS (PRIVATE) 1		PLAT
GENERAL NOTES (2 OF 2)  C1.0 EXISTING CONDITIONS PLAN  C2.0 DEMOLITION PLAN  C3.0 PAVING PLAN  C4.0 DIMENSION CONTROL PLAN  C5.0 GRADING PLAN  C6.0 EXISTING DRAINAGE AREA MAP  C7.0 REGIONAL DRAINAGE AREA MAP  C8.0 PROPOSED DRAINAGE AREA MAP  C8.1 INLET CALCULATIONS  C9.0 DETENTION PLAN (N)  C9.1 DETENTION PLAN (MID)  C10.0 DETENTION PLAN (MID)  C10.1 DETENTION PLAN (MID)  C11.0 DETENTION PLAN (S)  C11.1 DETENTION CALCULATIONS (S)  C12.0 STORM SEWER PLAN  C12.1 STORM PROFILE  C12.2 STORM PROFILE  C12.3 STORM CALCULATIONS  C13.0 STORM FLUME PLAN  C13.1 FLUME SPREADER PLAN  C14.0 WATER AND WASTEWATER PLAN  C15.0 EROSION CONTROL PLAN  C16.1 PUBLIC DETAILS 1  C16.1 PUBLIC DETAILS 2  C17.0 DETAILS (PRIVATE) 1	SP	SITE PLAN
GENERAL NOTES (2 OF 2) C1.0 EXISTING CONDITIONS PLAN C2.0 DEMOLITION PLAN C3.0 PAVING PLAN C4.0 DIMENSION CONTROL PLAN C5.0 GRADING PLAN C6.0 EXISTING DRAINAGE AREA MAP C7.0 REGIONAL DRAINAGE AREA MAP C7.0 REGIONAL DRAINAGE AREA MAP C8.1 INLET CALCULATIONS C9.0 DETENTION PLAN (N) C9.1 DETENTION PLAN (N) C10.0 DETENTION PLAN (MID) C10.1 DETENTION PLAN (MID) C11.0 DETENTION PLAN (S) C11.1 DETENTION CALCULATIONS (S) C12.0 STORM SEWER PLAN C12.1 STORM PROFILE C12.2 STORM PROFILE C12.3 STORM CALCULATIONS C13.0 STORM FLUME PLAN C13.1 FLUME SPREADER PLAN C14.0 WATER AND WASTEWATER PLAN C15.0 EROSION CONTROL PLAN C16.0 PUBLIC DETAILS 1 C16.1 PUBLIC DETAILS 2 C17.0 DETAILS (PRIVATE) 1		GENERAL NOTES (1 OF 2)
C2.0 DEMOLITION PLAN  C3.0 PAVING PLAN  C4.0 DIMENSION CONTROL PLAN  C5.0 GRADING PLAN  C6.0 EXISTING DRAINAGE AREA MAP  C7.0 REGIONAL DRAINAGE AREA MAP  C8.0 PROPOSED DRAINAGE AREA MAP  C8.1 INLET CALCULATIONS  C9.0 DETENTION PLAN (N)  C9.1 DETENTION CALCULATIONS (N)  C10.0 DETENTION PLAN (MID)  C10.1 DETENTION CALCULATIONS (MID)  C11.0 DETENTION PLAN (S)  C11.1 DETENTION CALCULATIONS (S)  C12.0 STORM SEWER PLAN  C12.1 STORM PROFILE  C12.2 STORM PROFILE  C12.3 STORM CALCULATIONS  C13.1 FLUME SPREADER PLAN  C14.0 WATER AND WASTEWATER PLAN  C15.0 EROSION CONTROL PLAN  C16.1 PUBLIC DETAILS 1  C16.1 PUBLIC DETAILS 2  C17.0 DETAILS (PRIVATE) 1  C17.1 DETAILS (PRIVATE) 2		
C3.0 PAVING PLAN  C4.0 DIMENSION CONTROL PLAN  C5.0 GRADING PLAN  C6.0 EXISTING DRAINAGE AREA MAP  C7.0 REGIONAL DRAINAGE AREA MAP  C8.0 PROPOSED DRAINAGE AREA MAP  C8.1 INLET CALCULATIONS  C9.0 DETENTION PLAN (N)  C9.1 DETENTION CALCULATIONS (N)  C10.0 DETENTION PLAN (MID)  C10.1 DETENTION CALCULATIONS (MID)  C11.0 DETENTION CALCULATIONS (S)  C11.1 DETENTION CALCULATIONS (S)  C12.0 STORM SEWER PLAN  C12.1 STORM PROFILE  C12.2 STORM PROFILE  C12.3 STORM CALCULATIONS  C13.0 STORM FLUME PLAN  C13.1 FLUME SPREADER PLAN  C14.0 WATER AND WASTEWATER PLAN  C15.0 EROSION CONTROL PLAN  C16.1 PUBLIC DETAILS 1  C16.1 PUBLIC DETAILS 2  C17.0 DETAILS (PRIVATE) 1  C17.1 DETAILS (PRIVATE) 2	C1.0	EXISTING CONDITIONS PLAN
C4.0 DIMENSION CONTROL PLAN  C5.0 GRADING PLAN  C6.0 EXISTING DRAINAGE AREA MAP  C7.0 REGIONAL DRAINAGE AREA MAP  C8.0 PROPOSED DRAINAGE AREA MAP  C8.1 INLET CALCULATIONS  C9.0 DETENTION PLAN (N)  C9.1 DETENTION CALCULATIONS (N)  C10.0 DETENTION PLAN (MID)  C10.1 DETENTION CALCULATIONS (MID)  C11.0 DETENTION PLAN (S)  C11.1 DETENTION CALCULATIONS (S)  C12.0 STORM SEWER PLAN  C12.1 STORM PROFILE  C12.2 STORM PROFILE  C12.3 STORM CALCULATIONS  C13.0 STORM FLUME PLAN  C13.1 FLUME SPREADER PLAN  C14.0 WATER AND WASTEWATER PLAN  C15.0 EROSION CONTROL PLAN  C16.1 PUBLIC DETAILS 1  C16.1 PUBLIC DETAILS 2  C17.0 DETAILS (PRIVATE) 1  C17.1 DETAILS (PRIVATE) 2	C2.0	DEMOLITION PLAN
C5.0 GRADING PLAN C6.0 EXISTING DRAINAGE AREA MAP C7.0 REGIONAL DRAINAGE AREA MAP C8.0 PROPOSED DRAINAGE AREA MAP C8.1 INLET CALCULATIONS C9.0 DETENTION PLAN (N) C9.1 DETENTION CALCULATIONS (N) C10.0 DETENTION PLAN (MID) C10.1 DETENTION CALCULATIONS (MID) C11.0 DETENTION CALCULATIONS (MID) C11.1 DETENTION CALCULATIONS (S) C12.0 STORM SEWER PLAN C12.1 STORM PROFILE C12.2 STORM PROFILE C12.3 STORM CALCULATIONS C13.0 STORM FLUME PLAN C13.1 FLUME SPREADER PLAN C14.0 WATER AND WASTEWATER PLAN C15.0 EROSION CONTROL PLAN C16.1 PUBLIC DETAILS 1 C16.1 PUBLIC DETAILS 2 C17.0 DETAILS (PRIVATE) 1 C17.1 DETAILS (PRIVATE) 2	C3.0	PAVING PLAN
C6.0 EXISTING DRAINAGE AREA MAP C7.0 REGIONAL DRAINAGE AREA MAP C8.0 PROPOSED DRAINAGE AREA MAP C8.1 INLET CALCULATIONS C9.0 DETENTION PLAN (N) C9.1 DETENTION CALCULATIONS (N) C10.0 DETENTION PLAN (MID) C10.1 DETENTION CALCULATIONS (MID) C11.0 DETENTION CALCULATIONS (MID) C11.1 DETENTION CALCULATIONS (S) C12.0 STORM SEWER PLAN C12.1 STORM PROFILE C12.2 STORM PROFILE C12.3 STORM CALCULATIONS C13.0 STORM FLUME PLAN C13.1 FLUME SPREADER PLAN C13.1 FLUME SPREADER PLAN C15.0 EROSION CONTROL PLAN C16.0 PUBLIC DETAILS 1 C16.1 PUBLIC DETAILS 2 C17.0 DETAILS (PRIVATE) 1 C17.1 DETAILS (PRIVATE) 2	C4.0	DIMENSION CONTROL PLAN
C7.0 REGIONAL DRAINAGE AREA MAP  C8.0 PROPOSED DRAINAGE AREA MAP  C8.1 INLET CALCULATIONS  C9.0 DETENTION PLAN (N)  C9.1 DETENTION CALCULATIONS (N)  C10.0 DETENTION PLAN (MID)  C10.1 DETENTION CALCULATIONS (MID)  C11.0 DETENTION PLAN (S)  C11.1 DETENTION CALCULATIONS (S)  C12.0 STORM SEWER PLAN  C12.1 STORM PROFILE  C12.2 STORM PROFILE  C12.3 STORM CALCULATIONS  C13.0 STORM FLUME PLAN  C13.1 FLUME SPREADER PLAN  C14.0 WATER AND WASTEWATER PLAN  C15.0 EROSION CONTROL PLAN  C16.1 PUBLIC DETAILS 1  C16.1 PUBLIC DETAILS 2  C17.0 DETAILS (PRIVATE) 1  C17.1 DETAILS (PRIVATE) 2		GRADING PLAN
C8.0 PROPOSED DRAINAGE AREA MAP  C8.1 INLET CALCULATIONS  C9.0 DETENTION PLAN (N)  C9.1 DETENTION CALCULATIONS (N)  C10.0 DETENTION PLAN (MID)  C10.1 DETENTION CALCULATIONS (MID)  C11.0 DETENTION PLAN (S)  C11.1 DETENTION CALCULATIONS (S)  C12.0 STORM SEWER PLAN  C12.1 STORM PROFILE  C12.2 STORM PROFILE  C12.3 STORM CALCULATIONS  C13.0 STORM FLUME PLAN  C13.1 FLUME SPREADER PLAN  C14.0 WATER AND WASTEWATER PLAN  C15.0 EROSION CONTROL PLAN  C16.1 PUBLIC DETAILS 1  C16.1 PUBLIC DETAILS 2  C17.0 DETAILS (PRIVATE) 1  C17.1 DETAILS (PRIVATE) 2		EXISTING DRAINAGE AREA MAP
C8.1 INLET CALCULATIONS C9.0 DETENTION PLAN (N) C9.1 DETENTION CALCULATIONS (N) C10.0 DETENTION PLAN (MID) C10.1 DETENTION CALCULATIONS (MID) C11.0 DETENTION PLAN (S) C11.1 DETENTION CALCULATIONS (S) C12.0 STORM SEWER PLAN C12.1 STORM PROFILE C12.2 STORM PROFILE C12.3 STORM CALCULATIONS C13.0 STORM FLUME PLAN C13.1 FLUME SPREADER PLAN C14.0 WATER AND WASTEWATER PLAN C15.0 EROSION CONTROL PLAN C16.0 PUBLIC DETAILS 1 C16.1 PUBLIC DETAILS 2 C17.0 DETAILS (PRIVATE) 2		REGIONAL DRAINAGE AREA MAP
C9.0 DETENTION PLAN (N)  C9.1 DETENTION CALCULATIONS (N)  C10.0 DETENTION PLAN (MID)  C10.1 DETENTION CALCULATIONS (MID)  C11.0 DETENTION PLAN (S)  C11.1 DETENTION CALCULATIONS (S)  C12.0 STORM SEWER PLAN  C12.1 STORM PROFILE  C12.2 STORM PROFILE  C12.3 STORM CALCULATIONS  C13.0 STORM FLUME PLAN  C13.1 FLUME SPREADER PLAN  C14.0 WATER AND WASTEWATER PLAN  C15.0 EROSION CONTROL PLAN  C16.1 PUBLIC DETAILS 1  C16.1 PUBLIC DETAILS 2  C17.0 DETAILS (PRIVATE) 1  C17.1 DETAILS (PRIVATE) 2		PROPOSED DRAINAGE AREA MAP
C9.1 DETENTION CALCULATIONS (N) C10.0 DETENTION PLAN (MID) C10.1 DETENTION CALCULATIONS (MID) C11.0 DETENTION PLAN (S) C11.1 DETENTION CALCULATIONS (S) C12.0 STORM SEWER PLAN C12.1 STORM PROFILE C12.2 STORM PROFILE C12.3 STORM CALCULATIONS C13.0 STORM FLUME PLAN C13.1 FLUME SPREADER PLAN C14.0 WATER AND WASTEWATER PLAN C15.0 EROSION CONTROL PLAN C16.0 PUBLIC DETAILS 1 C16.1 PUBLIC DETAILS 2 C17.0 DETAILS (PRIVATE) 1 C17.1 DETAILS (PRIVATE) 2		INLET CALCULATIONS
C10.0 DETENTION PLAN (MID) C10.1 DETENTION CALCULATIONS (MID) C11.0 DETENTION PLAN (S) C11.1 DETENTION CALCULATIONS (S) C12.0 STORM SEWER PLAN C12.1 STORM PROFILE C12.2 STORM PROFILE C12.3 STORM CALCULATIONS C13.0 STORM FLUME PLAN C13.1 FLUME SPREADER PLAN C14.0 WATER AND WASTEWATER PLAN C15.0 EROSION CONTROL PLAN C16.1 PUBLIC DETAILS 1 C16.1 PUBLIC DETAILS 2 C17.0 DETAILS (PRIVATE) 1 C17.1 DETAILS (PRIVATE) 2		DETENTION PLAN (N)
C10.1 DETENTION CALCULATIONS (MID) C11.0 DETENTION PLAN (S) C11.1 DETENTION CALCULATIONS (S) C12.0 STORM SEWER PLAN C12.1 STORM PROFILE C12.2 STORM PROFILE C12.3 STORM CALCULATIONS C13.0 STORM FLUME PLAN C13.1 FLUME SPREADER PLAN C14.0 WATER AND WASTEWATER PLAN C15.0 EROSION CONTROL PLAN C16.1 PUBLIC DETAILS 1 C16.1 PUBLIC DETAILS 2 C17.0 DETAILS (PRIVATE) 1 C17.1 DETAILS (PRIVATE) 2		DETENTION CALCULATIONS (N)
C11.0 DETENTION PLAN (S) C11.1 DETENTION CALCULATIONS (S) C12.0 STORM SEWER PLAN C12.1 STORM PROFILE C12.2 STORM PROFILE C12.3 STORM CALCULATIONS C13.0 STORM FLUME PLAN C13.1 FLUME SPREADER PLAN C14.0 WATER AND WASTEWATER PLAN C15.0 EROSION CONTROL PLAN C16.0 PUBLIC DETAILS 1 C16.1 PUBLIC DETAILS 2 C17.0 DETAILS (PRIVATE) 1 C17.1 DETAILS (PRIVATE) 2		
C11.1 DETENTION CALCULATIONS (S) C12.0 STORM SEWER PLAN C12.1 STORM PROFILE C12.2 STORM PROFILE C12.3 STORM CALCULATIONS C13.0 STORM FLUME PLAN C13.1 FLUME SPREADER PLAN C14.0 WATER AND WASTEWATER PLAN C15.0 EROSION CONTROL PLAN C16.0 PUBLIC DETAILS 1 C16.1 PUBLIC DETAILS 2 C17.0 DETAILS (PRIVATE) 1 C17.1 DETAILS (PRIVATE) 2		
C12.0 STORM SEWER PLAN C12.1 STORM PROFILE C12.2 STORM PROFILE C12.3 STORM CALCULATIONS C13.0 STORM FLUME PLAN C13.1 FLUME SPREADER PLAN C14.0 WATER AND WASTEWATER PLAN C15.0 EROSION CONTROL PLAN C16.0 PUBLIC DETAILS 1 C16.1 PUBLIC DETAILS 2 C17.0 DETAILS (PRIVATE) 1 C17.1 DETAILS (PRIVATE) 2		
VICINITY MAP

PROBABLE START OF CONSTRUCTION:
MAY 2023


SURVEYOR: BLUE SKY SURVEYING 11015 MIDWAY ROAD DALLAS, TX 75229 PH: (214) 358-4500 OWNER:
DON VALK
230 O'CONNOR RIDGE,
SUITE 115
IRVING, TX 75038
PH: (214) 808-6667
CONTACT: DON VALK

DEVELOPER:
PLATINUM CONSTRUCTION
1450 TL TOWNSEND DR,
STE 100
ROCKWALL, TX 75032
PH: (214) 668-6907
CONTACT: RONALD VALK

ENGINEER:
CUMULUS DESIGN, INC.
FIRM NUMBER: 14810
2080 NORTH HIGHWAY 360, SUITE 240
GRAND PRAIRIE, TEXAS 75050
PH: (214) 235-0367
CONTACT: PAUL CRAGUN



N.T.S.

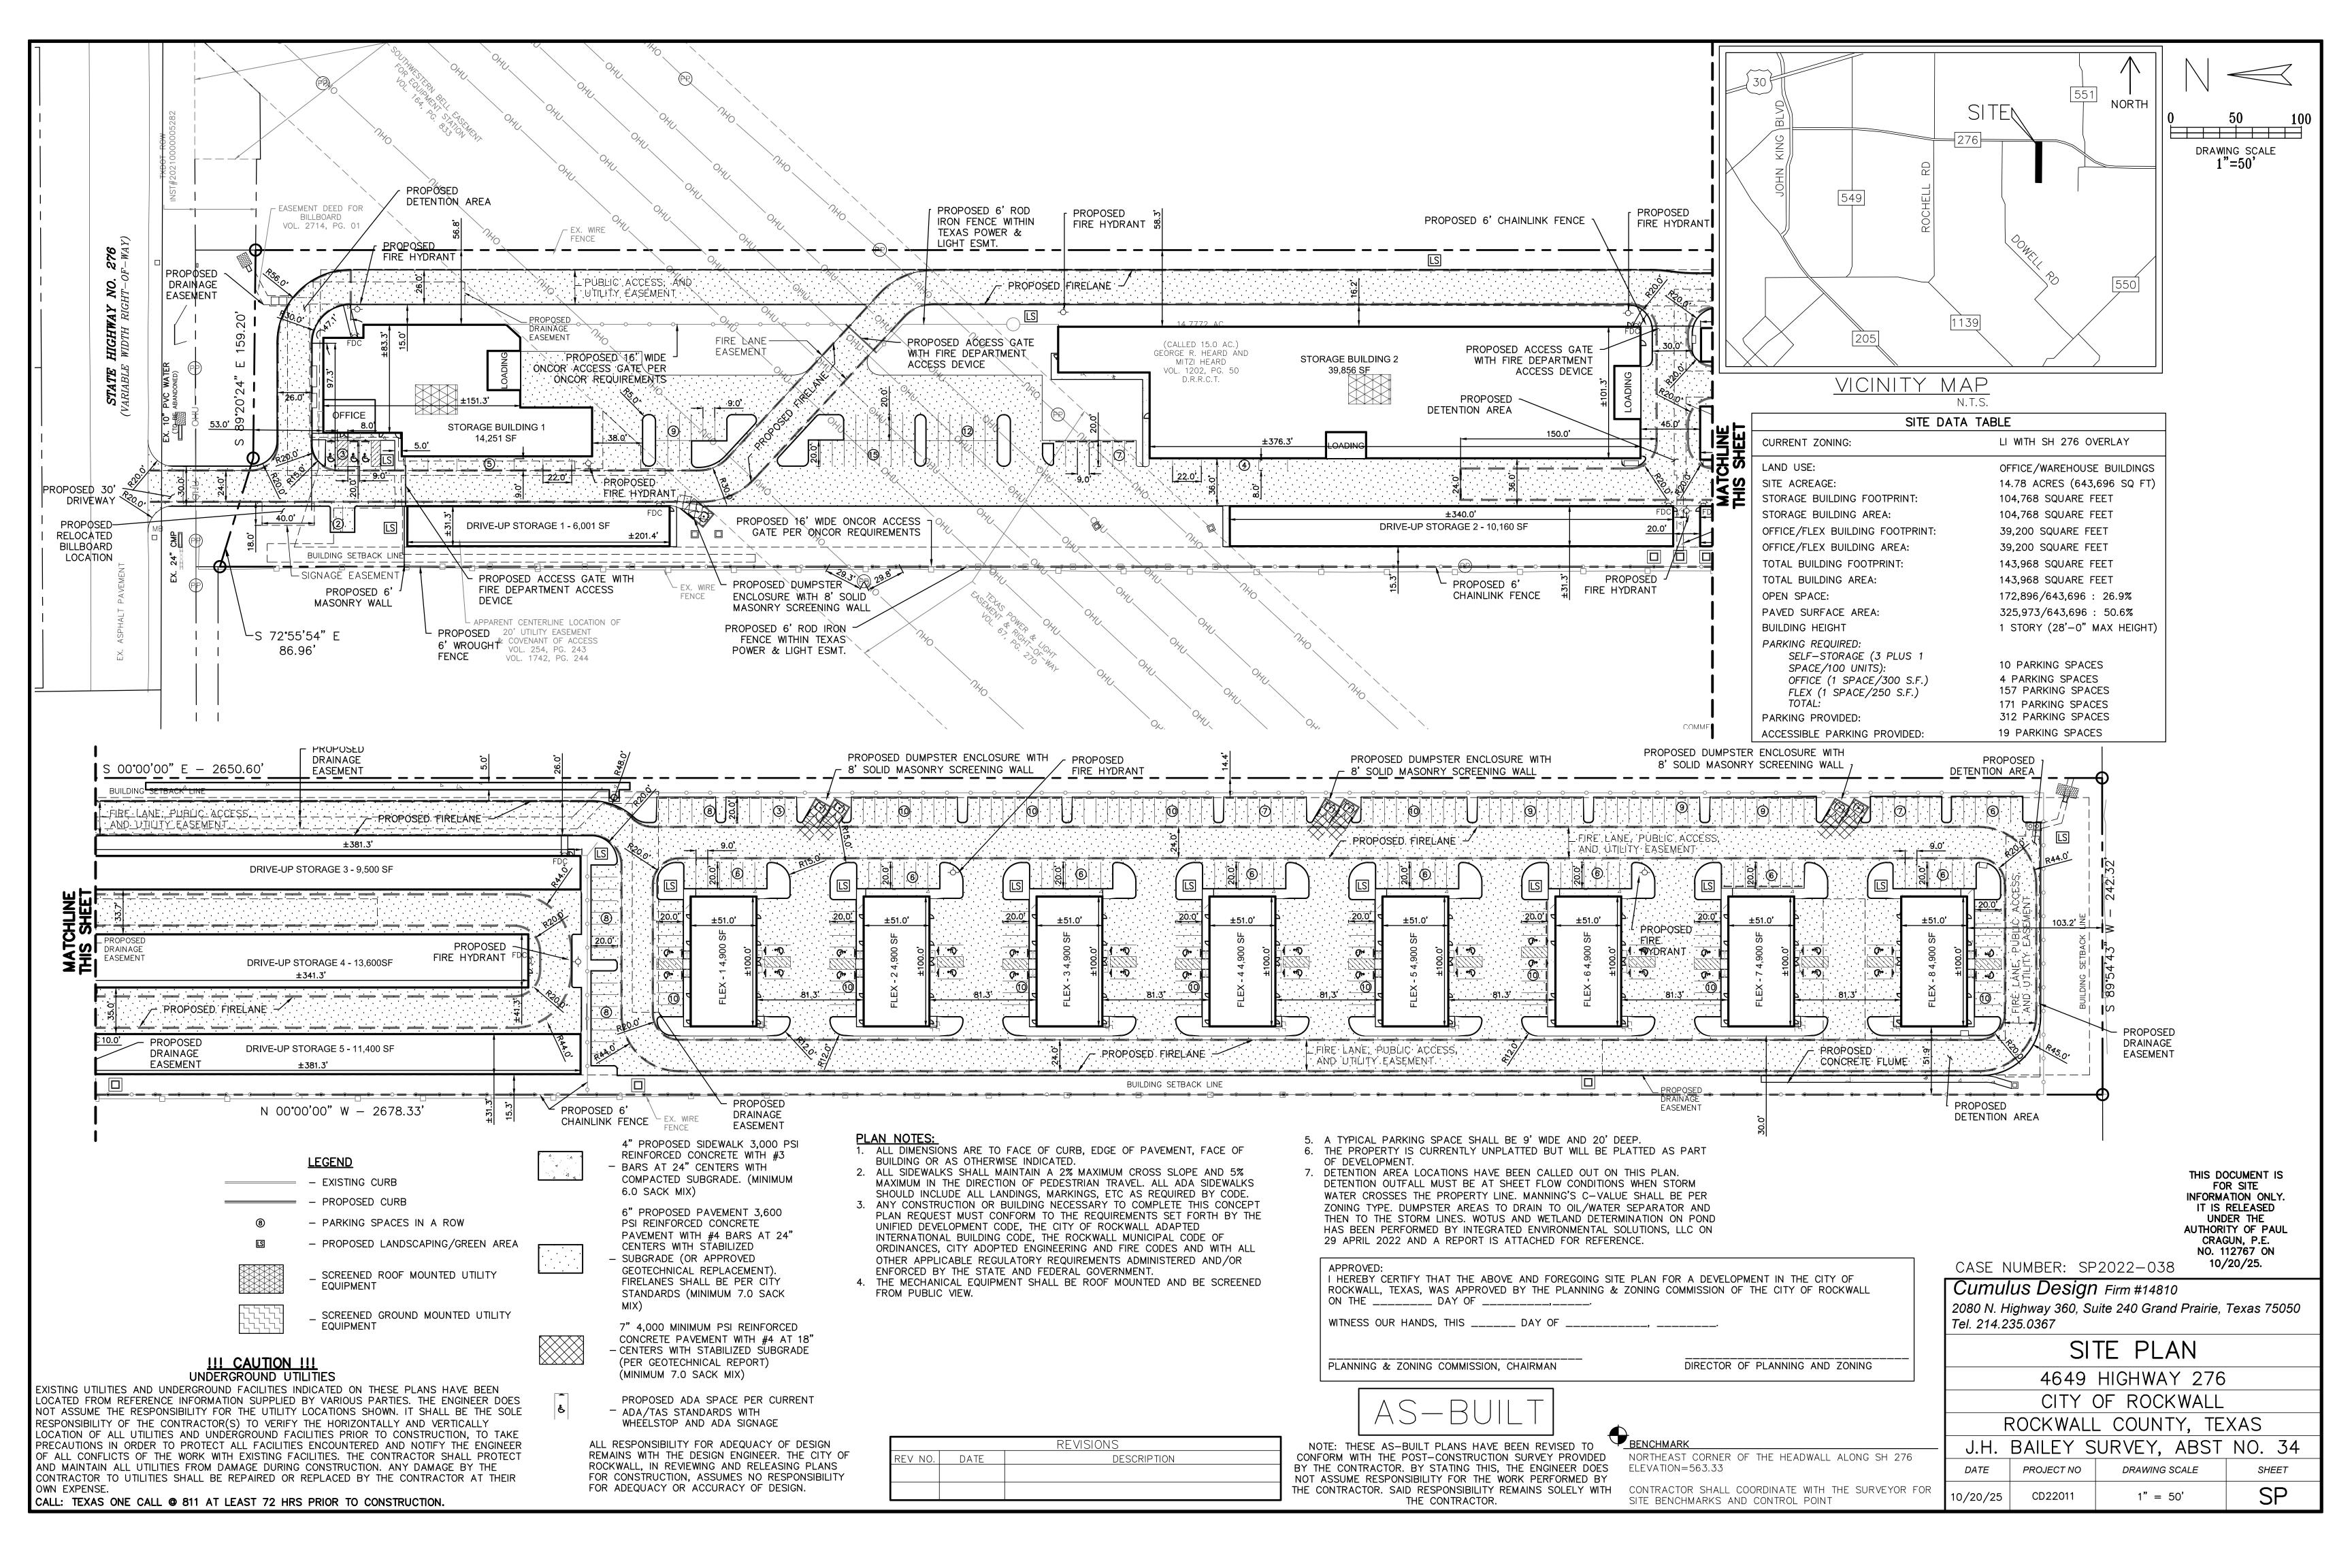

# **GENERAL ITEMS**

- 1. All construction shall conform to the requirements set forth in the City of Rockwall's Engineering Department's "Standards of Design and Construction" and the "Standard Specifications for Public Works Construction" by the North Texas Central Council of Governments, 5th edition amended by the City of Rockwall. The CONTRACTOR shall reference the latest City of Rockwall standard details provided in the Rockwall Engineering Departments "Standards of Design and Construction" manual for details not provided in these plans. The CONTRACTOR shall possess one set of the NCTCOG Standard Specifications and Details and the City of Rockwall's "Standards of Design and Construction" manual on the project site at all times
- 2. Where any conflicting notes, details or specifications occur in the plans the City of Rockwall General Construction Notes, Standards, Details and Specifications shall govern unless detail or specification is more strict.
- 3. The City of Rockwall Engineering Departments "Standards of Design and Construction" can be found online at: <a href="http://www.rockwall.com/engr.asp">http://www.rockwall.com/engr.asp</a>
- 4. All communication between the City and the CONTRACTOR shall be through the Engineering Construction Inspector and City Engineer or designated representative only. It is the responsibility of the CONTRACTOR to contact the appropriate department for inspections that do not fall under this approved engineering plan set.
- 5. Prior to construction, CONTRACTOR shall have in their possession all necessary permits, plans, licenses,
- 6. The CONTRACTOR shall have at least one original stamped and signed set of approved engineering plans and specifications on-site and in their possession at all times. A stop work order will be issued if items are not on-site. Copies of the approved plans will not be substituted for the required original "approved plans to be on-site".
- 7. All material submittals, concrete batch designs and shop drawings required for City review and approval shall be submitted by the CONTRACTOR to the City sufficiently in advance of scheduled construction to allow no less than 10 business days for review and response by the City.
- 8. All site dimensions are referenced to the face of curb or edge of pavement unless otherwise noted.
- 9. The City requires ten (10%) percent-two (2) year maintenance bond for paving, paving improvements, water systems, wastewater systems, storm sewer systems including detention systems, and associated fixtures and structures which are located within the right-of-ways or defined easements. The two (2) year maintenance bond is to state "from date of City acceptance" as the starting time.
- 10. A review of the site shall be conducted at twenty (20) months into the two (2) year maintenance period. The design engineer or their designated representative and the CONTRACTOR shall be present to walk the site with the City of Rockwall Engineering Inspection personnel.

# **EROSION CONTROL & VEGETATION**

- 1. The CONTRACTOR or developer shall be responsible, as the entity exercising operational control, for all permitting as required by the Environmental Protection Agency (EPA) and the Texas Commission on Environmental Quality (TCEQ). This includes, but is not limited to, preparation of the Storm Water Pollution Prevention Plan (SWPPP), the Construction Site Notice (CSN), the Notice of Intent (NOI), the Notice of Termination (NOT) and any Notice of Change (NOC) and is required to pay all associated fees
- 2. Erosion control devices as shown on the erosion control plan for the project shall be installed prior to the start of land disturbing activities.
- 3. All erosion control devices are to be installed in accordance with the approved plans, specifications and Storm Water Pollution Prevention Plan (SWPPP) for the project. Erosion control devices shall be placed and in working order prior to start of construction. Changes are to be reviewed and approved by the design engineer and the City of Rockwall prior to implementation.
- 4. If the Erosion Control Plans and Storm Water Pollution Prevention Plan (SWPPP) as approved cannot appropriately control erosion and off-site sedimentation from the project, the erosion control plan and/or the SWPPP is required to be revised and any changes reported to the Texas Commission on Environmental Quality (TCEQ), when applicable.
- 5. All erosion control devices shall be inspected weekly by the CONTRACTOR and after all major rain events, or more frequently as dictated in the project Storm Water Pollution Prevention Plan (SWPPP). CONTRACTOR shall provide copies of inspection's reports to the engineering inspection after each inspection
- inspection.The CONTRACTOR shall not dispose of waste and any materials into streams, waterways or floodplains.The CONTRACTOR shall secure all excavation at the end of each day and dispose of all excess materials.
- 7. CONTRACTOR shall take all available precautions to control dust. CONTRACTOR shall control dust by sprinkling water or other means as approved by the City Engineer.
- 8. CONTRACTOR shall establish grass and maintain the seeded area, including watering, until a "Permanent Stand of Grass" is obtained at which time the project will be accepted by the City. A "Stand of Grass" (not winter rye or weeds) shall consist of 75% to 80% coverage of all disturbed areas and a minimum of one-inch (1") in height as determined by the City. No bare spots will be allowed. Re-seeding will be required in all washed areas and areas that don't grow.
- 9. All City right-of-ways shall be sodded if disturbed. No artificial grass is allowed in any City right-of-way and/or easements.
- 10. All adjacent streets/alleys shall be kept clean at all times
- 11. CONTRACTOR shall keep construction site clean at all times, immediately contain all debris and trash, all debris and trash shall be removed at the end of each work day, and all vegetation on the construction site 10-inches or taller in height must be cut immediately.
- 12. Suspension of all construction activities for the project will be enforced by the City if any erosion control requirements are not meet. Work may commence after deficiency has been rectified.
- 13. During construction of the project, all soil stockpiles and borrow areas shall be stabilized or protected with sediment trapping measures. The CONTRACTOR is responsible for the temporary protection and permanent stabilization of all soil stockpiles on-site as well as borrow areas and soil intentionally transported from the project site.
- 14. Where construction vehicles access routes intersect paved or public roads/alleys, construction entrances shall be installed to minimize the transport of sediment by vehicular tracking onto paved surfaces. Where sediment is transferred onto paved or public surfaces, the surface shall be immediately cleaned. Sediment shall be

- removed from the surface by shoveling or sweeping and transported to a sediment disposal area. Pavement washing shall be allowed only after sediment is removed in this manner.
- 15. All drainage inlets shall be protected from siltation, ineffective or unmaintained protection devices shall be immediately replaced and the inlet and storm system cleaned. Flushing is not an acceptable method of cleaning.
- 16. During all dewatering operations, water shall be pumped into an approved filtering device prior to discharge into a receiving outlet.

# TRAFFIC CONTROL

- 1. All new Detouring or Traffic Control Plans are required to be submitted to the City for review and approval a minimum of 21 calendar days prior to planned day of implementation.
- 2. When the normal function of the roadway is suspended through closure of any portion of the right-of-way, temporary construction work zone traffic control devices shall be installed to effectively guide the motoring public through the area. Consideration for road user safety, worker safety, and the efficiency of road user flow is an integral element of every traffic control zone.
- 3. All traffic control plans shall be prepared and submitted to the Engineering Department in accordance with the standards identified in Part VI of the most recent edition of the TMUTCD. Lane closures will not occur on roadways without an approval from the Rockwall Engineering Department and an approved traffic control plan. Traffic control plans shall be required on all roadways as determined by the City Engineer or the designated representative.
- 4. All traffic control plans must be prepared, signed, and sealed by an individual that is licensed as a professional engineer in the State of Texas. All traffic control plans and copies of work zone certification must be submitted for review and approval a minimum of three (3) weeks prior to the anticipated temporary traffic control.
- 5. The CONTRACTOR executing the traffic control plan shall notify all affected property owners two (2) weeks prior to any the closures in writing and verbally.
- 6. Any deviation from an approved traffic control plan must be reviewed by the City Engineer or the designated representative. If an approved traffic control plan is not adhered to, the CONTRACTOR will first receive a verbal warning and be required to correct the problem immediately. If the deviation is not corrected, all construction work will be suspended, the lane closure will be removed, and the roadway opened to traffic.
- 7. All temporary traffic control devices shall be removed as soon as practical when they are no longer needed. When work is suspended for short periods of time at the end of the workday, all temporary traffic control devices that are no longer appropriate shall be removed or covered. The first violation of this provision will result in a verbal warning to the construction foreman. Subsequent violations will result in suspension of all work at the job site for a minimum of 48 hours. All contractors working on City funded projects will be charged one working day for each 24 hour closure.
- 8. Lane closures on any major or minor arterial will not be permitted between the hours of 6:00 am to 9:00 am and 3:30 pm to 7:00 pm. Where lane closures are needed in a school area, they will not be permitted during peak hours of 7:00 am 9:00 am and 3:00 pm to 5:00 pm. Closures may be adjusted according to the actual start-finish times of the actual school with approval by the City Engineer. The first violation of this provision will result in a verbal warning to the construction foreman. Subsequent violations will result in suspension of all work at the job site for a minimum of 48 hours. All contractors working on City funded projects will be charged one working day for each 24 hour closure of a roadway whether they are working or not.
- 9. No traffic signs shall be taken down without permission from the City.
- 10. No street/roadway will be allowed to be fully closed.

# **UTILITY LINE LOCATES**

- 1. It is the CONTRACTOR's responsibility to notify utility companies to arrange for utility locates at least 48 hours prior to beginning construction. The completeness and accuracy of the utility data shown on the plans is not guaranteed by the design engineer or the City. The CONTRACTOR is responsible for verifying the depth and location of existing underground utilities proper to excavating, trenching, or drilling and shall be required to take any precautionary measures to protect all lines shown and .or any other underground utilities not on record or not shown on the plans.
- 2. The CONTRACTOR shall be responsible for damages to utilities
- 3. CONTRACTOR shall adjust all City of Rockwall utilities to the final grades.
- 4. All utilities shall be placed underground.
- 5. CONTRACTOR shall be responsible for the protection of all existing main lines and service lines crossed or exposed by construction operations. Where existing mains or service lines are cut, broken or damaged, the CONTRACTOR shall immediately make repairs to or replace the entire service line with same type of original construction or better. The City of Rockwall can and will intervene to restore service if deemed necessary and charge the CONTRACTOR for labor, equipment, material and loss of water if repairs aren't made in a timely manner by the CONTRACTOR.
- 6. The City of Rockwall (City utilities) is not part of the Dig Tess or Texas one Call 811 line locate system. All City of Rockwall utility line locates are to be scheduled with the City of Rockwall Service Center. 972-771-7730. A 48-hour advance notice is required for all non-emergency line locates.
- 7. Underground utility lines shall be installed in accordance with the following standards in addition to other applicable criteria:
  - a. No more than 500 linear feet of trench may be opened at one time.
  - b. Material used for backfilling trenches shall be properly compacted to 95% standard density in order to minimize erosion, settlement, and promote stabilization that the geotechnical engineer recommends.c. Applicable safety regulations shall be complied with.
- 11. This plan details pipes up to 5 feet from the building. Refer to the building plans for building connections. CONTRACTOR shall supply and install pipe adapters as necessary.
- 12. All underground lines shall be installed, inspected, and approved prior to backfilling.
- 13. All concrete encasement shall have a minimum of 28 days compressive strength at 3,000 psi (min. 5.5 sack mix).

# WATER LINE NOTES

- 1. The CONTRACTOR shall maintain existing water service at all times during construction.
- 2. Proposed water lines shall be AWWA C900-16 PVC Pipe (blue in color) for all sizes, DR 14 (PC 305) for pipeline sizes 12-inch and smaller, and DR 18 (PC 235) for 14-inch and larger water pipelines unless otherwise shown on water plan and profiles sheets. Proposed water lines shall be constructed with minimum cover of 4 feet for 6-inch through 8-inch, 5 feet for 12-inch through 18-inch and 6 feet for 20-inch and larger.
- 3. Proposed water line embedment shall be NCTCOG Class 'B-3' as amended by the City of Rockwall's engineering standards of design and construction manual.
- 4. CONTRACTOR shall coordinate the shutting down of all water lines with the City of Rockwall Engineering Inspector and Water Department. The City shall operate all water valves. Allow 5 business days from the date of notice to allow City personnel time to schedule a shut down. Two additional days are required for the CONTRACTOR to notify residents in writing of the shut down after the impacted area has been identified. Water shut downs impacting businesses during their normal operation hours is not allowed. CONTRACTOR is required to coordinate with the Rockwall Fire Department regarding any fire watch requirements as well as any costs incurred when the loss of fire protection to a structure occurs.
- 5. CONTRACTOR shall furnish and install gaskets on water lines between all dissimilar metals and at valves (both existing and proposed).
- 6. All fire hydrants and valves removed and salvaged shall be returned to the City of Rockwall Municipal Service Center.
- 7. Blue EMS pads shall be installed at every change in direction, valve, curb stop and service tap on the proposed water line and every 250'.
- 8. All water valve hardware and valve extensions, bolts, nuts and washers shall be 316 stainless steel.
- 9. All fire hydrants bolts, nuts and washers that are buried shall be 316 stainless steel.
- 10. Abandoned water lines to remain in place shall be cut and plugged and all void spaces within the abandoned line shall be filled with grout, flowable fill or an expandable permanent foam product. Valves to be abandoned in place shall have any extensions and the valve box removed and shall be capped in concrete.
- 11. All fire hydrants will have a minimum of 5 feet of clearance around the appurtenance including but not limited to parking spaces and landscaping.
- 12. All joints are to be megalug joints with thrust blocking.
- 13. Water and sewer mains shall be kept 10 feet apart (parallel) or when crossing 2 feet vertical clearance.
- 14. CONTRACTOR shall maintain a minimum of 4 feet of cover on all water lines.
- 15. All domestic and irrigation services are required to have a testable backflow device with a double check valve installed per the City of Rockwall regulations at the property line and shown on plans.

# WASTEWATER LINE NOTES

- 1. The CONTRACTOR shall maintain existing wastewater service at all times during construction.
- 2. Wastewater line for 4-inch through 15-inch shall be Green PVC SDR 35 (ASTM D3034) [less 10 ft cover] and SDR 26 (ASTM D3034) [10 ft or more cover]. For 18-inch and lager wastewater line shall be Green PVC PS 46 (ASTM F679) [less 10 ft cover] and PS 115 (ASTM F679) [10 ft or more cover]. No services will be allowed on a sanitary sewer line deeper than 10 feet.
- 3. Proposed wastewater line embedment shall be NCTCOG Class 'H' as amended by the City of Rockwall's public works standard design and construction manual.
- 4. Green EMS pads shall be installed at every 250', manhole, clean out and service lateral on proposed wastewater lines.
- 5. CONTRACTOR shall CCTV all existing wastewater lines that are to be abandoned to ensure that all laterals are accounted for and transferred to proposed wastewater lines prior to abandonment.
- 6. All abandoned wastewater and force main lines shall be cut and plugged and all void spaces within the abandoned line shall be filled with grout, flowable fill or an expandable permanent foam product.
- 7. Existing manholes and cleanouts not specifically called to be relocated shall be adjusted to match final grades.
- 8. All wastewater pipes and public services shall be inspected by photographic means (television and DVD) prior to final acceptance and after franchise utilities are installed. The CONTRACTOR shall furnish a DVD to the Engineering Construction Inspector for review. Pipes shall be cleaned prior to TV inspection of the pipes. Any sags, open joints, cracked pipes, etc. shall be repaired or removed by the CONTRACTOR at the CONTRACTOR's expense. A television survey will be performed as part of the final testing in the twentieth (20<sup>th</sup>) month of the maintenance period.
- 9. All manholes (public or private) shall be fitted with inflow prevention. The inflow prevention shall conform to the measures called out in standard detail R-5031.
- 10. All new or existing manholes being modified shall have corrosion protection being Raven Liner 405 epoxy coating, ConShield, or approved equal.. Consheild must have terracotta color dye mixed in the precast and cast-in-place concrete. Where connections to existing manholes are made the CONTRACTOR shall rehab manhole as necessary and install a 125 mil thick coating of Raven Liner 405 or approved equal.
- 11. All new or existing manholes that are to be placed in pavement shall be fitted with a sealed (gasketed) rim and cover to prevent inflow.
- 12. If an existing wastewater main or trunk line is called out to be replaced in place a wastewater bypassing pump plan shall be required and submitted to the Engineering Construction Inspector and City Engineer for approval prior to implementation. Bypass pump shall be fitted with an auto dialer and conform to the City's Noise Ordinance. Plan shall be to the City sufficiently in advance of scheduled construction to allow no less than 10 business days for review and response by the City.
- 13. CONTRACTOR shall maintain a minimum of 4 feet of cover on all wastewater lines.



# GENERAL CONSTRUCTION NOTES Sheet 1 of 2

October 2020

# CITY OF ROCKWALL ENGINEERING DEPARTMENT

385 S. Goliad Rockwall, Texas 75087 P (972) 771-7746 F (972) 771-7748

# DEMOLITION, REMOVAL, DISPOSAL AND EXCAVATION NOTES

- 1. All pavements to be removed and replaced shall be saw cut to full depth along neat squared lines shown in the plans.
- 2. Proposed concrete pavement shall be constructed with longitudinal butt construction joints at all connections to existing concrete pavement.
- 3. All public concrete pavement to be removed and replaced shall be full panel replacement, 1-inch thicker and on top of 6-inch thick compacted flexbase.
- 4. No excess excavated material shall be deposited in low areas or along natural drainage ways without written permission from the affected property owner and the City of Rockwall. No excess excavation shall be deposited in the City Limits without a permit from the City of Rockwall. If the CONTRACTOR places excess materials in these areas without written permission, the CONTRACTOR will be responsible for all damages resulting from such fill and shall remove the material at their own cost.

# PAVING AND GRADING

- 1. All detention systems are to be installed and verified for design compliance along with the associated storm sewer and outflow structures, prior to the start of any paving operations (including building foundations). Erosion protection shall be placed at the pond outflow structures, silt fence along the perimeter of the pond along with any of the associated erosion BMPs noted on the erosion control plan, and the sides and bottom of the detention system shall have either sod or anchored seeded curlex installed prior to any concrete placement.
- 2. All paving roadway, driveways, fire lanes, drive-isles, parking, dumpster pads, etc. sections shall have a minimum thickness, strength, reinforcement, joint type, joint spacing and subgrade treatment shall at a minimum conform to the City standards of Design and Construction and table below.

Street/Payament Type	Minimum Thickness	Streng th 28-	Minimum (sacks /		Steel Re	einforcement
Street/Pavement Type	(inches)	Day (psi)	Machine placed	Hand Placed	Bar#	Spacing (O.C.E.W.)
Arterial	10"	3,600	6.0	6.5	#4 bars	18"
Collector	8"	3,600	6.0	6.5	#4 bars	18"
Residential	6"	3,600	6.0	6.5	#3 bars	24"
Alley	7"-5"-7"	3,600	6.0	6.5	#3 bars	24"
Fire Lane	6"	3,600	6.0	6.5	#3 bars	24"
Driveways	6"	3,600	6.0	6.5	#3 bars	24"
Barrier Free Ramps	6"	3,600	N/A	6.5	#3 bars	24"
Sidewalks	4"	3,000	N/A	5.5	#3 bars	24"
Parking Lot/Drive Aisles	5"	3,000	5.0	5.5	#3 bars	24"
Dumpster Pads	7"	3,600	6.0	6.5	#3 bars	24"

- 3. Reinforcing steel shall be tied (100%). Reinforcing steel shall be set on plastic chairs. Bar laps shall be minimum 30 diameters. Sawed transverse dummy joints shall be spaced every 15 feet or 1.25 time longitudinal butt joint spacing whichever is less. Sawing shall occur within 5 to 12 hours after the pour, including sealing. Otherwise, the section shall be removed and longitudinal butt joint constructed.
- 4. No sand shall be allowed under any paving.
- 5. All concrete mix design shall be submitted to the City for review and approval prior to placement.
- 6. Fly ash may be used in concrete pavement locations provided that the maximum cement reduction does not exceed 20% by weight per C.Y. of concrete. The fly ash replacement shall be 1.25 lbs. per 1.0 lb. cement reduction.
- 7. All curb and gutter shall be integral (monolithic) with the pavement.
- 8. All fill shall be compacted by sheep's foot roller to a minimum 95% standard proctor. Maximum loose lift for compaction shall be 8 inches. All lifts shall be tested for density by an independent laboratory. All laboratory compaction reports shall be submitted to the City Engineering Construction Inspector once results are received. All reports will be required prior to final acceptance.
- 9. All concrete compression tests and soil compaction/density tests are required to be submitted to the City's Engineering Inspector immediately upon results.
- 10. All proposed sidewalks shall include barrier free ramps at intersecting streets, alleys, etc. Barrier free ramps (truncated dome plate in Colonial or brick red color) shall meet current City and ADA requirements and be approved by the Texas Department of Licensing and Regulation (TDLR).
- 11. All public sidewalks shall be doweled into pavement where it abuts curbs and driveways. Expansion joint material shall be used at these locations.
- 12. All connection of proposed concrete pavement to existing concrete pavement shall include a longitudinal butt joint as the load transfer device. All longitudinal butt joints shall be clean, straight and smooth (not jagged in appearance)
- 13. Cracks formed in concrete pavement shall be repaired or removed by the CONTRACTOR at the City's discretion. CONTRACTOR shall replace existing concrete curbs, sidewalk, paving, a gutters as indicated on the plans and as necessary to connect to the existing infrastructure, including any damage caused by the CONTRACTOR.
- 14. All residential lots will require individual grading plans submitted during the building permit process that correspond with the engineered grading and drainage area plans.
- 15. Approval of this plan is not an authorization to grade adjacent properties when the plans or field conditions warrant off-site grading. Written permission must be obtained and signed from the affected property owner(s) and temporary construction easements may be required. The written permission shall be provided to the City as verification of approval by the adjacent property owner(s). Violation of this requirement will result in suspension of all work at the job site until issue has been rectified.
- 16. All cut or fill slopes of non-paved areas shall be a maximum of 4:1 and minimum of 1%.
- 17. CONTRACTOR agrees to repair any damage to property and the public right-of-way in accordance with the City Standards of Design and Construction.
- 18. CONTRACTOR shall protect all monuments, iron pins/rods, and property corners during construction.
- 19. CONTRACTOR shall ensure positive drainage so that runoff will drain by gravity flow to new or existing drainage inlets or sheet flow per these approved plans.

# **DRAINAGE / STORM SEWER NOTES**

- 1. The CONTRACTOR shall maintain drainage at all times during construction. Ponding of water in streets, drives, trenches, etc. will not be allowed. Existing drainage ways shall not be blocked or removed unless explicitly stated in the plans or written approval is given by the City.
- 2. All structural concrete shall be 4200 psi compressive strength at 28 days minimum 7.0 sack mix, air entrained, unless noted otherwise. Fly ash shall not be allowed in any structural concrete.
- 3. Proposed storm sewer embedment shall be NCTCOG Class 'B' as amended by the City of Rockwall's Engineering Department Standards of Design and Construction Manual.
- 4. All public storm pipe shall be a minimum of 18-inch reinforced concrete pipe (RCP), Class III, unless otherwise noted.
- 5. All storm pipe entering structures shall be grouted to assure connection at the structure is watertight.
- 6. All storm structures shall have a smooth uniform poured mortar invert from invert in to invert out.
- 7. All storm sewer manholes in paved areas shall be flush with the paving grade, and shall have traffic bearing ring and covers.
- 8. All storm sewer pipes and laterals shall be inspected by photographic means (television and DVD) prior to final acceptance and after franchise utilities are installed. The CONTRACTOR shall furnish a DVD to the Engineering Construction Inspector for review. Pipes shall be cleaned prior to TV inspection of the pipes. Any sags, open joints, cracked pipes, etc. shall be repaired or removed by the CONTRACTOR at the CONTRACTOR's expense. A television survey will be performed as part of the final testing in the twentieth (20<sup>th</sup>) month of the maintenance period.

# **RETAINING WALLS**

- 1. All retaining walls, regardless of height, will be reviewed and approved by the City Engineering Department
- 2. All retaining walls (including foundation stem walls), regardless of height, will be constructed of rock/stone/brick or rock/stone/brick faced. No smooth concrete walls are allowed. Wall materials shall be the same for all walls on the project.
- 3. All portions, including footings, tie-backs, and drainage backfill, of the wall shall be on-site and not encroach into any public easements or right-of-way. The entire wall shall be in one lot and shall not be installed along a lot line.
- 4. All walls 3 feet and taller will be designed and signed/sealed by a registered professional engineer in the State of Texas. The wall design engineer is required to inspect the wall construction and supply a signed/sealed letter of wall construction compliance to the City of Rockwall along with wall as-builts prior to City Engineering acceptance.
- 5. No walls are allowed in detention easements. A variance to allow retaining walls in a detention easement will require approval by the Planning and Zoning Commission with appeals being heard by the City Council.

# FINAL ACCEPTANCE AND RECORD DRWINGS/AS-BUILTS

- 1. Final Acceptance shall occur when all the items on the Checklist for Final Acceptance have been completed and signed-off by the City. An example of the checklist for final acceptance has been included in the Appendix of the Standards of Design and Construction. Items on the checklist for final acceptance will vary per project and additional items not shown on the check list may be required.
- 2. After improvements have been constructed, the developer shall be responsible for providing to the City "As Built" or "Record Drawings". The Design Engineer shall furnish all digital files of the project formatted in Auto Cad 14, or 2000 format or newer and Adobe Acrobat (.pdf) format with a CD-ROM disk or flash drive. The disk or drive shall include a full set of plans along with any landscaping, wall plans, and details sheets.
- 3. Submit 1-set of printed drawings of the "Record Drawings" containing copies of all sheets to the Engineering Construction Inspector for the project. The printed sheets will be reviewed by the inspector PRIOR to producing the "Record Drawing" digital files on disk or flash drive. This will allow any revisions to be addressed prior to producing the digital files.
- 4. Record Drawing Disk drawings shall have the Design Engineers seal, signature and must be stamped and dated as "Record Drawings" or "As Built Drawings" on all sheets.
- 5. The City of Rockwall will not accept any Record Drawing disk drawings which include a disclaimer. A disclaimer shall not directly or indirectly state or indicate that the design engineer or the design engineer's surveyor/surveyors did not verify grades after construction, or that the Record Drawings were based solely on information provided by the construction contractor/contractors. Any Record Drawings which include like or similar disclaimer verbiage will not be accepted by the City of Rockwall.
- 6. Example of Acceptable Disclaimer: "To the best of our knowledge ABC Engineering, Inc., hereby states that this plan is As-Built. This information provided is based on surveying at the site and information provided by the contractor."




GENERAL CONSTRUCTION NOTES


Sheet 2 of 2


October 2020


CITY OF ROCKWALL ENGINEERING DEPARTMENT


385 S. Goliad Rockwall, Texas 75087 P (972) 771-7746 F (972) 771-7748

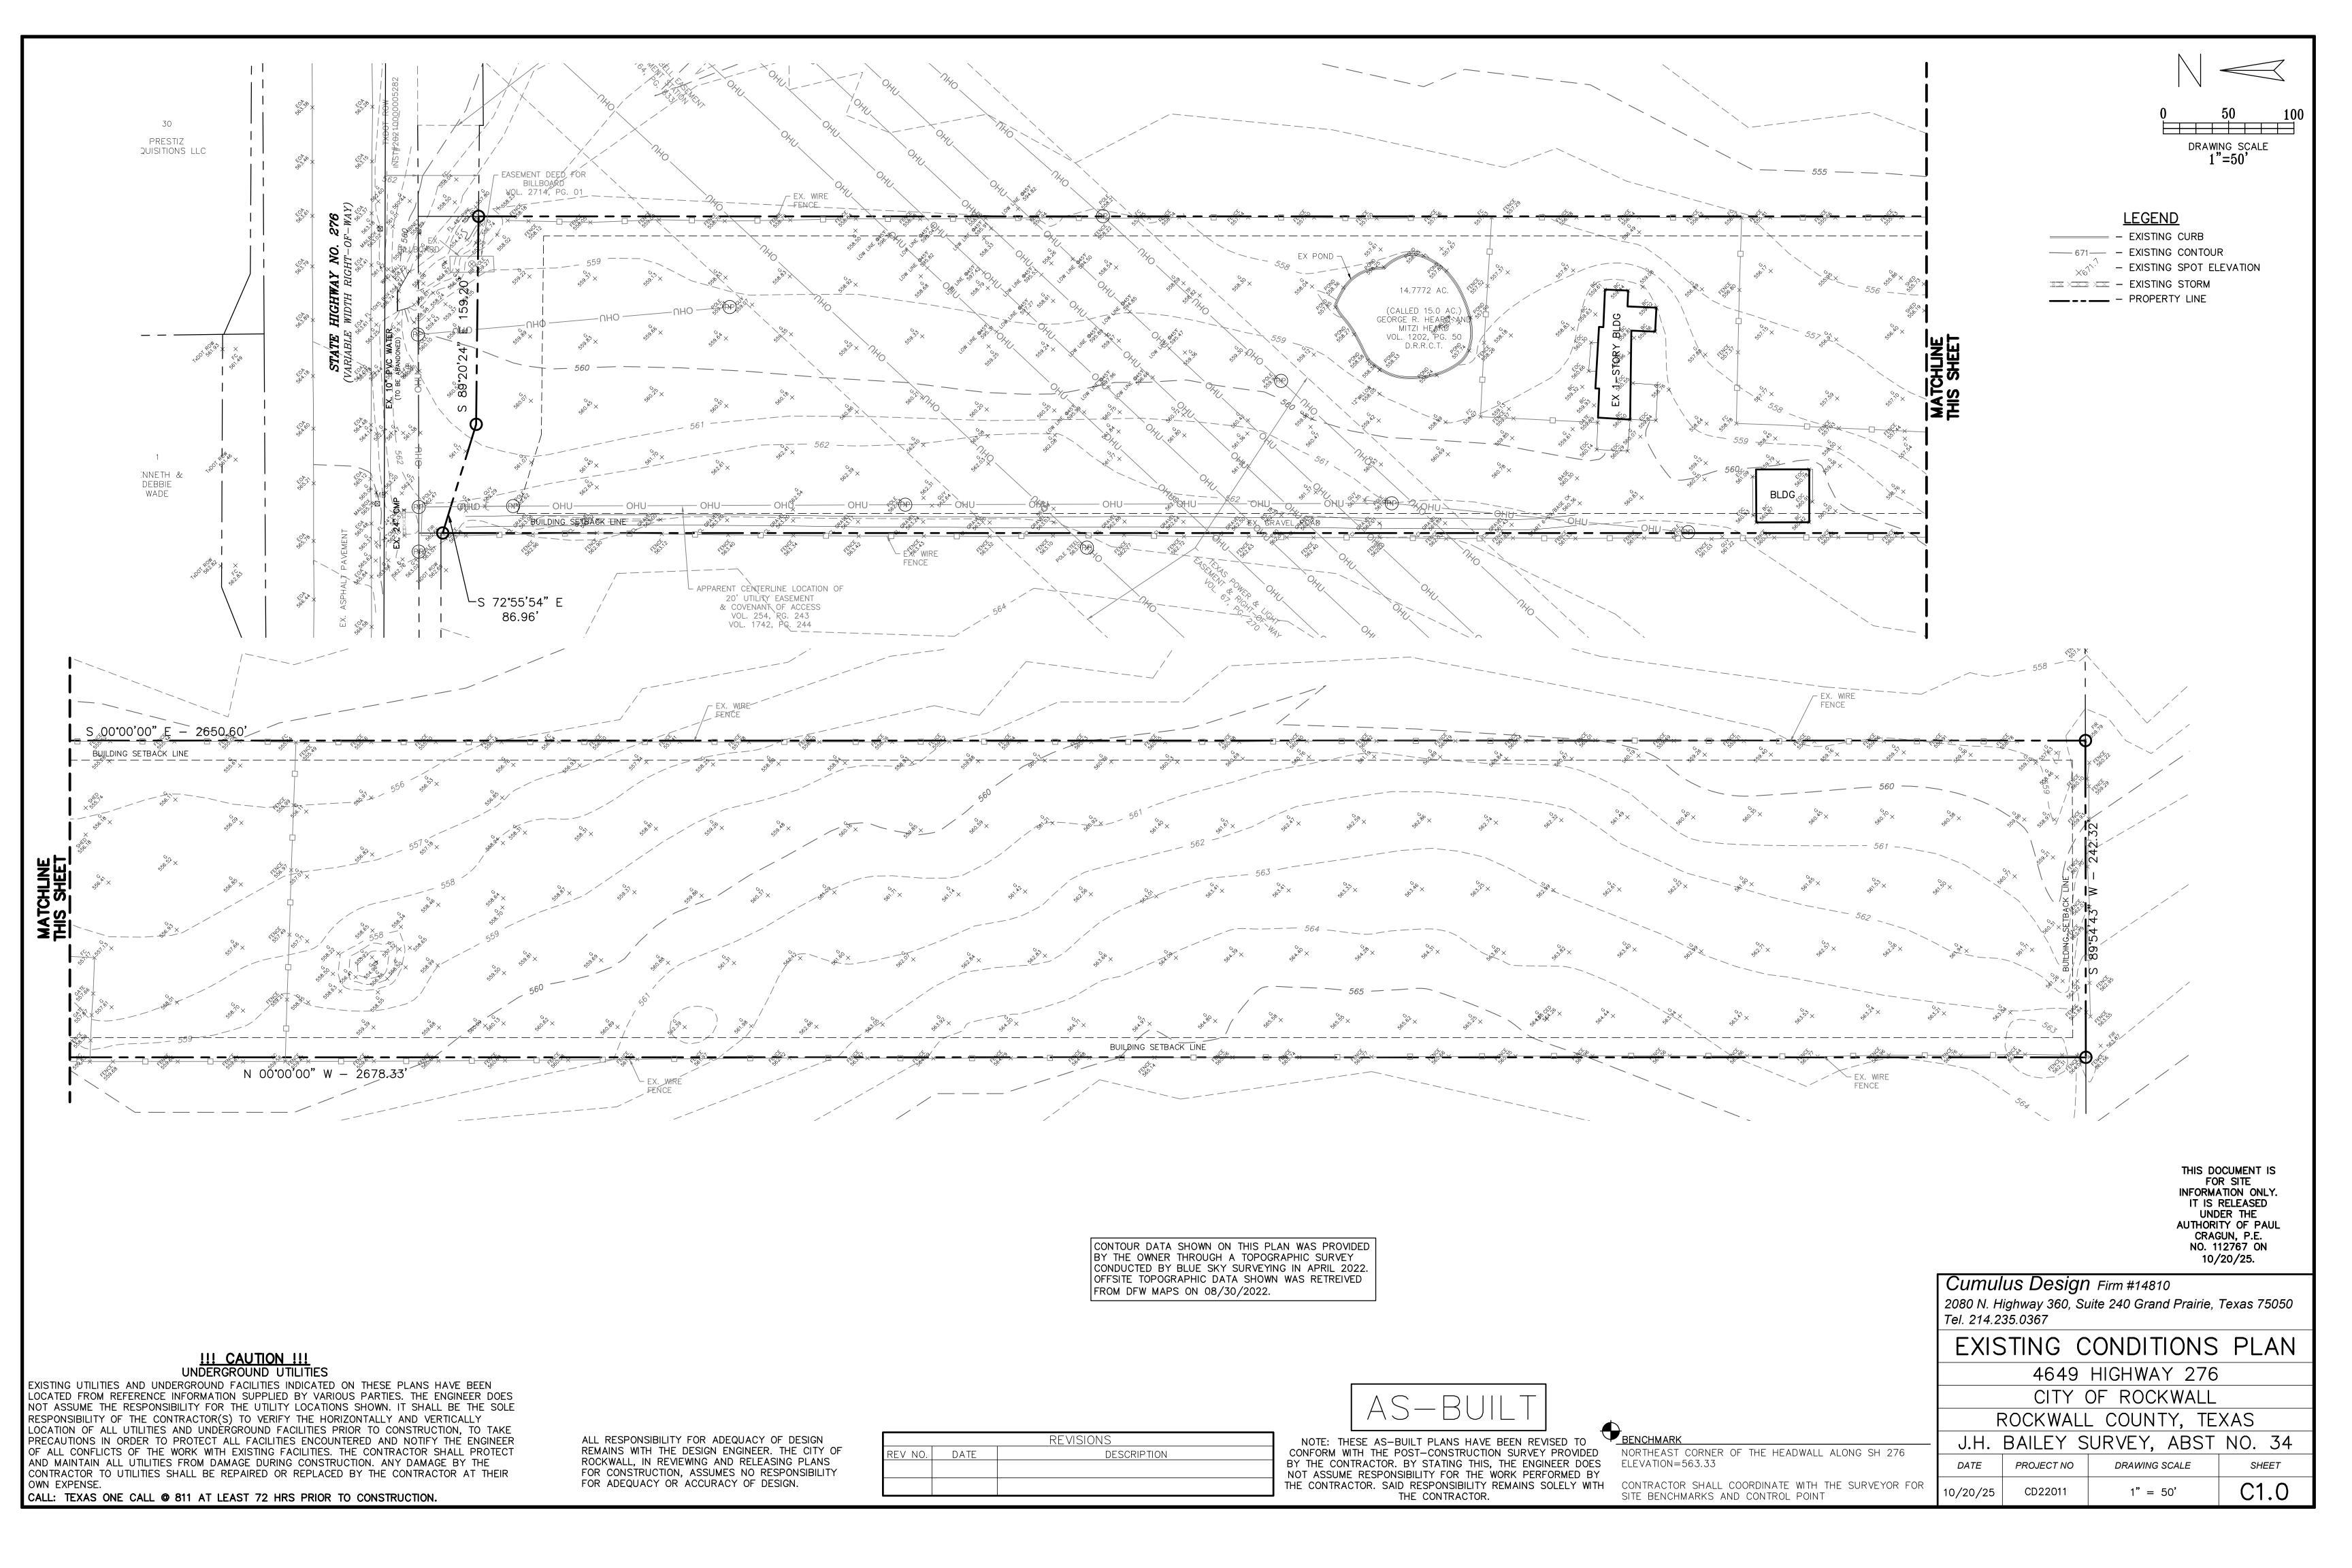


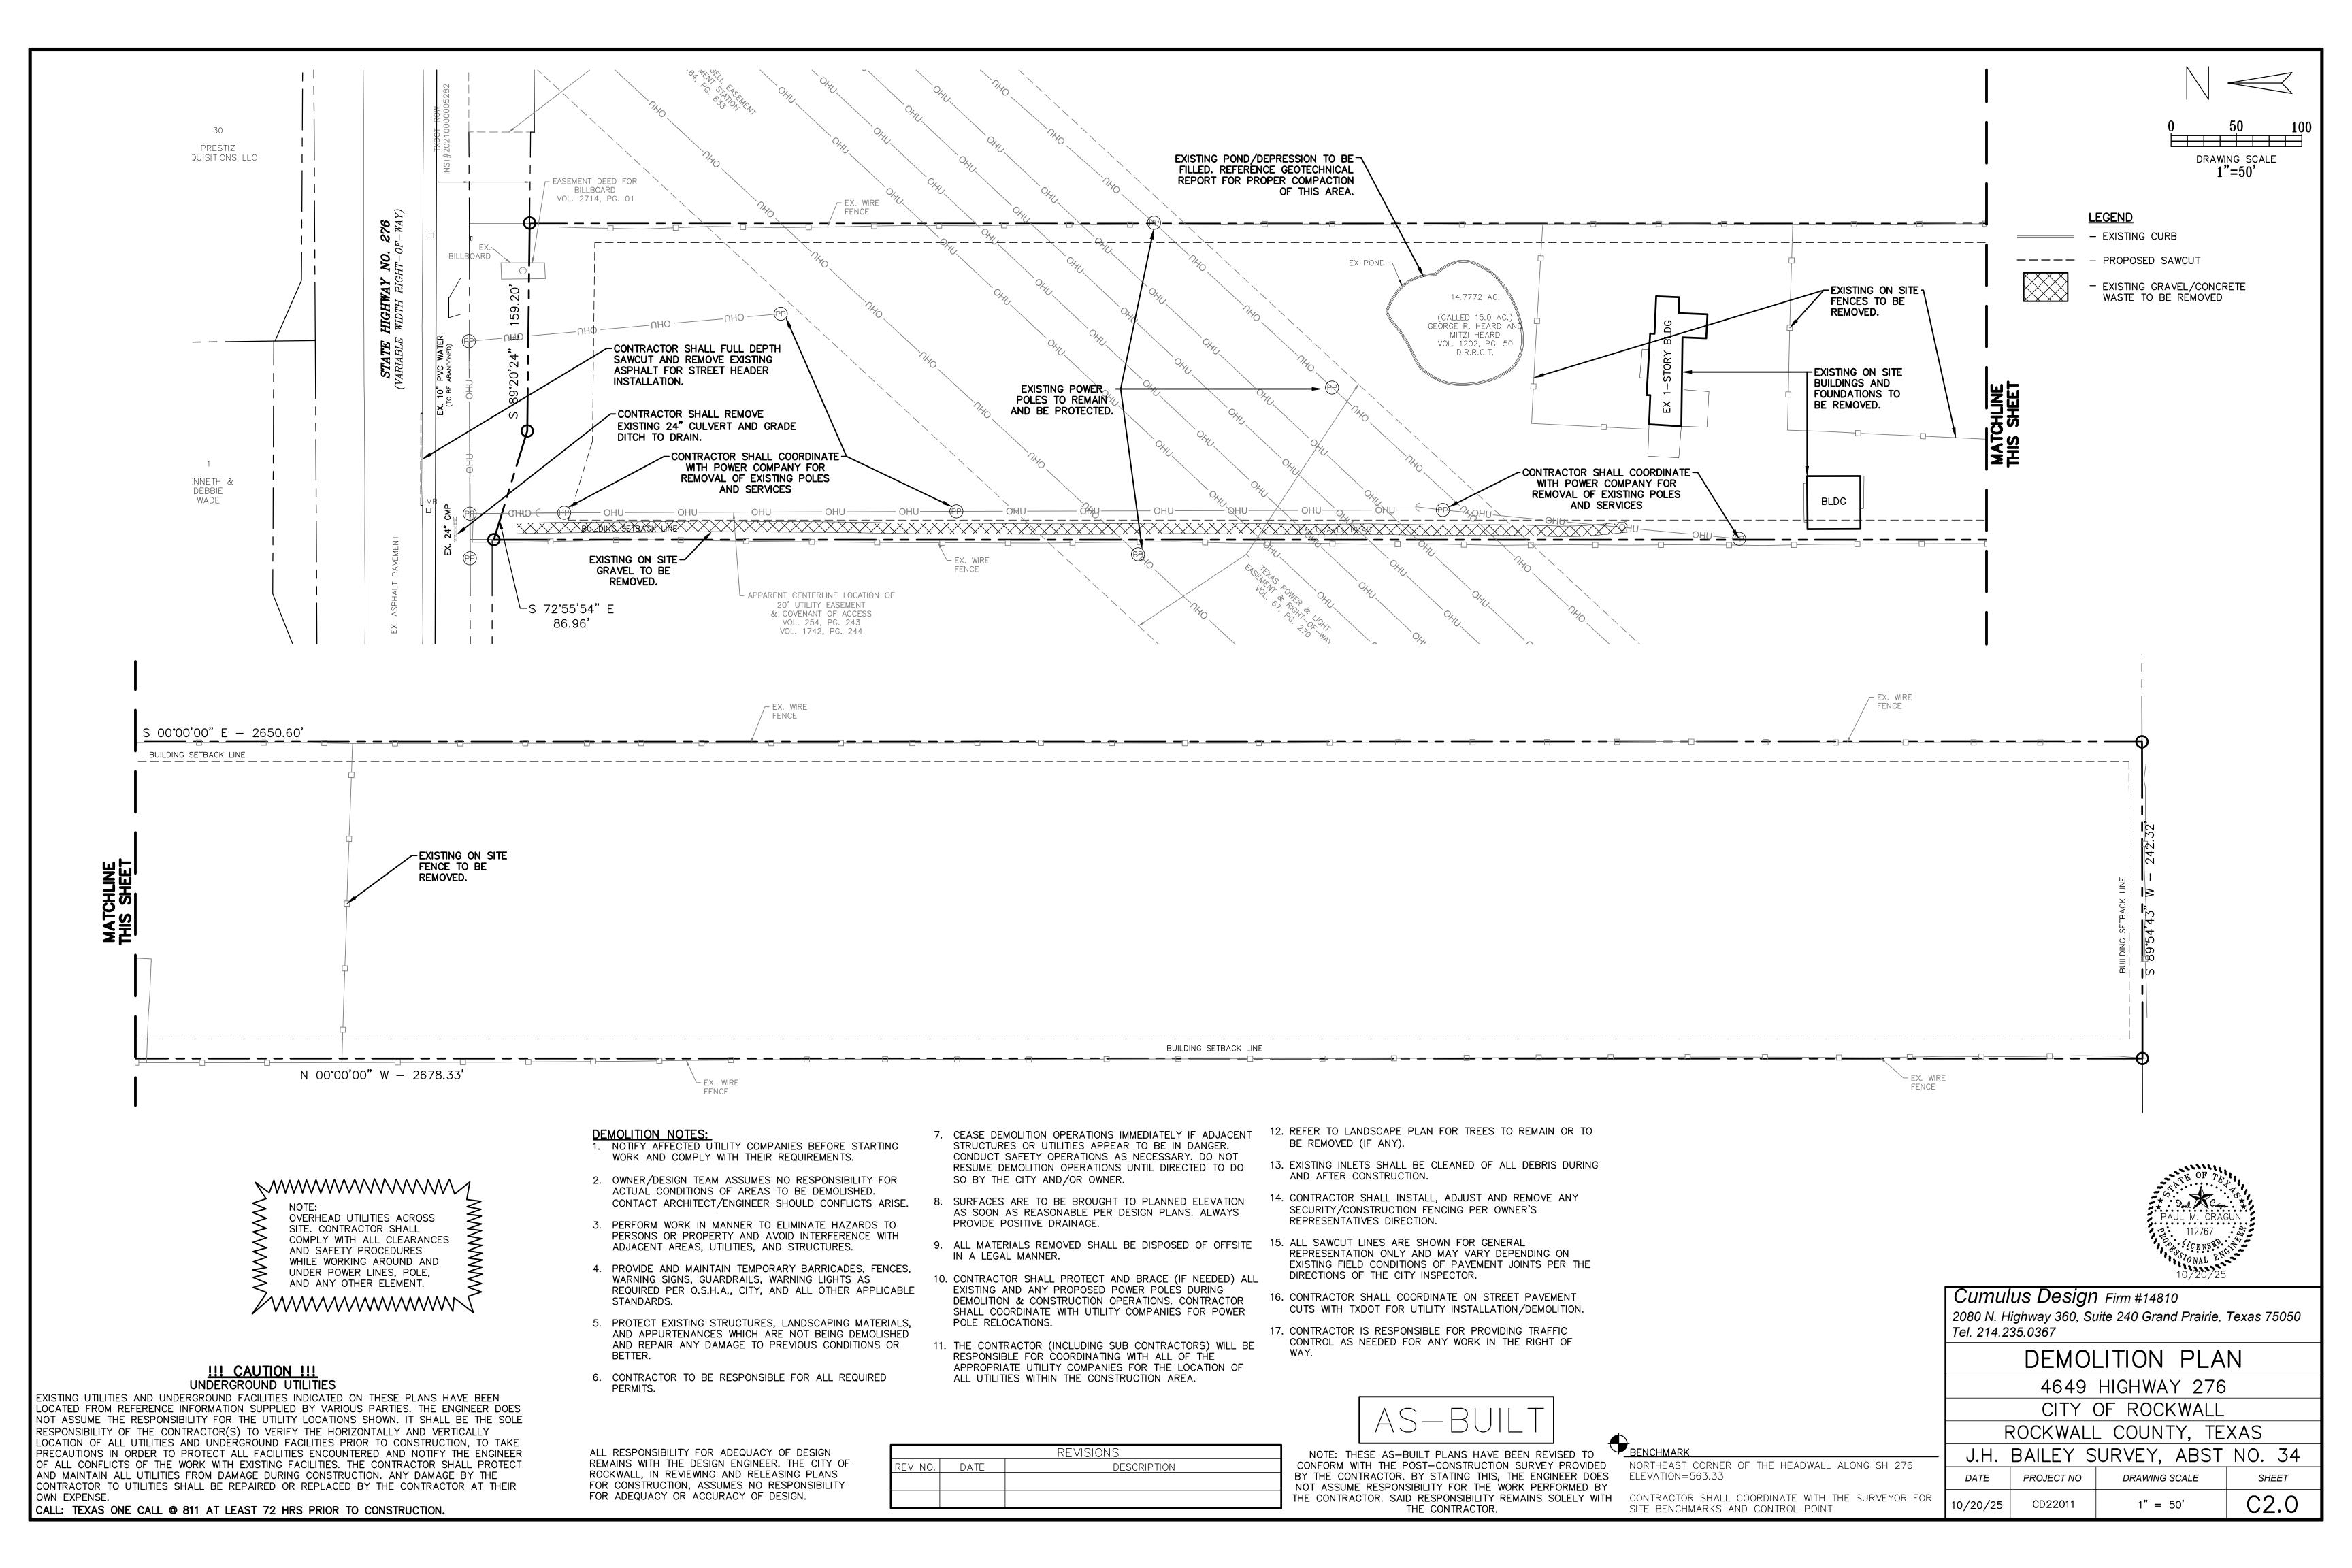

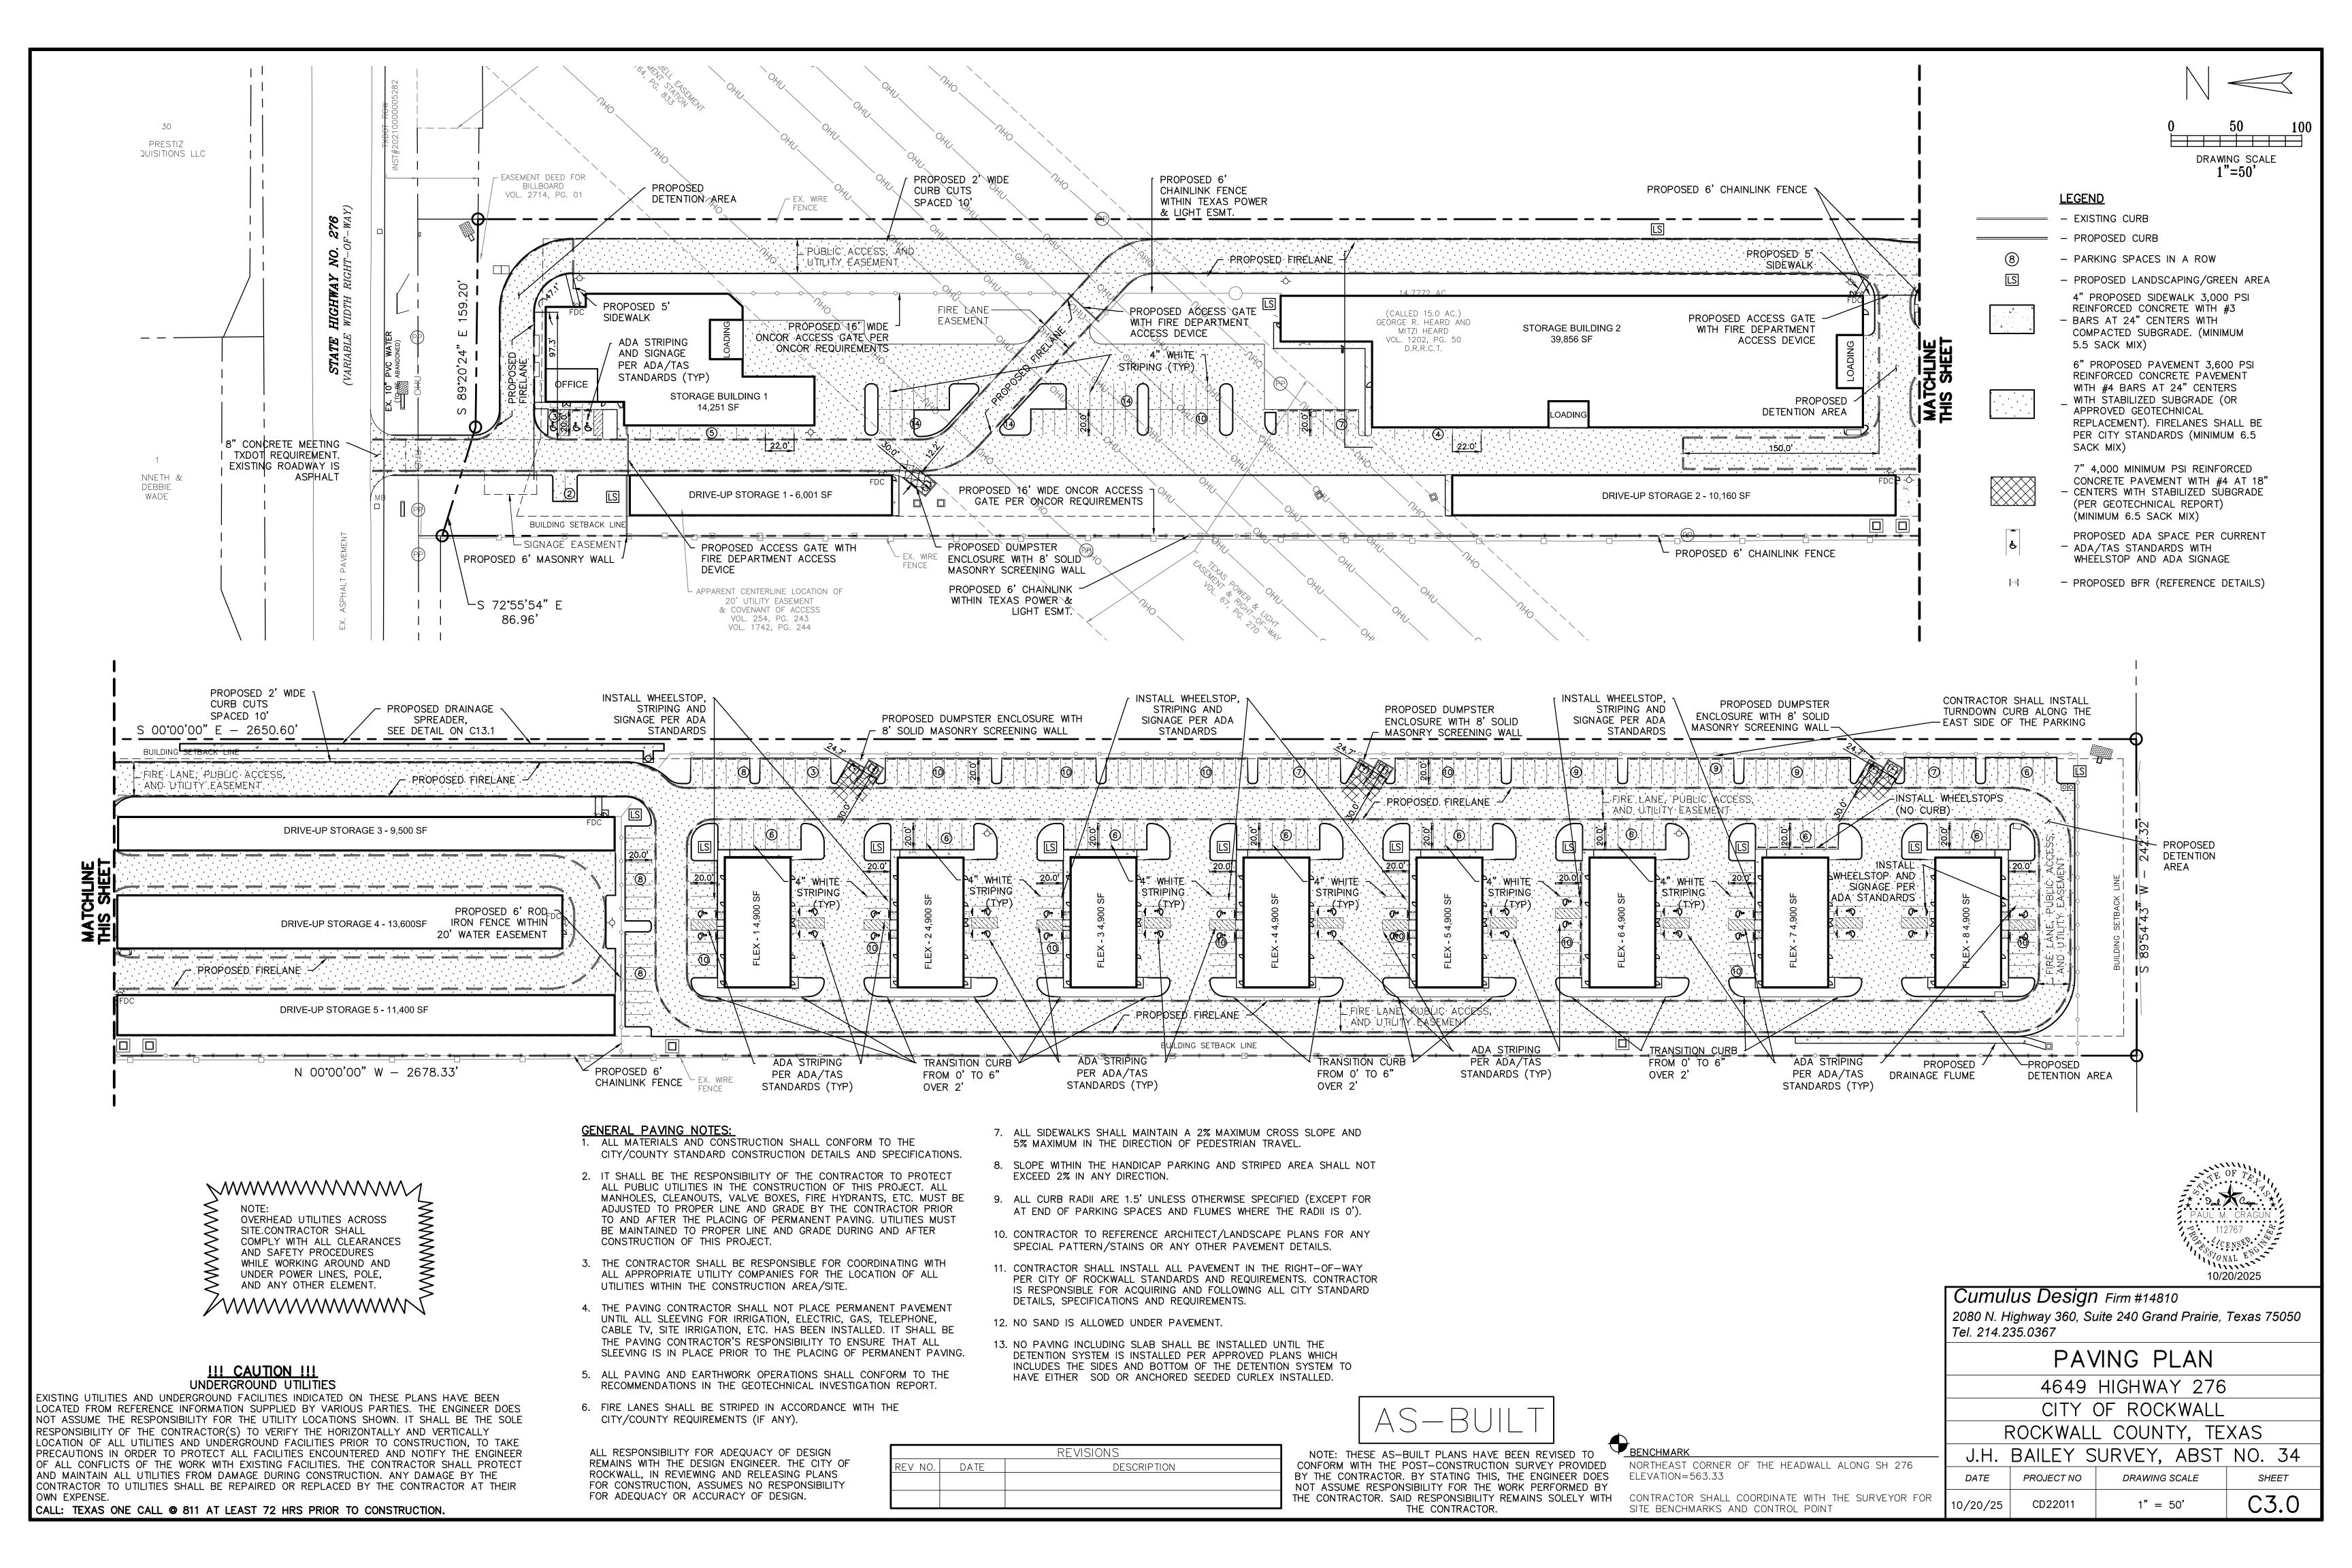

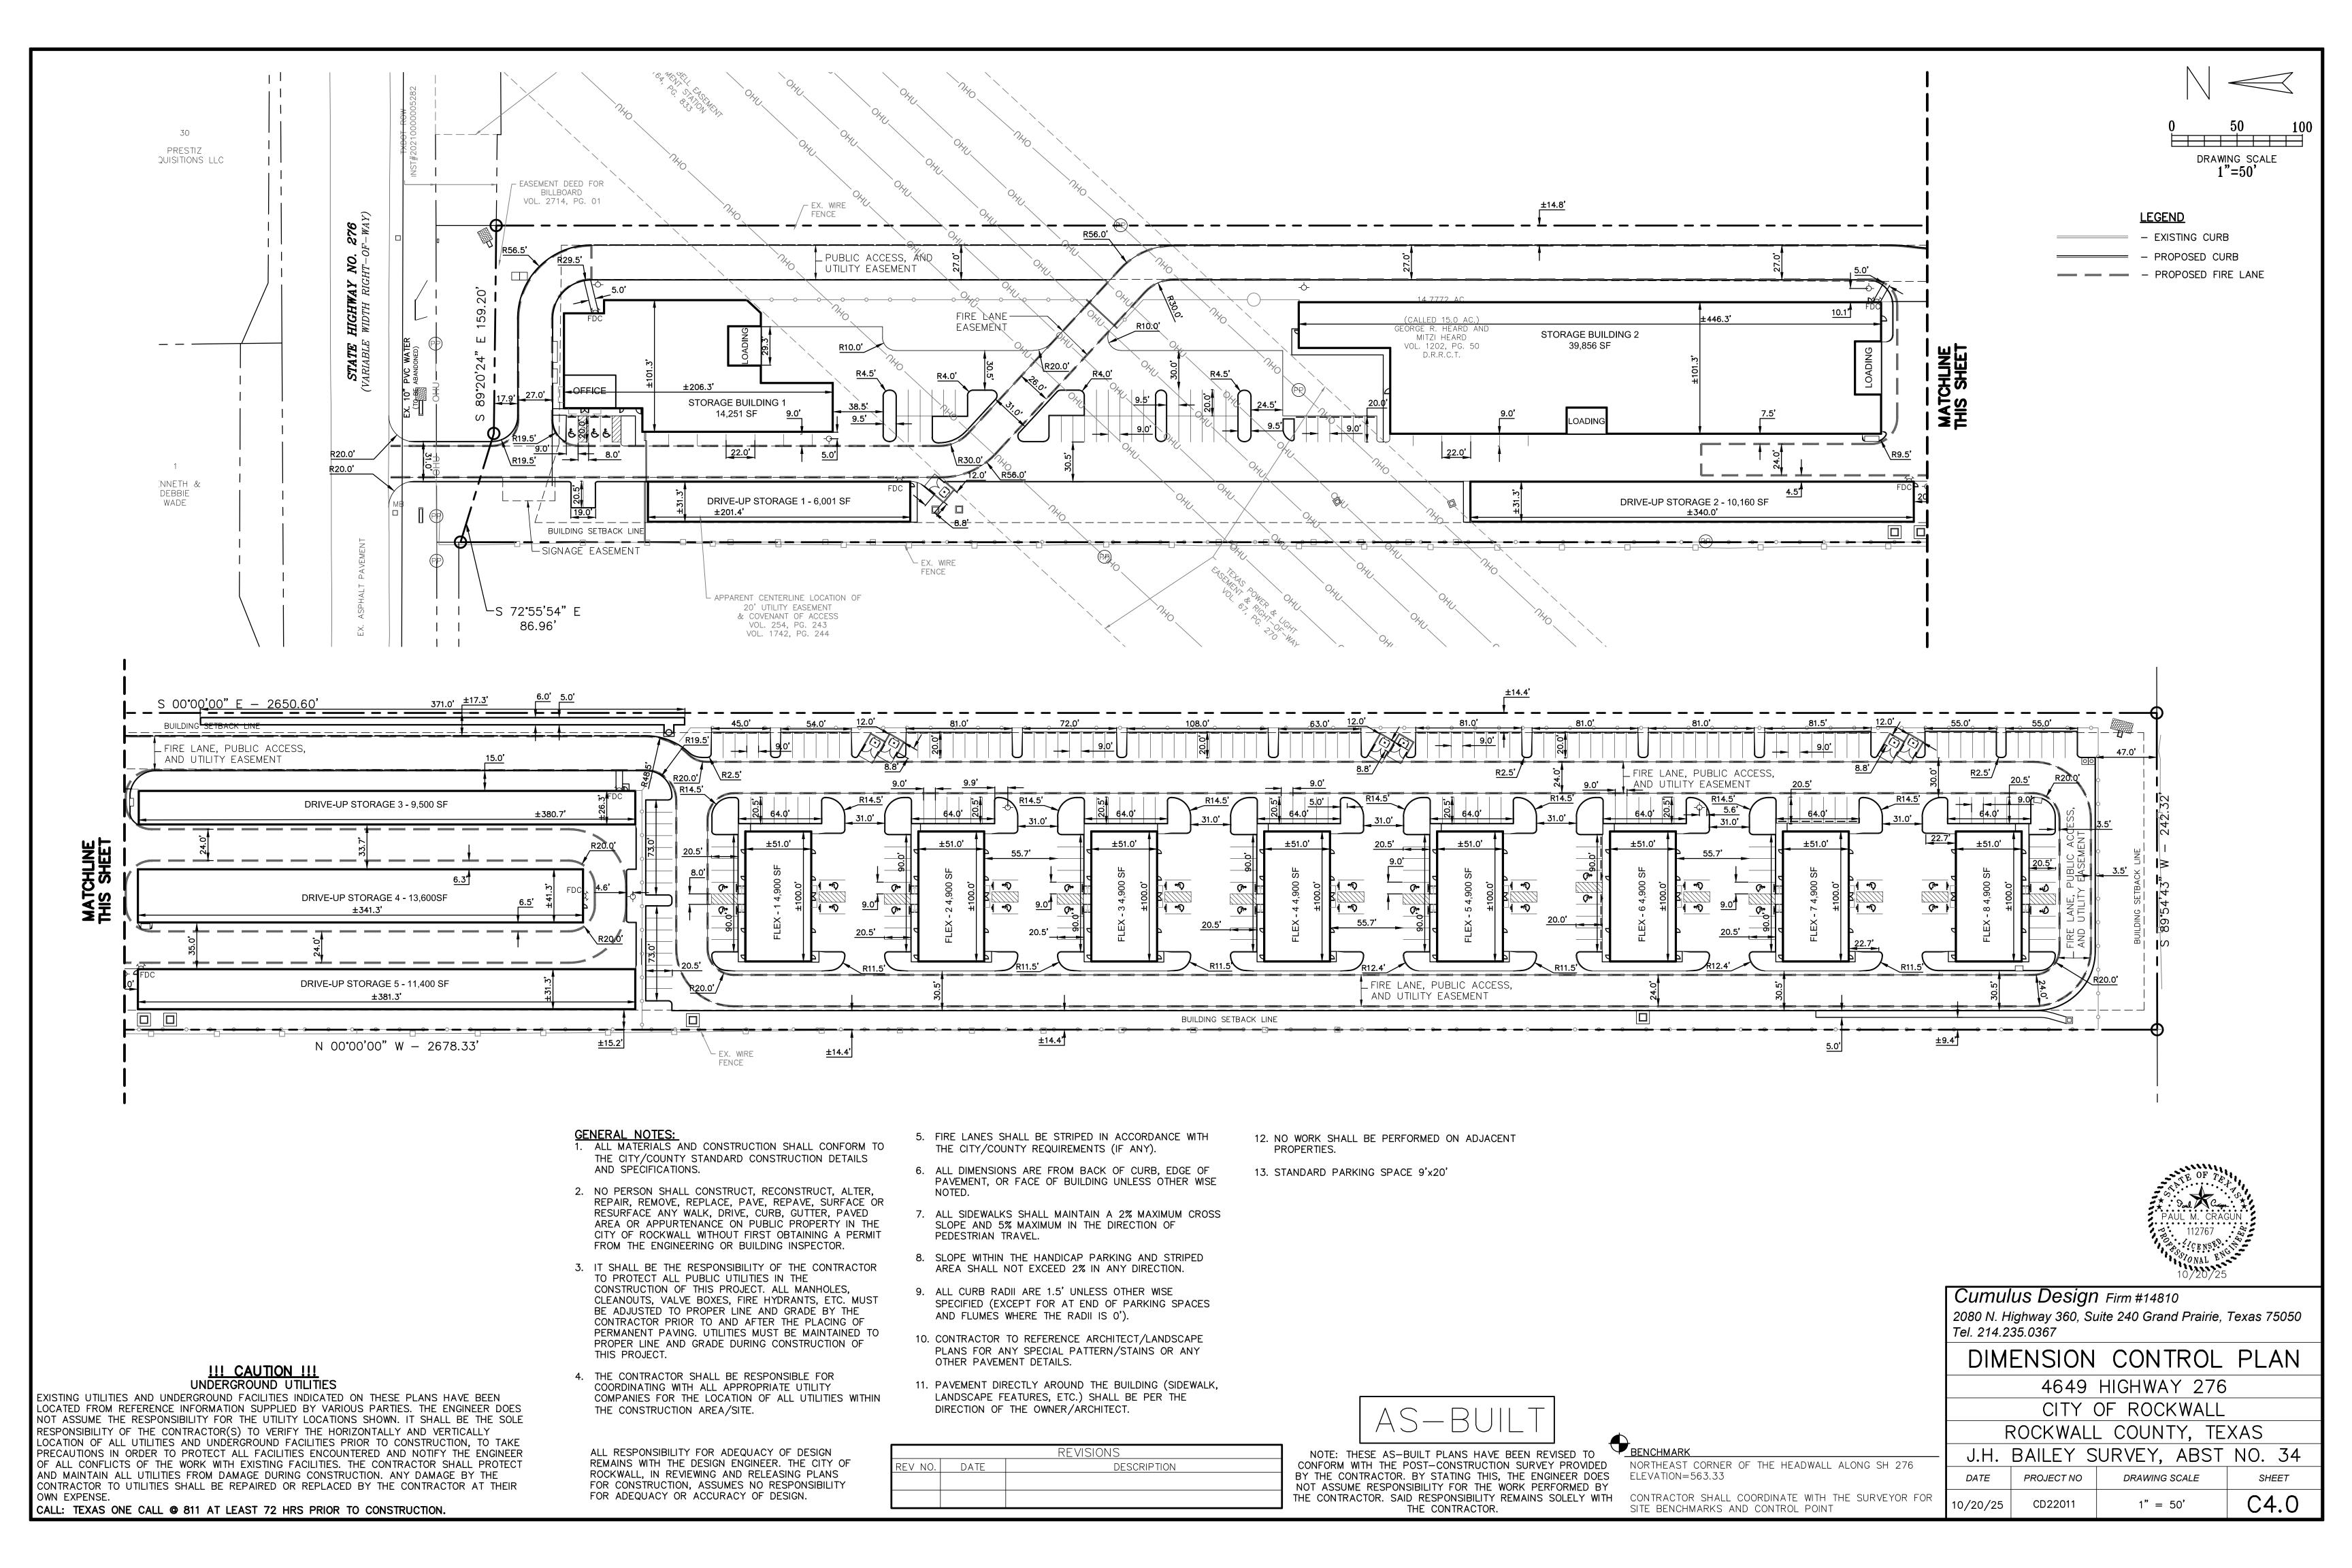

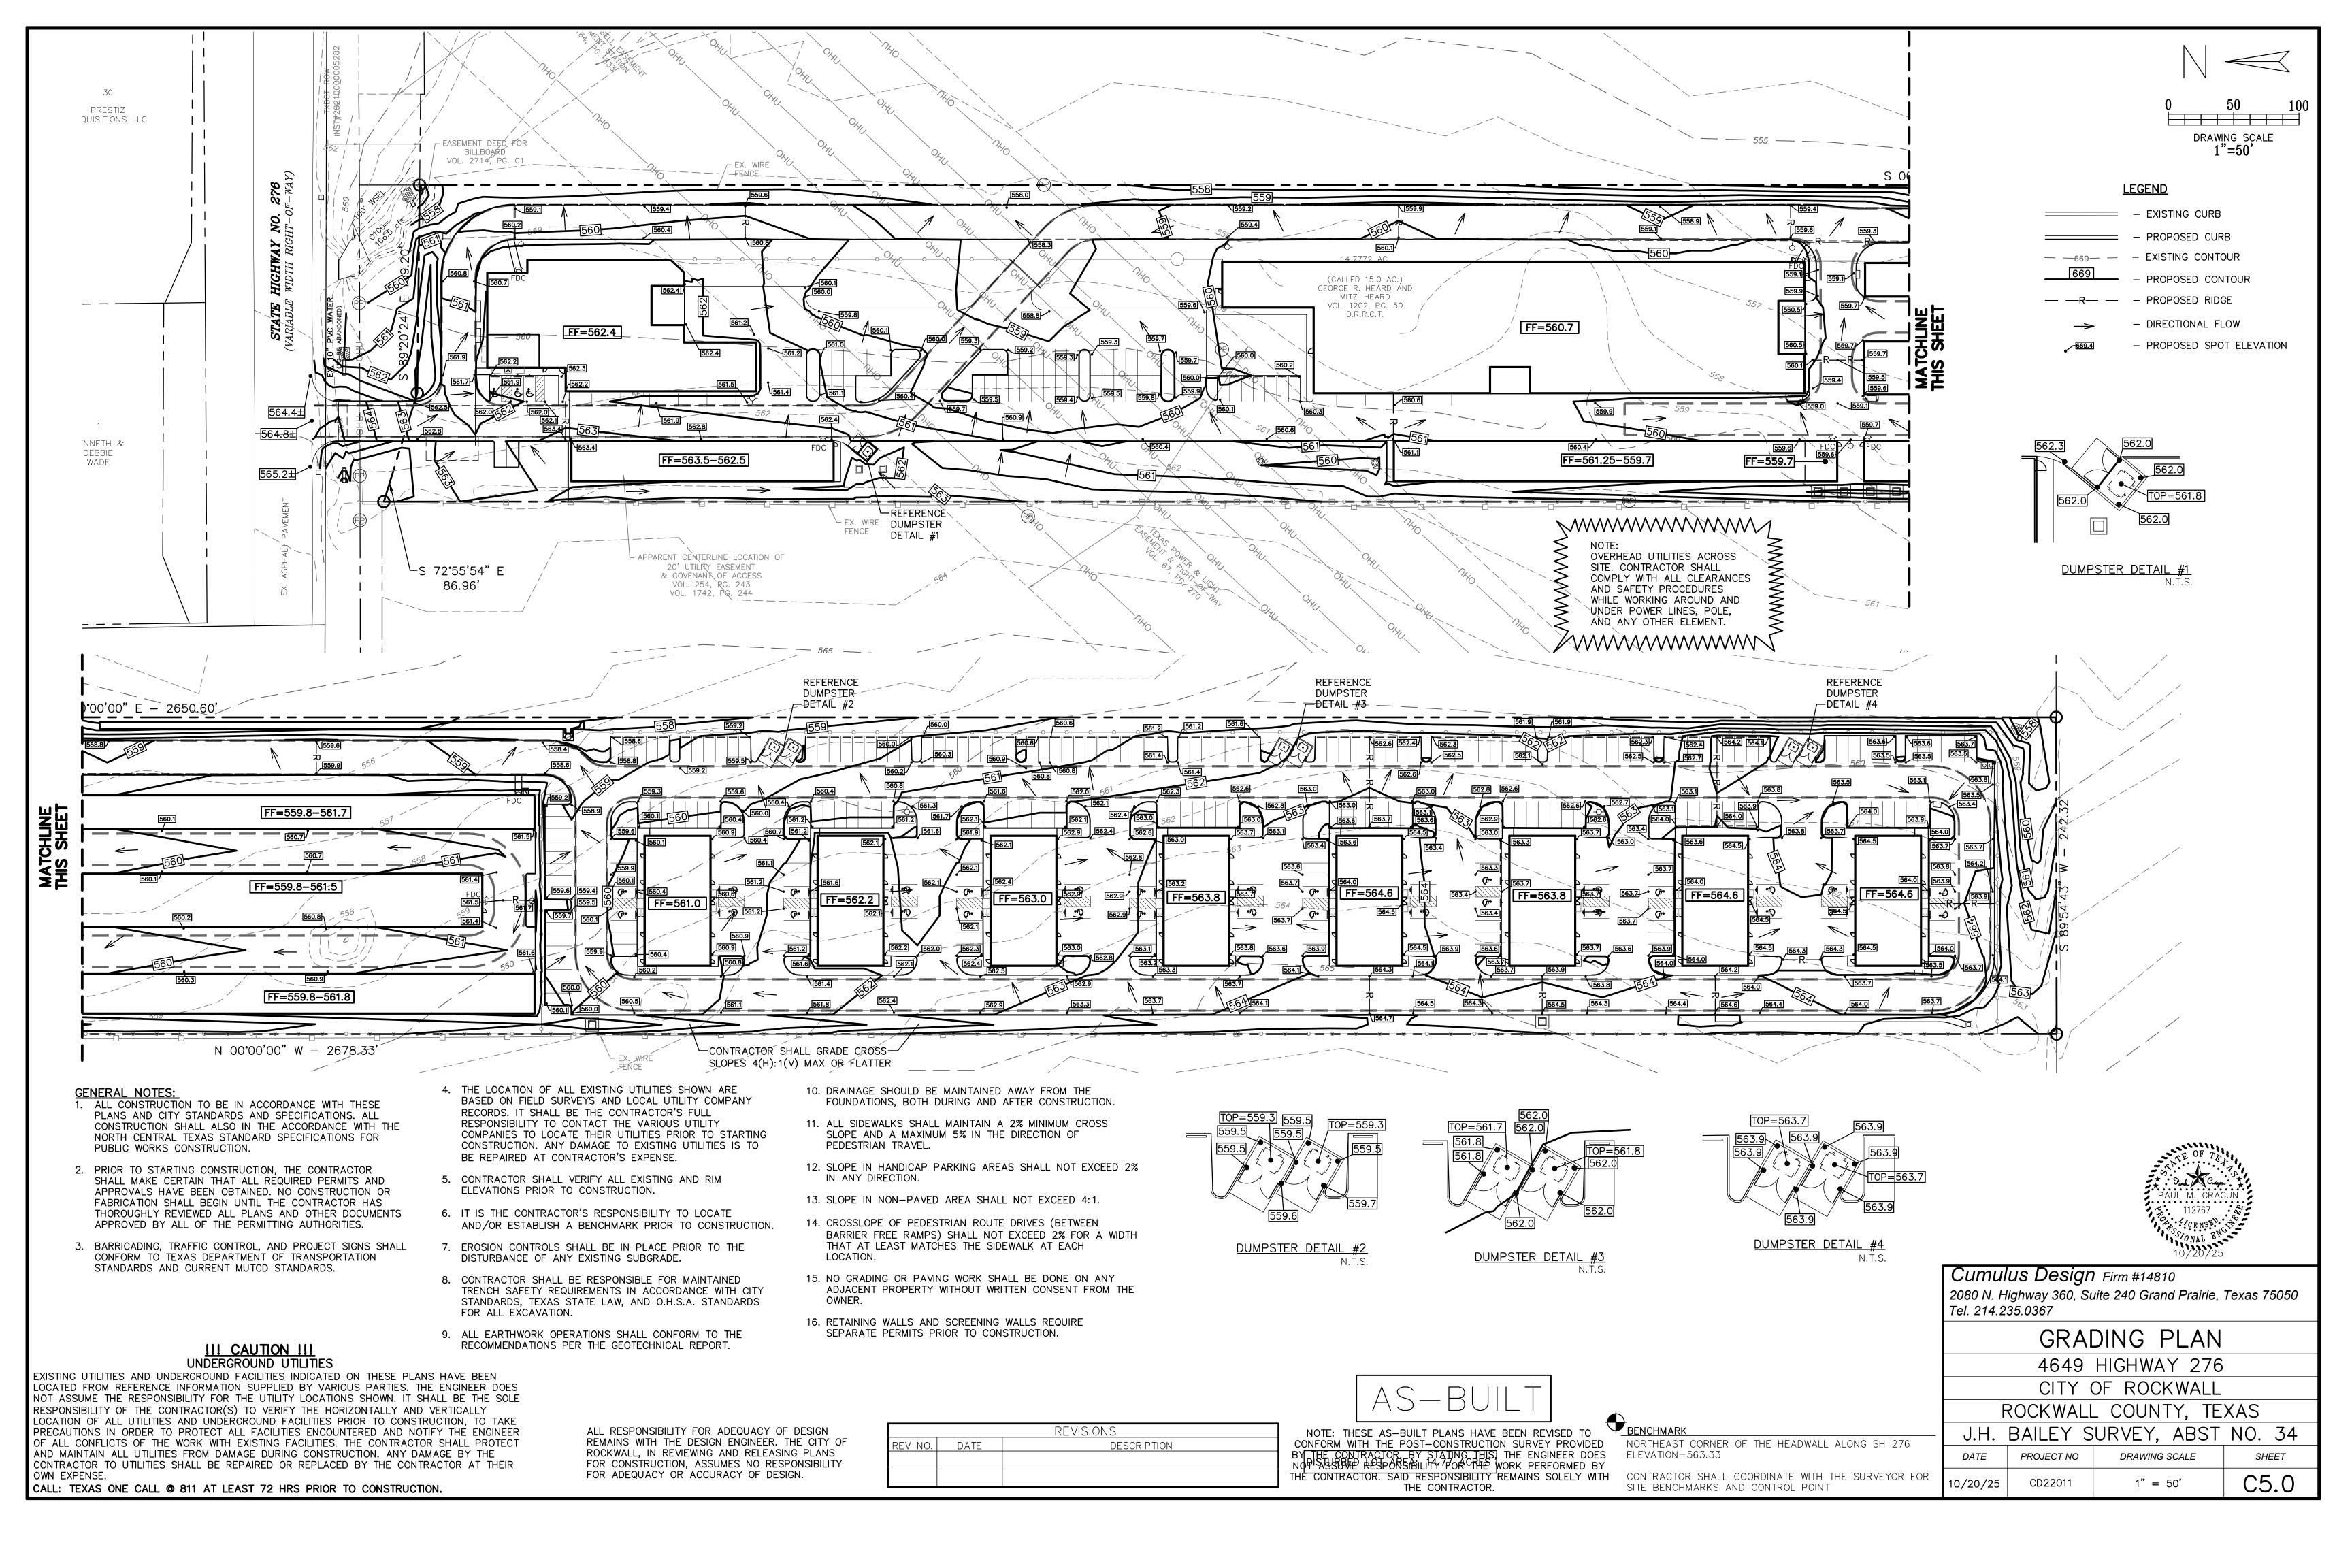

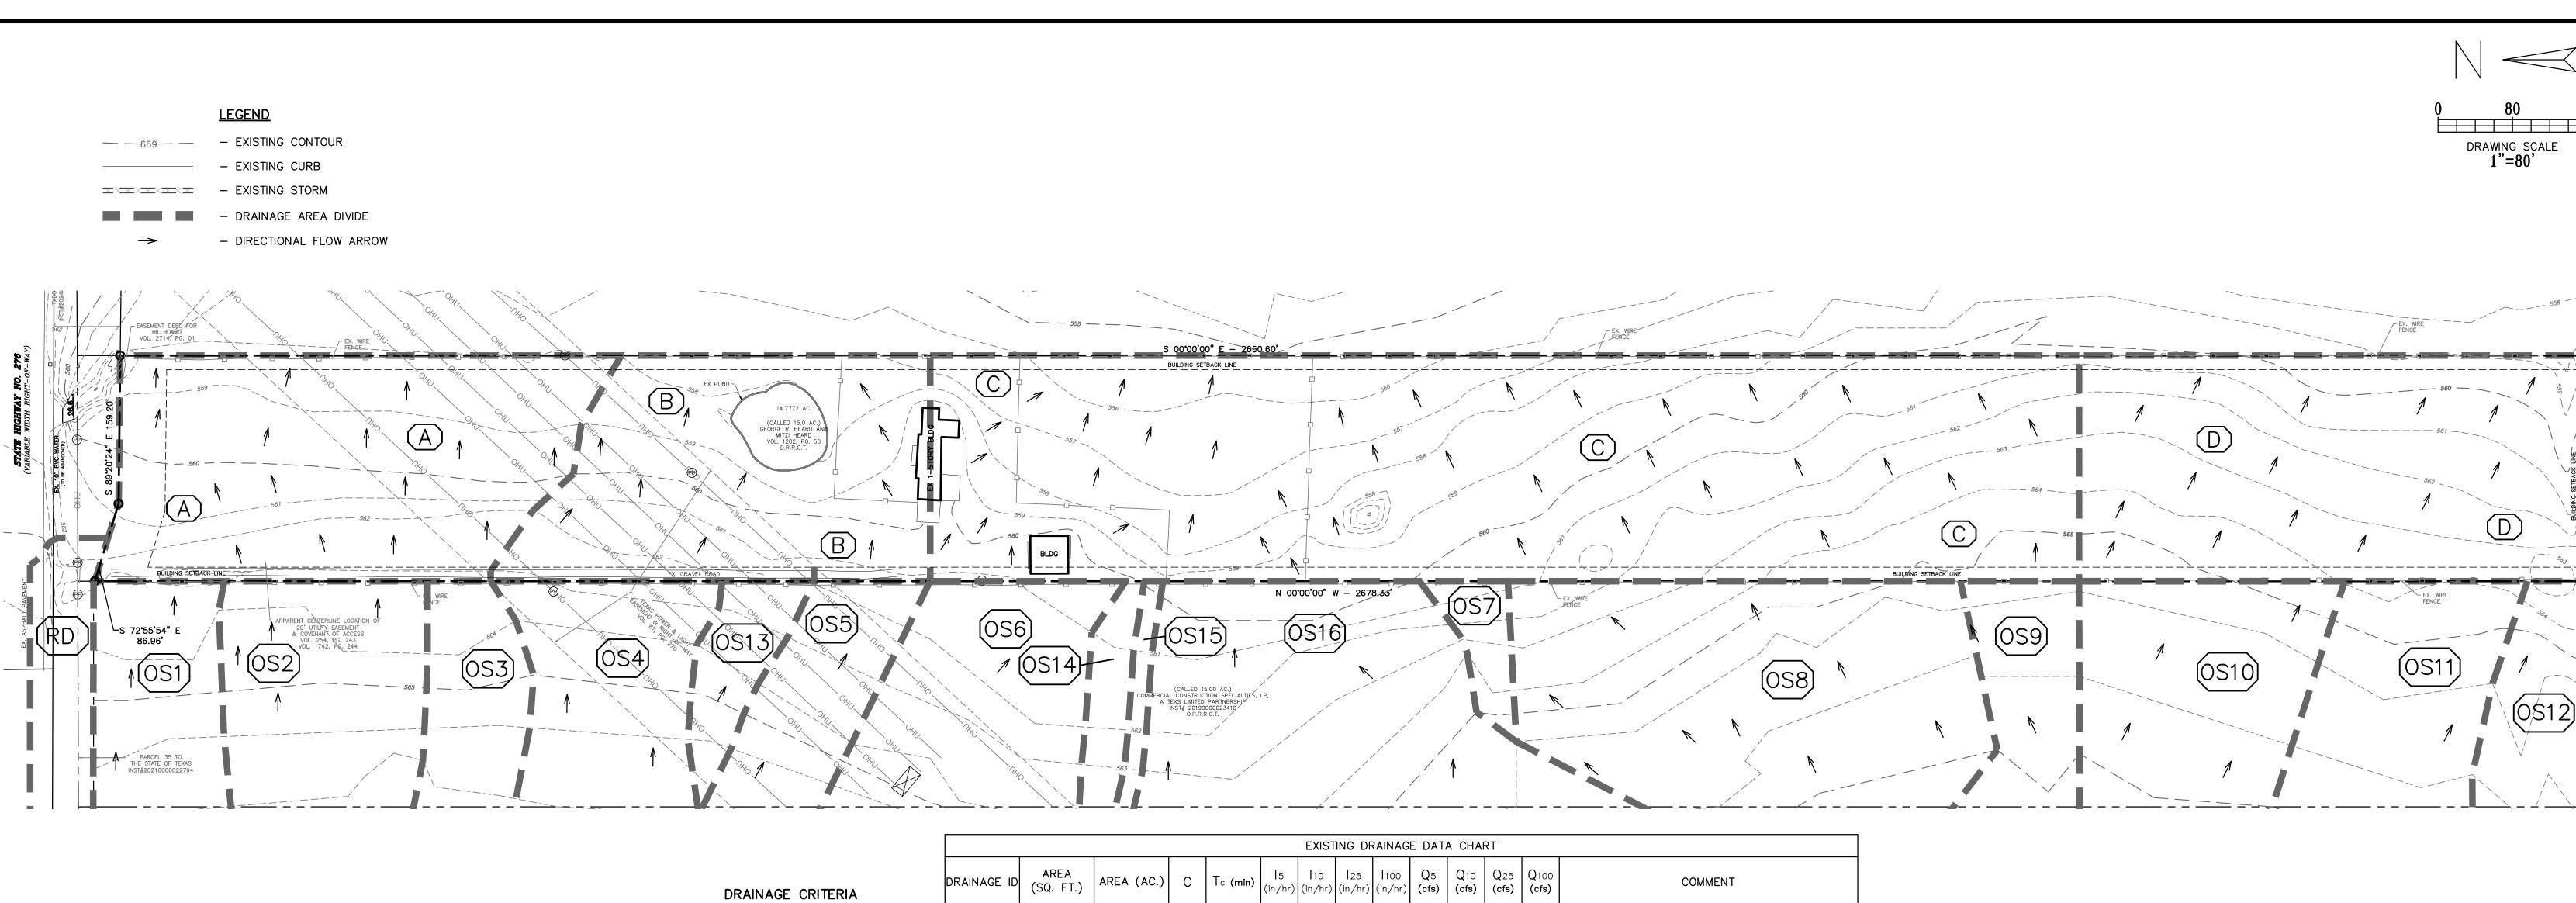

COMPOSITE C CALCULATIONS:

IMPERVIOUS AREA (0.9)=59159.1086 SF (1.36 ACRES) PERVIOUS AREA (0.35)=27885.0358 SF (0.64 ACRES) Cc = ((1.36\*0.9) + (0.64\*0.35))/(1.36+0.64) = 0.724

IMPERVIOUS AREA (0.9)=84845.8464 SF (1.95 ACRES) PERVIOUS AREA (0.35)=33963.9390 SF (0.78 ACRES) Cc = ((1.95\*0.9) + (0.78\*0.35))/(1.95+0.78) = 0.743

IMPERVIOUS AREA (0.9)=35626.1369 SF (0.82 ACRES) PERVIOUS AREA (0.35)=244.1552 SF (0.01 ACRES) Cc=((0.82\*0.9)+(0.01\*0.35))/(0.82+0.01)=0.893

IMPERVIOUS AREA (0.9)=99037.6267 SF (2.27 ACRES) PERVIOUS AREA (0.35)=23424.5402 SF (0.54 ACRES) Cc=((2.27\*0.9)+(0.54\*0.35))/(2.27+0.54)=0.794

IMPERVIOUS AREA (0.9)=33953.3932 SF (0.78 ACRES) PERVIOUS AREA (0.35)=9018.1673 SF (0.21 ACRES) Cc=((0.78\*0.9)+(0.21\*0.35))/(0.78+0.21)=0.783

IMPERVIOUS AREA (0.9)=157238.7179 SF (3.61 ACRES) PERVIOUS AREA (0.35)=411619.6819 SF (9.45 ACRES) Cc=((3.61\*0.9)+(9.45\*0.35))/(3.61+9.45)=0.502

!!! CAUTION !!! UNDERGROUND UTILITIES

CALL: TEXAS ONE CALL @ 811 AT LEAST 72 HRS PRIOR TO CONSTRUCTION.

EXISTING UTILITIES AND UNDERGROUND FACILITIES INDICATED ON THESE PLANS HAVE BEEN LOCATED FROM REFERENCE INFORMATION SUPPLIED BY VARIOUS PARTIES. THE ENGINEER DOES NOT ASSUME THE RESPONSIBILITY FOR THE UTILITY LOCATIONS SHOWN. IT SHALL BE THE SOLE RESPONSIBILITY OF THE CONTRACTOR(S) TO VERIFY THE HORIZONTALLY AND VERTICALLY LOCATION OF ALL UTILITIES AND UNDERGROUND FACILITIES PRIOR TO CONSTRUCTION, TO TAKE PRECAUTIONS IN ORDER TO PROTECT ALL FACILITIES ENCOUNTERED AND NOTIFY THE ENGINEER OF ALL CONFLICTS OF THE WORK WITH EXISTING FACILITIES. THE CONTRACTOR SHALL PROTECT AND MAINTAIN ALL UTILITIES FROM DAMAGE DURING CONSTRUCTION. ANY DAMAGE BY THE CONTRACTOR TO UTILITIES SHALL BE REPAIRED OR REPLACED BY THE CONTRACTOR AT THEIR OWN EXPENSE.

ALL RESPONSIBILITY FOR ADEQUACY OF DESIGN REMAINS WITH THE DESIGN ENGINEER. THE CITY OF ROCKWALL, IN REVIEWING AND RELEASING PLANS FOR CONSTRUCTION, ASSUMES NO RESPONSIBILITY FOR ADEQUACY OR ACCURACY OF DESIGN.

Q=C\*I\*A

tc=10/20 min. C=0.35/0.90

- AREA DESCRIPTION

						EXIST	ING DF	RAINAG	E DAT	A CHAF	<b>२</b> T		
DRAINAGE ID	AREA (SQ. FT.)	AREA (AC.)	С	Tc (min)			25 (in/hr)	  100 (in/hr)	Q5 (cfs)	Q <sub>10</sub> (cfs)	Q25 (cfs)	Q100 (cfs)	COMMENT
А	115633.10	2.65	0.35	20.0	4.9	5.9	6.6	8.3	4.6	5.5	6.1	7.7	DRAINS TO THE EAST OF PROPERTY
В	96551.20	2.22	0.35	20.0	4.9	5.9	6.6	8.3	3.8	4.6	5.1	6.4	DRAINS TO THE EAST OF PROPERTY
С	299094.72	6.87	0.35	20.0	4.9	5.9	6.6	8.3	11.8	14.2	15.9	19.9	DRAINS TO THE EAST OF PROPERTY
D	132417.51	3.04	0.35	20.0	4.9	5.9	6.6	8.3	5.2	6.3	7.0	8.8	DRAINS TO THE EAST OF PROPERTY
TOTAL SITE	643696.54	14.78							25.3	30.5	34.1	42.9	TOTAL SITE STORMWATER FLOW
OS1	87044.14	2.00	0.72	10.0	6.1	7.1	8.3	9.8	8.8	10.3	12.0	14.2	DRAINS TO DRAINAGE AREA "B1"
OS2	118809.79	2.73	0.74	10.0	6.1	7.1	8.3	9.8	12.4	14.4	16.8	19.9	DRAINS TO DRAINAGE AREA "E"
OS3	35870.29	0.82	0.89	10.0	6.1	7.1	8.3	9.8	4.5	5.2	6.1	7.2	DRAINS TO DRAINAGE AREA "E"
0S4	122462.17	2.81	0.73	10.0	6.1	7.1	8.3	9.8	12.5	14.5	16.9	20.0	DRAINS TO DRAINAGE AREA "F1"
0\$5	42971.56	0.99	0.78	10.0	6.1	7.1	8.3	9.8	4.7	5.5	6.4	7.6	DRAINS TO DRAINAGE AREA "L1"
OS6	72969.47	1.68	0.77	10.0	6.1	7.1	8.3	9.8	7.9	9.2	10.7	12.7	DRAINS TO DRAINAGE AREA "L1"
0S7	8781.38	0.20	0.90	10.0	6.1	7.1	8.3	9.8	1.1	1.3	1.5	1.8	DRAINS TO DRAINAGE AREA "L4"
0S8	158049.17	3.63	0.35	10.0	6.1	7.1	8.3	9.8	7.7	9.0	10.5	12.4	DRAINS TO DRAINAGE AREA "Q"
OS9	64042.26	1.47	0.35	10.0	6.1	7.1	8.3	9.8	3.1	3.7	4.3	5.0	DRAINS TO DRAINAGE AREA "Q"
OS10	92871.32	2.13	0.35	20.0	4.9	5.9	6.6	8.3	3.7	4.4	4.9	6.2	DRAINS TO DRAINAGE AREA "S"
OS11	134646.66	3.09	0.35	20.0	4.9	5.9	6.6	8.3	5.3	6.4	7.1	9.0	DRAINS TO DRAINAGE AREA "V"
OS12	79822.69	1.83	0.35	20.0	4.9	5.9	6.6	8.3	3.1	3.8	4.2	5.3	DRAINS TO DRAINAGE AREA "Z"
0S13	15349.45	0.35	0.90	10.0	6.1	7.1	8.3	9.8	1.9	2.3	2.6	3.1	DRAINS TO DRAINAGE AREA "F2"
OS14	89977.96	2.07	0.41	10.0	6.1	7.1	8.3	9.8	5.2	6.1	7.1	8.4	DRAINS TO DRAINAGE AREA "L2"
OS15	64978.60	1.49	0.39	10.0	6.1	7.1	8.3	9.8	3.6	4.1	4.8	5.7	DRAINS TO DRAINAGE AREA "L3"
OS16	340967.12	7.83	0.49	10.0	6.1	7.1	8.3	9.8	23.3	27.2	31.8	37.5	DRAINS TO DRAINAGE AREA "L4"
RD	42337.70	0.97	0.90	10.0	6.1	7.1	8.3	9.8	5.3	6.2	7.3	8.6	DRAINS TO PROPOSED CULVERT
TOTAL OFFSITE	1018340.92	23.38							114.2	133.4	155.2	184.5	

NOTE: CITY OF ROCKWALL STANDARDS OF DESIGN AND CONSTRUCTION OCTOBER 2019 WAS USED FOR RUNOFF COEFFICIENTS AND INTENSITY VALUES. A WEIGHTED RUNOFF COEFFICIENT HAS BEEN CALCULATED FOR DRAINAGE AREA OS1, OS2, OS3, OS4, OS5, AND OS6, SINCE DIFFERENT LAND TYPES ARE CONTRIBUTING TO A DISCHARGE DESIGN POINT.

AS-BUILT

)VIDED : DOES ED BY THE CONTRACTOR.

BENCHMARK NORTHEAST CORNER OF THE HEADWALL ALONG SH 276 ELEVATION=563.33 CONTRACTOR SHALL COORDINATE WITH THE SURVEYOR FOR

SITE BENCHMARKS AND CONTROL POINT

EXISTING DRAINAGE AREA MAP 4649 HIGHWAY 276 CITY OF ROCKWALL ROCKWALL COUNTY, TEXAS


2080 N. Highway 360, Suite 240 Grand Prairie, Texas 75050


Cumulus Design Firm #14810


Tel. 214.235.0367

J.H. BAILEY SURVEY, ABST NO. 34 PROJECT NO DRAWING SCALE C6.0 10/20/25 1" = 80' CD22011

		REVISIONS	NOTE: THESE AS-BUILT PLANS HAVE BEEN REVISED T
REV NO.	DATE	DESCRIPTION	CONFORM WITH THE POST-CONSTRUCTION SURVEY PROVI
			BY THE CONTRACTOR. BY STATING THIS, THE ENGINEER D
			■ NOT ASSUME RESPONSIBILITY FOR THE WORK PERFORMED
			THE CONTRACTOR. SAID RESPONSIBILITY REMAINS SOLELY

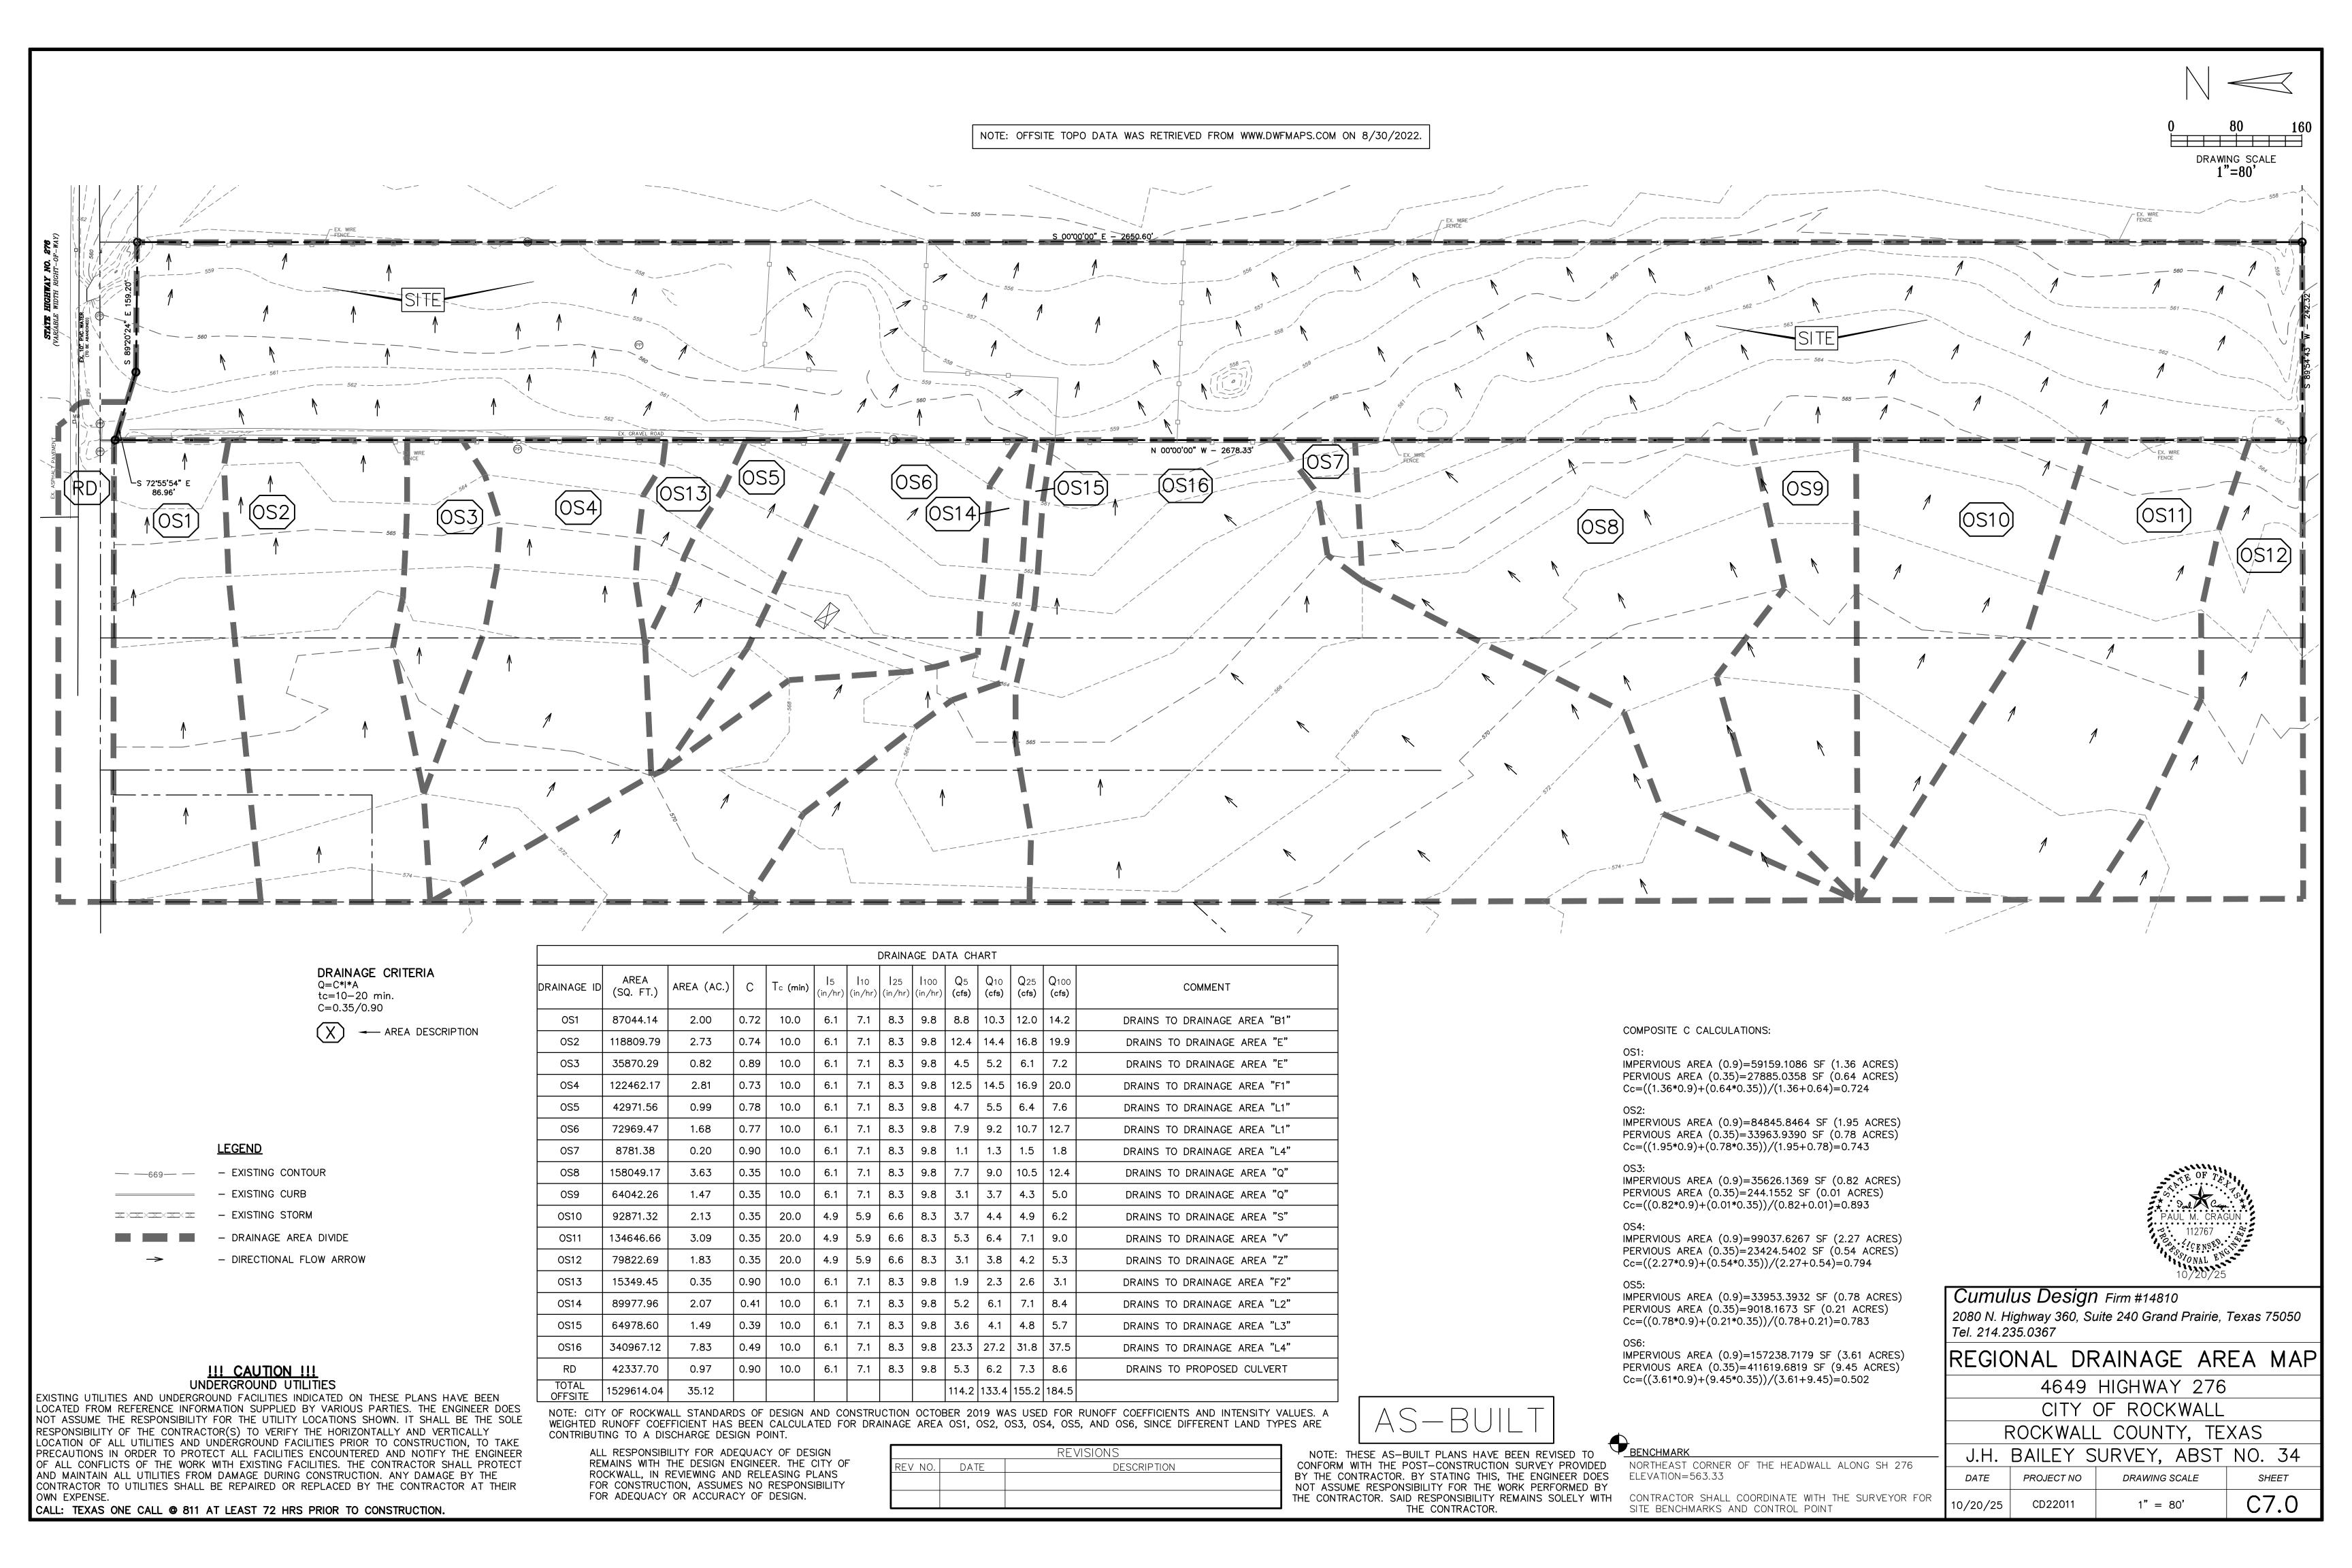

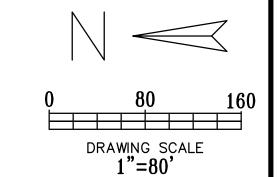

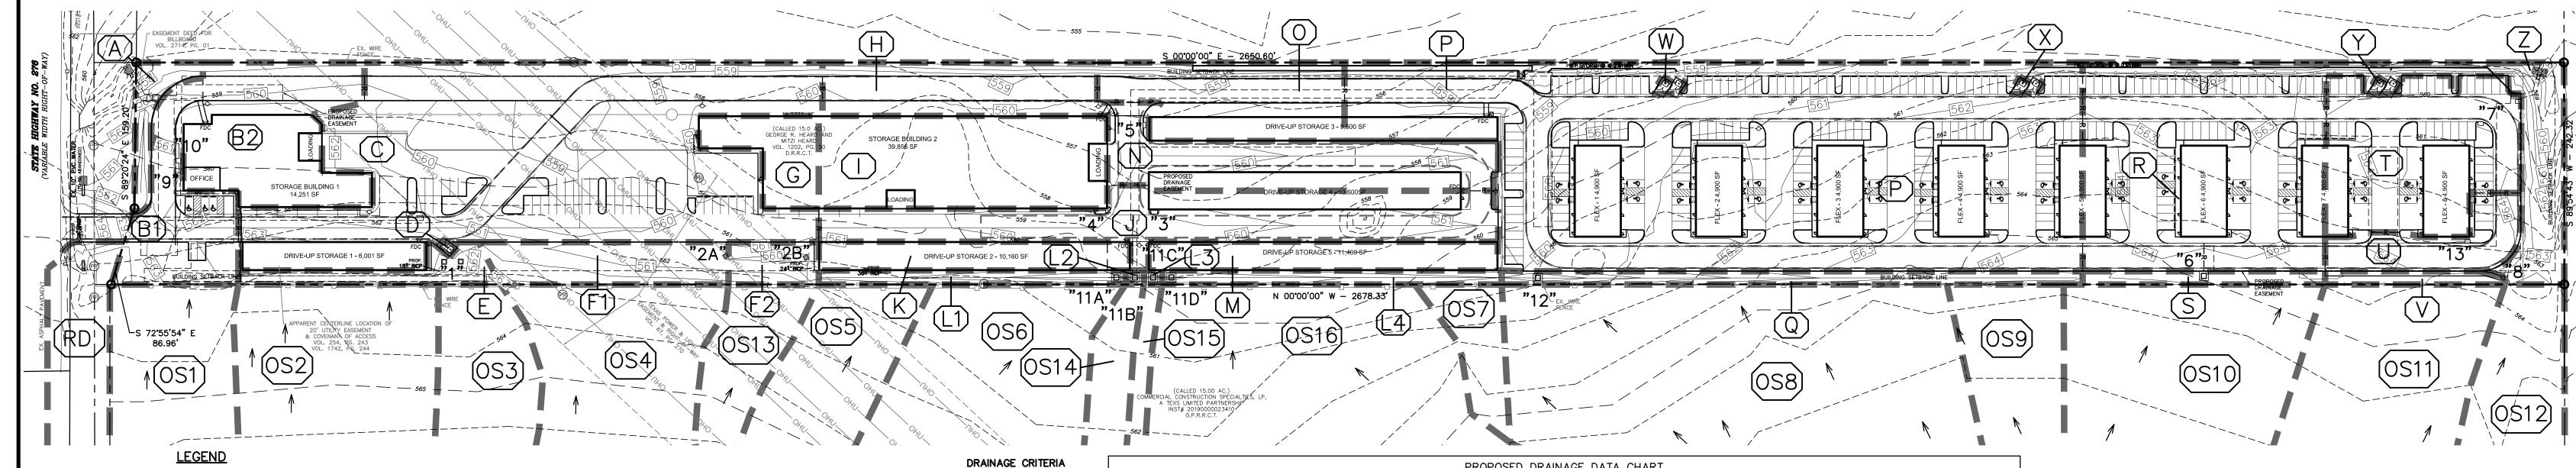

REVISIONS

DESCRIPTION

REV NO. DATE

	- DRA	INAGE AREA	DIVIDE			
<b>→</b>	– DIRE	ECTIONAL FLO	)W ARF	ROW		
						PR
DRAINAGE ID	AREA (SQ. FT.)	AREA (AC.)	С	Tc (min)	5 (in/hr)	- (in,
OS1	87044.14	2.00	0.72	10.0	6.1	7
	_	, and the second				

EXISTING CONTOUR

						PROPO	SED D	RAINA	GE DA	TA CHA	ART		
DRAINAGE ID	AREA (SQ. FT.)	AREA (AC.)	С	Tc (min)			125 (in/hr)	1100 (in/hr)	Q5 (cfs)	Q10 (cfs)	Q25 (cfs)	Q100 (cfs)	COMMENT
OS1	87044.14	2.00	0.72	10.0	6.1	7.1	8.3	9.8	8.8	10.3	12.0	14.2	DRAINS TO DRAINAGE AREA "B1"
OS2	118809.79	2.73	0.74	10.0	6.1	7.1	8.3	9.8	12.4	14.4	16.8	19.9	DRAINS TO DRAINAGE AREA "E"
OS3	35870.29	0.82	0.89	10.0	6.1	7.1	8.3	9.8	4.5	5.2	6.1	7.2	DRAINS TO DRAINAGE AREA "E"
OS4	122462.17	2.81	0.73	10.0	6.1	7.1	8.3	9.8	12.5	14.5	16.9	20.0	DRAINS TO DRAINAGE AREA "F1"
OS5	42971.56	0.99	0.78	10.0	6.1	7.1	8.3	9.8	4.7	5.5	6.4	7.6	DRAINS TO DRAINAGE AREA "L1"
OS6	72969.47	1.68	0.77	10.0	6.1	7.1	8.3	9.8	7.9	9.2	10.7	12.7	DRAINS TO DRAINAGE AREA "L1"
0S7	8781.38	0.20	0.90	10.0	6.1	7.1	8.3	9.8	1.1	1.3	1.5	1.8	DRAINS TO DRAINAGE AREA "L4"
OS8	158049.17	3.63	0.35	10.0	6.1	7.1	8.3	9.8	7.7	9.0	10.5	12.4	DRAINS TO DRAINAGE AREA "Q"
OS9	64042.26	1.47	0.35	10.0	6.1	7.1	8.3	9.8	3.1	3.7	4.3	5.0	DRAINS TO DRAINAGE AREA "Q"
OS10	92871.32	2.13	0.35	20.0	4.9	5.9	6.6	8.3	3.7	4.4	4.9	6.2	DRAINS TO DRAINAGE AREA "S"
OS11	134646.66	3.09	0.35	20.0	4.9	5.9	6.6	8.3	5.3	6.4	7.1	9.0	DRAINS TO DRAINAGE AREA "V"
OS12	79822.69	1.83	0.35	20.0	4.9	5.9	6.6	8.3	3.1	3.8	4.2	5.3	DRAINS TO DRAINAGE AREA "Z"
OS13	15349.45	0.35	0.90	10.0	6.1	7.1	8.3	9.8	1.9	2.3	2.6	3.1	DRAINS TO DRAINAGE AREA "F2"
OS14	89977.96	2.07	0.41	10.0	6.1	7.1	8.3	9.8	5.2	6.1	7.1	8.4	DRAINS TO DRAINAGE AREA "L2"
OS15	64978.60	1.49	0.39	10.0	6.1	7.1	8.3	9.8	3.6	4.1	4.8	5.7	DRAINS TO DRAINAGE AREA "L3"
OS16	340967.12	7.83	0.49	10.0	6.1	7.1	8.3	9.8	23.3	27.2	31.8	37.5	DRAINS TO DRAINAGE AREA "L4"
RD	42337.70	0.97	0.90	10.0	6.1	7.1	8.3	9.8	5.3	6.2	7.3	8.6	DRAINS TO PROPOSED CULVERT
TOTAL OFFSITE	1529614.04	35.12							114.2	133.4	155.2	184.5	

NOTE: CITY OF ROCKWALL STANDARDS OF DESIGN AND CONSTRUCTION OCTOBER 2019 WAS USED FOR RUNOFF COEFFICIENTS AND INTENSITY VALUES. A WEIGHTED RUNOFF COEFFICIENT HAS BEEN CALCULATED FOR DRAINAGE AREA OS1, OS2, OS3, OS4, OS5, OS6, OS14, OS15, AND OS16, SINCE DIFFERENT LAND TYPES ARE CONTRIBUTING TO A DISCHARGE DESIGN POINT.

# !!! CAUTION !!!

EXISTING UTILITIES AND UNDERGROUND FACILITIES INDICATED ON THESE PLANS HAVE BEEN LOCATED FROM REFERENCE INFORMATION SUPPLIED BY VARIOUS PARTIES. THE ENGINEER DOES NOT ASSUME THE RESPONSIBILITY FOR THE UTILITY LOCATIONS SHOWN. IT SHALL BE THE SOLE RESPONSIBILITY OF THE CONTRACTOR(S) TO VERIFY THE HORIZONTALLY AND VERTICALLY LOCATION OF ALL UTILITIES AND UNDERGROUND FACILITIES PRIOR TO CONSTRUCTION, TO TAKE PRECAUTIONS IN ORDER TO PROTECT ALL FACILITIES ENCOUNTERED AND NOTIFY THE ENGINEER OF ALL CONFLICTS OF THE WORK WITH EXISTING FACILITIES. THE CONTRACTOR SHALL PROTECT AND MAINTAIN ALL UTILITIES FROM DAMAGE DURING CONSTRUCTION. ANY DAMAGE BY THE CONTRACTOR TO UTILITIES SHALL BE REPAIRED OR REPLACED BY THE CONTRACTOR AT THEIR OWN EXPENSE.

CALL: TEXAS ONE CALL @ 811 AT LEAST 72 HRS PRIOR TO CONSTRUCTION.

ALL RESPONSIBILITY FOR ADEQUACY OF DESIGN REMAINS WITH THE DESIGN ENGINEER. THE CITY OF ROCKWALL, IN REVIEWING AND RELEASING PLANS FOR CONSTRUCTION, ASSUMES NO RESPONSIBILITY FOR ADEQUACY OR ACCURACY OF DESIGN.

DRAINAGE CRITERIA Q=C*I*A		PROPOSED DRAINAGE DATA CHART													
tc=10 min. C=0.9  AREA DESCRIPTION	DRAINAGE ID	AREA (SQ. FT.)	AREA (AC.)	С	Tc (min)			125 (in/hr)	100 (in/hr)	Q5 (cfs)	Q10 (cfs)	Q25 (cfs)	Q100 (cfs)	COMMENT	
	А	4438.62	0.10	0.90	10.0	6.1	7.1	8.3	9.8	0.6	0.7	0.8	0.9	DRAINS EAST TO EXISTING ROADSIDE DITCH	
	B1	14081.05	0.32	0.90	10.0	6.1	7.1	8.3	9.8	1.8	2.1	2.4	2.9	DRAINS EAST TO INLET #9 AND #10, THEN TO (N) DETENTION SYSTEM	
	B2	28606.34	0.66	0.90	10.0	6.1	7.1	8.3	9.8	3.6	4.2	4.9	5.8	DRAINS EAST TO TO ADJACENT PROPERTY	
$\neg$	С	103407.42	2.37	0.90	10.0	6.1	7.1	8.3	9.8	13.0	15.2	17.7	20.9	DRAINS EAST TO ADJACENT PROPERTY	
	D	236.60	0.01	0.90	10.0	6.1	7.1	8.3	9.8	0.0	0.0	0.0	0.0	DRAINS TO DUMPSTER INLET	
	Е	6096.73	0.14	0.90	10.0	6.1	7.1	8.3	9.8	0.8	0.9	1.0	1.2	DRAINS PARTIALLY TO INLET #1 THEN TO (N) DETENTION SYSTEM	
	F1	12037.85	0.28	0.90	10.0	6.1	7.1	8.3	9.8	1.5	1.8	2.1	2.4	DRAINS PARTIALLY TO INLET #2A THEN TO (MID)  DETENTION SYSTEM, OVERFLOW TO INLET #2B	
_	F2	4551.97	0.10	0.90	10.0	6.1	7.1	8.3	9.8	0.6	0.7	0.8	0.9	DRAINS PARTIALLY TO INLET #2B THEN TO (MID)  DETENTION SYSTEM	
	G	8715.15	0.20	0.90	10.0	6.1	7.1	8.3	9.8	1.1	1.3	1.5	1.8	ROOF DRAINS EAST TO DRAINAGE AREA C	
4	Н	17575.74	0.40	0.90	10.0	6.1	7.1	8.3	9.8	2.2	2.6	3.0	3.6	DRAINS EAST TO ADJACENT PROPERTY	
	I	31916.62	0.73	0.90	10.0	6.1	7.1	8.3	9.8	4.0	4.7	5.5	6.5	ROOF DRAINS EAST TO DRAINAGE AREA H	
	J	35893.19	0.82	0.90	10.0	6.1	7.1	8.3	9.8	4.5	5.3	6.2	7.3	DRAINS TO CURB INLET #3 AND #4 THEN TO  (MID) DETENTION SYSTEM	
4	К	10652.66	0.24	0.90	10.0	6.1	7.1	8.3	9.8	1.3	1.6	1.8	2.2	ROOF DRAINS EAST TO DRAINAGE AREA J	
4	L1	5136.35	0.12	0.90	10.0	6.1	7.1	8.3	9.8	0.6	0.8	0.9	1.0	DRAINS SOUTH TO INLET #11A, THEN TO (MID) DETENTION SYSTEM. OVERFLOW TO INLET #11B	
	L2	306.68	0.01	0.90	10.0	6.1	7.1	8.3	9.8	0.0	0.0	0.1	0.1	DRAINS TO INLET #11B, THEN TO  (MID) DETENTION SYSTEM	
	L3	306.67	0.01	0.90	10.0	6.1	7.1	8.3	9.8	0.0	0.0	0.1	0.1	DRAINS TO INLET #11C, THEN TO (MID) DETENTION SYSTEM. OVERFLOW TO INLET #11B	
	L4	5681.83	0.13	0.90	10.0	6.1	7.1	8.3	9.8	0.7	0.8	1.0	1.2	DRAINS NORTH TO INLET #11D, THEN TO " (MID) DETENTION SYSTEM. OVERFLOW TO INLET #11C	
	М	11948.44	0.27	0.90	10.0	6.1	7.1	8.3	9.8	1.5	1.8	2.0	2.4	ROOF DRAINS EAST TO DRAINAGE AREA J	
	N	24914.44	0.57	0.90	10.0	6.1	7.1	8.3	9.8	3.1	3.7	4.3	5.0	DRAINS NORTH TO INLET #5	
	0	20652.11	0.47	0.90	10.0	6.1	7.1	8.3	9.8	2.6	3.0	3.5	4.2	DRAINS EAST TO ADJACENT PROPERTY	
	Р	159059.80	3.65	0.90	10.0	6.1	7.1	8.3	9.8	20.0	23.3	27.3	32.2	DRAINS EAST TO ADJACENT PROPERTY	
	Q	9149.36	0.21	0.90	10.0	6.1	7.1	8.3	9.8	1.2	1.3	1.6	1.9	DRAINS NORTH TO INLET #12, THEN TO (MID)  DETENTION SYSTEM	
_	R	60440.43	1.39	0.90	10.0	6.1	7.1	8.3	9.8	7.6	8.9	10.4	12.2	DRAINS EAST TO ADJACENT PROPERTY	
_	S	3814.11	0.09	0.90	10.0	6.1	7.1	8.3	9.8	0.5	0.6	0.7	0.8	DRAINS TO INLET #6	
	Т	33327.07	0.77	0.90	10.0	6.1	7.1	8.3	9.8	4.2	4.9	5.7	6.7	DRAINS EAST TO INLET #7	
A T	U	10555.09	0.24	0.90	10.0	6.1	7.1	8.3	9.8	1.3	1.5	1.8	2.1	DRAINS EAST TO INLET #13	
	V	2753.84	0.06	0.90	10.0	6.1	7.1	8.3	9.8	0.3	0.4	0.5	0.6	DRAINS SOUTHEAST TO INLET #8	
	W	463.75	0.01	0.90	10.0	6.1	7.1	8.3	9.8	0.1	0.1	0.1	0.1	DRAINS TO DUMPSTER INLET	
	Х	463.75	0.01	0.90	10.0	6.1	7.1	8.3	9.8	0.1	0.1	0.1	0.1	DRAINS TO DUMPSTER INLET	
	Y	463.75	0.01	0.90	10.0	6.1	7.1	8.3	9.8	0.1	0.1	0.1	0.1	DRAINS TO DUMPSTER INLET	
	Z	16048.56	0.37	0.90	10.0	6.1	7.1	8.3	9.8	2.0	2.4	2.8	3.2	DRAINS TO EAST TO EXISTING LOWPOINT	
	TOTAL SITE	643696.54	14.78							81.1	94.4	110.4	130.3		
						·									

NOTE: CITY OF ROCKWALL STANDARDS OF DESIGN AND CONSTRUCTION OCTOBER 2019 WAS USED FOR RUNOFF COEFFICIENTS AND INTENSITY VALUES.

NOTE: THESE AS-BUILT PLANS HAVE BEEN REVISED TO CONFORM WITH THE POST-CONSTRUCTION SURVEY PROVIDED BY THE CONTRACTOR. BY STATING THIS, THE ENGINEER DOES NOT ASSUME RESPONSIBILITY FOR THE WORK PERFORMED BY THE CONTRACTOR. SAID RESPONSIBILITY REMAINS SOLELY WITH THE CONTRACTOR.

NORTHEAST CORNER OF THE HEADWALL ALONG SH 276 ELEVATION=563.33

CONTRACTOR SHALL COORDINATE WITH THE SURVEYOR FOR SITE BENCHMARKS AND CONTROL POINT

THERE IS THREE PROPOSED DETENTION SYSTEMS THAT CAPTURE AND DETAIN MOSTLY OFFSITE RUNOFF. THE PROPOSED ONSITE RUNOFF WILL MOSTLY BYPASS THE DETENTION AND SURFACE FLOW FROM THE PROPERTY IN A NON-CONCENTRATED MANNER TO MATCH EXISTING CONDITIONS.

# 100-YR COMPARISON TABLE:

EXISITING SITE & OFFSITE PASSTHROUGH PEAK RUNOFF: 217.5 CFS

PROPOSED SITE & OFFSITE PASSTHROUGH PEAK RUNOFF BEFORE DETENTION: 304.9 CFS

ACTUAL PROPOSED SITE & OFFSITE PASSTHROUGH PEAK RUNOFF AFTER DETENTION: 198.8 CFS



# Cumulus Design Firm #14810

CD22011


10/20/25

2080 N. Highway 360, Suite 240 Grand Prairie, Texas 75050 Tel. 214.235.0367


# PROPOSED DRAINAGE AREA MAP

4649 HIGHWAY 276 CITY OF ROCKWALL ROCKWALL COUNTY, TEXAS J.H. BAILEY SURVEY, ABST NO. 34 DATE PROJECT NO DRAWING SCALE C8.0

1" = 80'

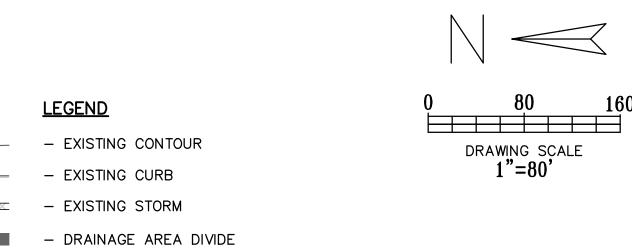

- DIRECTIONAL FLOW ARROW

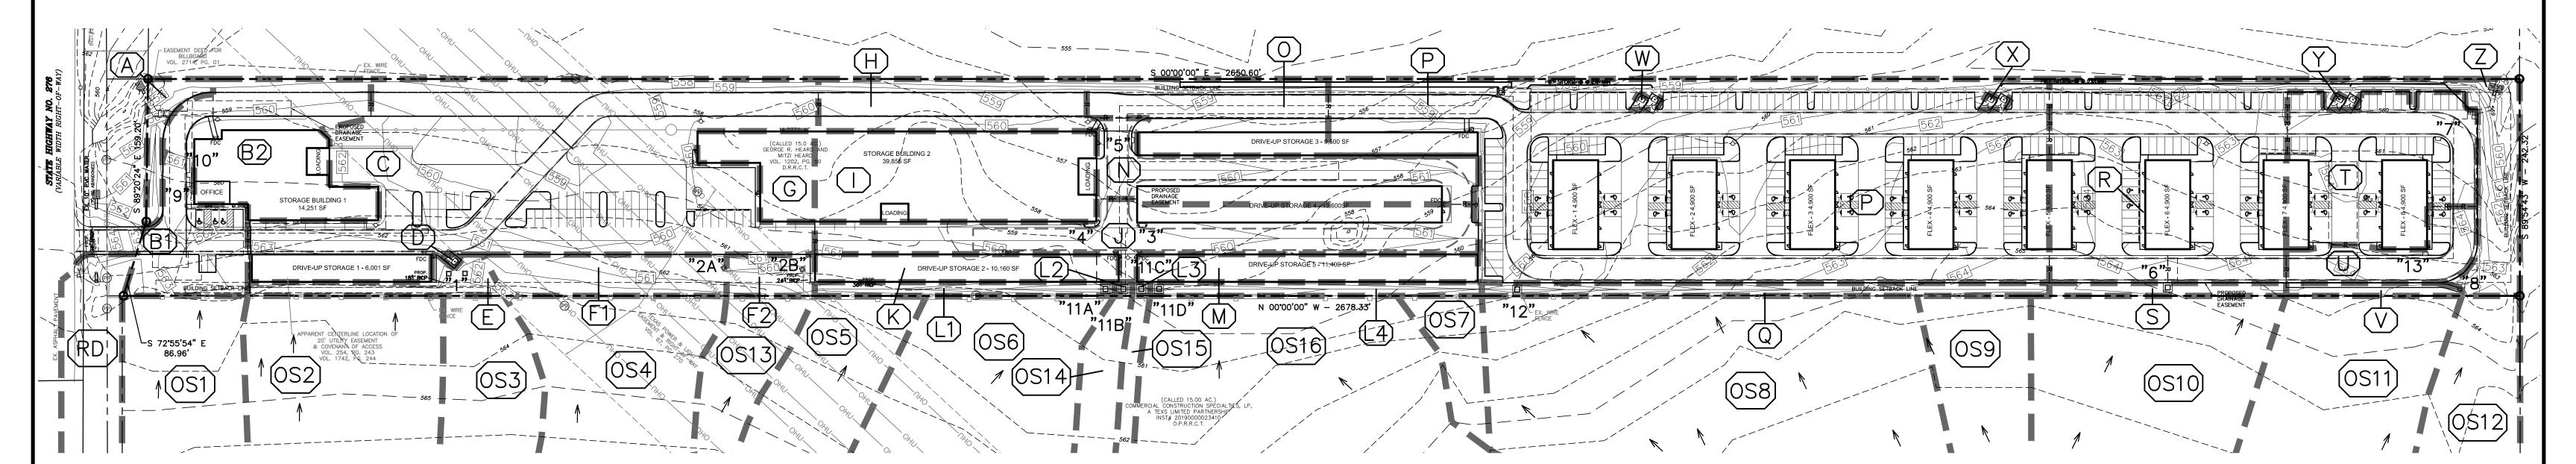

INLET CALCULATIONS

		Location				Area Runoff	F		Upstream	n Total					ı	Gutter Flo	OW	Gutter Flow							Inlets Capacity							Inlet By-pass			
Inlet	Alignme	nt Station	Offset Design	С	Area ID	Time of Concentration	on Intensity	Area Runo	ff Bypass C*A	Gutter Flow Qa	Thoroughfare On- Type Grade/Sa	Manning's	Long Slope S	Crown S	Cross Slope [ Sx	Depressio	on I	onding :h/Spread		pth of ter Flow	Max. Allowable Flow based on Max. Allowable		ed Gutter ction	Section Depre	Beyond ession	Con	iveyance	Ratio of Depression Flow	Equivalent	Inlet Ler	gth	Inlet Capacity	Flow	By <sub> </sub>	I
															D	-				l) (actual) ed Yactual	Ponding Width Qallow gutter	Area Aw	Wetter Perimeter	Area Ao	Wetter Perimeter	1 '	Section Beyond Depression	to Total Flow Eo	Slope	Required L	Actual -actual	Qc	Q <sub>bypass</sub>	i	ID
			(yr)			(min)	(in/hr)	(acres) (cfs)	(acres)	(cfs)			(ft/ft)	(	ft/ft)	(ft) (f	t) (ft)	(ft)	(ft)	(ft)	(cfs)	(ft <sup>2</sup> )	(ft)	(ft <sup>2</sup> )	(ft)					(ft)	(ft)	(cfs)	(cfs)		
#1	Line C	1+15.9	100	0.9, 0.74, 0.89	9 E, OS2, OS3	10	9.8	3.69 28.30	0.00	28.30	Sag	0.0175	0.005	NA	0.01	0.5 2	2 N/A	45.86	N/A	0.46	N/A	0.907	2.07	9.618	43.860	44.50	297.01	0.13	0.04	29.52	32	34.93	0.00	0.00 N	N/A 2-4'x4' Wye
#2	Line D	1+20.3	100	0.9, 0.79	F, OS4	10	9.8	3.19 25.30	0.00	25.30	Sag	0.0175	0.02	NA	0.03	0.5 2	2 N/A	17.06	N/A	0.51	N/A	0.994	2.08	3.404	15.065	51.63	107.24	0.32	0.11	22.37	24	26.19	0.00	0.00 N	N/A 2-3'x3' Wye
#3	Lat E2	1+31.9	100	0.9	J, M	10	9.8	0.76 6.70	0.00	6.70	On-Grad	e 0.0175	0.02	Straight	0.01	0.5	2 N/A	20.61	N/A	0.21	N/A	0.402	2.07	1.731	18.605	11.47	30.17	0.28	0.08	21.46	5	1.85	4.85	0.50	4 5' Curb
#4	Lat E3	1+17.6	100	0.9	J, K	10	9.8	0.58 5.12	0.50	9.97	Sag	0.0175	0.01	Straight	0.02	0.5 2	2 N/A	17.66	N/A	0.35	N/A	0.686	2.07	2.451	15.657	27.90	60.47	0.32	0.10	8.66	10	12.76	0.00	0.00 N	N/A 10' Curb
#5	Lat E1	1+09.0	100	0.9	N	10	9.8	0.57 5.03	0.00	5.03	Sag	0.0175	0.005	Straight (	0.005	0.5 2	2 N/A	37.00	N/A	0.18	N/A	0.365	2.06	3.062	34.996	9.76	51.24	0.16	0.05	2.58	5	6.99	0.00	0.00 N	N/A 5' Curb
#6	Line G	1+16.6	100	0.9, 0.35	S, OS10	10, 20	9.8, 8.3	2.22 6.98	0.00	6.98	Sag	0.0175	0.005	NA	0.01	0.5 2	2 N/A	27.13	N/A	0.27	N/A	0.533	2.07	3.158	25.133	18.32	67.28	0.21	0.06	16.00	20	21.83	0.00	0.00 N	N/A 5'x5' Wye
#7	Line L	1+16.1	100	0.9	Т	10	9.8	0.77 6.79	0.00	6.79	Sag	0.0175	0.005	Straight	0.02	0.5	2 N/A	17.41	N/A	0.35	N/A	0.676	2.07	2.375	15.412	27.24	57.98	0.32	0.10	4.75	5	6.99	0.00	0.00 N	N/A 5' Curb
#8	Line I	1+05.5	100	0.9, 0.35	V, OS11	10, 20	9.8, 8.3	3.15 9.51	0.00	9.51	Sag	0.0175	0.01	NA	0.02	0.5	2 N/A	17.34	N/A	0.35	N/A	0.674	2.07	2.355	15.345	27.06	57.31	0.32	0.10	15.07	12	13.10	0.00	0.00 N	N/A 3'x3' Wye
#9	Line	1+00.0	100	0.9, 0.74	B, OS1	10	9.8	2.76 20.82	2 0.00	20.82	On-Grad	e 0.0175	0.015	Straight	0.01	0.5 2	2 N/A	33.26	N/A	0.33	N/A	0.655	2.07	4.886	31.262	25.87	120.40	0.18	0.05	39.66	10	11.06	9.76	1.00	10 10' Curb
#10	) Line	1+00.0	100	0.9, 0.74	B, OS1	10	9.8	2.76 20.82	2 1.00	9.76	On-Grad	e 0.0175	0.015	Straight	0.01	0.5	2 N/A	25.03	N/A	0.25	N/A	0.491	2.07	2.653	23.034	15.98	53.32	0.23	0.07	11.23	15	15.13	0.00	0.00 N	N/A 10' Curb
#11	L Line	1+00.0	100	0.9, 0.78, 0.50	O, L, OS5, OS6, OS7	10	9.8	14.51 75.90	0.00	75.90	Sag	0.0175	0.005	NA	0.01	0.5	2 N/A	66.39	N/A	0.66	N/A	1.318	2.07	20.730	64.390	82.90	826.89	0.09	0.03	45.45	80	87.31	0.00	۸ 00.0	N/A 4-5'x5' Wye
#12	2 Line F	1+51.4	100	0.9, 0.35	Q, OS8, OS9	10	9.8	5.31 14.80	0.00	14.80	Sag	0.0175	0.005	NA	0.01	0.5	2 N/A	35.96	N/A	0.36	N/A	0.709	2.07	5.768	33.963	29.52	150.18	0.16	0.05	22.23	20	21.83	0.00	0.00 N	N/A 1-5'x5' Wye
#13	3 Line M	1+05.6	100	0.9	U	10	9.8	0.24 2.12	0.00	2.12	Sag	0.0175	0.005	Straight	0.02	0.5 2	2 N/A	11.25	N/A	0.22	N/A	0.430	2.07	0.855	9.246	12.79	14.84	0.46	0.14	5.03	5	6.99	0.00	0.00 N	N/A 5' Curb



!!! CAUTION !!!

CALL: TEXAS ONE CALL @ 811 AT LEAST 72 HRS PRIOR TO CONSTRUCTION.

UNDERGROUND UTILITIES EXISTING UTILITIES AND UNDERGROUND FACILITIES INDICATED ON THESE PLANS HAVE BEEN LOCATED FROM REFERENCE INFORMATION SUPPLIED BY VARIOUS PARTIES. THE ENGINEER DOES NOT ASSUME THE RESPONSIBILITY FOR THE UTILITY LOCATIONS SHOWN. IT SHALL BE THE SOLE RESPONSIBILITY OF THE CONTRACTOR(S) TO VERIFY THE HORIZONTALLY AND VERTICALLY LOCATION OF ALL UTILITIES AND UNDERGROUND FACILITIES PRIOR TO CONSTRUCTION, TO TAKE PRECAUTIONS IN ORDER TO PROTECT ALL FACILITIES ENCOUNTERED AND NOTIFY THE ENGINEER OF ALL CONFLICTS OF THE WORK WITH EXISTING FACILITIES. THE CONTRACTOR SHALL PROTECT AND MAINTAIN ALL UTILITIES FROM DAMAGE DURING CONSTRUCTION. ANY DAMAGE BY THE CONTRACTOR TO UTILITIES SHALL BE REPAIRED OR REPLACED BY THE CONTRACTOR AT THEIR OWN EXPENSE.

ALL RESPONSIBILITY FOR ADEQUACY OF DESIGN REMAINS WITH THE DESIGN ENGINEER. THE CITY OF ROCKWALL, IN REVIEWING AND RELEASING PLANS FOR CONSTRUCTION, ASSUMES NO RESPONSIBILITY FOR ADEQUACY OR ACCURACY OF DESIGN.

		REVISIONS
REV NO.	DATE	DESCRIPTION

AS-BUILT

NOTE: THESE AS—BUILT PLANS HAVE BEEN REVISED TO

CONFORM WITH THE POST—CONSTRUCTION SURVEY PROVIDED


NORTHEAST CORNER OF THE HEADWALL ALONG SH 276 BY THE CONTRACTOR. BY STATING THIS, THE ENGINEER DOES ELEVATION=563.33 NOT ASSUME RESPONSIBILITY FOR THE WORK PERFORMED BY THE CONTRACTOR. SAID RESPONSIBILITY REMAINS SOLELY WITH THE CONTRACTOR.

BENCHMARK

CONTRACTOR SHALL COORDINATE WITH THE SURVEYOR FOR SITE BENCHMARKS AND CONTROL POINT

2080 N. H Tel. 214.2		iite 240 Grand F	Prairie,	Texas 7	5050
	INLET (	CALCULA	1OIT	NS	
	4649	HIGHWAY	276		
	CITY (	OF ROCKV	VALL		
F	ROCKWALL	COUNTY	, TE	XAS	
J.H.	BAILEY S	URVEY, A	BST	NO.	34
DATE	PROJECT NO	DRAWING SCA	ALE	SH	EET
10/20/25	CD22011	1" = 80'		C8	3.1

Cumulus Design Firm #14810

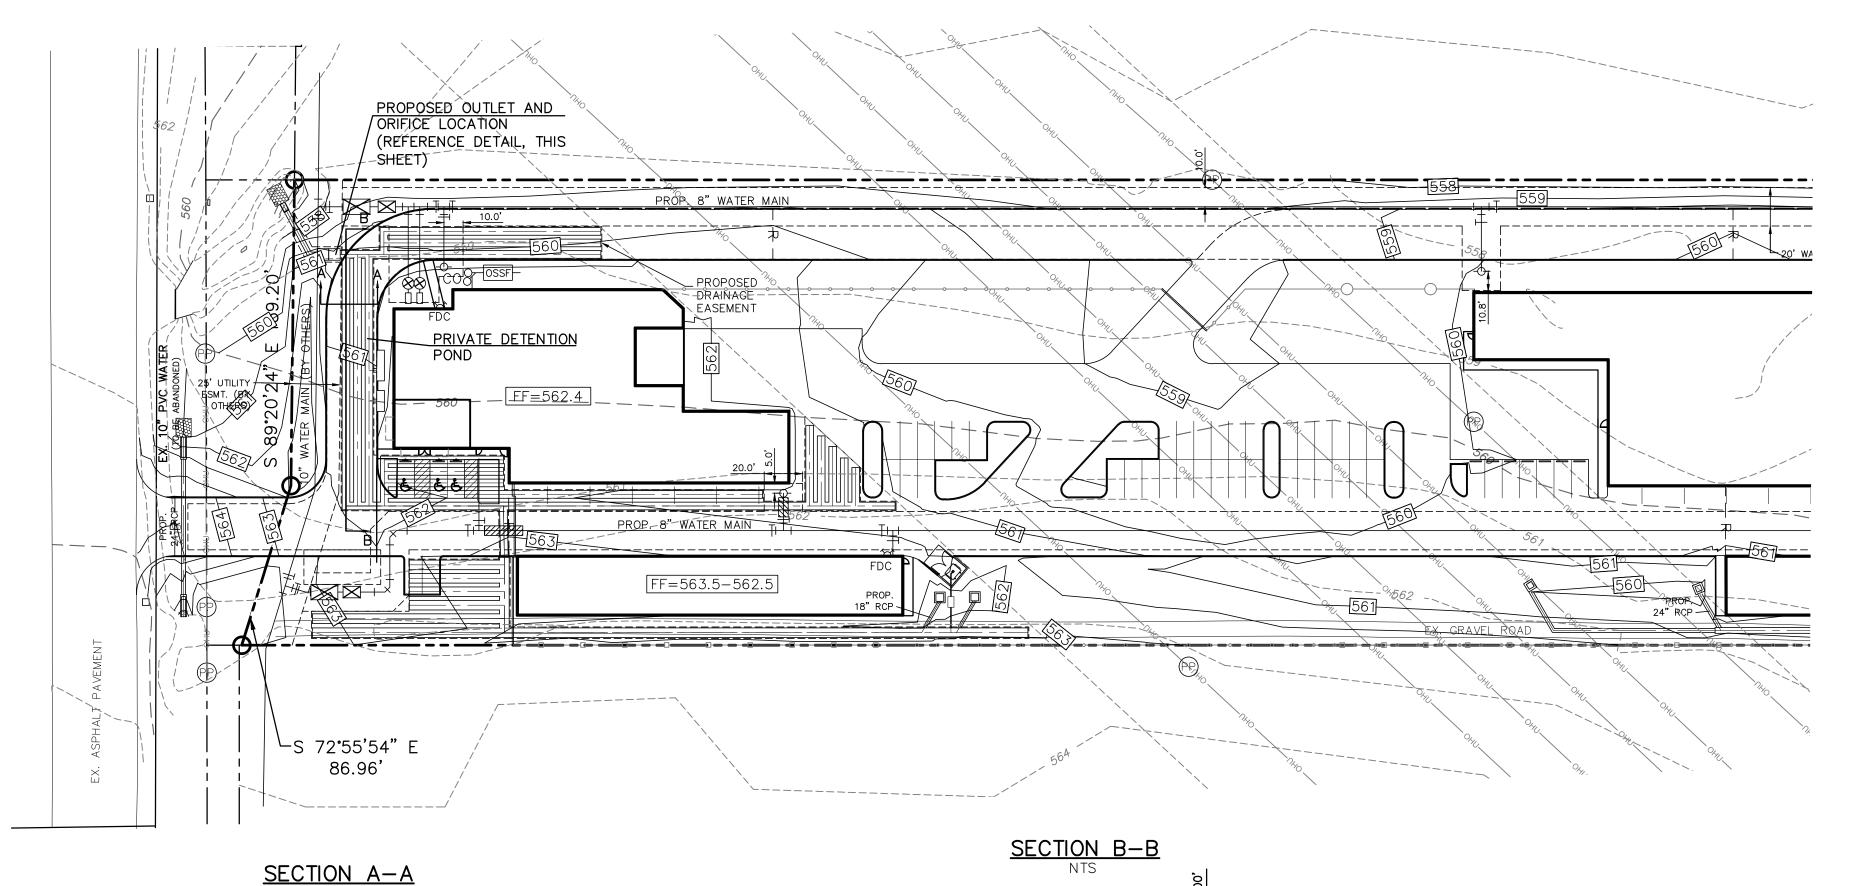

PROPOSED GROUND √ SURFACE 100 YR WSEL-

✓PROPOSED 48" ACMP

100 YR WSEL-└0.2% SLOPE -PROPOSED 48" ACMP-

# MAINTENANCE NOTES:

1. ACCESS TO THE DETENTION AREA IS PROVIDED THROUGH HATCHES AND CLEANOUTS FOR MAINTENANCE AND INSPECTION AS NEEDED.

2. THE ORIFICES SHALL BE CHECKED YEARLY AND ANY DEBRIS OR SEDIMENT REMOVED FROM THE ORIFICE.

3. NO PUMPS ARE PROPOSED FOR THE PROPOSED DETENTION POND. THE SCOPE OF MAINTENANCE WILL BE TO COLLECT TRASH/DEBRIS CAUGHT IN THE ORIFICE. THE ENTIRE SYSTEM SHOULD BE CHECKED BIENNIALLY AND SEDIMENT BUILDUP REMOVED WHEN IT EXCEEDS 4".

# DRAINAGE NOTES:

1. ALL MATERIALS AND CONSTRUCTION SHALL CONFORM TO THE CITY'S STANDARD CONSTRUCTION DETAILS AND SPECIFICATIONS EXCEPT AS NOTED HEREIN OR APPROVED BY THE CITY.

2. DURING THE CONSTRUCTION OF THE STORM AND DETENTION POND IMPROVEMENTS, ANY INTERPRETATION OF THE CITY'S STANDARD DETAILS AND SPECIFICATIONS MUST BE APPROVED BY THE DIRECTOR OF PUBLIC WORKS OR THEIR DESIGNEE BEFORE ANY CONSTRUCTION INVOLVING THAT DECISION COMMENCES. ASSUMPTIONS ABOUT WHAT THESE DECISIONS MIGHT BE WHICH ARE MADE DURING THE BIDDING PHASE WILL HAVE NO BEARING ON THE DECISION.

3. THE DETENTION SYSTEM FUNCTIONS BY USING TWO ORIFICE OPENINGS. THE STORMWATER ENTERS THE DETENTION SYSTEM BY FLOWING INTO THE SITE INLETS.

4. THE WATER SURFACE ELEVATION WAS DETERMINED BY USING THE HYDROCAD SOFTWARE. THE DRAINAGE DATA, OUTLET CONTROLS AND THE UNDERGROUND SYSTEM INFORMATION WAS INSERTED INTO THE MODEL. THE MODEL WAS COMPUTED TO DETERMINE THE WSEL AND THE OUTFLOW INFORMATION. ADJUSTMENTS WERE MADE TO THE OUTLET CONTROLS AND THE VOLUME OF WATER STORAGE TO ALLOW FOR PROPER DETENTION.

				DETEN	ITION POND DATA					
STORM EVENT (YEAR)	EXISTING RUNOFF (INCLUDING OFFSITE) (CFS)	PROPOSED SITE RUNOFF (INCLUDING OFFSITE) (CFS)	DETENTION SYSTEM WATER SURFACE ELEVATION (FT)	RELEASE FROM 17" ORIFICE (CFS)	RELEASE FROM 12" ORIFICE (CFS)	MAX RELEASE RATE FROM DETENTION (CFS)	BYPASS FLOW FROM THE SITE (CFS)	TOTAL RELEASE FROM THE SITE (CFS)	DETENTION VOLUME PROVIDED (CF)	NET RUNOFF CHANGE (PROP-EX) (CFS)
100	52.3	74.8	560.3	16.7	4.7	21.4	29.4	50.9	32986	-1.5
25	43.7	63.3	558.5	13.3	0.3	13.6	24.9	38.5	26386	-5.2
10	37.8	54.2	557.9	12.1	0.0	12.1	21.3	33.4	22173	-4.3
5	32.2	46.6	557.5	11.0	0.0	11.0	18.3	29.3	18017	-2.9

# !!! CAUTION !!! UNDERGROUND UTILITIES

EXISTING UTILITIES AND UNDERGROUND FACILITIES INDICATED ON THESE PLANS HAVE BEEN LOCATED FROM REFERENCE INFORMATION SUPPLIED BY VARIOUS PARTIES. THE ENGINEER DOES NOT ASSUME THE RESPONSIBILITY FOR THE UTILITY LOCATIONS SHOWN. IT SHALL BE THE SOLE RESPONSIBILITY OF THE CONTRACTOR(S) TO VERIFY THE HORIZONTALLY AND VERTICALLY LOCATION OF ALL UTILITIES AND UNDERGROUND FACILITIES PRIOR TO CONSTRUCTION, TO TAKE PRECAUTIONS IN ORDER TO PROTECT ALL FACILITIES ENCOUNTERED AND NOTIFY THE ENGINEER OF ALL CONFLICTS OF THE WORK WITH EXISTING FACILITIES. THE CONTRACTOR SHALL PROTECT AND MAINTAIN ALL UTILITIES FROM DAMAGE DURING CONSTRUCTION. ANY DAMAGE BY THE CONTRACTOR TO UTILITIES SHALL BE REPAIRED OR REPLACED BY THE CONTRACTOR AT THEIR CALL: TEXAS ONE CALL @ 811 AT LEAST 72 HRS PRIOR TO CONSTRUCTION.

ALL RESPONSIBILITY FOR ADEQUACY OF DESIGN REMAINS WITH THE DESIGN ENGINEER. THE CITY OF ROCKWALL, IN REVIEWING AND RELEASING PLANS FOR CONSTRUCTION, ASSUMES NO RESPONSIBILITY FOR ADEQUACY OR ACCURACY OF DESIGN.

		REVISIONS
REV NO.	DATE	DESCRIPTION

# **LEGEND**


— – EXISTING CURB PROPOSED CURB

- PROPOSED STORM PIPE

——669 — EXISTING CONTOUR — PROPOSED CONTOUR DRAWING SCALE 1"=50'


# GENERAL DETENTION POND DATA

GENERAL DETENTION POND DATA						
Elevation (feet)	Storage (cubic-feet)	Primary (cfs)				
554.7	0	0.0				
554.9	50	0.2				
555.1	305	0.8				
555.3	795	1.7				
555.5	1601	2.8				
555.7	2,736	4.1				
555.9	4,078	5.3				
556.1	5,574	6.3				
556.3	7,187	7.2				
556.5	8,890	7.9				
556.7	10,661	8.6				
556.9	12,480	9.3				
557.1	14,328	9.9				
557.3	16,190	10.4				
557.5	18,046	11.0				
557.7	19,880	11.5				
557.9	21,674	12.0				
558.1	23,406	12.5				
558.3	25,054	12.9				
558.5	26,586	13.7				
558.7	27,954	14.7				
558.9	29,058	15.8				
559.1	29,906	16.9				
559.3	30,621	17.9				
559.5	31,258	18.7				
559.7	31,836	19.5				
559.9	32,342	20.2				
560.1	32,754	20.9				
560.3	33,014	21.5				

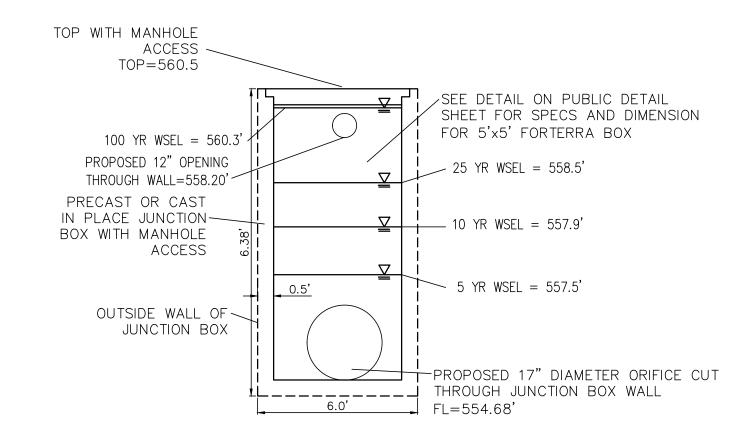

# ORIFICE CONTROL DETAIL

ORIFICE EQUATION  $Q=C*A*(2*G*H)^{(0.5)}$ WAS USED FOR THE DETENTION POND CALCULATIONS WITH A C VALUE OF 0.6.

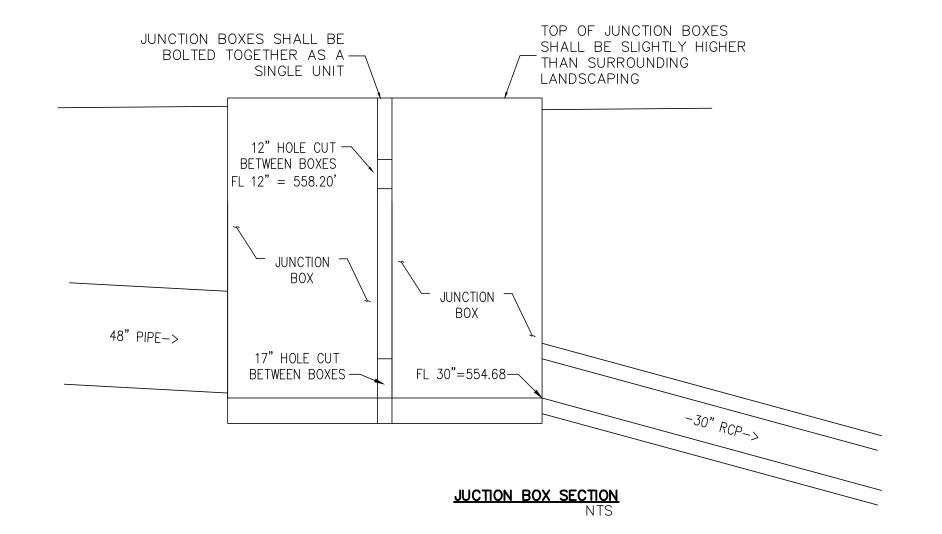



NOTE: THESE AS-BUILT PLANS HAVE BEEN REVISED TO CONFORM WITH THE POST-CONSTRUCTION SURVEY PROVIDED BY THE CONTRACTOR. BY STATING THIS, THE ENGINEER DOES NOT ASSUME RESPONSIBILITY FOR THE WORK PERFORMED BY THE CONTRACTOR. SAID RESPONSIBILITY REMAINS SOLELY WITH CONTRACTOR SHALL COORDINATE WITH THE SURVEYOR FOR

THE CONTRACTOR.

NORTHEAST CORNER OF THE HEADWALL ALONG SH 276 ELEVATION=563.33

SITE BENCHMARKS AND CONTROL POINT

Cumulus Design Firm #14810 2080 N. Highway 360, Suite 240 Grand Prairie, Texas 75050 Tel. 214.235.0367 DETENTION PLAN (N)

4649 HIGHWAY 276 CITY OF ROCKWALL

ROCKWALL COUNTY, TEXAS J.H. BAILEY SURVEY, ABST NO. 34

DATE PROJECT NO DRAWING SCALE SHEET 10/20/25 CD22011 1" = 50'

<u>100 Yea</u>	r Storm Existing Conditions	<u>100 Year</u>	Storm Post Contruction	<u>Conditions</u>		
Site Areas: A, B1, B2, C, D, E, G		Site Areas: B1, E		Bypass Areas: A, B2, C, D, G		
C:	0.35	C:	0.90	C(Site): 0.9		
<b>T</b> ':	20 Min	Т:	10 Min	T: 10 Min		
1.0.0	8.3 In/Hr	ľ":	9.8 In/Hr	I'': 9.8 In/Hr		
Area:	3.80 Acres	Area:	0.46 Acres	Area: 3.34 Acres		
<b>Q</b> '' • • •	11.04 CFS	<b>Q</b> '°°:	4.09 CFS	Q*** 29.44 CFS		
Offsite Ar	reas: OS1, OS2, OS3	Offsite Ar	eas: OS1, OS2, OS3	The existing release from the site and offsite is		
	<i>,</i> ,		• •	52.34 CFS. The bypass from the site is being		
C(Offsite):	0.72-0.89	C(Offsite):	0.72-0.89	1		
Т:	10 Min	Т:	10 Min	proposed as sheetflow to match existing		
100	9.8 In/Hr	1' ° :	9.8 In/Hr	sheetflow conditions. The bypass from the site		
Area:	5.55 Acres	Area:	5.55 Acres	and offsite is 29.44 CFS, which allows for a		
<b>Q</b> 1001	41.30 CFS	Q'°°	41.30 CFS	maximum release from the detention system of		
				22.90 cfs		
al Runoff:	52.34 CFS	Total Runoff:	45.39 CFS			
			T-1-10			

74.83 CFS **Total Runoff:** 22.90 CFS Allowed Release (-Bypass):

		Develope	d + Offsite	Allowed		
Duration (Min)	Intensity (In/Hr)	Flow (CFS)	Inflow (CF)	Outflow (CF)	Storage (CF)	Storage (Acre-Ft)
10	9.80	45.15	27,088	13,741	13,348	0.31
15	9.00	41.46	37,316	17,176	20,140	0.46
20	8.30	38.24	45,885	20,611	25,273	0.58
30	6.90	31.79	57,217	27,482	29,736	0.68
40	5.80	26.72	64,128	34,352	29,776	0.68
50	5.00	23.03	69,103	41,222	27,881	0.64
60	4.50	20.73	74,631	48,093	26,539	0.61
70	4.00	18.43	77,396	54,963	22,433	0.51
80	3.70	17.05	81,818	61,833	19,985	0.46
90	3.50	16.12	87,070	68,704	18,366	0.42
100	3.40	15.66	93,980	75,574	18,406	0.42
110	3.20	14.74	97,297	82,445	14,853	0.34

Note: The referenced in this sheet are from the proposed drainage area map.

<u> 10 Year</u>	<b>Storm Existing Conditions</b>	<u> 10 Year S</u>	Storm Post Contruction	<u>Conditions</u>
Site Areas:	A, B1, B2, C, D, E, G	Site	Areas: B1, E	Bypass Areas: A, B2, C, D, G
C:	0.35	C:	0.90	C(Site): 0.9
Τ΄:	20 Min	Т:	10 Min	T : 10 Min
1 0	5.9 In/Hr	l'°:	7.1 In/Hr	I": 7.1 In/Hr
Area:	3.80 Acres	Area:	0.46 Acres	Area: 3.34 Acres
Q <sup>*°</sup>	7.85 CFS	Q	2.96 CFS	Q** 21.33 CFS
Offsite Ar	eas: OS1, OS2, OS3	Offsite Are	eas: OS1, OS2, OS3	The existing release from the site and offsite is
C(Offsite):	0.72-0.89	C(Offsite):	0.72-0.89	37.75 CFS. The bypass from the site is being
, T:	10 Min	T:	10 Min	proposed as sheetflow to match existing
l'°:	7.1 In/Hr	ľ°:	7.1 In/Hr	sheetflow conditions. The bypass from the site
Area:	5.55 Acres	Area:	5.55 Acres	and offsite is 21.33 CFS, which allows for a
<b>Q</b> 1011	29.90 CFS	Q <sup>···</sup>	29.90 CFS	maximum release from the detention system of
				16.42 cfs
Total Runoff:	37.75 CFS	Total Runoff:	32.86 CFS	
			Total Ru	noff: 54.19 CFS

Allowed Release (-Bypass):

		- 1	1 oss :-			
		Develope	d + Offsite	Allowed		
Duration (Min)	Intensity (In/Hr)	Flow (CFS)	Inflow (CF)	Outflow (CF)	Storage (CF)	Storage (Acre-Ft)
10	7.10	32.71	19,625	9,852	9,774	0.22
15	6.50	29.94	26,950	12,315	14,636	0.34
20	5.90	27.18	32,617	14,778	17,839	0.41
30	4.80	22.11	39,803	19,704	20,100	0.46
40	4.00	18.43	44,226	24,629	19,597	0.45
50	3.50	16.12	48,372	29,555	18,817	0.43
60	3.00	13.82	49,754	34,481	15,273	0.35
70	2.80	12.90	54,177	39,407	14,770	0.34
80	2.60	11.98	57,494	44,333	13,161	0.30
90	2.50	11.52	62,193	49,259	12,934	0.30
100	2.40	11.06	66,339	54,185	12,154	0.28
110	2.30	10.60	69,932	59,111	10,822	0.25

Note: The referenced in this sheet are from the proposed drainage area map.

30	30	5.50	25.34	45,608	22,495
40	40	4.60	21.19	50,860	28,119
50	50	4.00	18.43	55,283	33,743

			•		•	
30	5.50	25.34	45,608	22,495	23,113	0.53
40	4.60	21.19	50,860	28,119	22,741	0.52
50	4.00	18.43	55,283	33,743	21,540	0.49
60	3.50	16.12	58,047	39,366	18,680	0.43
70	3.30	15.20	63,851	44,990	18,861	0.43
80	3.10	14.28	68,550	50,614	17,937	0.41
90	2.90	13.36	72,144	56,238	15,906	0.37
100	2.70	12.44	74,631	61,861	12,770	0.29
110	2.50	11.52	76,013	67,485	8,528	0.20

Developed + Offsite

34.55

30.41

Duration (Min) Intensity (In/Hr) Flow (CFS) Inflow (CF) Outflow (CF) Storage (CF) Storage (Acre-Ft) 22,942

31,096

36,486

Note: The referenced in this sheet are from the proposed drainage area map.

**25 Year Storm Existing Conditions** 

0.35

20 Min

6.6 In/Hr

3.80 Acres

10 Min

8.3 In/Hr

5.55 Acres

34.90 CFS

43.68 CFS

8.78 CFS

Site Areas: A, B1, B2, C, D, E, G

Offsite Areas: OS1, OS2, OS3

7.50

6.60

0.72-0.89

Т:

Area:

Q<sup>2</sup> ,

C(Offsite):

**T**:

Area:

**Total Runoff:** 

10

15

20

5 Year Storm Existing Conditions		5 Year Sto	orm Post Contruction C	onditions on the state of the s	
Site Areas: A	A, B1, B2, C, D, E, G	Site A	reas: B1, E	Bypass Are	eas: A, B2, C, D, G
C:	0.35	C:	0.90	C(Site):	0.9
T:	20 Min	Т:	10 Min	T':	10 Min
<b>1</b> °:	4.9 In/Hr	<b>1</b> °:	6.1 In/Hr	l <sup>*</sup> :	6.1 In/Hr
Area:	3.80 Acres	Area:	0.46 Acres	Area:	3.34 Acres
Q°	6.52 CFS	Q	2.54 CFS	Q	18.33 CFS
Offsite Area	as: OS1, OS2, OS3	Offsite Area	s: OS1, OS2, OS3	The existing re	elease from the site and offsite is

			Total Ru	ınoff∙ 46 57 CFS
otal Runoff:	32.22 CFS	Total Runoff:	28.24 CFS	
				13.89 cfs
$\mathbf{Q}^{\circ}$	25.70 CFS	$\mathbf{Q}^{r}$	25.70 CFS	maximum release from the detention system of
Area:	5.55 Acres	Area:	5.55 Acres	and offsite is 18.33 CFS, which allows for a
l':	6.1 In/Hr	Ι':	6.1 In/Hr	sheetflow conditions. The bypass from the site
T':	10 Min	Т:	10 Min	proposed as sheetflow to match existing
C(Offsite):	0.72-0.89	C(Offsite):	0.72-0.89	32.22 CFS. The bypass from the site is being

		Total Runoff:	46.57 CFS
		Allowed Release (-Bypass):	13.89 CFS
d + Offsita	Allowed		

**25 Year Storm Post Contruction Conditions** 

10 Min

8.3 In/Hr

0.46 Acres

10 Min 8.3 In/Hr

5.55 Acres

34.90 CFS

38.36 CFS

Allowed Release (-Bypass):

**Total Runoff:** 

3.46 CFS

0.90

Bypass Areas: A, B2, C, D, G

0.9

10 Min

8.3 In/Hr

3.34 Acres

The existing release from the site and offsite is

43.68 CFS. The bypass from the site is being

proposed as sheetflow to match existing

sheetflow conditions. The bypass from the site

and offsite is 24.94 CFS, which allows for a

maximum release from the detention system of 18.75 cfs

24.94 CFS

C(Site):

Area:

 $Q^{2}$ 

63.30 CFS

18.75 CFS

Site Areas: B1, E

Offsite Areas: OS1, OS2, OS3

0.27

0.39

0.45

0.72-0.89

Area:

**Q**° ':

C(Offsite):

l<sup>2</sup> :

Area:

 $\mathbf{Q}^{r}$ 

Total Runoff:

11,695

17,037

19,615

Allowed

11,248

14,059

16,871

		Develope	ed + Offsite	Allowed		
Duration (Min)	Intensity (In/Hr)	Flow (CFS)	Inflow (CF)	Outflow (CF)	Storage (CF)	Storage (Acre-Ft)
10	6.10	28.10	16,861	8,336	8,525	0.20
15	5.50	25.34	22,804	10,420	12,384	0.28
20	4.90	22.57	27,088	12,504	14,584	0.33
30	4.10	18.89	33,999	16,672	17,327	0.40
40	3.40	15.66	37,592	20,840	16,752	0.38
50	2.80	12.90	38,698	25,008	13,690	0.31
60	2.60	11.98	43,120	29,176	13,944	0.32
70	2.40	11.06	46,437	33,344	13,093	0.30
80	2.30	10.60	50,860	37,512	13,348	0.31
90	2.10	9.67	52,242	41,680	10,562	0.24
100	1.90	8.75	52,518	45,848	6,670	0.15
110	1.80	8.29	54,730	50,016	4,713	0.11

Note: The referenced in this sheet are from the proposed drainage area map.



Cumulus Design Firm #14810 2080 N. Highway 360, Suite 240 Grand Prairie, Texas 75050 Tel. 214.235.0367

# DETENTION CALCULATIONS (N)

4649 HIGHWAY 276 CITY OF ROCKWALL ROCKWALL COUNTY, TEXAS

J.H. BAILEY SURVEY, ABST NO. 34 PROJECT NO DRAWING SCALE C9.1

CD22011

10/20/25

N.T.S

ALL RESPONSIBILITY FOR ADEQUACY OF DESIGN REMAINS WITH THE DESIGN ENGINEER. THE CITY OF ROCKWALL, IN REVIEWING AND RELEASING PLANS FOR CONSTRUCTION, ASSUMES NO RESPONSIBILITY FOR ADEQUACY OR ACCURACY OF DESIGN.

16.42 CFS

REVISIONS						
REV NO.	DATE	DESCRIPTION				

NOTE: THESE AS-BUILT PLANS HAVE BEEN REVISED TO CONFORM WITH THE POST-CONSTRUCTION SURVEY PROVIDED BY THE CONTRACTOR. BY STATING THIS, THE ENGINEER DOES NOT ASSUME RESPONSIBILITY FOR THE WORK PERFORMED BY

NORTHEAST CORNER OF THE HEADWALL ALONG SH 276 ELEVATION=563.33 THE CONTRACTOR. SAID RESPONSIBILITY REMAINS SOLELY WITH
THE CONTRACTOR.

CONTRACTOR SHALL COORDINATE WITH THE SURVEYOR FOR SITE BENCHMARKS AND CONTROL POINT


ONDERCORD OTHER TES
EXISTING UTILITIES AND UNDERGROUND FACILITIES INDICATED ON THESE PLANS HAVE BEEN
LOCATED FROM REFERENCE INFORMATION SUPPLIED BY VARIOUS PARTIES. THE ENGINEER DOES
NOT ASSUME THE RESPONSIBILITY FOR THE UTILITY LOCATIONS SHOWN. IT SHALL BE THE SOLE
RESPONSIBILITY OF THE CONTRACTOR(S) TO VERIFY THE HORIZONTALLY AND VERTICALLY
LOCATION OF ALL UTILITIES AND UNDERGROUND FACILITIES PRIOR TO CONSTRUCTION, TO TAKE
PRECAUTIONS IN ORDER TO PROTECT ALL FACILITIES ENCOUNTERED AND NOTIFY THE ENGINEER
OF ALL CONFLICTS OF THE WORK WITH EXISTING FACILITIES. THE CONTRACTOR SHALL PROTECT
AND MAINTAIN ALL UTILITIES FROM DAMAGE DURING CONSTRUCTION. ANY DAMAGE BY THE
CONTRACTOR TO LITHITIES SHALL RE REPAIRED OR REDLACED BY THE CONTRACTOR AT THEIR

CONTRACTOR TO UTILITIES SHALL BE REPAIRED OR REPLACED BY THE CONTRACTOR AT THEIR


!!! CAUTION !!!

UNDERGROUND UTILITIES

CALL: TEXAS ONE CALL @ 811 AT LEAST 72 HRS PRIOR TO CONSTRUCTION.

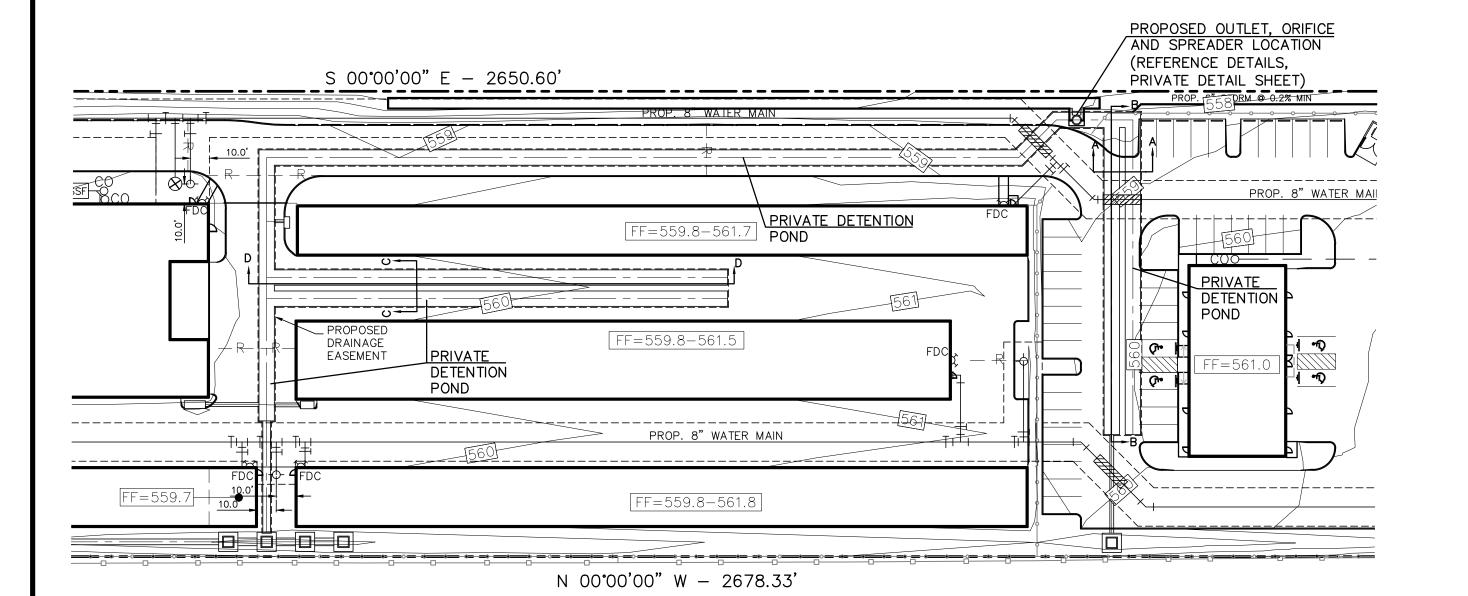





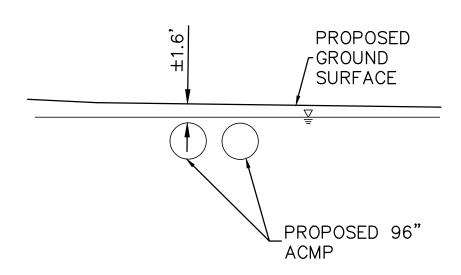

SECTION B-B **PROPOSED** r GROUND SURFACE \_PROPOSED 96" └0.2% SLOPE

SECTION C-C

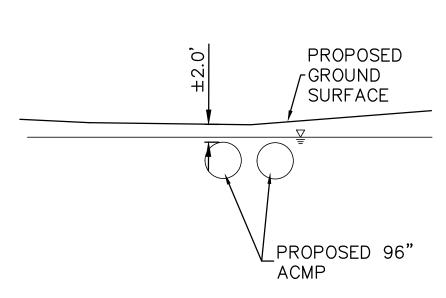

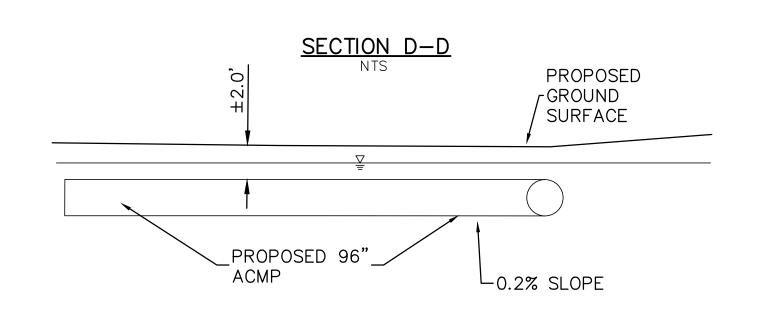

# DETENTION POND DATA

					DETENTION FO	DATA					
STORM EVENT (YEAR)	EXISTING RUNOFF (INCLUDING OFFSITE) (CFS)	PROPOSED SITE RUNOFF (INCLUDING OFFSITE) (CFS)	DETENTION SYSTEM WATER SURFACE ELEVATION (FT)	RELEASE FROM PUMP 1 (CFS)	RELEASE FROM PUMP 2 (CFS)	RELEASE FROM 1.5' TALL x 6' WIDE WEIR/ORIFICE (CFS)	1 110111 5212111011	BYPASS FLOW FROM THE SITE (CFS)	TOTAL RELEASE FROM THE SITE (CFS)	DETENTION VOLUME PROVIDED (CF)	NET RUNOFF CHANGE (PROP-EX) (CFS)
100	136.0	183.6	557.6	32.0	32.0	8.8	72.8	46.6	119.4	69699	-16.6
25	114.2	155.7	555.2	32.0	32.0	0.0	64.0	39.5	103.5	49312	-10.7
10	98.4	133.3	554.7	32.0	32.0	0.0	64.0	33.8	97.8	43283	-0.7
5	84.0	114.4	554.2	32.0	0.0	0.0	32.0	29.0	61.0	38081	-23.0

# !!! CAUTION !!! UNDERGROUND UTILITIES

EXISTING UTILITIES AND UNDERGROUND FACILITIES INDICATED ON THESE PLANS HAVE BEEN LOCATED FROM REFERENCE INFORMATION SUPPLIED BY VARIOUS PARTIES. THE ENGINEER DOES NOT ASSUME THE RESPONSIBILITY FOR THE UTILITY LOCATIONS SHOWN. IT SHALL BE THE SOLE RESPONSIBILITY OF THE CONTRACTOR(S) TO VERIFY THE HORIZONTALLY AND VERTICALLY LOCATION OF ALL UTILITIES AND UNDERGROUND FACILITIES PRIOR TO CONSTRUCTION, TO TAKE PRECAUTIONS IN ORDER TO PROTECT ALL FACILITIES ENCOUNTERED AND NOTIFY THE ENGINEER OF ALL CONFLICTS OF THE WORK WITH EXISTING FACILITIES. THE CONTRACTOR SHALL PROTECT AND MAINTAIN ALL UTILITIES FROM DAMAGE DURING CONSTRUCTION. ANY DAMAGE BY THE CONTRACTOR TO UTILITIES SHALL BE REPAIRED OR REPLACED BY THE CONTRACTOR AT THEIR

ALL RESPONSIBILITY FOR ADEQUACY OF DESIGN REMAINS WITH THE DESIGN ENGINEER. THE CITY OF ROCKWALL, IN REVIEWING AND RELEASING PLANS FOR CONSTRUCTION, ASSUMES NO RESPONSIBILITY FOR ADEQUACY OR ACCURACY OF DESIGN.

		REVISIONS
REV NO.	DATE	DESCRIPTION

# **LEGEND**

- EXISTING CURB
- PROPOSED CURB
- PROPOSED STORM PIPE
- EXISTING CONTOUR

# GENERAL DETENTION POND DATA

Elevation (feet)	Storage (cubic-feet)	Primary (cfs)
547.4	0	0.0
547.7	4	32.0
548.0	8	32.0
548.3	11	32.0
548.6	15	32.0
548.9	19	32.0
549.2	23	32.0
549.5	34	32.0
549.8	255	32.0
550.1	818	32.0
550.4	1,717	32.0
550.7	3,261	32.0
551.0	5,259	32.0
551.3	7,572	32.0
551.6	10,129	32.0
551.9	12,885	32.0
552.2	15,802	32.0
552.5	18,850	32.0
552.8	22,010	32.0
553.1	25,275	32.0
553.4	28,617	32.0
553.7	32,008	32.0
554.0	35,427	32.0
554.3	38,856	32.0
554.6	42,277	64.0
554.9	45,669	64.0
555.2	49,007	64.0
555.5	52,263	64.0
555.8	55,409	64.0
556.1	58,411	64.0
556.4	61,235	64.0
556.7	63,838	64.0
557.0	66,173	64.0
557.3	68,192	67.2
557.6	69,743	73.1
557.9	70,780	80.8
558.2	71,432	89.8
558.5	71,600	100.1
558.8	71,606	108.2

- - PROPOSED CONTOUR

# TOP OF STRUCTURE-=559.0'- PROPOSED RISER 100 YR WSEL=557.6-BY CONTECH PROPOSED 6' WIDE x 1.5' TALL ORIFICE CUT INTO STRUCTURE 25 YR WSEL=555.2, FL = 557.0'10 YR WSEL=554.7 -SEE DETAIL ON PRIVATE (DETAILS) SHEET FOR SPECS AND DIMENSION 5 YR WSEL=554.2 FOR CONTECH ACCESS RISER 96" ACMP 96" ACMP PROPOSED SUMP FL = 545.4'


# ORIFICE CONTROL DETAIL

ORIFICE EQUATION  $Q=C*A*(2*G*H)^{(0.5)}$ WAS USED FOR THE DETENTION POND CALCULATIONS WITH A C VALUE OF 0.6.

THE PRIMARY INLET FOR THE DETENTION SYSTEM IS ONSITE INLETS. THE OUTLET FROM THE DETENTION SYSTEM IS AN ORIFICE AND TWO PUMPS THROUGH THE OUTLET STRUCTURES.

THE PUMPS AND CONTROLS OF THE DETENTION POND SHALL BE DESIGN-BUILD AND SHALL MEET THE REQUIREMENTS OF THE CITY OF ROCKWALL (AS APPLICABLE). THE DESIGNER SHOULD CONTACT THE CIVIL ENGINEER OR STAFF AT 214-235-0367 PRIOR TO COMMENCING DESIGN TO OBTAIN ALL RELEVANT INFORMATION REGARDING FLOWS AND ELEVATIONS NEEDED FOR THE DESIGN.

THE PUMPS NEEDED FOR THE OUTLET BOX WILL BE REQUIRED TO REMOVE APPROXIMATELY 32 CFS EACH  $(\pm 14,361 \text{ GAL/MIN})$  AND A HEAD OF AT LEAST 15'.

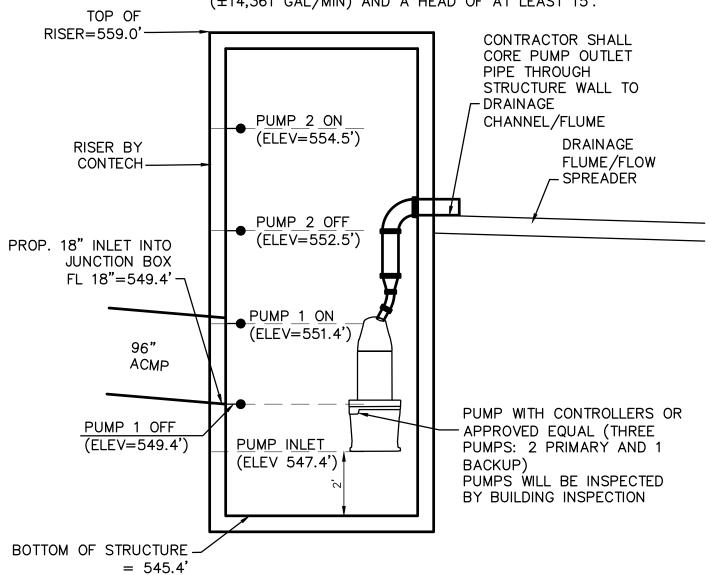

# OUTLET BOX DETAIL

AS-BUILT

NOTE: THESE AS-BUILT PLANS HAVE BEEN REVISED TO

- 1. THE TOP STEP SHALL BE 15" FROM THE ACCESS MANHOLE. STEPS SHALL BE 15" CENTERS VERTICALLY AND STAGGERED ON 12" CENTERS.
- 2. ALL CONCRETE SHALL BE 4500 PSI CONCRETE AND SHALL BE WITHIN 3" TO 5" SLUMP.

MAINTENANCE NOTES:

1. ACCESS TO THE DETENTION AREA IS PROVIDED THROUGH HATCHES AND CLEANOUTS FOR MAINTENANCE AND INSPECTION AS NEEDED.

DRAWING SCALE 1"=50'

2. THE ORIFICES SHALL BE CHECKED YEARLY AND ANY DEBRIS OR SEDIMENT REMOVED FROM THE ORIFICE.

3. NO PUMPS ARE PROPOSED FOR THE PROPOSED DETENTION POND. THE SCOPE OF MAINTENANCE WILL BE TO COLLECT TRASH/DEBRIS CAUGHT IN THE ORIFICE. THE ENTIRE SYSTEM SHOULD BE CHECKED BIENNIALLY AND SEDIMENT BUILDUP REMOVED WHEN IT EXCEEDS 4".

# **DRAINAGE NOTES:**

1. ALL MATERIALS AND CONSTRUCTION SHALL CONFORM TO THE CITY'S STANDARD CONSTRUCTION DETAILS AND SPECIFICATIONS EXCEPT AS NOTED HEREIN OR APPROVED BY THE CITY.

- 2. DURING THE CONSTRUCTION OF THE STORM AND DETENTION POND IMPROVEMENTS, ANY INTERPRETATION OF THE CITY'S STANDARD DETAILS AND SPECIFICATIONS MUST BE APPROVED BY THE DIRECTOR OF PUBLIC WORKS OR THEIR DESIGNEE BEFORE ANY CONSTRUCTION INVOLVING THAT DECISION COMMENCES. ASSUMPTIONS ABOUT WHAT THESE DECISIONS MIGHT BE WHICH ARE MADE DURING THE BIDDING PHASE WILL HAVE NO BEARING ON THE DECISION.
- 3. THE DETENTION SYSTEM FUNCTIONS BY USING ONE ORIFICE OPENING AND TWO PUMPS. THE STORMWATER ENTERS THE DETENTION SYSTEM BY FLOWING INTO THE SITE INLETS.
- 4. THE WATER SURFACE ELEVATION WAS DETERMINED BY USING THE HYDROCAD SOFTWARE. THE DRAINAGE DATA, OUTLET CONTROLS AND THE UNDERGROUND SYSTEM INFORMATION WAS INSERTED INTO THE MODEL. THE MODEL WAS COMPUTED TO DETERMINE THE WSEL AND THE OUTFLOW INFORMATION. ADJUSTMENTS WERE MADE TO THE OUTLET CONTROLS AND THE VOLUME OF WATER STORAGE TO ALLOW FOR PROPER DETENTION.



Cumulus Design Firm #14810

2080 N. Highway 360, Suite 240 Grand Prairie, Texas 75050 Tel. 214.235.0367

> DETENTION PLAN (MID) 4649 HIGHWAY 276

CITY OF ROCKWALL

ROCKWALL COUNTY, TEXAS

BAILEY SURVEY, ABST NO. 34 DATE PROJECT NO DRAWING SCALE SHEET C10.0 10/20/25 CD22011 1" = 50'

CONFORM WITH THE POST-CONSTRUCTION SURVEY PROVIDED NORTHEAST CORNER OF THE HEADWALL ALONG SH 276 BY THE CONTRACTOR. BY STATING THIS, THE ENGINEER DOES ELEVATION=563.33 NOT ASSUME RESPONSIBILITY FOR THE WORK PERFORMED BY THE CONTRACTOR. SAID RESPONSIBILITY REMAINS SOLELY WITH CONTRACTOR SHALL COORDINATE WITH THE SURVEYOR FOR SITE BENCHMARKS AND CONTROL POINT THE CONTRACTOR.

CALL: TEXAS ONE CALL @ 811 AT LEAST 72 HRS PRIOR TO CONSTRUCTION.

**100 Year Storm Existing Conditions 100 Year Storm Post Contruction Conditions** Site Areas: F, H, I, J, K, L, M, N, O, P, Q, W, X Site Areas: F, J, K, L, M, N, Q Bypass Areas: H, I, O, P, W, X 0.35 C: 0.90 C(Site): 0.9 C: 20 Min T : 10 Min 10 Min 100 8.3 In/Hr 100 9.8 In/Hr 9.8 In/Hr 8.05 Acres Area: 2.77 Acres 5.28 Acres Area: 23.39 CFS Q :: 24.41 CFS 46.60 CFS Offsite Areas: OS4, OS5, OS6, OS7, OS8, OS9 The existing release from the site and offsite is Offsite Areas: OS4, OS5, OS6, OS7, OS8, OS9 0.35-0.9 0.35-0.9 135.95 CFS. The bypass from the site is being C(Offsite): C(Offsite): proposed as sheetflow to match existing T': 10 Min 10 Min sheetflow conditions. The bypass from the site l'° : 9.8 In/Hr 100 9.8 In/Hr and offsite is 46.60 CFS, which allows for a Area: 22.16 Acres Area: 22.16 Acres 112.56 CFS maximum release from the detention system of  $\mathbf{Q}^{\circ}$ 112.56 CFS 89.35 cfs 135.95 CFS 136.97 CFS **Total Runoff: Total Runoff:** Total Punoff

183.57 CFS	Total Runoff:		
89.35 CFS	Allowed Release (-Bypass):		
		Allowed	Developed + Offsite

Duration (Min)	Intensity (In/Hr)	Flow (CFS)	Inflow (CF)	Outflow (CF)	Storage (CF)	Storage (Acre-Ft)
10	9.80	136.98	82,186	53,611	28,575	0.66
15	9.00	125.80	113,216	67,014	46,202	1.06
20	8.30	116.01	139,213	80,417	58,797	1.35
30	6.90	96.44	173,597	107,222	66,375	1.52
40	5.80	81.07	194,563	134,028	60,535	1.39
50	5.00	69.89	209,659	160,833	48,825	1.12
60	4.50	62.90	226,431	187,639	38,792	0.89
70	4.00	55.91	234,818	214,444	20,373	0.47
80	3.70	51.72	248,236	241,250	6,986	0.16
90	3.50	48.92	264,170	268,056	-3,886	-0.09
100	3.40	47.52	285,136	294,861	-9,725	-0.22
110	3.20	44.73	295,199	321,667	-26,467	-0.61

Note: The referenced in this sheet are from the proposed drainage area map.

<u>10 Year S</u>	torm Existing Conditions	10 Year Sto	orm Post Contruction C	<u>Conditions</u>	
Site Areas: F, H, I, J	, K, L, M, N, O, P, Q, W, X	Site Areas:	F, J, K, L, M, N, Q	Bypass Area	as: H, I, O, P, W, X
C:	0.35	C:	0.90	C(Site):	0.9
<b>T</b> ':	20 Min	<b>T</b> ':	10 Min	T :	10 Min
110	5.9 In/Hr	1.0	7.1 In/Hr	l'°:	7.1 In/Hr
Area:	8.05 Acres	Area:	2.77 Acres	Area:	5.28 Acres
<b>Q</b> <sup>1 ° 2</sup>	16.63 CFS	$\mathbf{Q}^{10}$	17.69 CFS	<b>Q</b> '° :	33.76 CFS

Offsite Areas: OS4	, OS5, OS6, OS7, OS8, OS9	Offsite Areas: OS4	4, OS5, OS6, OS7, OS8, OS9	The existing release from the site and offsite is
C(Offsite):	0.35-0.9	C(Offsite):	0.35-0.9	98.43 CFS. The bypass from the site is being
Τ:	10 Min	Т:	10 Min	proposed as sheetflow to match existing
1'°:	7.1 ln/Hr	l <sup>*</sup> :	7.1 ln/Hr	sheetflow conditions. The bypass from the site
Area:	22.16 Acres	Area:	22.16 Acres	and offsite is 33.76 CFS, which allows for a
$\mathbf{Q}^{\circ}$	81.80 CFS	$\mathbf{Q}^{\circ}$	81.80 CFS	maximum release from the detention system of
				64.67 cfs
Total Runoff:	98.43 CFS	Total Runoff:	99.49 CFS	

Total Runoff:	133.25 CFS
Allowed Release (-Bypass):	64.67 CFS

		Develope	ed + Offsite	Allowed		
Duration (Min)	Intensity (In/Hr)	Flow (CFS)	Inflow (CF)	Outflow (CF)	Storage (CF)	Storage (Acre-Ft)
10	7.10	99.24	59,543	38,800	20,743	0.48
15	6.50	90.85	81,767	48,500	33,267	0.76
20	5.90	82.47	98,959	58,200	40,759	0.94
30	4.80	67.09	120,763	77,600	43,163	0.99
40	4.00	55.91	134,182	97,000	37,181	0.85
50	3.50	48.92	146,761	116,400	30,361	0.70
60	3.00	41.93	150,954	135,800	15,154	0.35
70	2.80	39.14	164,372	155,200	9,172	0.21
80	2.60	36.34	174,436	174,600	-164	0.00
90	2.50	34.94	188,693	194,000	-5,307	-0.12
100	2.40	33.55	201,272	213,400	-12,128	-0.28
110	2.30	32.15	212,175	232,800	-20,626	-0.47

Note: The referenced in this sheet are from the proposed drainage area map.

9	The existing release from the site and offsite is
	98.43 CFS. The bypass from the site is being
	proposed as sheetflow to match existing
	sheetflow conditions. The bypass from the site
	and offsite is 33.76 CFS, which allows for a
	maximum release from the detention system of
	64.67 cfs

						Allowed R
		Develope	ed + Offsite	Allowed		
ation (Min)	Intensity (In/Hr)	Flow (CFS)	Inflow (CF)	Outflow (CF)	Storage (CF)	Storage (Acre-Ft)
10	7.10	99.24	59,543	38,800	20,743	0.48
15	6.50	90.85	81,767	48,500	33,267	0.76
20	5.90	82.47	98,959	58,200	40,759	0.94
30	4.80	67.09	120,763	77,600	43,163	0.99
40	4.00	55.91	134,182	97,000	37,181	0.85
50	3.50	48.92	146,761	116,400	30,361	0.70
60	3.00	41.93	150,954	135,800	15,154	0.35
70	2.80	39.14	164,372	155,200	9,172	0.21
80	2.60	36.34	174,436	174,600	-164	0.00
90	2.50	34.94	188,693	194,000	-5,307	-0.12
100	2.40	33 55	201 272	213 /100	-12 128	-N 28

# !!! CAUTION !!! UNDERGROUND UTILITIES

CALL: TEXAS ONE CALL @ 811 AT LEAST 72 HRS PRIOR TO CONSTRUCTION.

EXISTING UTILITIES AND UNDERGROUND FACILITIES INDICATED ON THESE PLANS HAVE BEEN LOCATED FROM REFERENCE INFORMATION SUPPLIED BY VARIOUS PARTIES. THE ENGINEER DOES NOT ASSUME THE RESPONSIBILITY FOR THE UTILITY LOCATIONS SHOWN. IT SHALL BE THE SOLE RESPONSIBILITY OF THE CONTRACTOR(S) TO VERIFY THE HORIZONTALLY AND VERTICALLY LOCATION OF ALL UTILITIES AND UNDERGROUND FACILITIES PRIOR TO CONSTRUCTION, TO TAKE PRECAUTIONS IN ORDER TO PROTECT ALL FACILITIES ENCOUNTERED AND NOTIFY THE ENGINEER OF ALL CONFLICTS OF THE WORK WITH EXISTING FACILITIES. THE CONTRACTOR SHALL PROTECT AND MAINTAIN ALL UTILITIES FROM DAMAGE DURING CONSTRUCTION. ANY DAMAGE BY THE CONTRACTOR TO UTILITIES SHALL BE REPAIRED OR REPLACED BY THE CONTRACTOR AT THEIR

ALL RESPONSIBILITY FOR ADEQUACY OF DESIGN REMAINS WITH THE DESIGN ENGINEER. THE CITY OF ROCKWALL, IN REVIEWING AND RELEASING PLANS FOR CONSTRUCTION, ASSUMES NO RESPONSIBILITY FOR ADEQUACY OR ACCURACY OF DESIGN.

		REVISIONS	
REV NO.	DATE	DESCRIPTION	
			l

NOTE: THESE AS-BUILT PLANS HAVE BEEN REVISED TO CONFORM WITH THE POST-CONSTRUCTION SURVEY PROVIDED BY THE CONTRACTOR. BY STATING THIS, THE ENGINEER DOES NOT ASSUME RESPONSIBILITY FOR THE WORK PERFORMED BY THE CONTRACTOR. SAID RESPONSIBILITY REMAINS SOLELY WITH THE CONTRACTOR.

ELEVATION=563.33

NORTHEAST CORNER OF THE HEADWALL ALONG SH 276 CONTRACTOR SHALL COORDINATE WITH THE SURVEYOR FOR

SITE BENCHMARKS AND CONTROL POINT

# **25 Year Storm Post Contruction Conditions**

Site Areas:	F, J, K, L, M, N, Q	Bypass Areas: H, I, O, P, W, X				
C:	0.90	C(Site):	0.9			
<b>T</b> :	10 Min	T :	10 Min			
2 5	8.3 In/Hr	2 5	8.3 In/Hr			
Area:	2.77 Acres	Area:	5.28 Acres			
Q <sup>2-5</sup> :	20.68 CFS	$\mathbf{Q}^{r,s,r}$	39.46 CFS			

maximum release from the detention system of

55.00 cfs

155.74 CFS

74.73 CFS

## Offsite Areas: OS4, OS5, OS6, OS7, OS8, OS9 The existing release from the site and offsite is Offsite Areas: OS4, OS5, OS6, OS7, OS8, OS9 C(Offsit

, 222, 222, 221, 222, 222		, 000, 000, 001, 000, 000	The symbol Breaker with the state and a state of
0.35-0.9	C(Offsite):	0.35-0.9	114.20 CFS. The bypass from the site is being
10 Min	<b>T</b> ':	10 Min	proposed as sheetflow to match existing
8.3 In/Hr	[2.5]	8.3 In/Hr	sheetflow conditions. The bypass from the site
22.16 Acres	Area:	22.16 Acres	and offsite is 39.46 CFS, which allows for a
95.60 CFS	Q	95.60 CFS	maximum release from the detention system of
			74.73 cfs
	0.35-0.9 10 Min 8.3 In/Hr 22.16 Acres	0.35-0.9       C(Offsite):         10 Min       T :         8.3 In/Hr       I :         22.16 Acres       Area:	0.35-0.9       C(Offsite):       0.35-0.9         10 Min       T :       10 Min         8.3 In/Hr       I : 8.3 In/Hr         22.16 Acres       Area:       22.16 Acres

114.20 CFS 116.28 CFS **Total Runoff: Total Runoff:** Allowed Release (-Bypass):

230,625 269,041 **-38,416** 

		Develope	ed + Offsite	Allowed		
Duration (Min)	Intensity (In/Hr)	Flow (CFS)	Inflow (CF)	Outflow (CF)	Storage (CF)	Storage (Acre-Ft)
10	8.30	116.01	69,607	44,840	24,767	0.57
15	7.50	104.83	94,346	56,050	38,296	0.88
20	6.60	92.25	110,700	67,260	43,440	1.00
30	5.50	76.87	138,375	89,680	48,694	1.12
40	4.60	64.30	154,309	112,100	42,208	0.97
50	4.00	55.91	167,727	134,520	33,207	0.76
60	3.50	48.92	176,113	156,941	19,173	0.44
70	3.30	46.12	193,725	179,361	14,364	0.33
80	3.10	43.33	207,981	201,781	6,201	0.14
90	2.90	40.53	218,884	224,201	-5,317	-0.12
100	2.70	37.74	226,431	246,621	-20,189	-0.46

Note: The referenced in this sheet are from the proposed drainage area map.

70.20 CFS

2.50

34.94

**25 Year Storm Existing Conditions** 

0.35

20 Min

6.6 In/Hr

8.05 Acres

18.60 CFS

Site Areas: F, H, I, J, K, L, M, N, O, P, Q, W, X

T :

Area:

 $Q^{i}$ 

110

Q'

# **5 Year Storm Post Contruction Conditions**

-0.88

<u>5 Year S</u>	Storm Existing Conditions	5 Year Storm Post Contruction Conditions						
Site Areas: F, H, I, J, K, L, M, N, O, P, Q, W, X		Site Areas:	Bypass Areas: H, I, O, P, W					
C:	0.35	C:	0.90	C(Site):	0.9			
<b>T</b> :	20 Min	Т:	10 Min	<b>T</b> °:	10 Min			
ļ* :	4.9 In/Hr	Γ:	6.1 In/Hr	5 .	6.1 In/Hr			
Area:	8.05 Acres	Area:	2.77 Acres	Area:	5.28 Acres			
Q*	13.81 CFS	$\mathbf{Q}^{*}$	15.20 CFS	$\mathbf{Q}^{(1)}$	29.00 CFS			

Offsite Areas: OS4, OS5, OS6, OS7, OS8, OS9		Offsite Areas: OS4	1, OS5, OS6, OS7, OS8, OS9	The existing release from the site and offsite is
C(Offsite):	0.35-0.9	C(Offsite):	0.35-0.9	84.01 CFS. The bypass from the site is being
T:	10 Min	Т:	10 Min	proposed as sheetflow to match existing
<b>1</b> 5 :	6.1 ln/Hr	l':	6.1 ln/Hr	sheetflow conditions. The bypass from the site
Area:	22.16 Acres	Area:	22.16 Acres	and offsite is 29.00 CFS, which allows for a

85.40 CFS **Total Runoff:** 84.01 CFS

 65.40 Cl 5	
Total Runoff:	114.40 CFS
Allowed Release (-Bypass):	55.00 CFS

70.20 CFS

		Develope	ed + Offsite	Allowed		
Duration (Min)	Intensity (In/Hr)	Flow (CFS)	Inflow (CF)	Outflow (CF)	Storage (CF)	Storage (Acre-Ft)
10	6.10	85.26	51,157	33,002	18,155	0.42
15	5.50	76.87	69,187	41,253	27,935	0.64
20	4.90	68.49	82,186	49,503	32,683	0.75
30	4.10	57.31	103,152	66,004	37,148	0.85
40	3.40	47.52	114,054	82,505	31,549	0.72
50	2.80	39.14	117,409	99,007	18,402	0.42
60	2.60	36.34	130,827	115,508	15,319	0.35
70	2.40	33.55	140,891	132,009	8,882	0.20
80	2.30	32.15	154,309	148,510	5,799	0.13
90	2.10	29.35	158,502	165,011	-6,509	-0.15
100	1.90	26.56	159,341	181,512	-22,171	-0.51
110	1.80	25.16	166,050	198,013	-31,963	-0.73

Note: The referenced in this sheet are from the proposed drainage area map.



Cumulus Design Firm #14810


2080 N. Highway 360, Suite 240 Grand Prairie, Texas 75050 Tel. 214.235.0367

# DETENTION CALCULATIONS (MID)


4649 HIGHWAY 276 CITY OF ROCKWALL


ROCKWALL COUNTY, TEXAS J.H. BAILEY SURVEY, ABST NO. 34

DATE PROJECT NO DRAWING SCALE SHEET C10.1 N.T.S CD22011 10/20/25

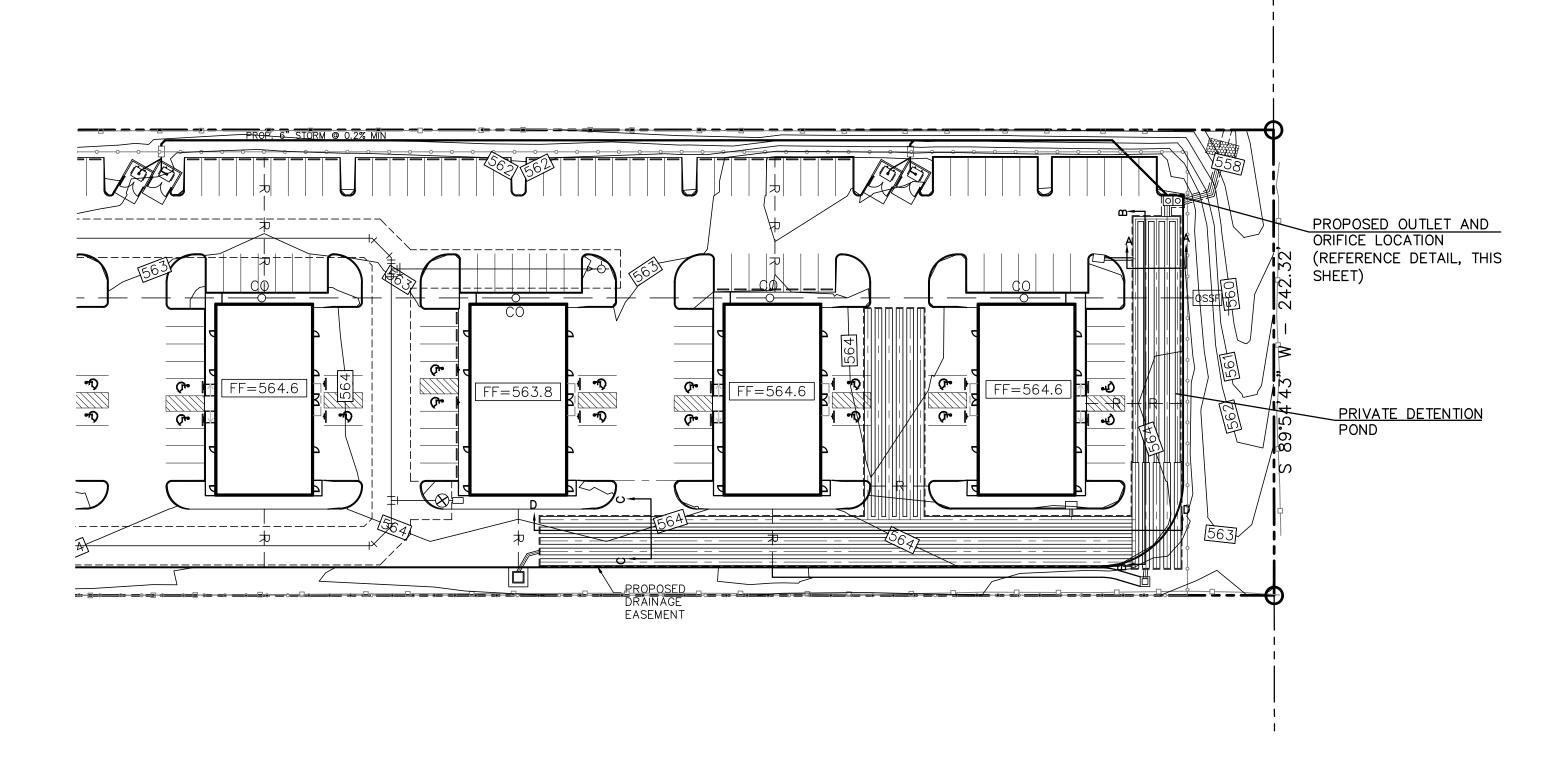


SECTION A-A PROPOSED -GROUND SURFACE

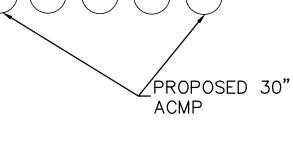


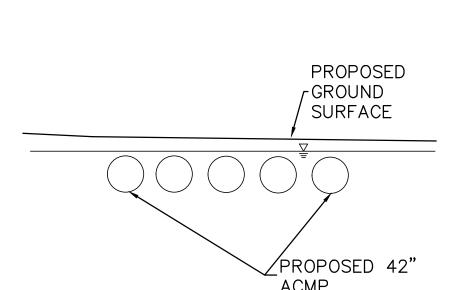

SECTION C-C

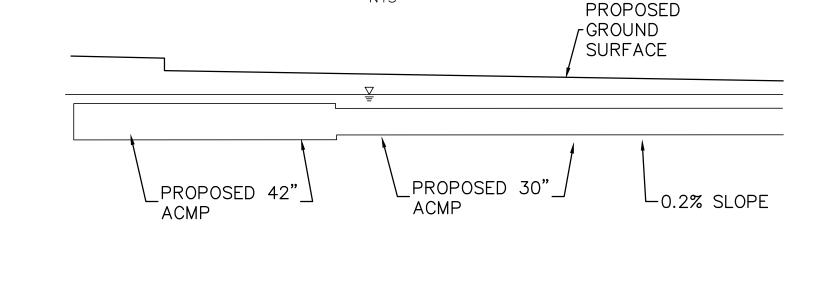

SECTION B-B

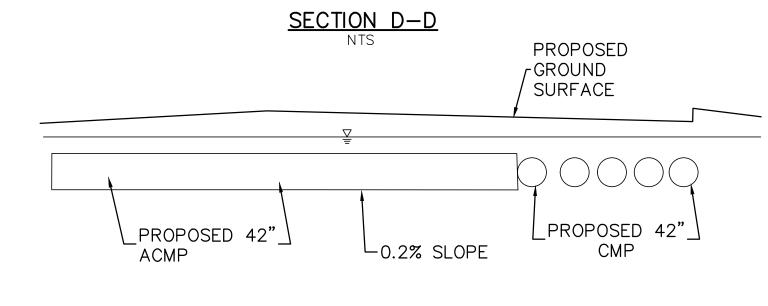

# <u>LEGEND</u>

EXISTING CURB


PROPOSED CURB

- PROPOSED STORM PIPE EXISTING CONTOUR

PROPOSED CONTOUR

# **GENERAL DETENTION POND DATA**

Elevation (feet)	Storage (cubic-feet)	Primary (cfs)
558.16	0	0.0
558.26	7	0.0
558.36	37	0.1
558.46	100	0.3
558.56	190	0.5
558.66	321	0.8
558.76	510	1.0
558.86	760	1.2
558.96	1,086	1.4
559.06	1,516	1.5
559.16	2,061	1.7
559.26	2,707	1.8
559.36	3,450	1.9
559.46	4,288	2.1
559.56	5,211	2.2
559.66	6,197	2.3
559.76	7,234	2.4
559.86	8,313	2.5
559.96	9,426	2.5
560.06	10,565	2.6
560.16	11,725	2.7
560.26	12,900	2.8
560.36	14,083	2.9
560.46	15,268	3.0
560.56	16,448	3.0
560.66	17,614	3.1
560.76	18,751	3.1
560.86	19,856	3.3
560.96	20,939	3.5
561.06	22,012	3.8
561.16	23,072	4.1
561.26	24,114	4.5
561.36	25,134	4.9
561.46	26,129	5.4
561.56	27,092	5.8
561.66	28,018	6.2
561.76	28,901	6.5
561.86	29,732	6.8
561.96	30,501	7.1
562.06	31,190	7.4
562.16	31,777	7.7
562.26	32,269	7.9
562.36	32,663	8.1
562.46	32,949	8.4
562.56	33,138	8.6
562.66	33,261	8.8

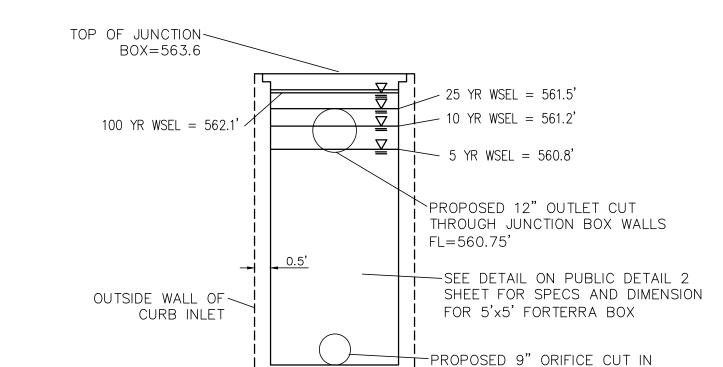

# ORIFICE CONTROL DETAIL (SECTION A-A)

L\_\_\_\_\_ JUNCTION BOX WALLS

FL=558.16'

ORIFICE EQUATION  $Q=C*A*(2*G*H)^{(0.5)}$ WAS USED FOR THE DETENTION POND CALCULATIONS WITH A C VALUE OF 0.6.

# MAINTENANCE NOTES: 1. ACCESS TO THE DETENTION AREA IS PROVIDED THROUGH HATCHES AND CLEANOUTS FOR MAINTENANCE AND INSPECTION AS NEEDED. 2. THE ORIFICES SHALL BE CHECKED YEARLY AND ANY DEBRIS OR SEDIMENT REMOVED FROM THE ORIFICE. 3. NO PUMPS ARE PROPOSED FOR THE PROPOSED DETENTION

\_\_\_\_\_

DRAWING SCALE

1"=50'

POND. THE SCOPE OF MAINTENANCE WILL BE TO COLLECT TRASH/DEBRIS CAUGHT IN THE ORIFICE. THE ENTIRE SYSTEM SHOULD BE CHECKED BIENNIALLY AND SEDIMENT BUILDUP REMOVED WHEN IT EXCEEDS 4".

# DRAINAGE NOTES:

1. ALL MATERIALS AND CONSTRUCTION SHALL CONFORM TO THE CITY'S STANDARD CONSTRUCTION DETAILS AND SPECIFICATIONS EXCEPT AS NOTED HEREIN OR APPROVED BY THE CITY.

- 2. DURING THE CONSTRUCTION OF THE STORM AND DETENTION POND IMPROVEMENTS, ANY INTERPRETATION OF THE CITY'S STANDARD DETAILS AND SPECIFICATIONS MUST BE APPROVED BY THE DIRECTOR OF PUBLIC WORKS OR THEIR DESIGNEE BEFORE ANY CONSTRUCTION INVOLVING THAT DECISION COMMENCES. ASSUMPTIONS ABOUT WHAT THESE DECISIONS MIGHT BE WHICH ARE MADE DURING THE BIDDING PHASE WILL HAVE NO BEARING ON THE DECISION.
- 3. THE DETENTION SYSTEM FUNCTIONS BY USING TWO ORIFICE OPENINGS. THE STORMWATER ENTERS THE DETENTION SYSTEM BY FLOWING INTO THE SITE INLETS.
- 4. THE WATER SURFACE ELEVATION WAS DETERMINED BY USING THE HYDROCAD SOFTWARE. THE DRAINAGE DATA, OUTLET CONTROLS AND THE UNDERGROUND SYSTEM INFORMATION WAS INSERTED INTO THE MODEL. THE MODEL WAS COMPUTED TO DETERMINE THE WSEL AND THE OUTFLOW INFORMATION. ADJUSTMENTS WERE MADE TO THE OUTLET CONTROLS AND THE VOLUME OF WATER STORAGE TO ALLOW FOR PROPER DETENTION.



# Cumulus Design Firm #14810 2080 N. Highway 360, Suite 240 Grand Prairie, Texas 75050 Tel. 214.235.0367

DETENTION PLAN (	(S)
4649 HIGHWAY 276	
CITY OF ROCKWALL	

ROCKWALL COUNTY, TEXAS BAILEY SURVEY, ABST NO. 34

PROJECT NO DATE DRAWING SCALE SHEET 10/20/25 CD22011 1" = 50'

Lievation	Juliage	Filliary
(feet)	(cubic-feet)	(cfs)
558.16	0	0.0
558.26	7	0.0
558.36	37	0.1
558.46	100	0.3
558.56	190	0.5
558.66	321	0.8
558.76	510	1.0
558.86	760	1.2
558.96	1,086	1.4
559.06	1,516	1.5
559.16	2,061	1.7
559.26	2,707	1.8
559.36	3,450	1.9
559.46	4,288	2.1
559.56	5,211	2.2
559.66	6,197	2.3
559.76	7,234	2.4
559.86	8,313	2.5
559.96	9,426	2.5
560.06	10,565	2.6
560.16	11,725	2.7
560.26	12,900	2.8
560.36	14,083	2.9
560.46	15,268	3.0
560.56	16,448	3.0
560.66	17,614	3.1
560.76	18,751	3.2
560.86	19,856	3.3
560.96	20,939	3.5
561.06	22,012	3.8
561.16	23,072	4.1
561.26	24,114	4.5
561.36	25,134	4.9
561.46	26,129	5.4
561.56	27,092	5.8
561.66	28,018	6.2
561.76	28,901	6.5
561.86	29,732	6.8
561.96	30,501	7.1
562.06	31,190	7.4
562.16	31,777	7.7
562.26	32,269	7.9
562.36	32,663	8.1
562.46	32,949	8.4
562.56	33,138	8.6
562.66	33,261	8.8
562.76	33,335	9.0
562.86	33,369	9.2
302.00		J

12" HOLE CUT — BETWEEN BOXES L 12" = 560.75'JUNCTION . BOX BOX INLET PIPE FL 24"=558.16— 9" HOLE CUT BETWEEN BOXES -JUCTION BOX SECTION

-- TOP=563.6

JUNCTION BOXES SHALL BE

BOLTED TOGETHER AS A -

SINGLE UNIT

	DETENTION POND DATA									
STORM EV (YEAR)	TORICH HUNGE CHESTE	PROPOSED SITE RUNOFF (INCLUDING OFFSITE) (CFS)	DETENTION SYSTEM WATER SURFACE ELEVATION (FT)	RELEASE FROM 9" ORIFICE (CFS)	RELEASE FROM 12" DIAMETER ORIFICE (CFS)	MAX RELEASE RATE FROM DETENTION (CFS)	BYPASS FLOW FROM THE SITE (CFS)	TOTAL RELEASE FROM THE SITE (CFS)	DETENTION VOLUME PROVIDED (CF)	CHANGE IN RUNOFF (CFS)
100	29.0	46.3	562.1	4.0	3.6	7.6	20.9	28.5	31686	-0.5
25	23.0	40.6	561.5	3.7	1.8	5.5	17.4	22.9	26461	0.0
10	20.6	33.3	561.2	3.5	0.9	4.4	15.1	19.4	23796	-1.2
5	17.1	28.2	560.8	3.2	0.0	3.2	12.8	16.0	18669	-1.1

!!! CAUTION !!! UNDERGROUND UTILITIES

EXISTING UTILITIES AND UNDERGROUND FACILITIES INDICATED ON THESE PLANS HAVE BEEN LOCATED FROM REFERENCE INFORMATION SUPPLIED BY VARIOUS PARTIES. THE ENGINEER DOES NOT ASSUME THE RESPONSIBILITY FOR THE UTILITY LOCATIONS SHOWN. IT SHALL BE THE SOLE RESPONSIBILITY OF THE CONTRACTOR(S) TO VERIFY THE HORIZONTALLY AND VERTICALLY LOCATION OF ALL UTILITIES AND UNDERGROUND FACILITIES PRIOR TO CONSTRUCTION, TO TAKE PRECAUTIONS IN ORDER TO PROTECT ALL FACILITIES ENCOUNTERED AND NOTIFY THE ENGINEER OF ALL CONFLICTS OF THE WORK WITH EXISTING FACILITIES. THE CONTRACTOR SHALL PROTECT AND MAINTAIN ALL UTILITIES FROM DAMAGE DURING CONSTRUCTION. ANY DAMAGE BY THE CONTRACTOR TO UTILITIES SHALL BE REPAIRED OR REPLACED BY THE CONTRACTOR AT THEIR CALL: TEXAS ONE CALL @ 811 AT LEAST 72 HRS PRIOR TO CONSTRUCTION.

ALL RESPONSIBILITY FOR ADEQUACY OF DESIGN REMAINS WITH THE DESIGN ENGINEER. THE CITY OF ROCKWALL, IN REVIEWING AND RELEASING PLANS FOR CONSTRUCTION, ASSUMES NO RESPONSIBILITY FOR ADEQUACY OR ACCURACY OF DESIGN.

		KE VISIONS
REV NO.	DATE	DESCRIPTION

NOTE: THESE AS-BUILT PLANS HAVE BEEN REVISED TO CONFORM WITH THE POST-CONSTRUCTION SURVEY PROVIDED BY THE CONTRACTOR. BY STATING THIS, THE ENGINEER DOES NOT ASSUME RESPONSIBILITY FOR THE WORK PERFORMED BY

AS-BUILT

NORTHEAST CORNER OF THE HEADWALL ALONG SH 276 ELEVATION=563.33 THE CONTRACTOR. SAID RESPONSIBILITY REMAINS SOLELY WITH CONTRACTOR SHALL COORDINATE WITH THE SURVEYOR FOR SITE BENCHMARKS AND CONTROL POINT

THE CONTRACTOR.

100 Year Storm	<b>Existing Conditions</b>	<u>1</u>	.00 Year Storm Post Cor	ntruction Conditions
Site Areas	: R, S, T, U, V, Y, Z	Site	Areas: S, T, U, V	Bypass Areas: OS12, R, Y, Z
C:	0.35	C:	0.90	C(Site): 0.9
T':	20 Min	Т:	10 Min	T : 10 Min
1 0 0 :	8.3 In/Hr	l'**:	9.8 In/Hr	I <sup>···</sup> : 9.8 In/Hr
Area:	2.92 Acres	Area:	1.16 Acres	Area: 1.77 Acres
<b>Q</b> , , ,	8.50 CFS	<b>Q</b> ' · · :	10.22 CFS	Q 20.90 CFS
Offsite Areas:	OS10, OS11, OS12	Offsite	Areas: OS10, OS11	The existing release from the site and offsite is
C(Offsite):	0.35	C(Offsite):	0.35	28.99 CFS. The bypass from the site is being
T:	20 Min	T:	20 Min	proposed as sheetflow to match existing
1100	8.3 In/Hr	['**:	8.3 In/Hr	sheetflow conditions. The bypass from the site
Area:	7.06 Acres	Area:	5.22 Acres	and offsite is 20.90 CFS, which allows for a
<b>Q</b> ****	20.50 CFS	$\mathbf{Q}^{\cdots}$	15.17 CFS	maximum release from the detention system of
				8.09 cfs
Total Runoff:	28.99 CFS	Total Runoff:	25.39 CFS	
			Total Rui	noff: 46.29 CFS

Allowed Release (-Bypass): 8.09 CFS

		Develope	ed + Offsite	Allowed		
Duration (Min)	Intensity (In/Hr)	Flow (CFS)	Inflow (CF)	Outflow (CF)	Storage (CF)	Storage (Acre-Ft)
10	9.80	25.39	15,233	4,853	10,380	0.24
20	8.30	21.27	25,518	7,279	18,239	0.42
30	6.90	17.80	32,031	9,706	22,325	0.51
40	5.80	15.19	36,447	12,132	24,314	0.56
50	5.00	13.44	40,314	14,559	25,756	0.59
60	4.50	12.00	43,211	16,985	26,225	0.60
70	4.00	10.93	45,920	19,412	26,508	0.61
80	3.70	10.26	49,224	21,838	27,386	0.63
90	3.50	9.86	53,264	24,265	29,000	0.67
100	3.40	9.39	56,363	26,691	29,672	0.68
110	3.20	8.36	55,194	29,118	26,077	0.60
120	2.75	6.52	46,963	31,544	15,419	0.35
180	2.00	4.46	48,181	46,103	2,078	0.05
360	1.30	1.36	29,269	89,779	-60,510	-1.39

Note: The referenced in this sheet are from the proposed drainage area map.

10 Year Storm E	xisting Conditions	<u>1</u>	10 Year Storm Post Con	truction Condition	<u>s</u>
Site Areas:	R, S, T, U, V, Y, Z	Site .	Areas: S, T, U, V	Bypass Area	s: OS12, R, Y, Z
C:	0.35	C:	0.90	C(Site):	0.9
Т:	20 Min	Т:	10 Min	<b>T</b> `:	10 Min
ľ°:	5.9 ln/Hr	[**:	7.1 In/Hr	l¹°:	7.1 ln/Hr
Area:	2.92 Acres	Area:	1.16 Acres	Area:	1.77 Acres
$\mathbf{Q}^{(0)}$	6.04 CFS	<b>Q</b> '° :	7.40 CFS	Q'°'	15.07 CFS
Offsite Areas: 0	OS10, OS11, OS12	Offsite .	Areas: OS10, OS11	The existing re	elease from the site and offsite
C(Offsite):	0.35	C(Offsite):	0.35	20.64 CFS. Th	ne bypass from the site is being
T :	20 Min	Т:	20 Min	proposed a	s sheetflow to match existing
ľ°:	5.9 In/Hr	l**:	5.9 In/Hr	sheetflow cor	ditions. The bypass from the sit
Area:	7.06 Acres	Area:	5.22 Acres	and offsite	is 15.07 CFS, which allows for a
Q'°'	14.60 CFS	Q'°	10.80 CFS	maximum rele	ase from the detention system
					5.57 cfs

18.20 CFS

**Total Runoff:** 33.27 CFS Allowed Release (-Bypass): 5.57 CFS

Total Runoff:

						Allowedit
		Develope	ed + Offsite	Allowed		
Duration (Min)	Intensity (In/Hr)	Flow (CFS)	Inflow (CF)	Outflow (CF)	Storage (CF)	Storage (Acre-Ft)
10	7.10	18.19	10,912	3,340	7,572	0.17
20	5.90	14.92	17,910	5,010	12,899	0.30
30	4.80	12.32	22,168	6,680	15,488	0.36
40	4.00	10.57	25,363	8,351	17,012	0.39
50	3.50	9.13	27,398	10,021	17,377	0.40
60	3.00	8.25	29,685	11,691	17,994	0.41
70	2.80	7.67	32,221	13,361	18,860	0.43
80	2.60	7.28	34,946	15,031	19,915	0.46
90	2.50	6.99	37,764	16,701	21,063	0.48
100	2.40	6.71	40,237	18,371	21,866	0.50
110	2.30	5.87	38,747	20,041	18,706	0.43
120	1.90	4.54	32,687	21,712	10,975	0.25
180	1.40	2.92	31,555	31,732	-177	0.00
360	0.80	0.83	18,012	61,794	-43,782	-1.01

Note: The referenced in this sheet are from the proposed drainage area map.

20.64 CFS

# !!! CAUTION !!! UNDERGROUND UTILITIES

Total Runoff

EXISTING UTILITIES AND UNDERGROUND FACILITIES INDICATED ON THESE PLANS HAVE BEEN LOCATED FROM REFERENCE INFORMATION SUPPLIED BY VARIOUS PARTIES. THE ENGINEER DOES NOT ASSUME THE RESPONSIBILITY FOR THE UTILITY LOCATIONS SHOWN. IT SHALL BE THE SOLE RESPONSIBILITY OF THE CONTRACTOR(S) TO VERIFY THE HORIZONTALLY AND VERTICALLY LOCATION OF ALL UTILITIES AND UNDÈRGROUND FACILITIES PRIOR TO CONSTRUCTION, TO TAKE PRECAUTIONS IN ORDER TO PROTECT ALL FACILITIES ENCOUNTERED AND NOTIFY THE ENGINEER OF ALL CONFLICTS OF THE WORK WITH EXISTING FACILITIES. THE CONTRACTOR SHALL PROTECT AND MAINTAIN ALL UTILITIES FROM DAMAGE DURING CONSTRUCTION. ANY DAMAGE BY THE CONTRACTOR TO UTILITIES SHALL BE REPAIRED OR REPLACED BY THE CONTRACTOR AT THEIR CALL: TEXAS ONE CALL @ 811 AT LEAST 72 HRS PRIOR TO CONSTRUCTION.

ALL RESPONSIBILITY FOR ADEQUACY OF DESIGN REMAINS WITH THE DESIGN ENGINEER. THE CITY OF ROCKWALL, IN REVIEWING AND RELEASING PLANS FOR CONSTRUCTION, ASSUMES NO RESPONSIBILITY FOR ADEQUACY OR ACCURACY OF DESIGN.

			REVISIONS
	REV NO.	DATE	DESCRIPTION
-			

S HAVE BEEN REVISED TO THE CONTRACTOR. SAID RESPONSIBILITY REMAINS SOLELY WITH THE CONTRACTOR.

TRUCTION SURVEY PROVIDED NG THIS, THE ENGINEER DOES R THE WORK PERFORMED BY

NORTHEAST CORNER OF THE HEADWALL ALONG SH 276 ELEVATION=563.33

**25 Year Storm Post Contruction Conditions** 

**Total Runoff:** 

**5 Year Storm Post Contruction Conditions** 

**Total Runoff:** 

Site Areas: S, T, U, V

Offsite Areas: OS10, OS11

0.21

0.35

0.43

0.48

0.50

0.53

0.57

0.60

0.61

0.60 0.52

0.38

0.15

-0.92

Site Areas: S, T, U, V

Offsite Areas: OS10, OS11

0.15

0.26

0.32

0.33

0.35

0.38

0.41

0.42

0.41

0.40

0.37

0.26

0.06

-0.74

0.35

20 Min

4.9 In/Hr

5.22 Acres

9.00 CFS

15.36 CFS

Allowed Release (-Bypass):

10 Min

6.1 In/Hr

1.16 Acres

6.36 CFS

0.35

20 Min

6.6 In/Hr

5.22 Acres

14.50 CFS

23.15 CFS

Allowed Release (-Bypass):

Area:

 $\mathbf{Q}_{i}$ 

C(Offsite):

2 5

Area:

Q<sup>2</sup> <sup>5</sup>

**Total Runoff:** 

9,114

15,347

18,824

20,767

21,755

23,245

24,985

26,035

26,397

26,069

22,640

16,582

6,391

-39,958

l':

Area:

C(Offsite):

5 :

Area:

**Total Runoff:** 

6,625

11,276

13,750

14,378

15,320

16,574

17,906

18,392

17,751

17,519

16,298

11,130

2,567

-32,142

Inflow (CF) Outflow (CF) Storage (CF) Storage (Acre-Ft)

Allowed

2,565

3,847

5,130

6,412

7,695

8,977

10,260

11,542

12,825

14,107

15,390

16,672

24,367

47,452

Allowed

3,316

4,974

6,632

8,290

9,948

11,606

13,264

14,922

18,238

19,896

21,554

31,502

61,347

16,580

0.90

10 Min

8.3 In/Hr

1.16 Acres

8.65 CFS

Bypass Areas: OS12, R, Y, Z

0.9

10 Min

8.3 In/Hr

1.77 Acres

The existing release from the site and offsite is 22.96 CFS. The bypass from the site is being

proposed as sheetflow to match existing

sheetflow conditions. The bypass from the site

and offsite is 17.43 CFS, which allows for a

maximum release from the detention system of

5.53 cfs

17.43 CFS

C(Site):

Area:

 $Q^{(i)}$ 

40.58 CFS

5.53 CFS

Bypass Areas: OS12, R, Y, Z

C(Site):

Area:

l':

Q'

28.20 CFS

4.27 CFS

0.9

10 Min

6.1 In/Hr

1.77 Acres

The existing release from the site and offsite is 17.12 CFS. The bypass from the site is being

proposed as sheetflow to match existing

sheetflow conditions. The bypass from the site

and offsite is 12.84 CFS, which allows for a

maximum release from the detention system of

4.27 cfs

12.84 CFS

CONTRACTOR SHALL COORDINATE WITH THE SURVEYOR FOR SITE BENCHMARKS AND CONTROL POINT

	10/20/25
Cumulus Design	Firm #14810

2080 N. Highway 360, Suite 240 Grand Prairie, Texas 75050 Tel. 214.235.0367

DETENTION CALCULATIONS (S) 4649 HIGHWAY 276

10 13 1110111111 270	
CITY OF ROCKWALL	
ROCKWALL COUNTY, TEXAS	
J.H. BAILEY SURVEY, ABST NO.	34

DATE PROJECT NO DRAWING SCALE SHEET CD22011 10/20/25 N.T.S

		REVISIONS	NOTE: THESE AS-BUILT PLANS
NO.	DATE	DESCRIPTION	CONFORM WITH THE POST-CONSTR
			BY THE CONTRACTOR. BY STATING
			NOT ASSUME RESPONSIBILITY FOR
			THE CONTRACTOR CAIR RECOGNICE

**25 Year Storm Existing Conditions** 

Τ:

Area:

 $\mathbf{Q}$ 

C(Offsite):

Area:

Q° '

Total Runoff:

10

20

30

40

50

60

70

80

90

100

110

120

180

360

Τ:

l':

Area:

C(Offsite):

T :

5

Area:

Total Runoff:

20

30

40

50

60

70

80

90

100

110

120

180 360

Site Areas: R, S, T, U, V, Y, Z

Offsite Areas: OS10, OS11, OS12

8.30

6.60

5.50

4.60

4.00

3.50

3.30

3.10

2.90

2.70

2.50

2.10

1.70

0.95

**5 Year Storm Existing Conditions** 

Offsite Areas: OS10, OS11, OS12

Duration (Min) Intensity (In/Hr) Flow (CFS)

6.10

4.90

4.10

3.40

2.80

2.60

2.40

2.30

2.10

1.90

1.80

1.60

1.20

0.68

Site Areas: R, S, T, U, V, Y, Z

0.35

20 Min

4.9 In/Hr

2.92 Acres

20 Min

4.9 In/Hr

7.06 Acres

Developed + Offsite

9,190

15,123

18,880

20,790

23,015

25,551

28,166

29,935

30,576

31,626

31,688

27,803

26,934

15,310

15.32

12.60

10.49

8.66

7.67

7.10

6.71

6.24

5.66

5.27

4.80

3.86

2.49

0.71

Note: The referenced in this sheet are from the proposed drainage area map.

12.10 CFS

17.12 CFS

5.02 CFS

0.35

20 Min

6.6 In/Hr

2.92 Acres

6.76 CFS

0.35

20 Min

6.6 In/Hr

7.06 Acres

16.20 CFS

22.96 CFS

Developed + Offsite

20.72

16.93

14.14

12.11

10.57

9.68

9.11

8.53

7.96

7.38

6.44

5.30

3.51

0.99

Note: The referenced in this sheet are from the proposed drainage area map.

| Duration (Min) | Intensity (In/Hr) | Flow (CFS) | Inflow (CF) | Outflow (CF) | Storage (CF) | Storage (Acre-Ft) |

12,430

20,321

25,456

29,057

31,703

34,851

38,249

40,957

42,977


44,307


42,536


38,136


37,894


21,389

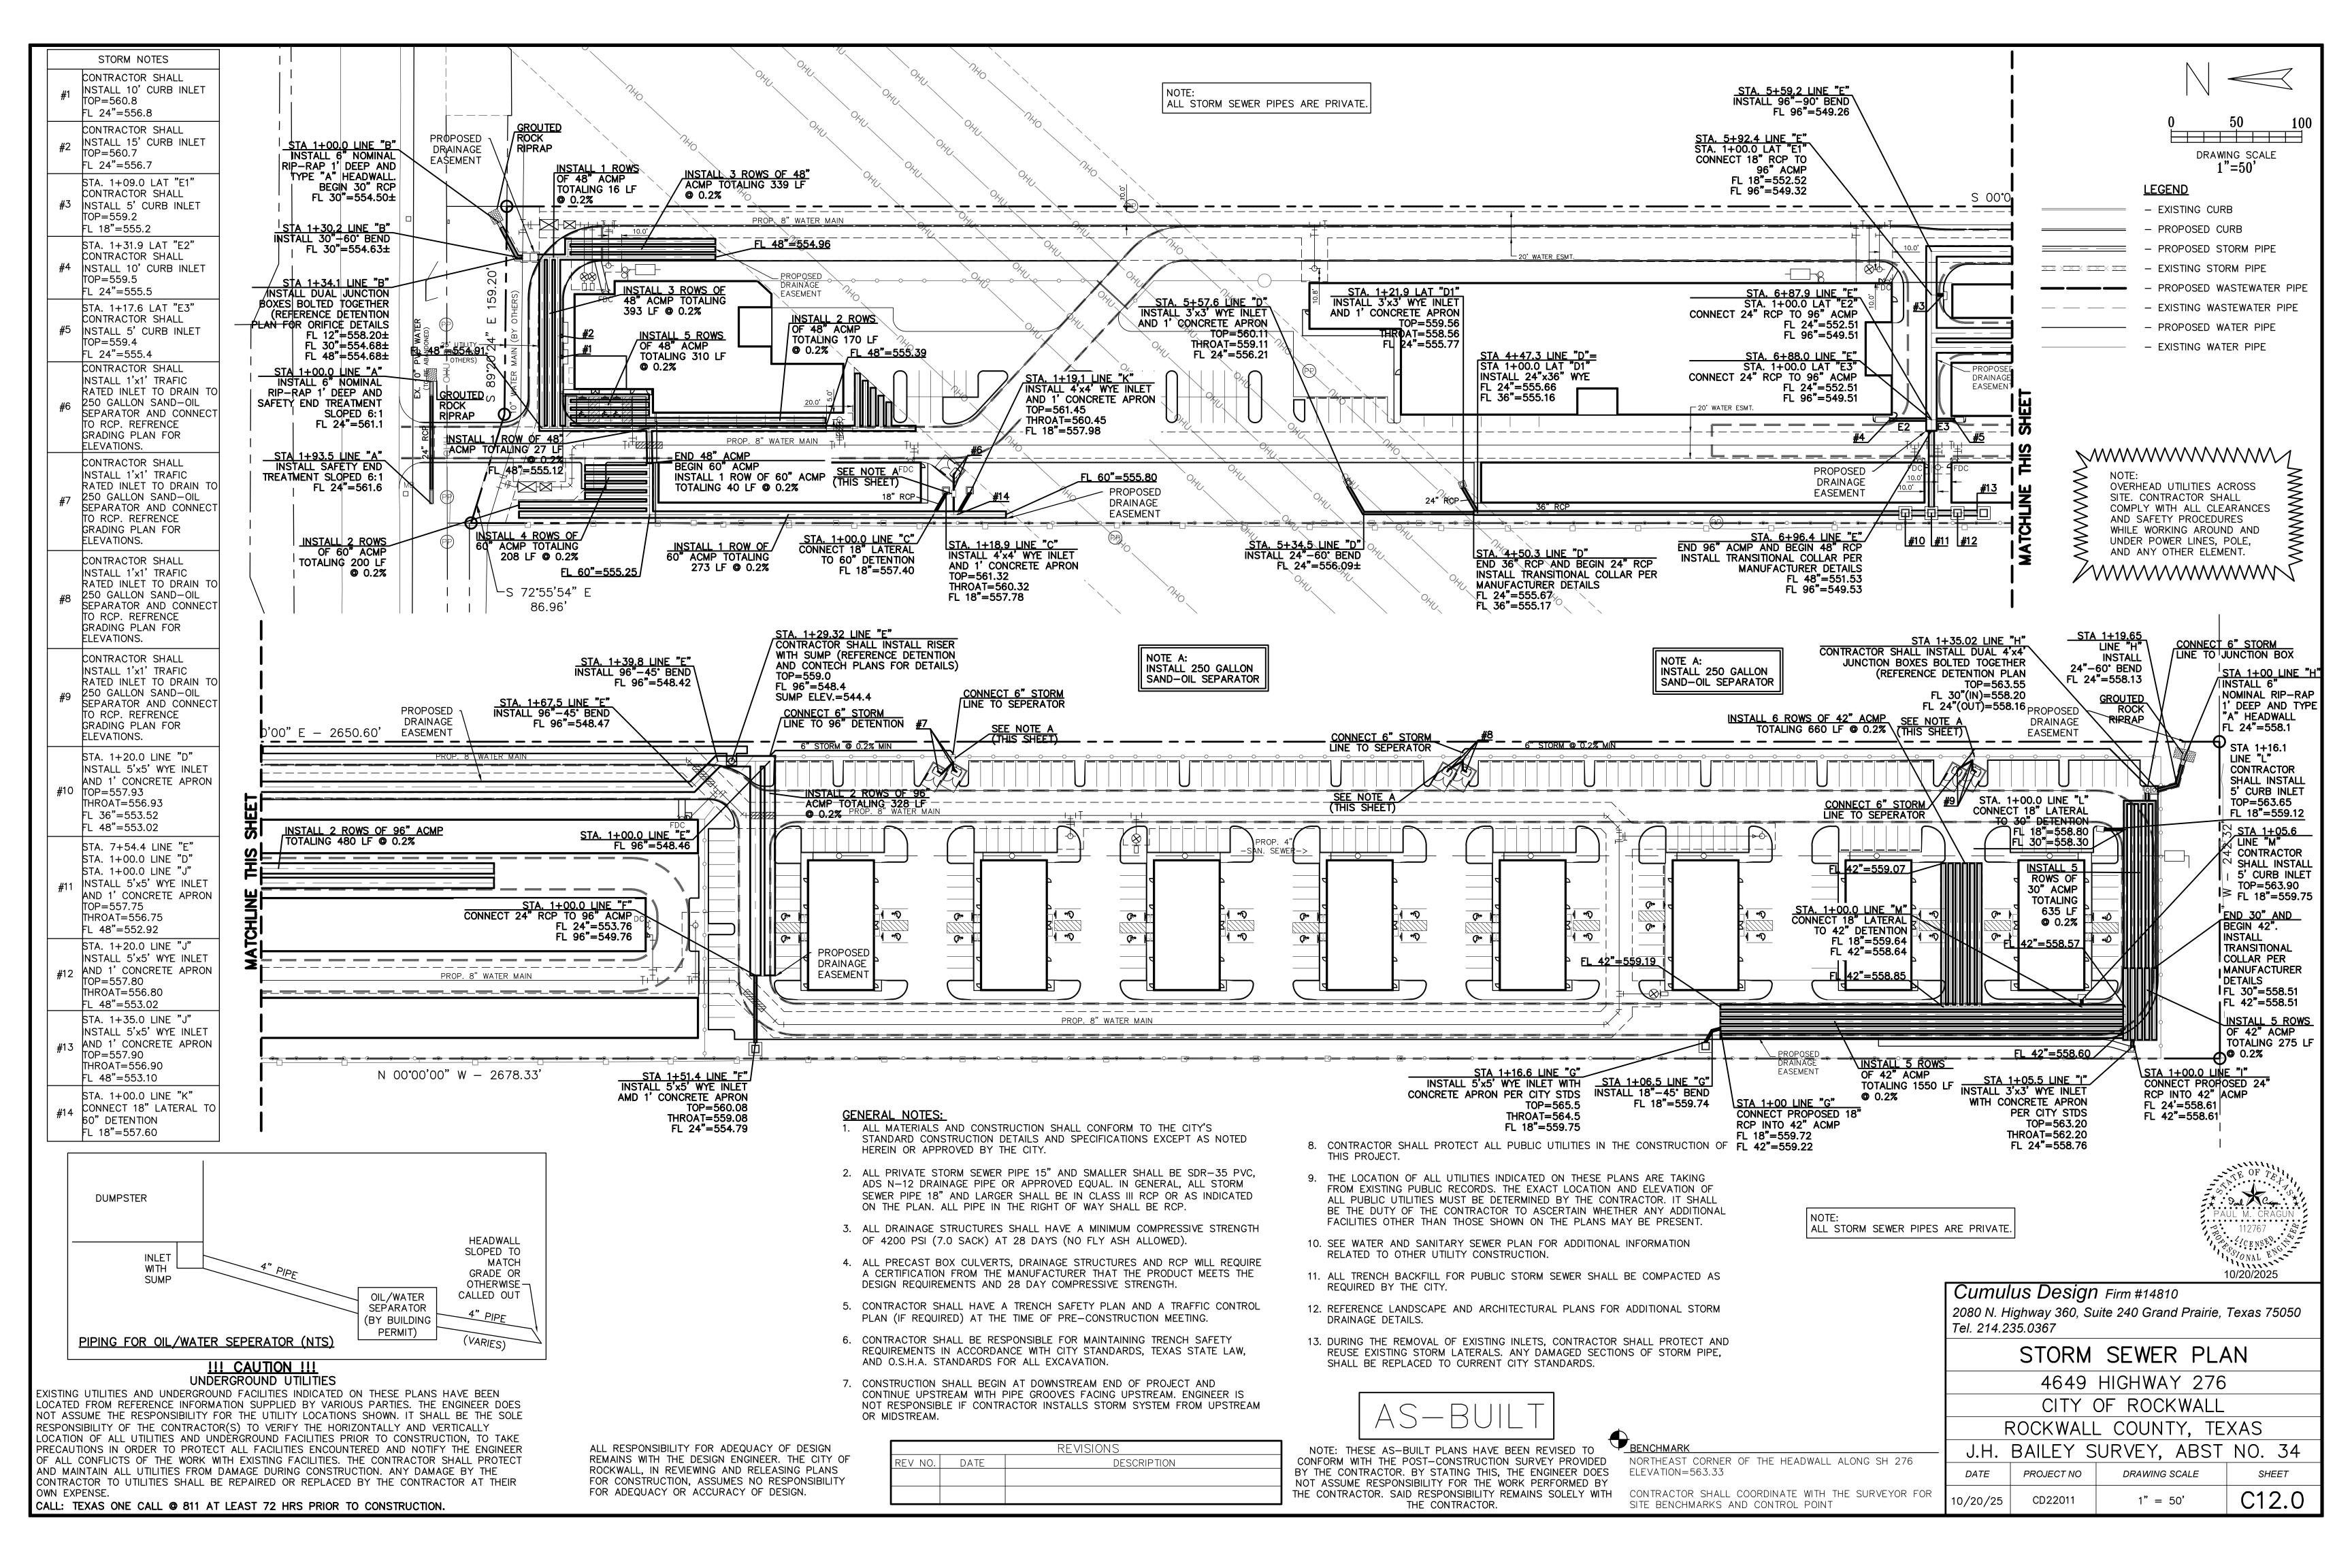


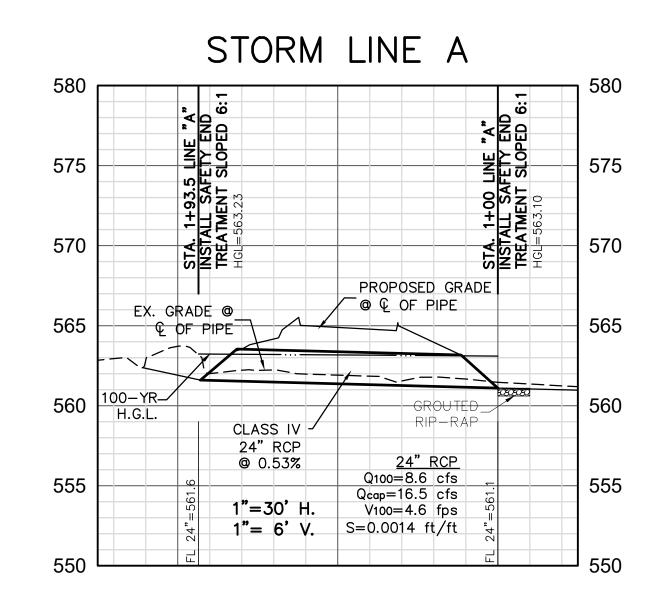

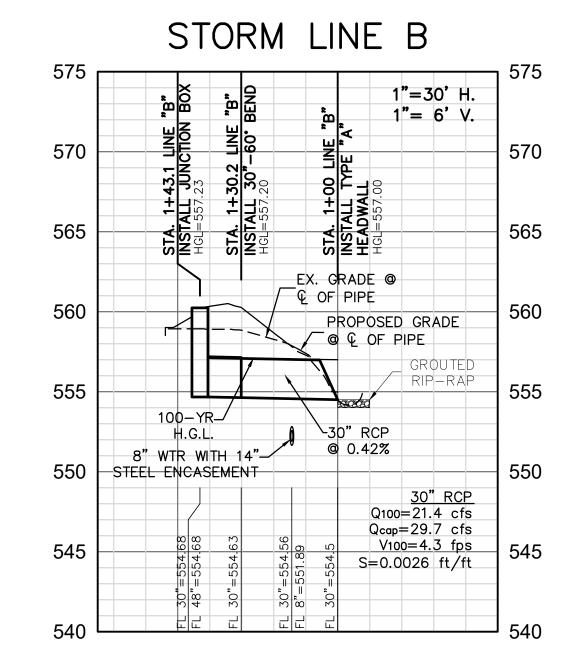

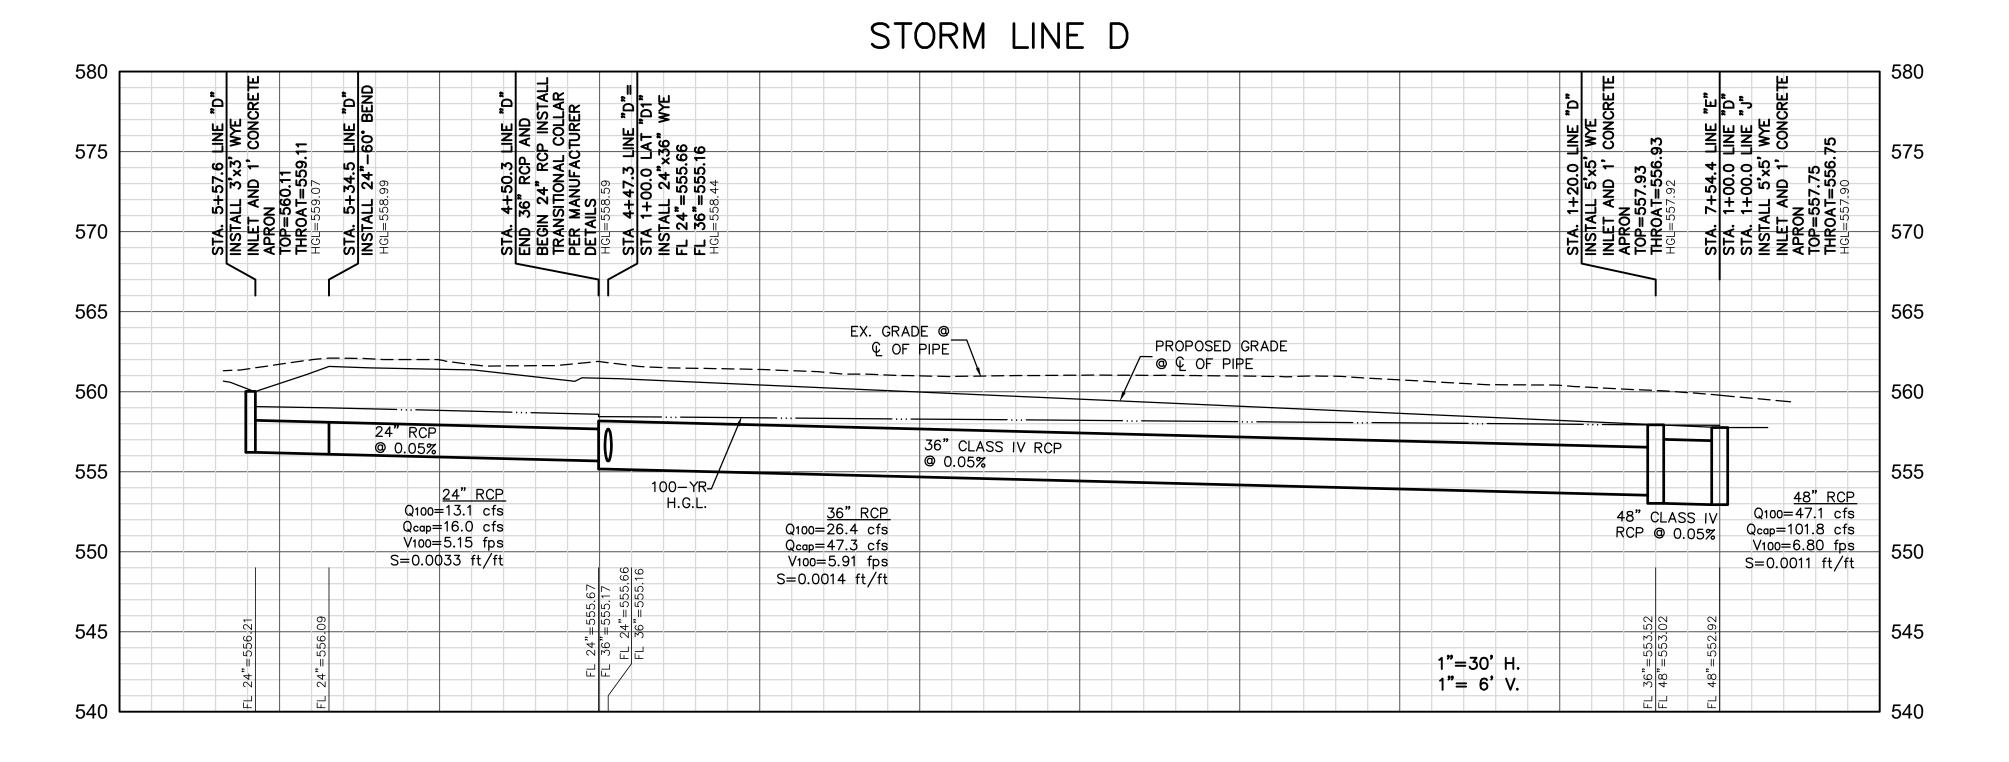

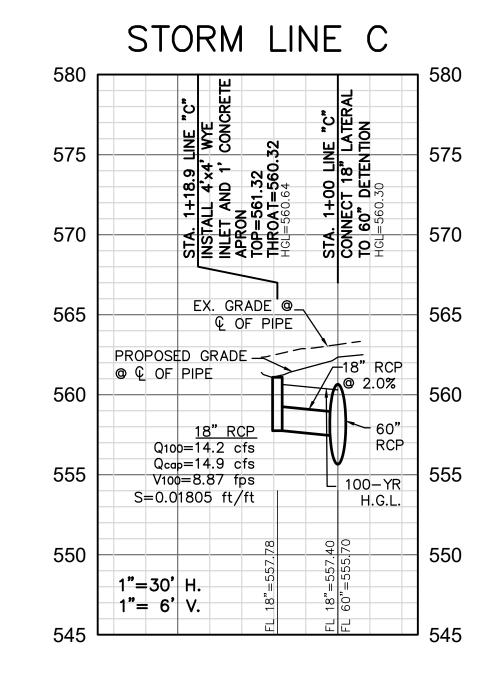

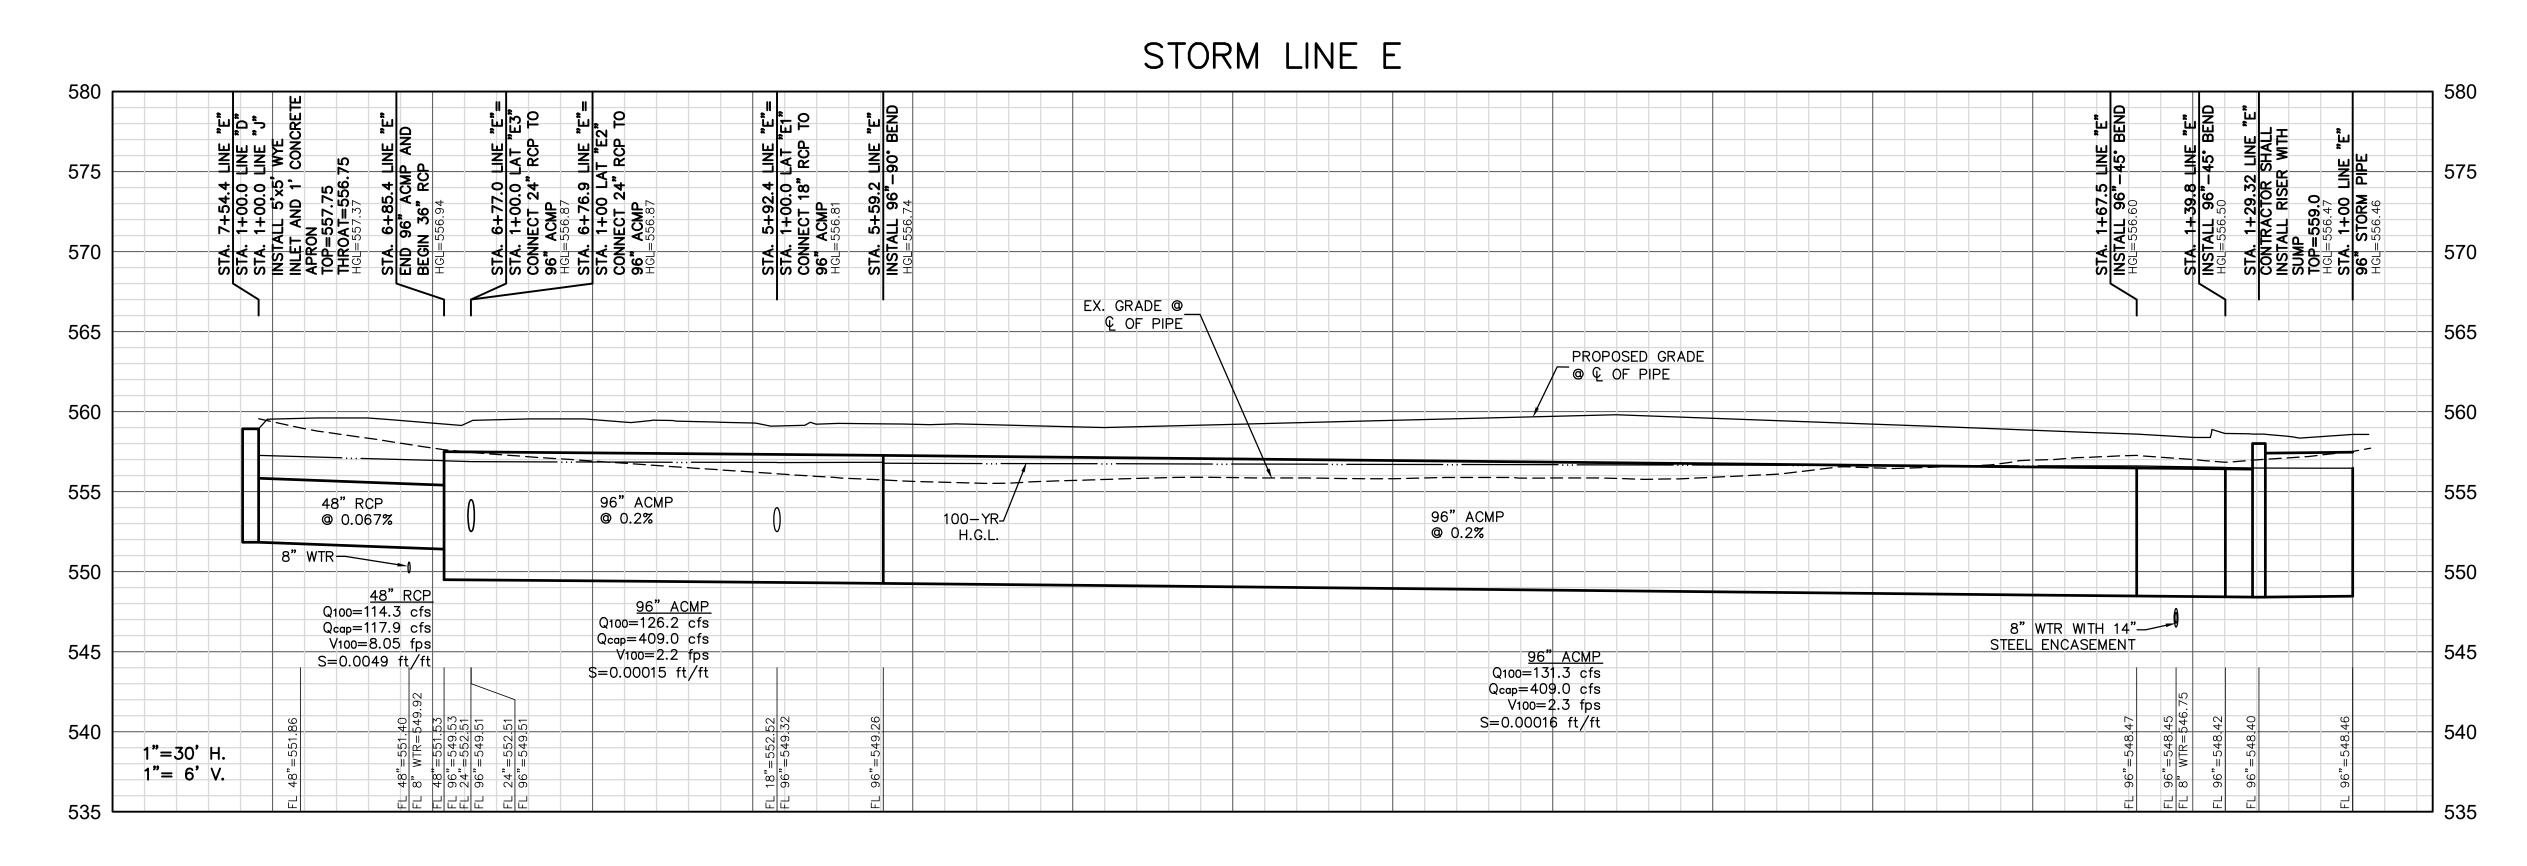



# !!! CAUTION !!! UNDERGROUND UTILITIES

EXISTING UTILITIES AND UNDERGROUND FACILITIES INDICATED ON THESE PLANS HAVE BEEN LOCATED FROM REFERENCE INFORMATION SUPPLIED BY VARIOUS PARTIES. THE ENGINEER DOES NOT ASSUME THE RESPONSIBILITY FOR THE UTILITY LOCATIONS SHOWN. IT SHALL BE THE SOLE RESPONSIBILITY OF THE CONTRACTOR(S) TO VERIFY THE HORIZONTALLY AND VERTICALLY LOCATION OF ALL UTILITIES AND UNDERGROUND FACILITIES PRIOR TO CONSTRUCTION, TO TAKE PRECAUTIONS IN ORDER TO PROTECT ALL FACILITIES ENCOUNTERED AND NOTIFY THE ENGINEER OF ALL CONFLICTS OF THE WORK WITH EXISTING FACILITIES. THE CONTRACTOR SHALL PROTECT AND MAINTAIN ALL UTILITIES FROM DAMAGE DURING CONSTRUCTION. ANY DAMAGE BY THE CONTRACTOR TO UTILITIES SHALL BE REPAIRED OR REPLACED BY THE CONTRACTOR AT THEIR CALL: TEXAS ONE CALL @ 811 AT LEAST 72 HRS PRIOR TO CONSTRUCTION.

ALL RESPONSIBILITY FOR ADEQUACY OF DESIGN REMAINS WITH THE DESIGN ENGINEER. THE CITY OF ROCKWALL, IN REVIEWING AND RELEASING PLANS FOR CONSTRUCTION. ASSUMES NO RESPONSIBILITY FOR ADEQUACY OR ACCURACY OF DESIGN.

		REVISIONS
REV NO.	DATE	DESCRIPTION

NOTE: THESE AS-BUILT PLANS HAVE BEEN REVISED TO CONFORM WITH THE POST-CONSTRUCTION SURVEY PROVIDED BY THE CONTRACTOR. BY STATING THIS, THE ENGINEER DOES NOT ASSUME RESPONSIBILITY FOR THE WORK PERFORMED BY


THE CONTRACTOR.


**BENCHMARK** NORTHEAST CORNER OF THE HEADWALL ALONG SH 276 ELEVATION=563.33 CONTRACTOR SHALL COORDINATE WITH THE SURVEYOR FOR THE CONTRACTOR. SAID RESPONSIBILITY REMAINS SOLELY WITH


SITE BENCHMARKS AND CONTROL POINT


Cumulus Design Firm #14810 2080 N. Highway 360, Suite 240 Grand Prairie, Texas 75050 Tel. 214.235.0367 STORM PROFILE 4649 HIGHWAY 276


CITY OF ROCKWALL ROCKWALL COUNTY, TEXAS J.H. BAILEY SURVEY, ABST NO. 34 PROJECT NO DATE DRAWING SCALE SHEET C12.1 CD22011 10/20/25

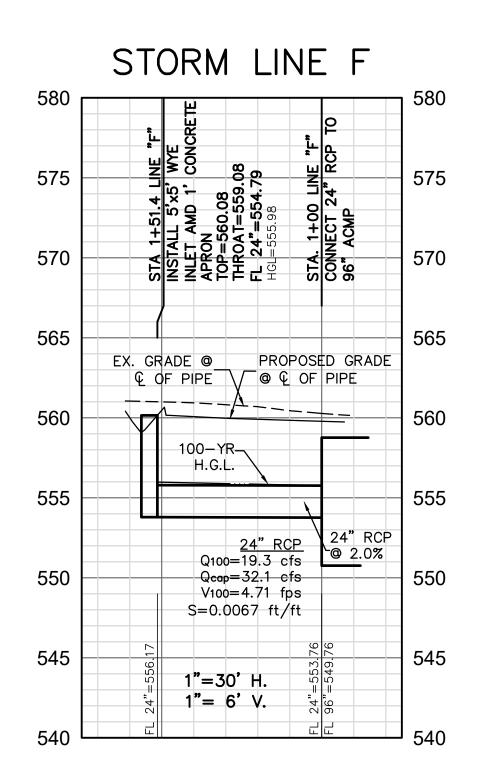


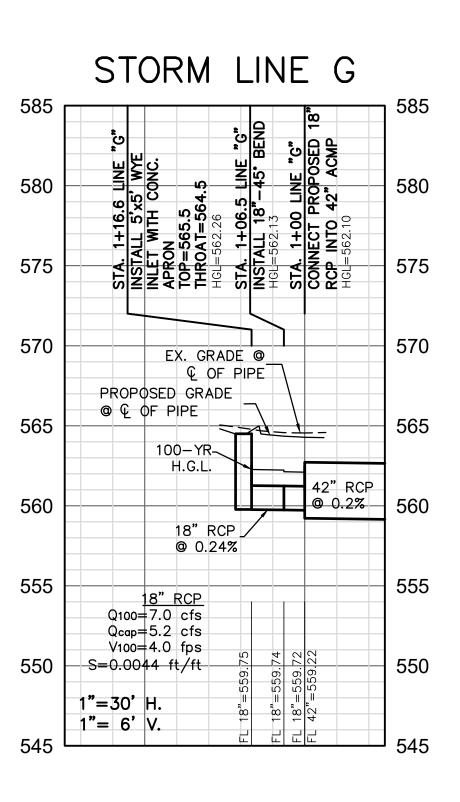


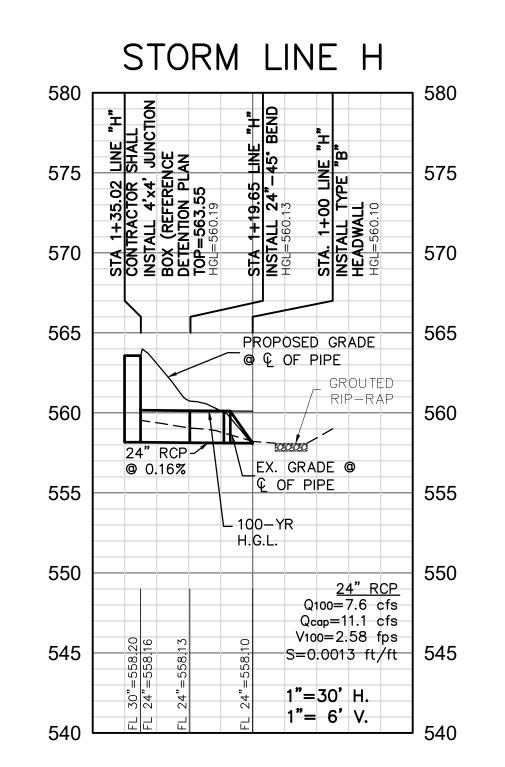


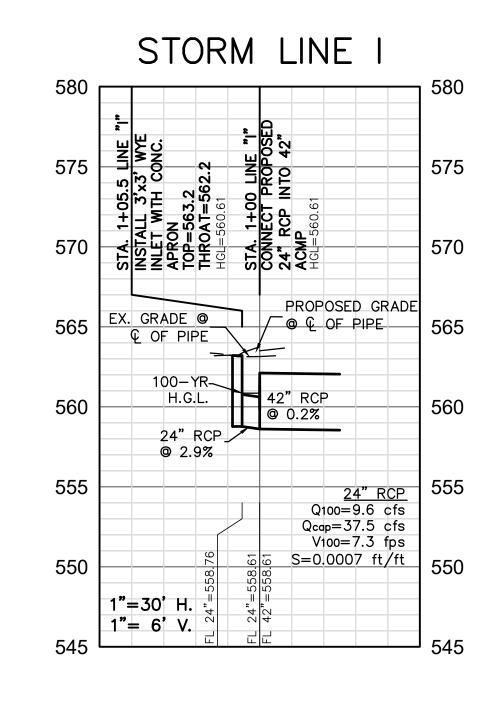

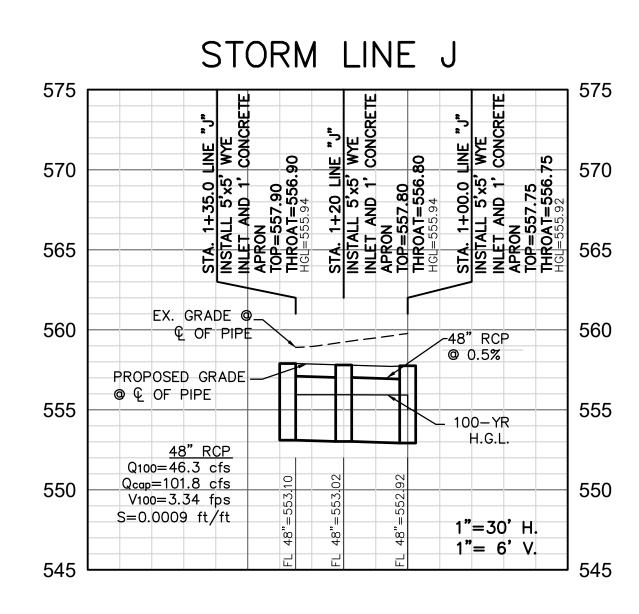

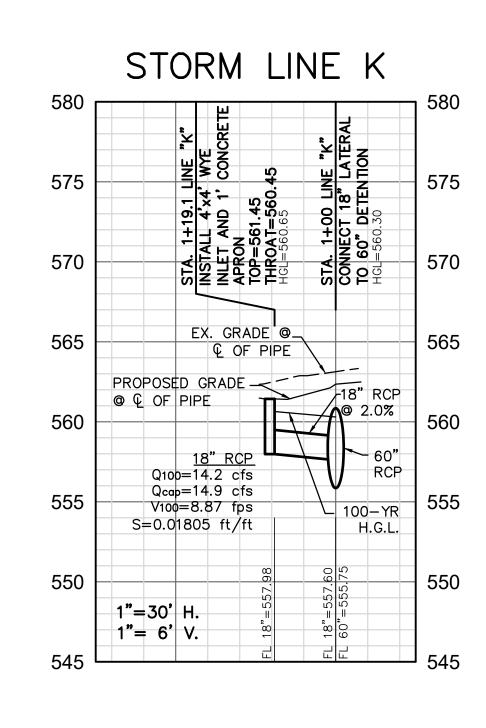

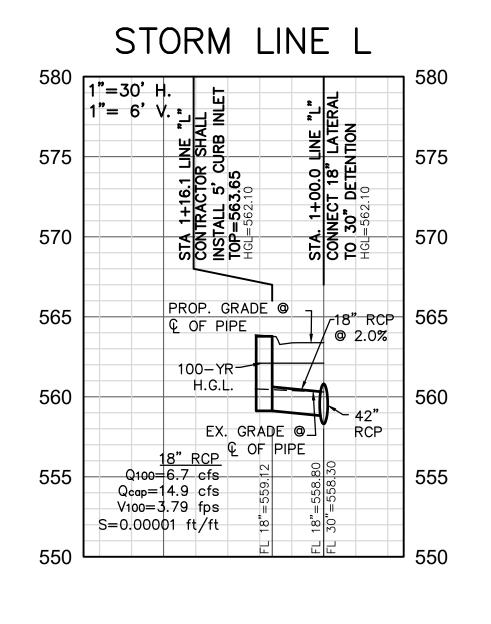

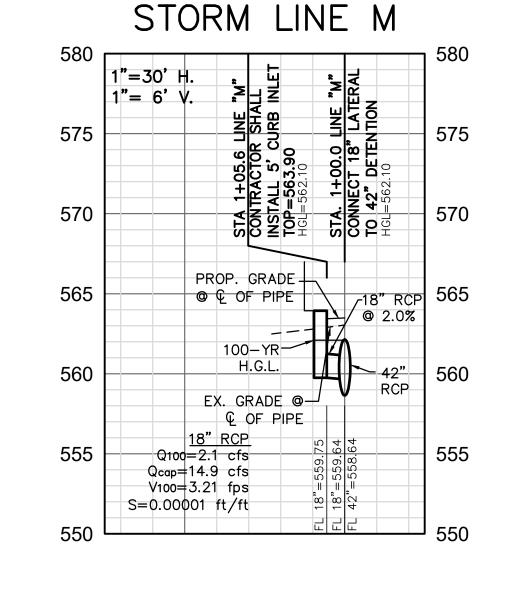



!!! CAUTION !!! UNDERGROUND UTILITIES

EXISTING UTILITIES AND UNDERGROUND FACILITIES INDICATED ON THESE PLANS HAVE BEEN LOCATED FROM REFERENCE INFORMATION SUPPLIED BY VARIOUS PARTIES. THE ENGINEER DOES NOT ASSUME THE RESPONSIBILITY FOR THE UTILITY LOCATIONS SHOWN. IT SHALL BE THE SOLE RESPONSIBILITY OF THE CONTRACTOR(S) TO VERIFY THE HORIZONTALLY AND VERTICALLY LOCATION OF ALL UTILITIES AND UNDÈRGROUND FACILITIES PRIOR TO CONSTRUCTION, TO TAKE PRECAUTIONS IN ORDER TO PROTECT ALL FACILITIES ENCOUNTERED AND NOTIFY THE ENGINEER OF ALL CONFLICTS OF THE WORK WITH EXISTING FACILITIES. THE CONTRACTOR SHALL PROTECT AND MAINTAIN ALL UTILITIES FROM DAMAGE DURING CONSTRUCTION. ANY DAMAGE BY THE CONTRACTOR TO UTILITIES SHALL BE REPAIRED OR REPLACED BY THE CONTRACTOR AT THEIR CALL: TEXAS ONE CALL @ 811 AT LEAST 72 HRS PRIOR TO CONSTRUCTION.

ALL RESPONSIBILITY FOR ADEQUACY OF DESIGN REMAINS WITH THE DESIGN ENGINEER. THE CITY OF ROCKWALL, IN REVIEWING AND RELEASING PLANS FOR CONSTRUCTION, ASSUMES NO RESPONSIBILITY FOR ADEQUACY OR ACCURACY OF DESIGN.

		REVISIONS
REV NO.	DATE	DESCRIPTION

AS-BUIL

NOTE: THESE AS-BUILT PLANS HAVE BEEN REVISED TO CONFORM WITH THE POST-CONSTRUCTION SURVEY PROVIDED BY THE CONTRACTOR. BY STATING THIS, THE ENGINEER DOES NOT ASSUME RESPONSIBILITY FOR THE WORK PERFORMED BY THE CONTRACTOR. SAID RESPONSIBILITY REMAINS SOLELY WITH THE CONTRACTOR. SITE BENCHMARKS AND CONTROL POINT

NORTHEAST CORNER OF THE HEADWALL ALONG SH 276 ELEVATION=563.33 CONTRACTOR SHALL COORDINATE WITH THE SURVEYOR FOR

	Cumulus Design Firm #14810 2080 N. Highway 360, Suite 240 Grand Prairie, Texas 75050 Tel. 214.235.0367
	STORM PROFILE
	4649 HIGHWAY 276
	CITY OF ROCKWALL
	ROCKWALL COUNTY, TEXAS
_	J.H. BAILEY SURVEY, ABST NO. 34

J.H.	RAILEY S	URVEY, ABST	NO. 34
DATE	PROJECT NO	DRAWING SCALE	SHEET
10/20/25	CD22011		C12.2

Collection Point Pipe Length Number of Pipe Size Box Size	Wetted Hydraulic Manning's Flowline Elevations Slope Incremental Drainage Area	Accumulated Up Stream Design Year Intensity Runoff Conduit Capacity Partial Velocity Time in Friction Slope Friction	Hydraulic Grade Line Headloss Calculations Design Top of Curb HGL Depth
System ID Downstream Upstream (ft) Barrels (in) Span (ft) Rise (ft) Type Area (ft²)	Perimeter (ft) Radius (ft) n Downstream Upstream (ft/ft) Drainage Area (acres) Runoff "C" Incremental (C*A)	1	ownstream (ft) Upstream (ft) V1²/2g (ft) V2²/2g (ft) Junction Type Coefficient (Kj) Head-Loss (HL) HGL Elevation Below (T/C)
Line "A" 1+00.0 1+93.5 93.5 1 24 RCP 3.14	6.28 0.5 0.013 561.10 561.60 0.0053 RD 0.97 0.90 0.87	0.87 10 100 9.8 8.6 16.59 Yes 2.74 0.57 0.0014 0.13	563.10 563.23 0.12 0.01 Inlet Box 1.25 0.01 0.0015 565.6 2.37
System ID Collection Point Pipe Length Number of Pipe Size Box Size Type Area (ft²)	Wetted Hydraulic Manning's Flowline Elevations Slope Incremental Drainage Area  Provided Area (1) Provided Area (2) Provided Area (3) Provided Area (4) Prov	Accumulated Up Stream Design Year Intensity Runoff Conduit Capacity Partial Velocity Time in Friction Slope Friction (C*A) (Tc) Storm Frequency (in/hr) (cfs) (CFS) Flow (ft/sec) Conduit (min) (ft/ft) Headloss (ft) Design Year Intensity Runoff Conduit Capacity Partial Velocity Time in Friction Slope Friction (CFS)	Hydraulic Grade Line Headloss Calculations Design Top of Curb HGL Depth  Remarks
Downstream   Upstream   (ft)   Barrels   (in)   Span (ft)   Rise (ft)     Rice (ft)     Line"B"   1+00.0   1+30.2   30.2   1   30     RCP   4.91	Perimeter (ft) Radius (ft) n Downstream Upstream (ft/ft) Drainage Area (acres) Runoff "C" Incremental (C*A) 7.85 0.625 0.013 554.50 554.63 0.0042	(C*A)         (Tc)         Storm Frequency         (in/hr)         (cfs)         (CFS)         Flow         (ft/sec)         Conduit (min)         (ft/ft)         Headloss (ft)         Dr           NA         10         100         9.8         21.4         26.65         Yes         4.30         0.12         0.0027         0.08	ownstream (ft)         Upstream (ft)         V1²/2g (ft)         V2²/2g (ft)         Junction Type         Coefficient (Kj)         Head-Loss (HL)         HGL         Elevation         Below (T/C)           557.00         557.08         0.29         0.29         60° Bend         0.43         0.12         0.0066         560.5         3.42
Line"B"         1+00.0         1+30.2         30.2         1         30         RCP         4.91           Line"B"         1+30.2         1+43.1         12.9         1         30         RCP         4.91	7.85 0.625 0.013 554.50 554.63 0.0042	NA 10 100 9.8 21.4 26.65 Yes 4.30 0.05 0.0027 0.03	557.00         557.08         0.29         0.29         60° Bend         0.43         0.12         0.0066         560.5         3.42           557.20         557.23         0.29         Junction Box         0.55         0.36         0.0031         560.5         3.27
System ID Collection Point Pipe Length Number of Pipe Size Box Size Type Area (ft²)	Wetted Hydraulic Manning's Flowline Elevations Slope Incremental Drainage Area	Accumulated Up Stream Design Year Intensity Runoff Conduit Capacity Partial Velocity Time in Friction Slope Friction	Hydraulic Grade Line Headloss Calculations Design Top of Curb HGL Depth Remarks
Downstream Upstream (ft) Barrels (in) Span (ft) Rise (ft)	Perimeter (tt)   Radius (tt)   n   Downstream Opstream (tt/tt)   Drainage Area (acres)   Runott "C"   Incremental (C"A)		ownstream (ft) Upstream (ft) V1²/2g (ft) V2²/2g (ft) Junction Type Coefficient (Kj) Head-Loss (HL) HGL Elevation Below (T/C)
Line"C" 1+00.0 1+18.9 18.9 1 18 RCP 1.77	4.71 0.375 0.013 557.40 557.78 0.0200 E, OS2, OS3 1.85 0.78 1.45	1.45 10 100 9.8 14.2 14.90 Yes 8.87 0.04 0.0181 0.34	560.30         560.64         1.22         1.22         Wye Inlet         1.25         1.53         0.0212         561.32         0.68
System ID Collection Point Pipe Length Number of Pipe Size Box Size Type Area (ft²)	Wetted Hydraulic Manning's Flowline Elevations Slope Incremental Drainage Area	Accumulated Up Stream Design Year Intensity Runoff Conduit Capacity Partial Velocity Time in Friction Slope Friction	Hydraulic Grade Line Headloss Calculations Design Top of Curb HGL Depth
System ID Downstream Upstream (ft) Barrels (in) Span (ft) Rise (ft) Type Area (ft²)	Perimeter (ft) Radius (ft) n Downstream Upstream (ft/ft) Drainage Area (acres) Runoff "C" Incremental (C*A)	(C*A) (Tc) Storm Frequency (in/hr) (cfs) (CFS) Flow (ft/sec) Conduit (min) (ft/ft) Headloss (ft) Do	ownstream (ft) Upstream (ft) V1²/2g (ft) V2²/2g (ft) Junction Type Coefficient (Kj) Head-Loss (HL) HGL Elevation Below (T/C)
Line"D" 1+00.0 1+20.0 20.0 1 48 RCP 12.57		4.88         10         100         9.8         47.1         101.84         Yes         3.75         0.09         0.0011         0.02	557.90 557.92 0.22 0.20 Wye Inlet 0.05 0.01 0.0016 559.6 1.68
Line"D" 1+20.0 4+47.3 327.3 1 36 RCP 7.07	9.42 0.75 0.013 555.52 555.16 0.0050 OS13, F2 0.45 0.90 0.41	2.71 10 100 9.8 26.4 47.29 Yes 3.58 1.52 0.0016 0.51	557.93 558.40 0.20 0.05 Junction 0.05 0.04 0.0016 559.6 1.20 *Includes Bypass Flows
Line"D"     4+47.3     4+50.3     3.0     1     36     RCP     7.07       Line"D"     4+50.3     5+34.5     84.2     1     24     RCP     3.14	9.42     0.75     0.013     555.16     555.17     0.0050       6.28     0.5     0.013     551.17     556.09     0.0050	2.30         10         100         9.8         13.1*         47.29         Yes         1.85         0.03         0.0004         0.00           2.30         10         100         9.8         13.1*         16.04         Yes         4.17         0.34         0.0033         0.28	558.44         558.44         0.05         0.27         Pipe Size Change         0.00         0.15         0.0504         561.1         2.66         *Remainer Bypass to 2B           558.59         558.87         0.27         0.27         60° Bend         0.43         0.12         0.0047         561.1         2.23         *Remainer Bypass to 2B
Line"D" 5+34.5 5+57.6 23.0 1 24 RCP 3.14	6.28 0.5 0.013 556.09 556.21 0.0050 OS4, F1 3.09 0.75 2.30	2.30 10 100 9.8 13.1* 16.04 Yes 4.17 0.09 0.0033 0.08	558.99 559.07 0.27 0.27 Wye Inlet 1.25 0.34 0.26 561.1 2.03 *Remainer Bypass to 2B
	5.25 5.55 5.55 5.55 5.55 5.55	200 200 200 200 200 200 200 200 200 200	5.2. 5.2. 5.2. 5.2. 5.2. 5.2.
System ID Collection Point Pipe Length Number of Pipe Size Box Size Type Area (ft²)	Wetted Hydraulic Manning's Flowline Elevations Slope Incremental Drainage Area	Accumulated Up Stream Design Year Intensity Runoff Conduit Capacity Partial Velocity Time in Friction Slope Friction	Hydraulic Grade Line Headloss Calculations Design Top of Curb HGL Depth Remarks
Downstream Upstream (ft) Barrels (in) Span (ft) Rise (ft)	' Perimeter (ft) Radius (ft) n Downstream Upstream (ft/ft) Drainage Area Area (acres) Runoff "C" Incremental (C*A)		ownstream (ft) Upstream (ft) V1²/2g (ft) V2²/2g (ft) Junction Type Coefficient (Kj) Head-Loss (HL) HGL Elevation Below (T/C)
Lat"D1"         1+00.0         1+21.9         21.9         1         24         RCP         3.14	6.28 0.5 0.013 555.66 555.77 0.0050 OS13, F2 0.45 0.90 0.41	0.41 10 100 9.8 13.3* 16.04 Yes 3.88 0.09 0.0034 0.08	558.44         558.50         0.23         0.23         Wye Inlet         1.25         0.29         0.0162         560.5         2.00         *Includues Bypass Runoff
System ID Collection Point Pipe Length Number of Pipe Size Box Size Type Area (ft²)	Wetted Hydraulic Manning's Flowline Elevations Slope Incremental Drainage Area	Accumulated Up Stream Design Year Intensity Runoff Conduit Capacity Partial Velocity Time in Friction Slope Friction	Hydraulic Grade Line Headloss Calculations Design Top of Curb HGL Depth
System ID Downstream Upstream (ft) Barrels (in) Span (ft) Rise (ft) Type Area (ft²)	Perimeter (ft) Radius (ft) n Downstream Upstream (ft/ft) Drainage Area (acres) Runoff "C" Incremental (C*A)		ownstream (ft) Upstream (ft) V1²/2g (ft) V2²/2g (ft) Junction Type Coefficient (Kj) Head-Loss (HL) HGL Elevation Below (T/C)
Line"E" 1+00.0 1+29.3 29.3 1 96 ACMP 50.27	25.13 2 0.013 548.46 548.40 0.0020	13.39 10 100 9.8 131.3 408.99 Yes 2.35 0.21 0.0002 0.01	556.46 556.47 0.09 0.09 Junction Box 0.05 0.0 0.0004 559.1 2.63
Line"E"         1+29.3         1+39.8         10.5         1         96         ACMP         50.27	25.13 2 0.013 548.40 548.42 0.0020	13.39 10 100 9.8 131.3 408.99 Yes 2.35 0.07 0.0002 0.00	556.47         556.47         0.09         0.09         45° Bend         0.37         0.03         0.0032         559.0         2.53
Line"E" 1+39.8 1+67.5 27.7 1 96 ACMP 50.27	25.13 2 0.013 548.42 548.47 0.0020 25.13 2 0.013 548.42 548.47 0.0020	13.39 10 100 9.8 131.3 408.99 Yes 2.35 0.20 0.0002 0.01	556.50 556.51 0.09 0.09 45° Bend 0.37 0.03 0.0014 558.9 2.39
Line"E"     1+67.5     5+59.2     391.7     1     96     ACMP     50.27       Line"E"     5+59.2     5+92.4     33.2     1     96     ACMP     50.27	25.13     2     0.013     548.47     549.26     0.0020     0.0020     0.051       25.13     2     0.013     549.26     549.32     0.0020     N     0.57     0.90     0.51	13.39     10     100     9.8     131.3     408.99     Yes     2.35     2.78     0.0002     0.08       13.39     10     100     9.8     131.3     408.99     Yes     2.30     0.24     0.0002     0.01	556.54         556.62         0.09         0.08         90° Bend         0.50         0.04         0.0003         559.0         2.38           556.66         556.67         0.08         0.08         Junction         1.00         0.08         0.0026         559.8         3.13
Line"E"         5+59.2         5+92.4         33.2         1         96         ACMP         50.27           Line"E"         5+92.4         6+76.9         84.5         1         96         ACMP         50.27	25.13         2         0.013         549.26         549.32         0.0020         N         0.57         0.90         0.51           25.13         2         0.013         549.32         549.51         0.0020         M         0.27         0.90         0.26	12.88 10 100 9.8 126.2 408.99 Yes 2.25 0.63 0.0002 0.02	
Line"E" 6+76.9 6+77.0 0.1 1 96 ACMP 50.27		12.62 10 100 9.8 123.7 408.99 Yes 2.01 0.00 0.0002 0.00	556.75         556.76         0.08         0.06         Junction         1.00         0.06         0.0009         559.6         2.84           556.83         556.83         0.06         0.06         Junction         1.00         0.06         0.6296         559.6         2.77
Line"E" 6+77.0 6+85.4 8.4 1 96 ACMP 50.27		11.66 10 100 9.8 114.3 408.99 Yes 2.01 0.07 0.0002 0.00	556.89         556.89         0.06         1.01         Pipe Size Change         1.00         0.05         0.0058         559.6         2.71
Line"E" 6+85.4 7+54.4 69.0 1 48 ACMP 12.57	12.57 1 0.013 551.40 551.86 0.0067 Lines J and D, 0.65 11.66	11.66 10 100 9.8 114.3 117.89 Yes 8.05 0.14 0.0063 0.43	556.94 557.37 1.01 1.01 Wye Inlet 1.25 1.26 0.82 559.6 2.23
	12.37 1 0.013 331.40 331.80 0.0007 OS14, L2 18.07 0.03 11.00		
Collection Point Pipe Length Number of Pipe Size Box Size	Wetted Hydraulic Manning's Flowline Elevations Slope Incremental Drainage Area	Accumulated Up Stream Design Year Intensity Runoff Conduit Capacity Partial Velocity Time in Friction Slope Friction	Hydraulic Grade Line Headloss Calculations Design Top of Curb HGL Depth
	Wetted Hydraulic Manning's Flowline Elevations Slope Incremental Drainage Area Perimeter (ft) Radius (ft) n Downstream Upstream (ft/ft) Drainage Area (acres) Runoff "C" Incremental (C*A) 6.28 0.5 0.013 553.76 554.79 0.0200 Q, OS8, OS9 5.31 0.37 1.96	(C*A)         (Tc)         Storm Frequency         (in/hr)         (cfs)         (CFS)         Flow         (ft/sec)         Conduit (min)         (ft/ft)         Headloss (ft)         Do           1.96         10         100         9.8         19.3         32.08         Yes         4.71         0.18         0.0072         0.37	ownstream (ft) Upstream (ft) V1²/2g (ft) V2²/2g (ft) Junction Type Coefficient (Kj) Head-Loss (HL) HGL Elevation Below (T/C)
Line"F" 1+00.0 1+51.4 51.4 1 24 RCP 3.14	6.28 0.5 0.013 553.76 554.79 0.0200 Q, OS8, OS9 5.31 0.37 1.96	Accumulated (C*A)Up Stream (Tc)Design Year Storm FrequencyIntensity (in/hr)Runoff (cfs)Conduit Capacity (CFS)Partial FlowVelocity (ft/sec)Time in Conduit (min)Friction Slope (ft/ft)Friction Slope Headloss (ft)1.96101009.819.332.08Yes4.710.180.00720.37	Hydraulic Grade LineHeadloss CalculationsDesignTop of CurbHGL DepthRemarksownstream (ft)Upstream (ft)V1²/2g (ft)V2²/2g (ft)Junction TypeCoefficient (Kj)Head-Loss (HL)HGLElevationBelow (T/C)555.76555.980.340.34Wye Inlet1.250.430.0126560.54.52
Collection Daint Division at Newston of Division Day Size	Matted Hadroutic Manufacto Flouding Flouding Claus	Assessed the Course Decision Vision Industrial Deposits Countries Deviced Vision Time in Friedrich Clause Friedrich	
System ID Collection Point Pipe Length Number of Pipe Size Box Size Type Area (ft²)  Downstream Upstream (ft) Barrels (in) Span (ft) Rise (ft)	Perimeter (ft) Radius (ft)   n   Downstream Unstream (ft/ft)   Drainage Area (acres)   Runoff "C"   Incremental (C*A)	Accumulated Up Stream Design Year Intensity Runoff Conduit Capacity Partial Velocity Time in Friction Slope Friction  (C*A) (Tc) Storm Frequency (in/hr) (cfs) (CFS) Flow (ft/sec) Conduit (min) (ft/ft) Headloss (ft) Design Year Intensity Runoff Conduit Capacity Partial Velocity Time in Friction Slope Friction Design Year Intensity Runoff Conduit Capacity Partial Velocity Time in Friction Slope Friction Design Year Intensity Runoff Conduit Capacity Partial Velocity Time in Friction Slope Friction Design Year Intensity Runoff Conduit Capacity Partial Velocity Time in Friction Slope Friction Design Year Intensity Runoff Conduit Capacity Partial Velocity Time in Friction Slope Friction Intensity Runoff Conduit Capacity Partial Velocity Time in Friction Slope Friction Intensity Runoff Conduit Capacity Partial Velocity Time Intensity Runoff Conduit Capacity Partial Velocity Runoff Capacity Partial Velocity Runoff Capaci	Hydraulic Grade Line  Headloss Calculations  Design Top of Curb HGL Depth Below (T/C)  Remarks
System ID         Collection Point         Pipe Length Downstream         Number of (ft)         Pipe Size         Box Size         Type         Area (ft²)           Line"G"         1+00.0         1+06.5         6.5         1         18         RCP         1.77           Line"G"         1+06.5         1+16.6         10.1         1         18         RCP         1.77	Terminate (it) manager (it) in periodic (it) pramager (it) indicate (it) indicate (it)	(C*A)         (Tc)         Storm Frequency         (in/hr)         (cfs)         (CFS)         Flow         (ft/sec)         Conduit (min)         (ft/ft)         Headloss (ft)         Dr.           0.71         10         100         9.8         7.0         5.77         No         3.96         0.03         0.0044         0.03	562.10 562.13 0.24 0.24 45° Bend 0.37 0.09 0.0182 565.5 3.37
Line"G" 1+06.5 1+16.6 10.1 1 18 RCP 1.77	4.71 0.375 0.013 559.74 559.75 0.0010 S, OS10 2.22 0.32 0.71	0.71         10         100         9.8         7.0         5.77         No         3.96         0.03         0.0044         0.03           0.71         10         100         9.8         7.0         3.33         No         3.96         0.04         0.0044         0.04	562.10         562.13         0.24         0.24         45° Bend         0.37         0.09         0.0182         565.5         3.37           562.22         562.26         0.24         0.24         Wye Inlet         1.25         0.30         0.0347         565.5         3.24
System ID Collection Point Downstream Upstream (ft) Pipe Length Number of Pipe Size Box Size Type Area (ft²)	Wetted Hydraulic Manning's Flowline Elevations Slope Incremental Drainage Area  Provided Area (1) Provided Area (2) Provided Area (3) Provided Area (4) Prov	Accumulated Up Stream Design Year Intensity Runoff Conduit Capacity Partial Velocity Time in Friction Slope Friction	Hydraulic Grade Line Headloss Calculations Design Top of Curb HGL Depth  Remarks
Line"H" 1+00.0 1+19.6 19.6 1 24 RCP 3.14	Perimeter (it)   Radius (it)   II   Downstream Opstream (it/it)   Dramage Area (acres) Runon C   incremental (C A)	(C*A)         (Tc)         Storm Frequency         (in/hr)         (cfs)         (CFS)         Flow         (ft/sec)         Conduit (min)         (ft/ft)         Headloss (ft)         Description           10         100         9.8         7.6         9.07         Yes         2.58         0.13         0.0011         0.02	ownstream (ft)         Upstream (ft)         V1²/2g (ft)         V2²/2g (ft)         Junction Type         Coefficient (Kj)         Head-Loss (HL)         HGL         Elevation         Below (T/C)           560.10         560.13         0.10         0.10         60° Bend         0.43         0.04         0.0035         564.1         3.97
Line"H"     1+00.0     1+19.6     19.6     1     24     RCP     3.14       Line"H"     1+19.6     1+35.0     15.4     1     24     RCP     3.14	6.28 0.5 0.013 558.13 558.16 0.0016 Detention NA NA NA	NA 10 100 9.8 7.6 9.07 Yes 2.58 0.10 0.0011 0.02	560.17 560.19 0.10 0.10 Junction Box 0.55 0.13 0.0097 564.1 3.91
	Wetted Hydraulic Radius (ft) Nanning's Downstream Upstream (ft/ft) Drainage Area Area (acres) Runoff "C" Incremental (C*A)  6.28 0.5 0.013 558.61 558.76 0.0280 V, OS11 3.15 0.30 0.95	Accumulated Up Stream Design Year Intensity Runoff Conduit Capacity Partial Velocity Time in Friction Slope Friction	Hydraulic Grade LineHeadloss CalculationsDesignTop of CurbHGL DepthRemarksownstream (ft)Upstream (ft)V1²/2g (ft)V2²/2g (ft)Junction TypeCoefficient (Kj)Head-Loss (HL)HGLElevationBelow (T/C)560.61560.610.050.05Wye Inlet1.250.070.0133563.22.59
Downstream   Upstream   (ft)   Barrels   (in)   Span (ft)   Rise (ft)	Perimeter (ft) Radius (ft) n Downstream Upstream (ft/ft) Drainage Area (acres) Runoff "C" Incremental (C*A)	(C*A) (Tc) Storm Frequency (in/hr) (cfs) (CFS) Flow (ft/sec) Conduit (min) (ft/ft) Headloss (ft) Do	ownstream (ft) Upstream (ft) V1²/2g (ft) V2²/2g (ft) Junction Type Coefficient (Kj) Head-Loss (HL) HGL Elevation Below (T/C)
Line"I" 1+00.0 1+05.4 5.4 1 24 RCP 3.14	6.28   0.5   0.013   558.61   558.76   0.0280   V, OS11   3.15   0.30   0.95	0.95   10   100   9.8   9.3   37.96   YeS   1.88   0.05   0.0017   0.01	560.61   560.61   0.05   0.05   Wye inlet   1.25   0.07   0.0133   563.2   2.59
Collection Point Pipe Length Number of Pipe Size Box Size	Wetted Hydraulic Manning's Flowline Elevations Slope Incremental Drainage Area	Accumulated Up Stream Design Year Intensity Runoff Conduit Capacity Partial Velocity Time in Friction Slope Friction	Hydraulic Grade Line Headloss Calculations Design Top of Curb HGL Depth
System ID Collection Point Downstream Upstream (ft) Pipe Length Number of Barrels (in) Span (ft) Rise (ft) Type Area (ft²)		AccumulatedUp StreamDesign YearIntensityRunoffConduit CapacityPartialVelocityTime inFriction SlopeFriction SlopeFriction(C*A)(Tc)Storm Frequency(in/hr)(cfs)(CFS)Flow(ft/sec)Conduit (min)(ft/ft)Headloss (ft)Description4.72101009.846.3101.84Yes3.340.100.00100.002	ownstream (ft) Upstream (ft) V1²/2g (ft) V2²/2g (ft) Junction Type Coefficient (Kj) Head-Loss (HL) HGL Elevation Below (T/C)
Line"J" 1+00.0 1+20.0 20.0 1 48 RCP 12.57	12.57 1 0.013 551.92 553.02 0.0050 L3, OS15 1.50 0.39 0.59		555.92         555.94         0.17         0.04         Junction Box         0.05         0.00         0.0010         559.6         3.66
Line"J" 1+20.0 1+35.0 15.0 1 48 RCP 12.57	12.57 1 0.013 553.02 553.10 0.0050 L4, OS7, OS16 8.16 0.51 4.13	4.13 10 100 9.8 40.5 101.84 Yes 1.67 0.15 0.0008 0.01	555.94 555.94 0.04 0.04 Wye Inlet 1.25 0.05 0.0038 559.6 3.66
Collection Point Pine Length Number of Pine Size Box Size	Wetted Hydraulic Manning's Flowline Elevations Slone Incremental Drainage Δrea	Accumulated Up Stream Design Year Intensity Runoff Conduit Capacity Partial Velocity Time in Friction Slope Friction	Hydraulic Grade Line Headloss Calculations Design Top of Curb HGL Depth Remarks
	Wetted Hydraulic Manning's Flowline Elevations Slope Incremental Drainage Area Perimeter (ft) Radius (ft) n Downstream Upstream (ft/ft) Drainage Area (acres) Runoff "C" Incremental (C*A) 4.71 0.375 0.013 557.60 557.98 0.0200 E, OS2,OS3 1.85 0.78 1.45	Accumulated Up Stream Design Year Intensity Runoff Conduit Capacity Partial Velocity Time in Friction Slope Friction (C*A) (Tc) Storm Frequency (in/hr) (cfs) (CFS) Flow (ft/sec) Conduit (min) (ft/ft) Headloss (ft) Design Year (in/hr) (cfs) (CFS) Flow (ft/sec) Conduit (min) (ft/ft) Headloss (ft) Design Year (in/hr) (cfs) (CFS) Flow (ft/sec) Conduit (min) (ft/ft) Headloss (ft) Design Year (in/hr) (cfs) (CFS) Flow (ft/sec) Conduit (min) (ft/ft) Headloss (ft) Design Year (in/hr) (cfs)	Hydraulic Grade Line  Headloss Calculations  Ownstream (ft)  Upstream (ft)  V1²/2g (ft)  V2²/2g (ft)  Junction Type  Coefficient (Kj)  Head-Loss (HL)  HGL  Elevation  Below (T/C)  Remarks
Line"K" 1+00.0 1+19.1 19.1 1 18 RCP 1.77	4.71 0.375 0.013 557.60 557.98 0.0200 E, OS2,OS3 1.85 0.78 1.45	1.45 10 100 9.8 14.2 14.90 Yes 8.01 0.04 0.0181 0.35	560.30 560.65 1.00 1.00 Wye Inlet 1.25 1.25 0.0832 562.0 1.35
System ID Collection Point Pipe Length Number of Pipe Size Box Size Type Area (ft²)	Wetted Hydraulic Radius (ft) Nanning's Flowline Elevations Slope Incremental Drainage Area  Downstream Upstream (ft/ft) Drainage Area (acres) Runoff "C" Incremental (C*A)	Accumulated Up Stream Design Year Intensity Runoff Conduit Capacity Partial Velocity Time in Friction Slope Friction (C*A) (Tc) Storm Frequency (in/hr) (cfs) (CFS) Flow (ft/sec) Conduit (min) (ft/ft) Headloss (ft) Design Year Intensity Runoff Conduit Capacity Partial Velocity Time in Friction Slope Friction (C*A)	Hydraulic Grade Line Headloss Calculations Design Top of Curb HGL Depth ownstream (ft) Upstream (ft) V1²/2g (ft) V2²/2g (ft) Junction Type Coefficient (Kj) Head-Loss (HL) HGL Elevation Below (T/C)
Line"L"	4.71 0.375 0.013 558.80 559.12 0.0200 T 0.77 0.90 0.69	(C*A)         (Tc)         Storm Frequency         (in/hr)         (cfs)         (CFS)         Flow         (ft/sec)         Conduit (min)         (ft/ft)         Headloss (ft)         Description           0.69         10         100         9.8         6.7         14.90         Yes         3.79         0.07         0.0041         0.07	ownstream (ft)         Upstream (ft)         V1²/2g (ft)         V2²/2g (ft)         Junction Type         Coefficient (Kj)         Head-Loss (HL)         HGL         Elevation         Below (T/C)           562.10         562.10         0.22         0.22         Curb Inlet         1.25         0.28         0.0173         563.65         1.55
1.77	5.5.5   5.55.55   555.22   6.6266   1   6.77   6.50   6.65		
System ID Collection Point Pipe Length Number of Pipe Size Box Size Type Area (ft²)	Wetted Hydraulic Manning's Flowline Elevations Slope Incremental Drainage Area	Accumulated Up Stream Design Year Intensity Runoff Conduit Capacity Partial Velocity Time in Friction Slope Friction	Hydraulic Grade Line Headloss Calculations Design Top of Curb HGL Depth Remarks
Downstream   Upstream   (ft)   Barrels   (in)   Span (ft)   Rise (ft)	Perimeter (ft)   Radius (ft)   n   Downstream   Upstream   (ft/ft)   Drainage Area (acres)   Runoff "C"   Incremental (C*A)		ownstream (ft)   Upstream (ft)   V1²/2g (ft)   V2²/2g (ft)   Junction Type   Coefficient (Kj)   Head-Loss (HL)   HGL   Elevation   Below (T/C)
Line"M" 1+00.0 1+05.6 5.6 1 18 RCP 1.77	4.71 0.375 0.013 559.64 559.75 0.0200 U 0.24 0.90 0.22	0.22 10 100 9.8 2.1 14.90 Yes 3.21 0.03 0.0004 0.00	562.10         562.10         0.16         Curb Inlet         1.25         0.20         0.0358         563.9         1.80



# !!! CAUTION !!! UNDERGROUND UTILITIES

EXISTING UTILITIES AND UNDERGROUND FACILITIES INDICATED ON THESE PLANS HAVE BEEN LOCATED FROM REFERENCE INFORMATION SUPPLIED BY VARIOUS PARTIES. THE ENGINEER DOES NOT ASSUME THE RESPONSIBILITY FOR THE UTILITY LOCATIONS SHOWN. IT SHALL BE THE SOLE RESPONSIBILITY OF THE CONTRACTOR(S) TO VERIFY THE HORIZONTALLY AND VERTICALLY LOCATION OF ALL UTILITIES AND UNDERGROUND FACILITIES PRIOR TO CONSTRUCTION, TO TAKE PRECAUTIONS IN ORDER TO PROTECT ALL FACILITIES ENCOUNTERED AND NOTIFY THE ENGINEER OF ALL CONFLICTS OF THE WORK WITH EXISTING FACILITIES. THE CONTRACTOR SHALL PROTECT AND MAINTAIN ALL UTILITIES FROM DAMAGE DURING CONSTRUCTION. ANY DAMAGE BY THE CONTRACTOR TO UTILITIES SHALL BE REPAIRED OR REPLACED BY THE CONTRACTOR AT THEIR CALL: TEXAS ONE CALL @ 811 AT LEAST 72 HRS PRIOR TO CONSTRUCTION.

ALL RESPONSIBILITY FOR ADEQUACY OF DESIGN REMAINS WITH THE DESIGN ENGINEER. THE CITY OF ROCKWALL, IN REVIEWING AND RELEASING PLANS FOR CONSTRUCTION, ASSUMES NO RESPONSIBILITY FOR ADEQUACY OR ACCURACY OF DESIGN.

REVISIONS					
REV NO.	DATE	DESCRIPTION			

AS-BUILT


NOTE: THESE AS—BUILT PLANS HAVE BEEN REVISED TO BENCHMARK


CONFORM WITH THE POST—CONSTRUCTION SURVEY PROVIDED NORTHEAST CORNER OF THE HEADWALL ALONG SH 276 BY THE CONTRACTOR. BY STATING THIS, THE ENGINEER DOES NOT ASSUME RESPONSIBILITY FOR THE WORK PERFORMED BY THE CONTRACTOR. SAID RESPONSIBILITY REMAINS SOLELY WITH THE CONTRACTOR.


ELEVATION=563.33 CONTRACTOR SHALL COORDINATE WITH THE SURVEYOR FOR SITE BENCHMARKS AND CONTROL POINT

Cumulus Design Firm #14810 2080 N. Highway 360, Suite 240 Grand Prairie, Texas 75050 Tel. 214.235.0367

STORM CALCULATIONS 4649 HIGHWAY 276 CITY OF ROCKWALL ROCKWALL COUNTY, TEXAS J.H. BAILEY SURVEY, ABST NO. 34 DATE PROJECT NO DRAWING SCALE C12.3 10/20/25 CD22011

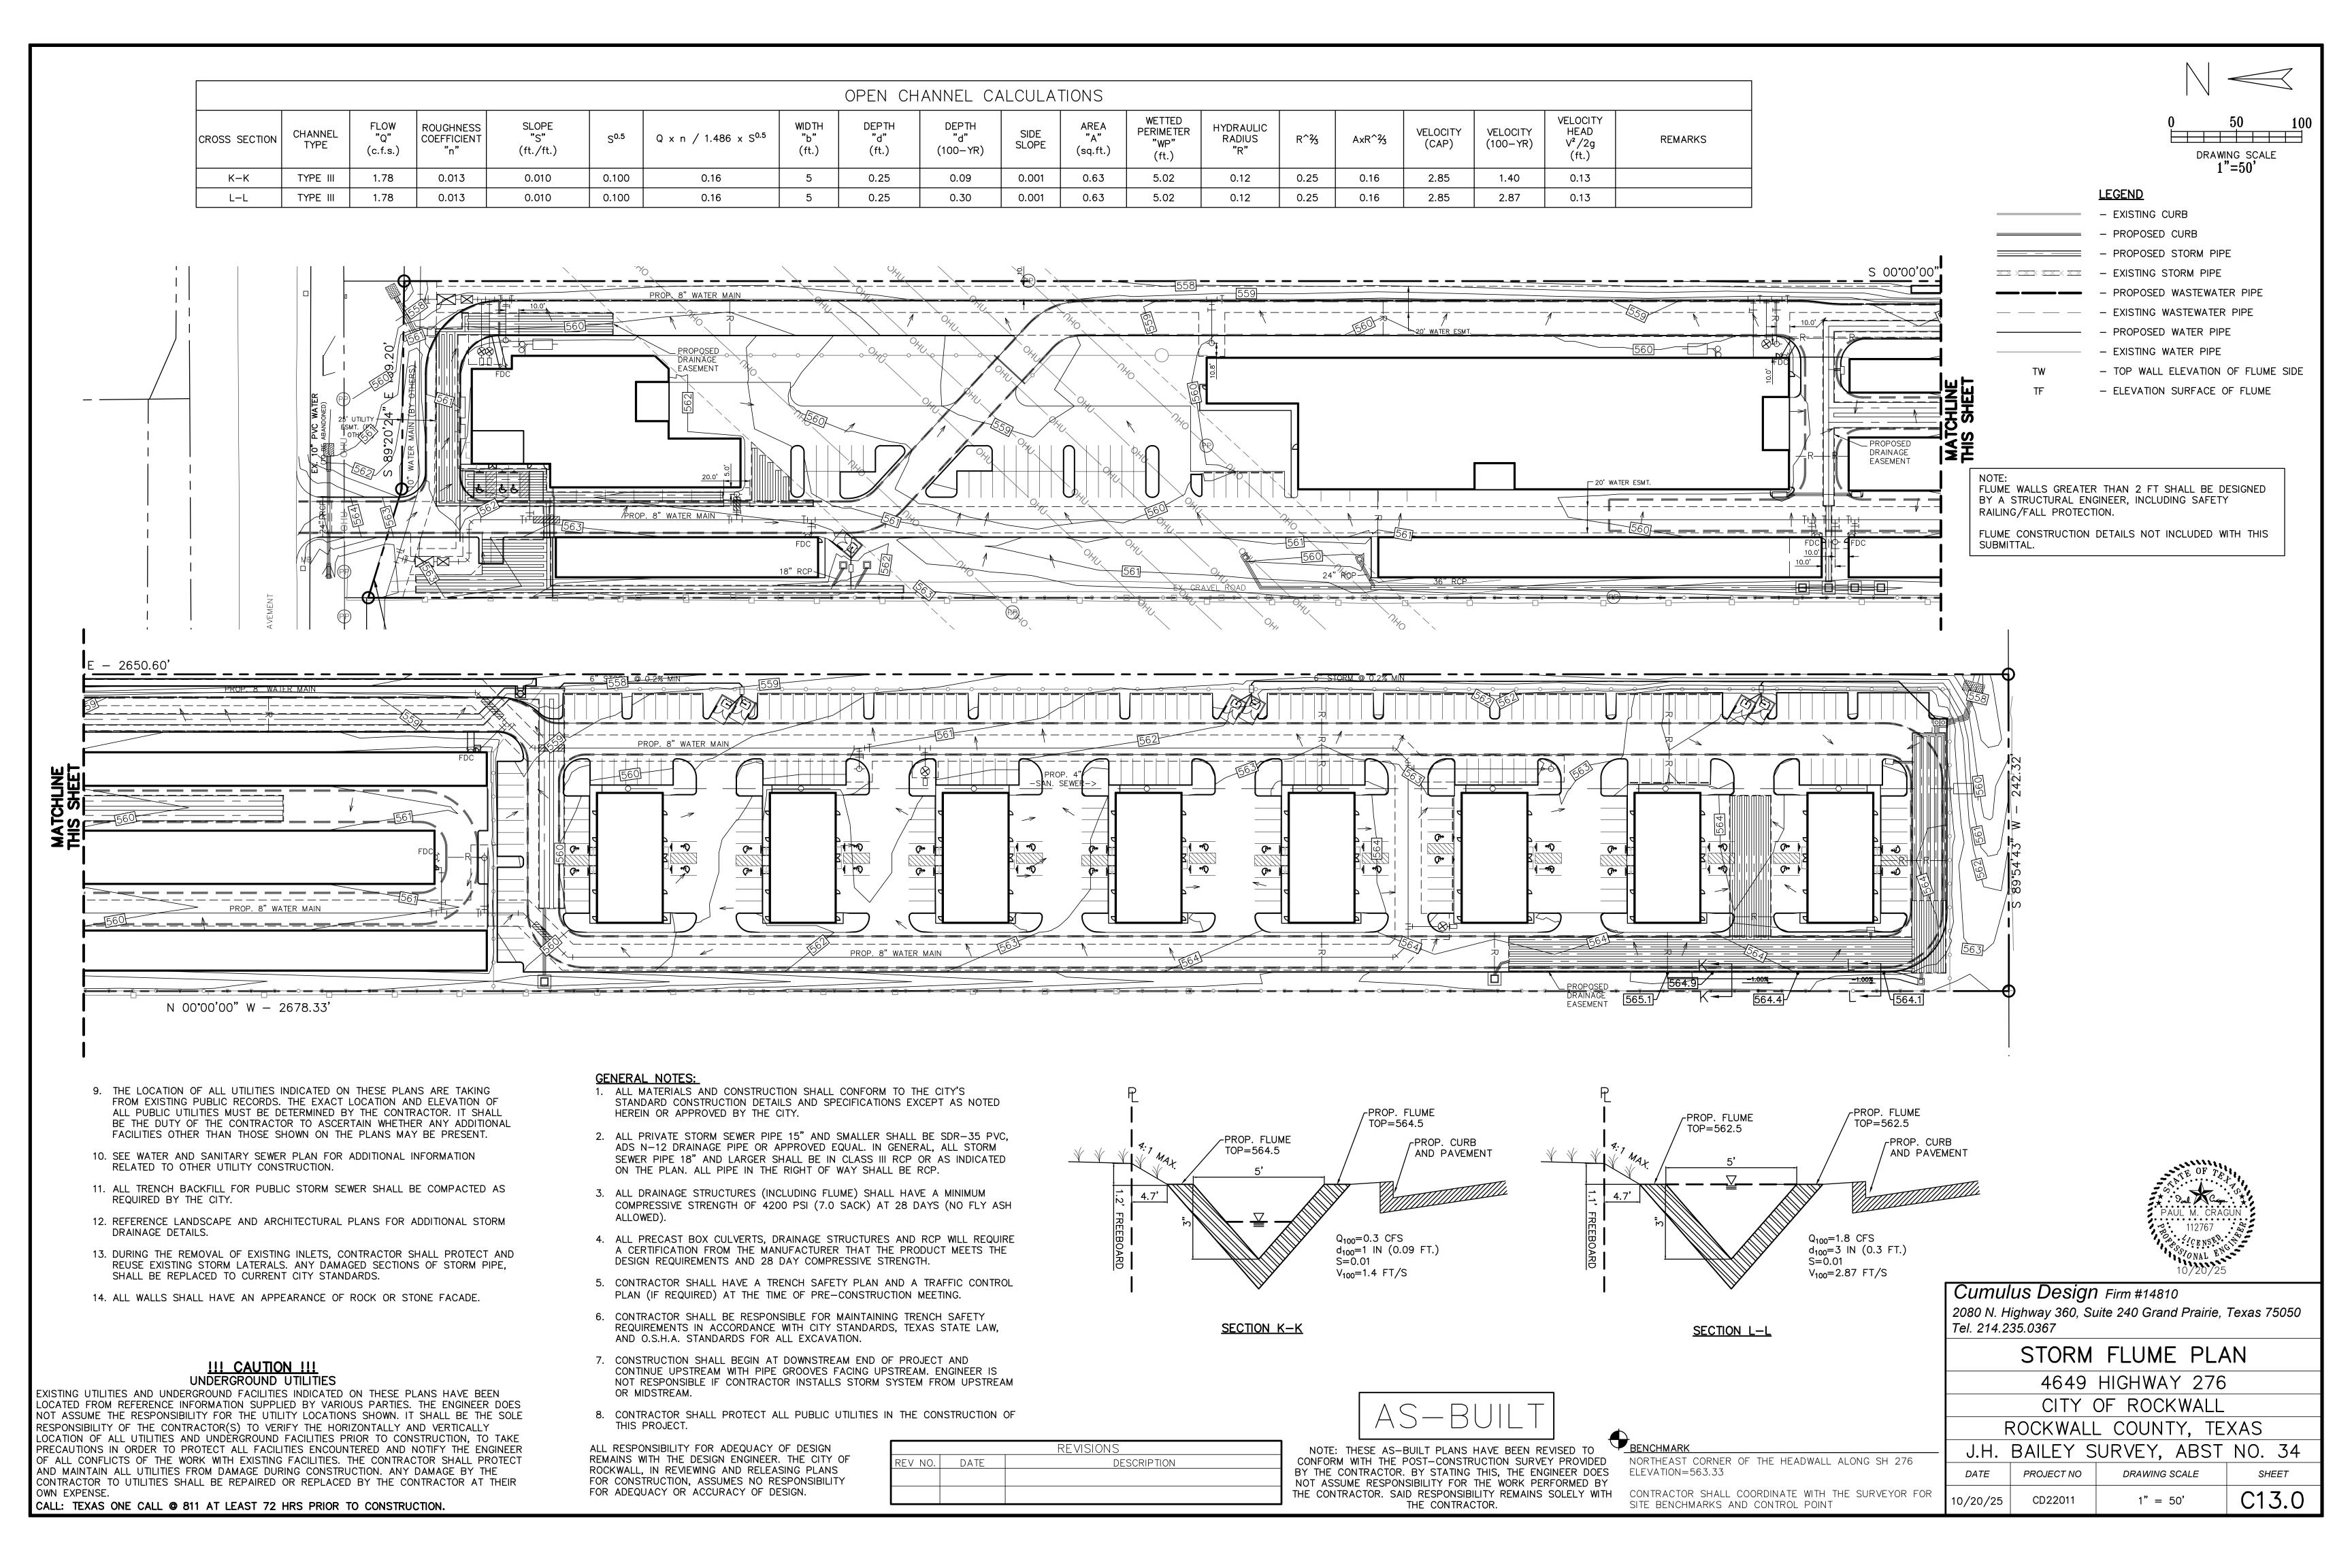

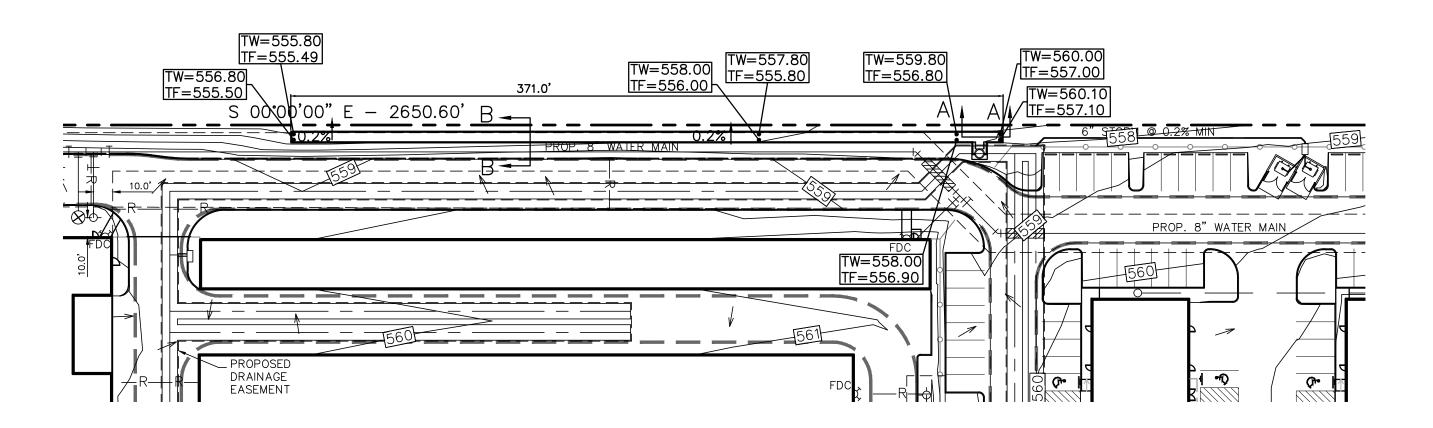

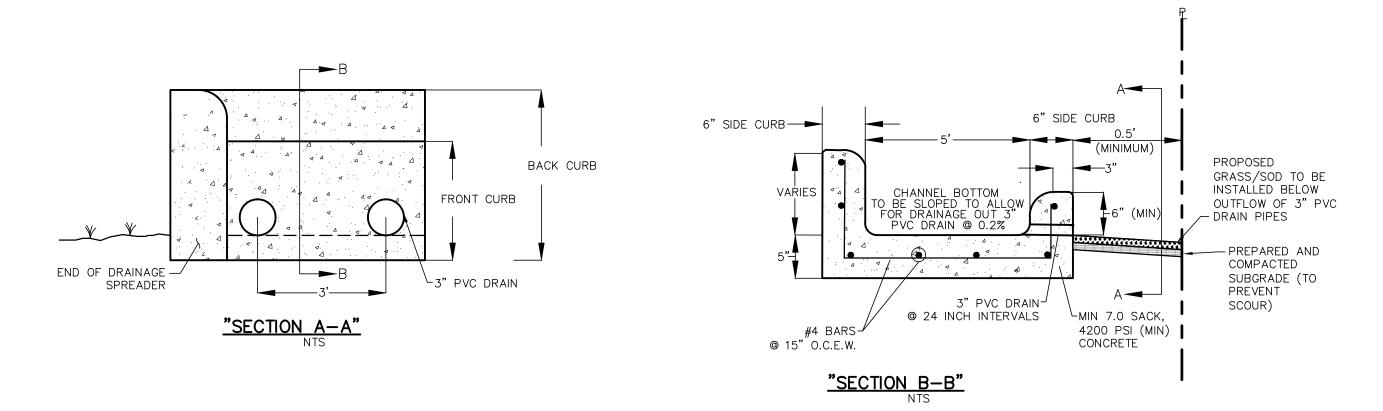

DRAINAGE SPREADER DETAILS

# EXISTING CURB PROPOSED CURB - PROPOSED STORM PIPE EXISTING STORM PIPE PROPOSED WASTEWATER PIPE EXISTING WASTEWATER PIPE - PROPOSED WATER PIPE EXISTING WATER PIPE - TOP WALL ELEVATION OF FLUME SIDE

- ELEVATION SURFACE OF FLUME

<u>LEGEND</u>

- **GENERAL NOTES:**
- 1. ALL MATERIALS AND CONSTRUCTION SHALL CONFORM TO THE CITY'S STANDARD CONSTRUCTION DETAILS AND SPECIFICATIONS EXCEPT AS NOTED HEREIN OR APPROVED BY THE CITY.
- 2. ALL PRIVATE STORM SEWER PIPE 15" AND SMALLER SHALL BE SDR-35 PVC, ADS N-12 DRAINAGE PIPE OR APPROVED EQUAL. IN GENERAL, ALL STORM SEWER PIPE 18" AND LARGER SHALL BE IN CLASS III RCP OR AS INDICATED ON THE PLAN. ALL PIPE IN THE RIGHT OF WAY SHALL BE RCP.
- 3. ALL DRAINAGE STRUCTURES (INCLUDING FLUME) SHALL HAVE A MINIMUM COMPRESSIVE STRENGTH OF 4200 PSI (7.0 SACK) AT 28 DAYS (NO FLY ASH
- 4. ALL PRECAST BOX CULVERTS, DRAINAGE STRUCTURES AND RCP WILL REQUIRE A CERTIFICATION FROM THE MANUFACTURER THAT THE PRODUCT MEETS THE DESIGN REQUIREMENTS AND 28 DAY COMPRESSIVE STRENGTH.
- 5. CONTRACTOR SHALL HAVE A TRENCH SAFETY PLAN AND A TRAFFIC CONTROL PLAN (IF REQUIRED) AT THE TIME OF PRE-CONSTRUCTION MEETING.
- 6. CONTRACTOR SHALL BE RESPONSIBLE FOR MAINTAINING TRENCH SAFETY REQUIREMENTS IN ACCORDANCE WITH CITY STANDARDS, TEXAS STATE LAW, AND O.S.H.A. STANDARDS FOR ALL EXCAVATION.
- 7. CONSTRUCTION SHALL BEGIN AT DOWNSTREAM END OF PROJECT AND CONTINUE UPSTREAM WITH PIPE GROOVES FACING UPSTREAM. ENGINEER IS NOT RESPONSIBLE IF CONTRACTOR INSTALLS STORM SYSTEM FROM UPSTREAM
- 8. CONTRACTOR SHALL PROTECT ALL PUBLIC UTILITIES IN THE CONSTRUCTION OF

NOTE: THESE AS-BUILT PLANS HAVE BEEN REVISED TO

THE CONTRACTOR.

- 9. THE LOCATION OF ALL UTILITIES INDICATED ON THESE PLANS ARE TAKING FROM EXISTING PUBLIC RECORDS. THE EXACT LOCATION AND ELEVATION OF ALL PUBLIC UTILITIES MUST BE DETERMINED BY THE CONTRACTOR. IT SHALL BE THE DUTY OF THE CONTRACTOR TO ASCERTAIN WHETHER ANY ADDITIONAL FACILITIES OTHER THAN THOSE SHOWN ON THE PLANS MAY BE PRESENT.
- 10. SEE WATER AND SANITARY SEWER PLAN FOR ADDITIONAL INFORMATION RELATED TO OTHER UTILITY CONSTRUCTION.
- 11. ALL TRENCH BACKFILL FOR PUBLIC STORM SEWER SHALL BE COMPACTED AS REQUIRED BY THE CITY.
- 12. REFERENCE LANDSCAPE AND ARCHITECTURAL PLANS FOR ADDITIONAL STORM DRAINAGE DETAILS.
- 13. DURING THE REMOVAL OF EXISTING INLETS, CONTRACTOR SHALL PROTECT AND REUSE EXISTING STORM LATERALS. ANY DAMAGED SECTIONS OF STORM PIPE, SHALL BE REPLACED TO CURRENT CITY STANDARDS.
- 14. ALL WALLS SHALL HAVE THE APPEARANCE OF ROCK OR STONE FACADE.



SHEET

C13.1

Cumulus Design Firm #14810

CD22011

2080 N. Highway 360, Suite 240 Grand Prairie, Texas 75050 Tel. 214.235.0367

FLUME SPREADER PLAN

4649 HIGHWAY 276

CITY OF ROCKWALL ROCKWALL COUNTY, TEXAS

J.H. BAILEY SURVEY, ABST NO. 34 DATE PROJECT NO DRAWING SCALE 10/20/25 1" = 50'


CONFORM WITH THE POST—CONSTRUCTION SURVEY PROVIDED NORTHEAST CORNER OF THE HEADWALL ALONG SH 276 BY THE CONTRACTOR. BY STATING THIS, THE ENGINEER DOES ELEVATION=563.33 NOT ASSUME RESPONSIBILITY FOR THE WORK PERFORMED BY THE CONTRACTOR. SAID RESPONSIBILITY REMAINS SOLELY WITH CONTRACTOR SHALL COORDINATE WITH THE SURVEYOR FOR SITE BENCHMARKS AND CONTROL POINT


!!! CAUTION !!!


EXISTING UTILITIES AND UNDERGROUND FACILITIES INDICATED ON THESE PLANS HAVE BEEN LOCATED FROM REFERENCE INFORMATION SUPPLIED BY VARIOUS PARTIES. THE ENGINEER DOES NOT ASSUME THE RESPONSIBILITY FOR THE UTILITY LOCATIONS SHOWN. IT SHALL BE THE SOLE RESPONSIBILITY OF THE CONTRACTOR(S) TO VERIFY THE HORIZONTALLY AND VERTICALLY LOCATION OF ALL UTILITIES AND UNDERGROUND FACILITIES PRIOR TO CONSTRUCTION, TO TAKE PRECAUTIONS IN ORDER TO PROTECT ALL FACILITIES ENCOUNTERED AND NOTIFY THE ENGINEER OF ALL CONFLICTS OF THE WORK WITH EXISTING FACILITIES. THE CONTRACTOR SHALL PROTECT AND MAINTAIN ALL UTILITIES FROM DAMAGE DURING CONSTRUCTION. ANY DAMAGE BY THE CONTRACTOR TO UTILITIES SHALL BE REPAIRED OR REPLACED BY THE CONTRACTOR AT THEIR


ALL RESPONSIBILITY FOR ADEQUACY OF DESIGN REMAINS WITH THE DESIGN ENGINEER. THE CITY OF ROCKWALL, IN REVIEWING AND RELEASING PLANS FOR CONSTRUCTION, ASSUMES NO RESPONSIBILITY FOR ADEQUACY OR ACCURACY OF DESIGN.


REVISIONS				
REV NO.	DATE	DESCRIPTION		

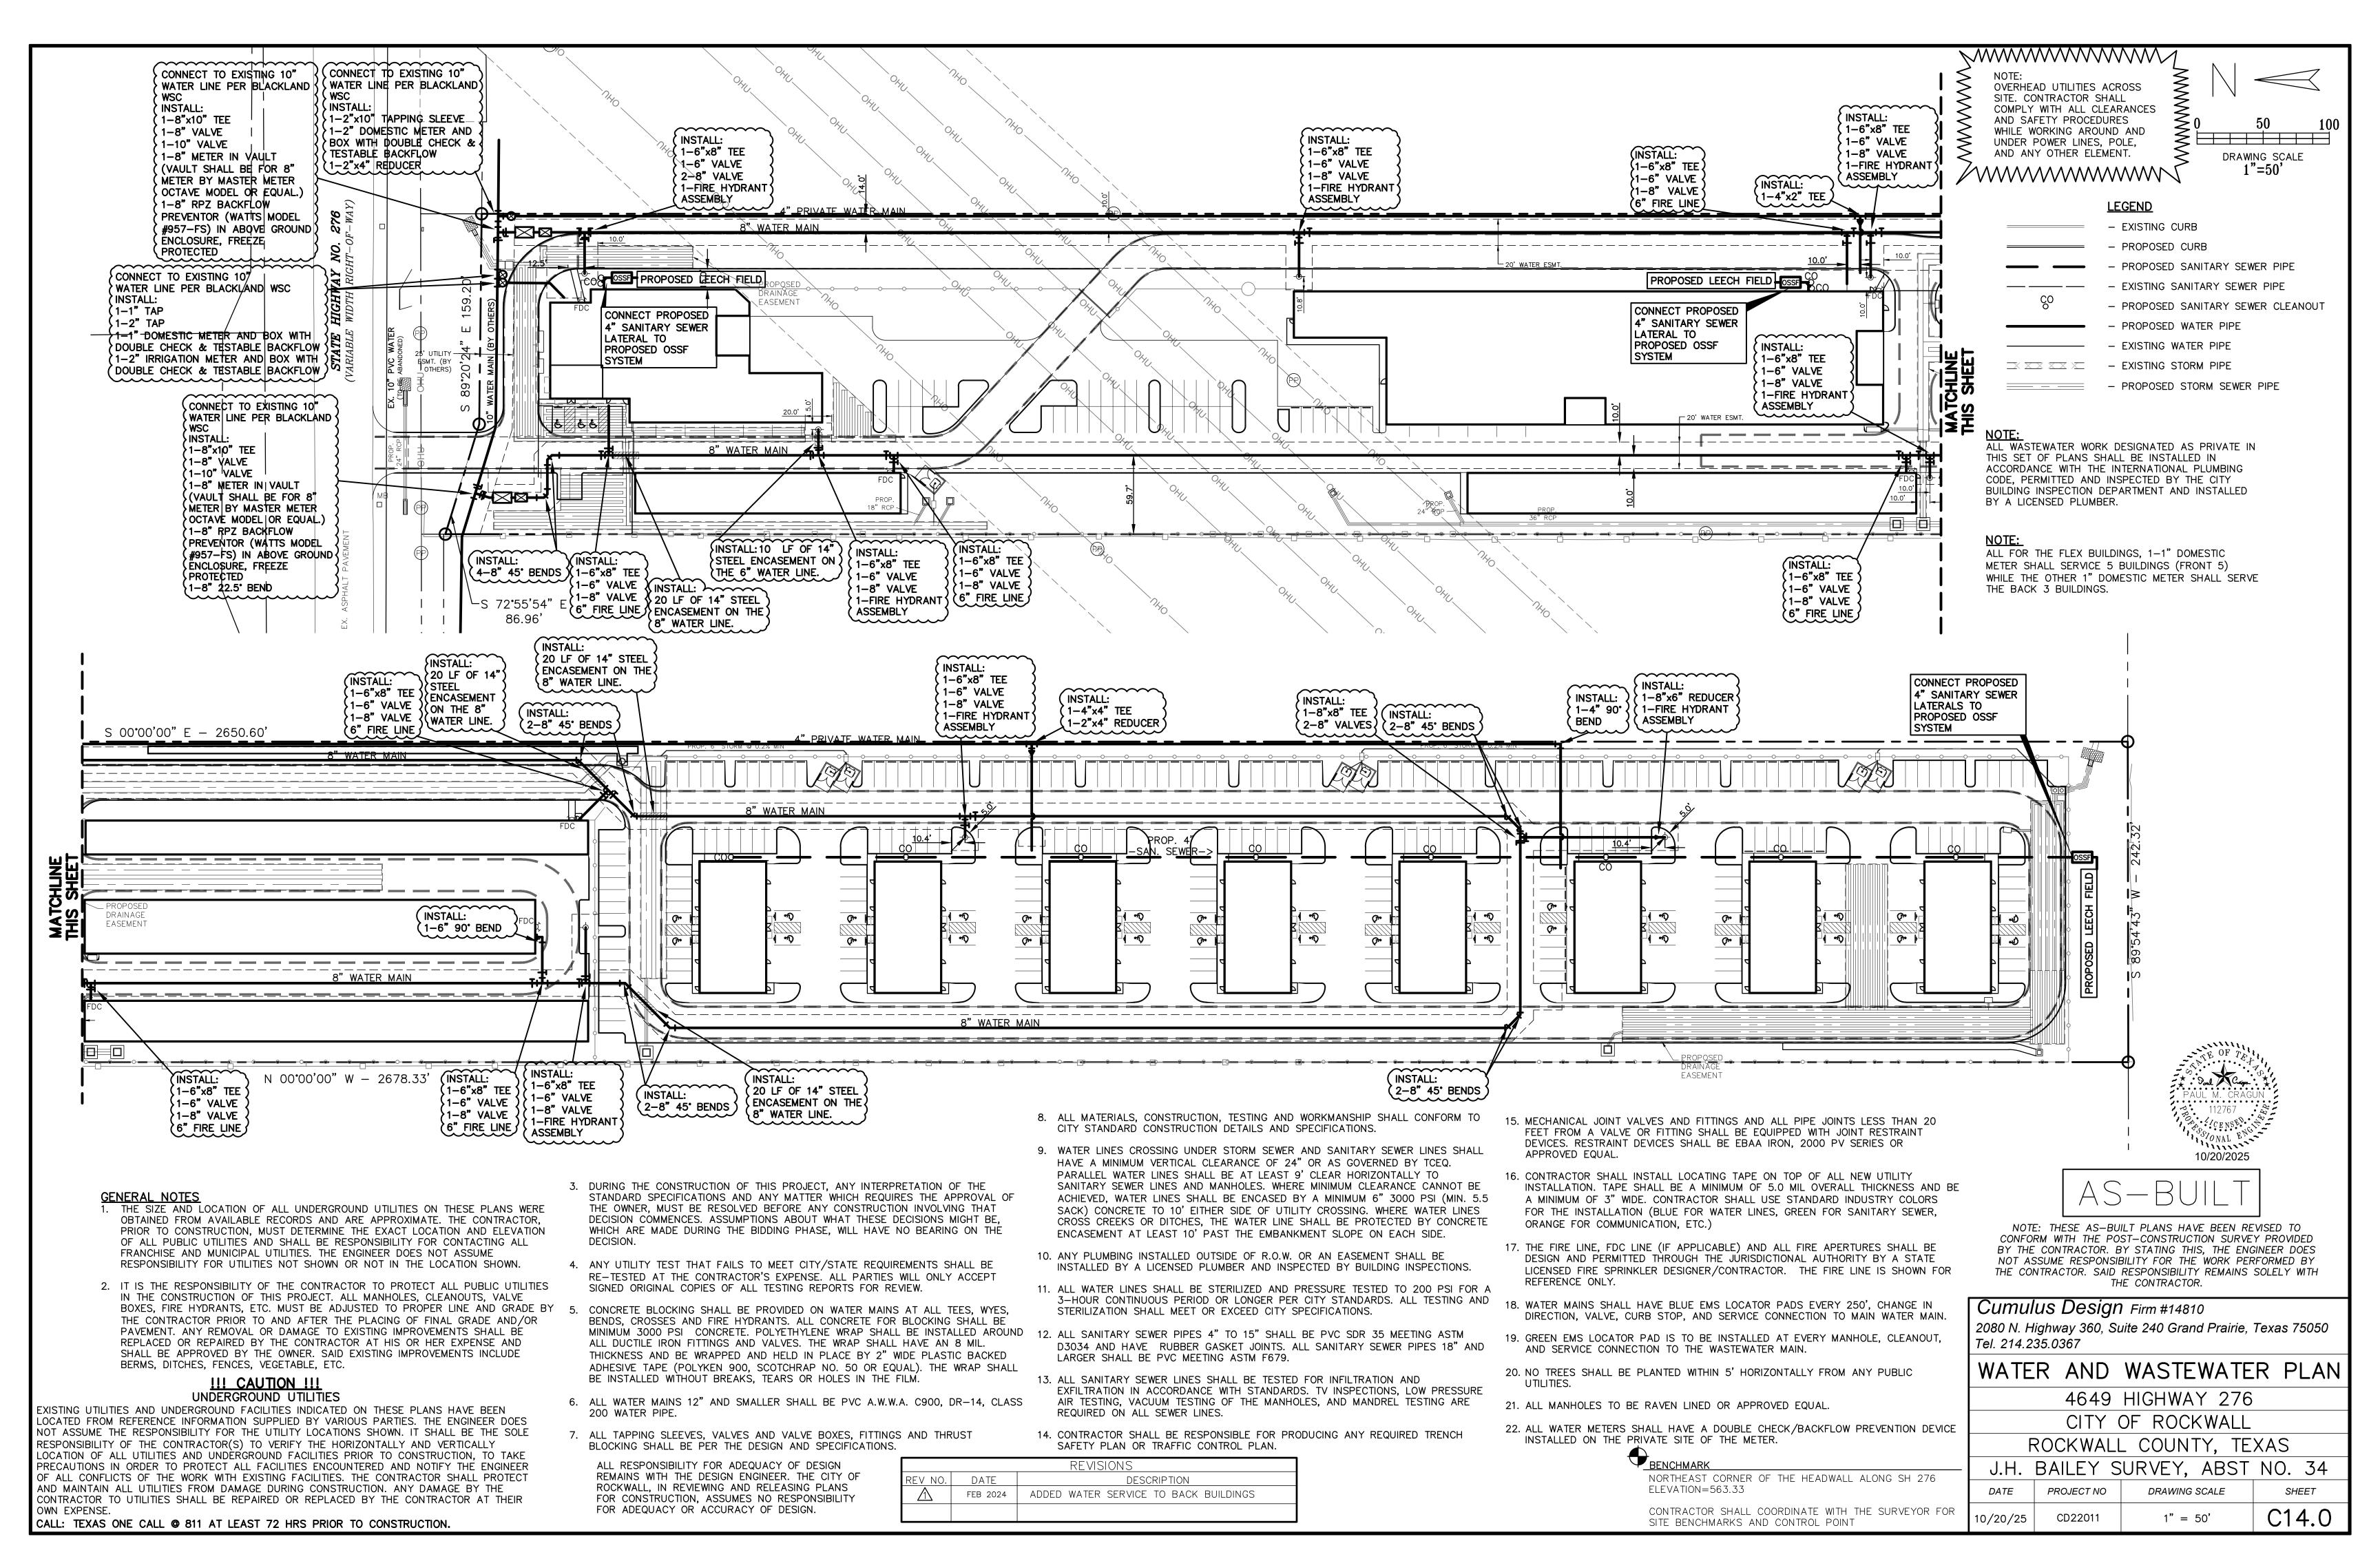


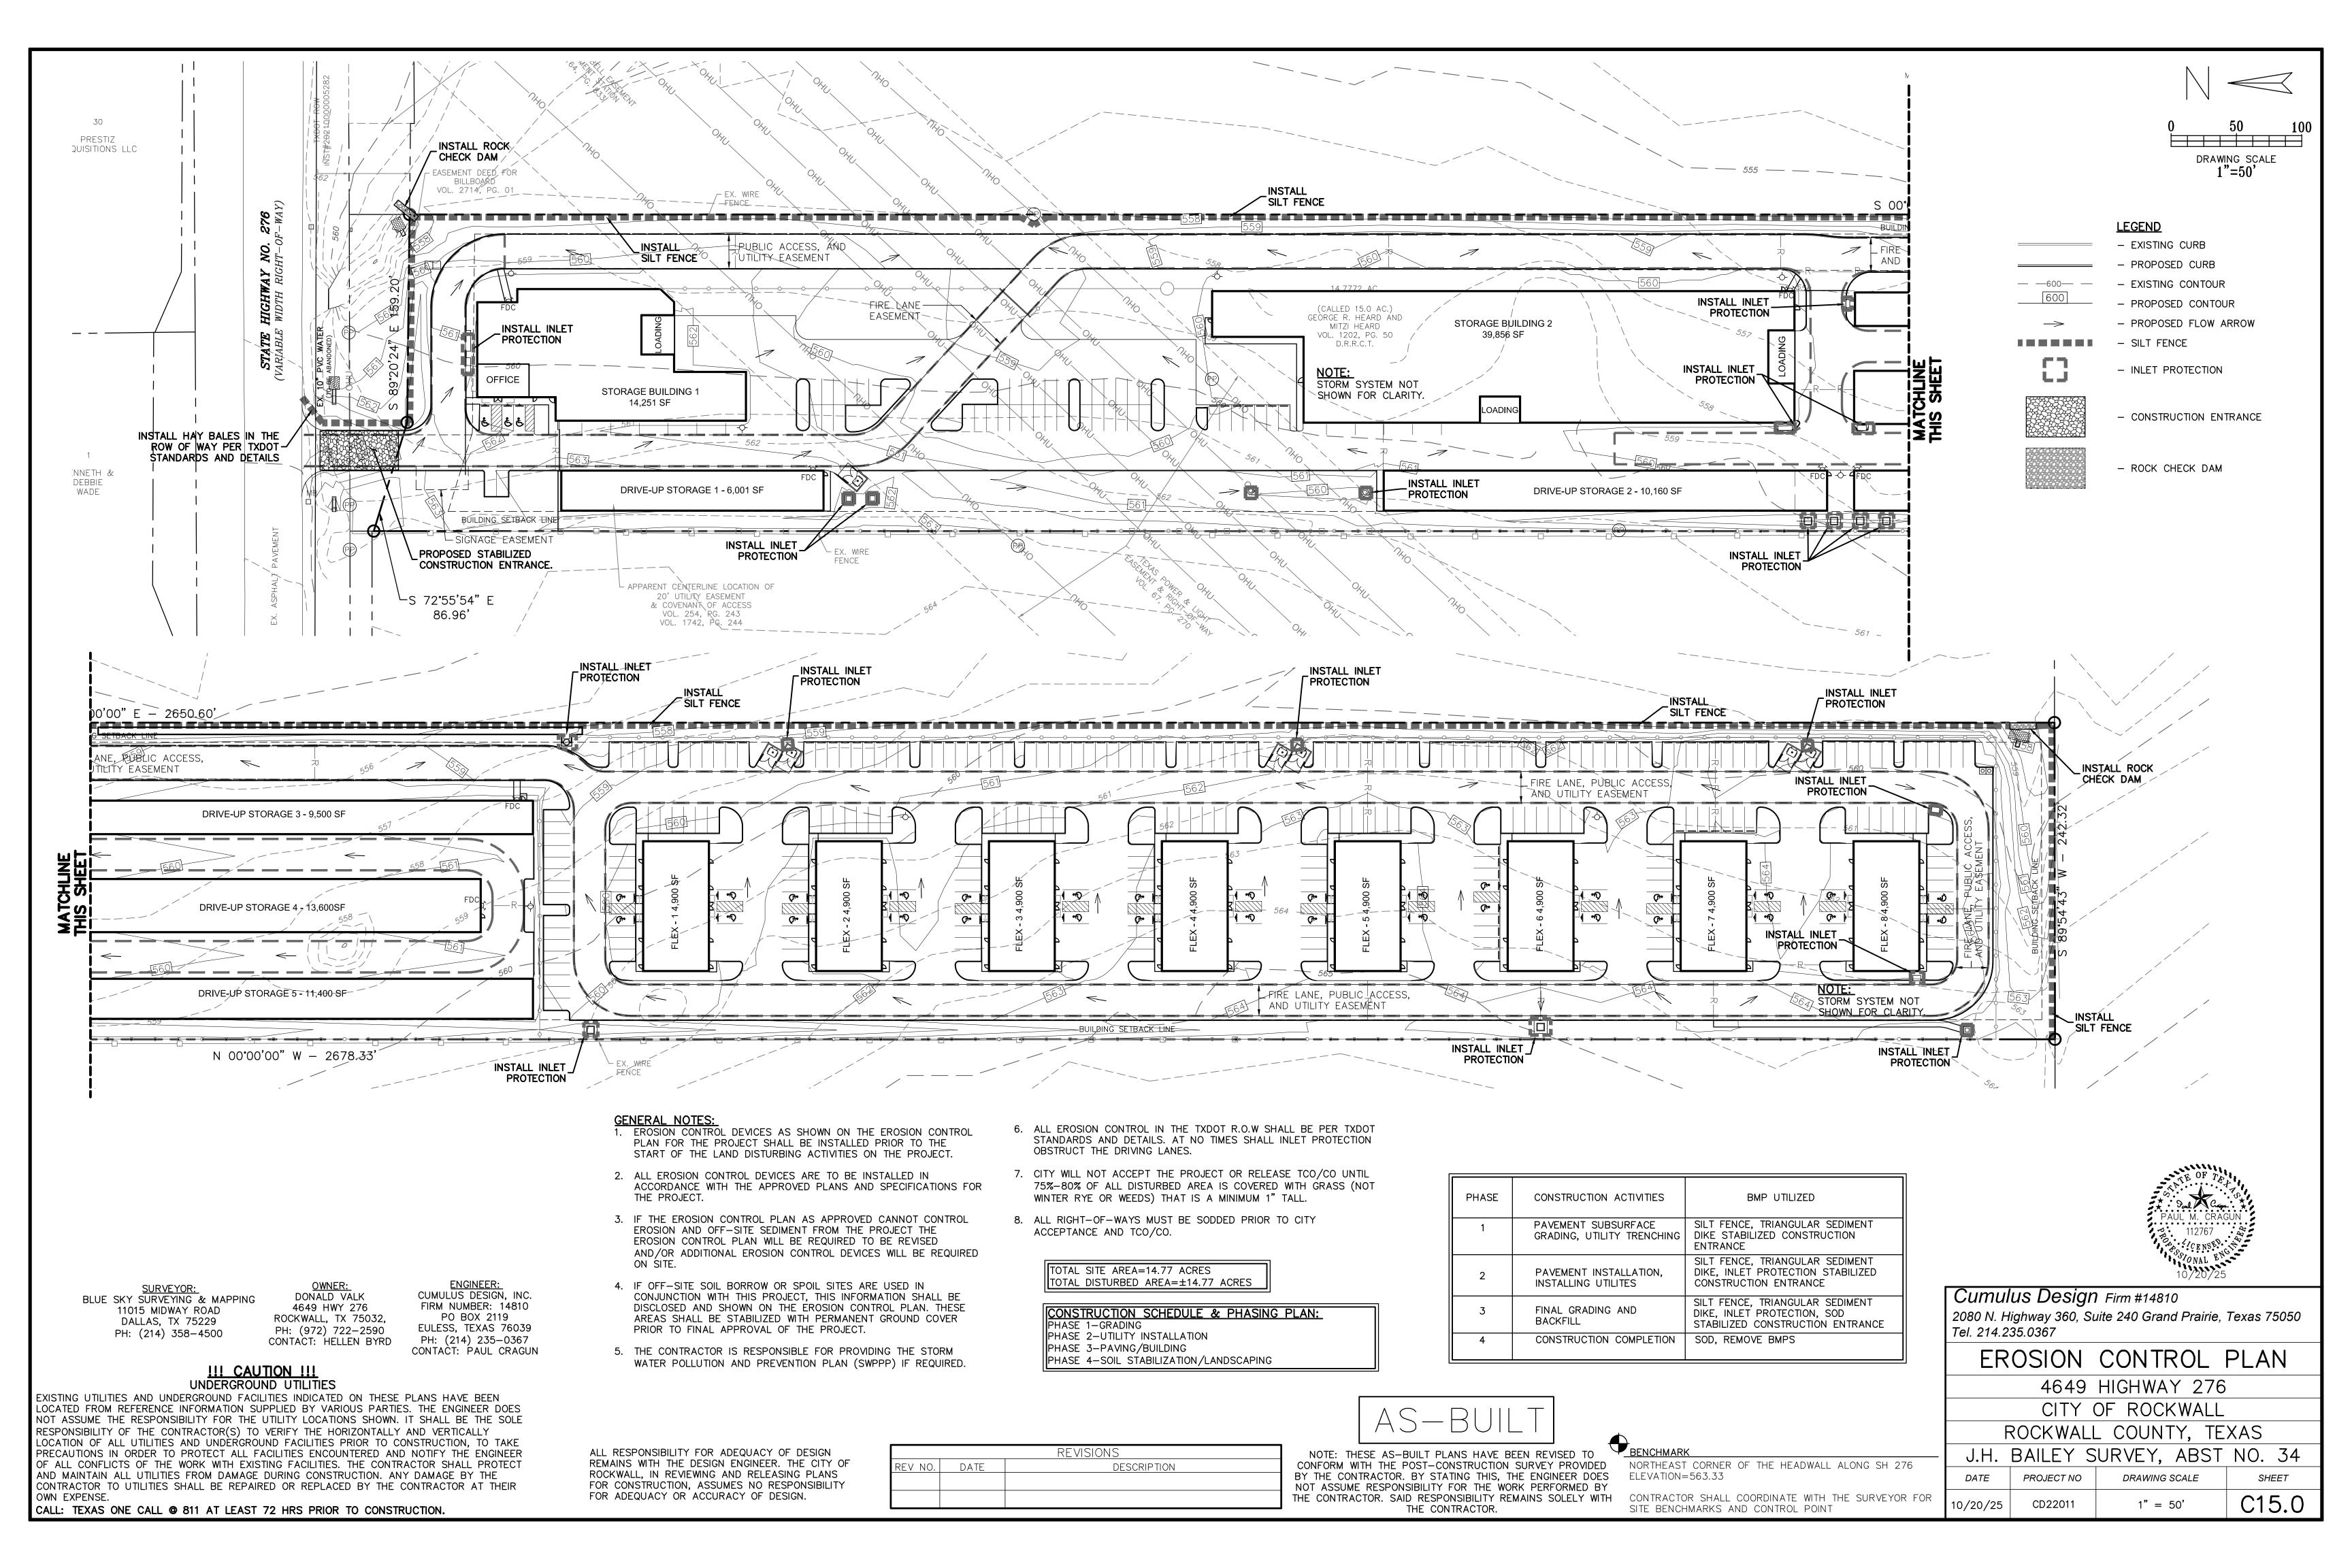


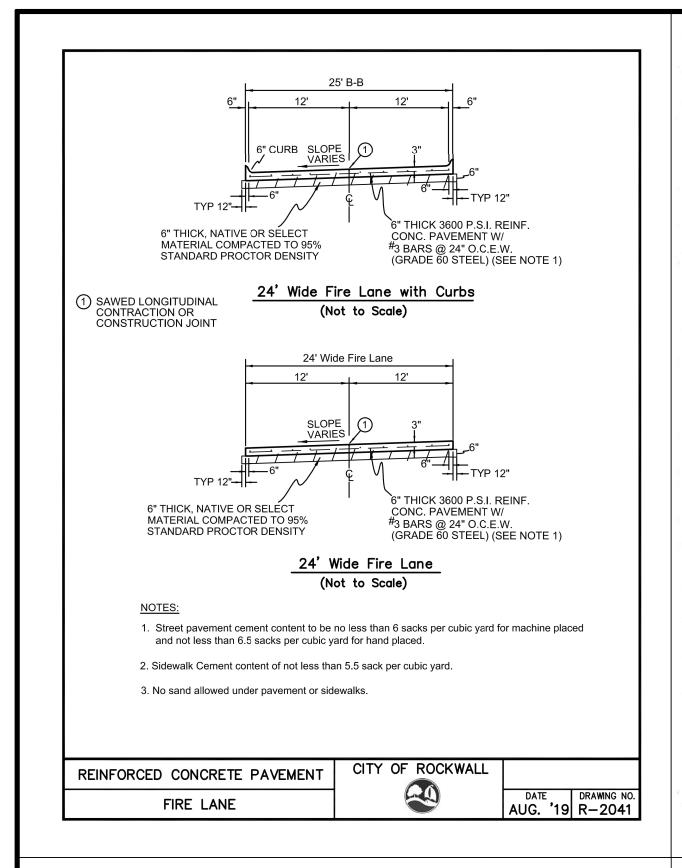


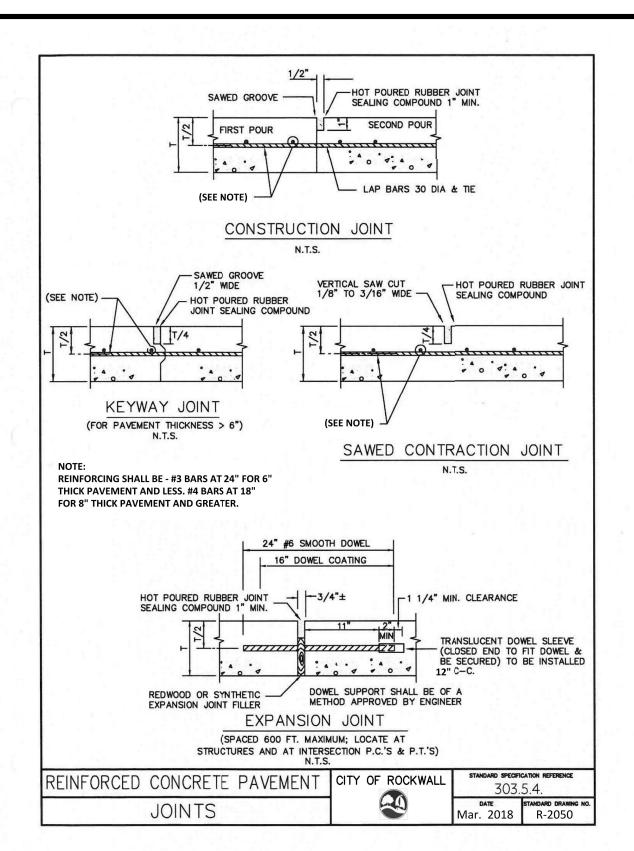


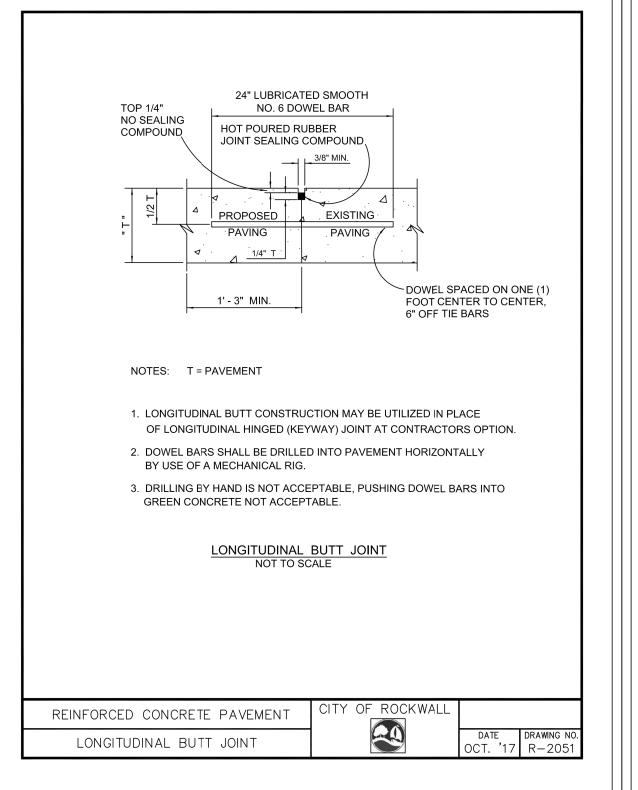


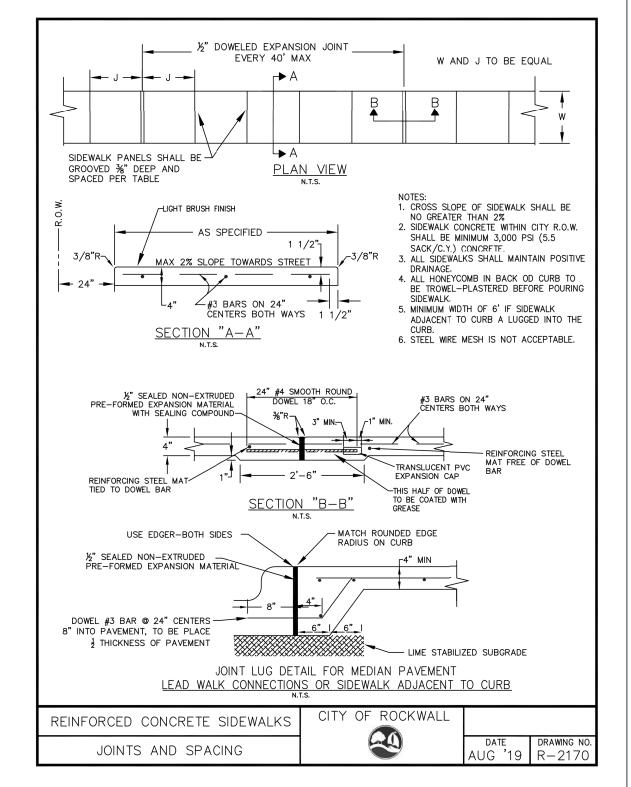


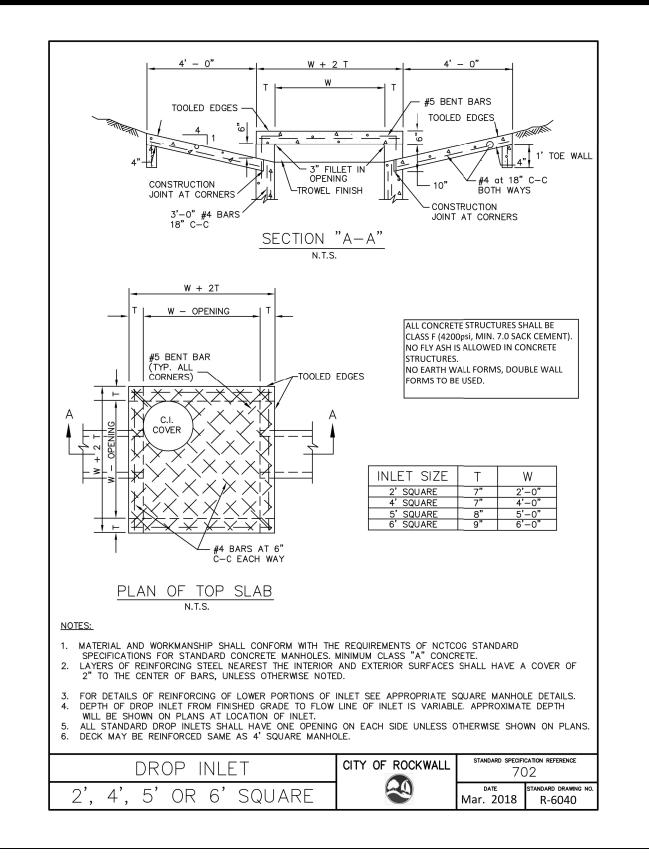

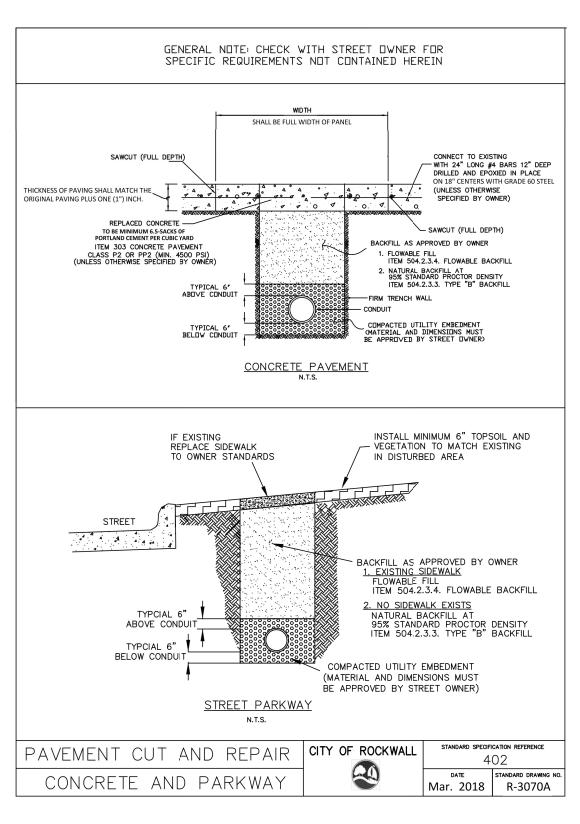

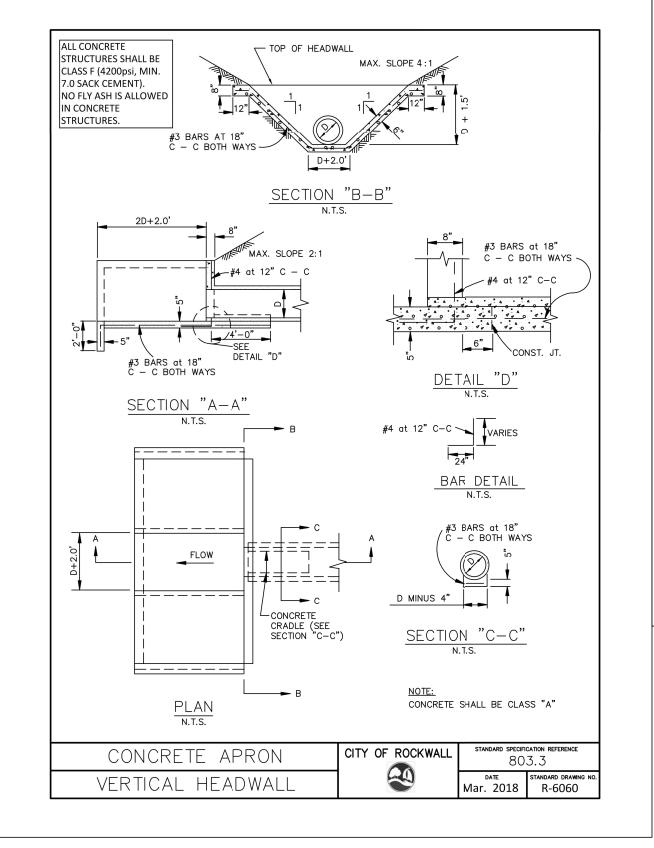

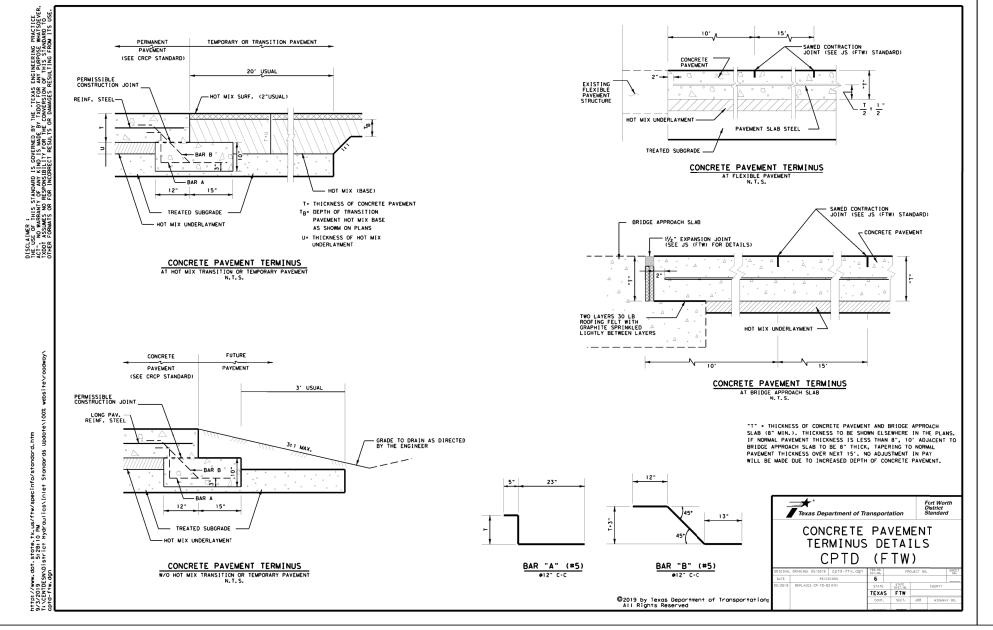

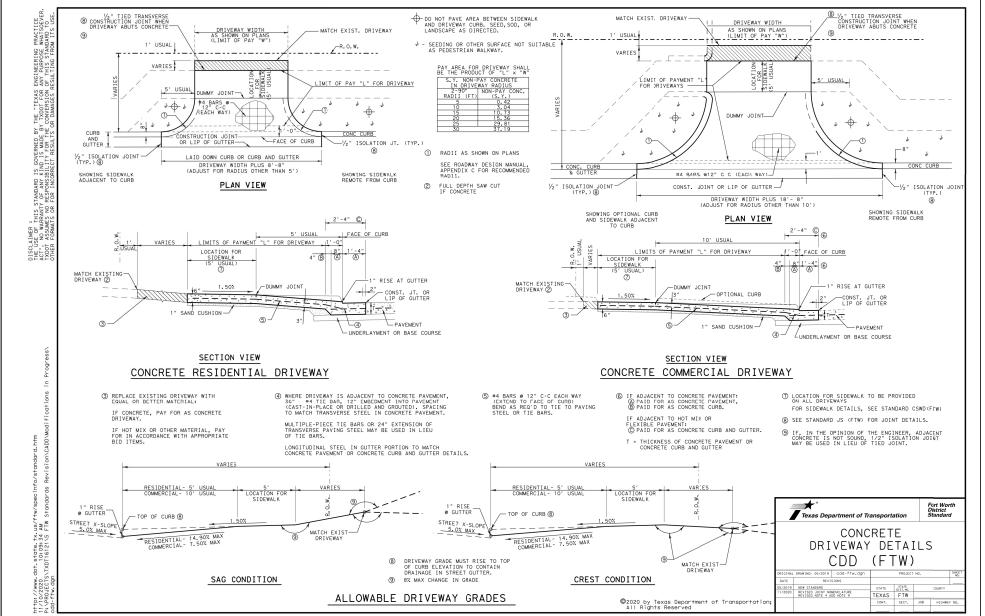

NOTE: THESE AS-BUILT PLANS HAVE BEEN REVISED TO CONFORM WITH THE POST-CONSTRUCTION SURVEY PROVIDED BY THE CONTRACTOR. BY STATING THIS, THE ENGINEER DOES NOT ASSUME RESPONSIBILITY FOR THE WORK PERFORMED BY THE CONTRACTOR. SAID RESPONSIBILITY REMAINS SOLELY WITH THE CONTRACTOR.


# Cumulus Design Firm #14810 2080 N. Highway 360, Suite 240 Grand Prairie, Texas 75050 Tel. 214.235.0367 PUBLIC DETAILS 1


BENCHMARK NORTHEAST CORNER OF THE HEADWALL ALONG SH 276 ELEVATION=563.33

4649 HIGHWAY 276				
CITY OF ROCKWALL				
ROCKWALL COUNTY, TEXAS				
J.H. BAILEY SURVEY, ABST NO. 34				
DATE	PROJECT NO	DRAWING SCALE	SHEET	
10/20/25	CD22011	N.T.S.	C16.0	
	J.H.	CITY ( ROCKWALI  J.H. BAILEY S  DATE PROJECT NO	CITY OF ROCKWALL ROCKWALL COUNTY, TE J.H. BAILEY SURVEY, ABST  DATE PROJECT NO DRAWING SCALE	

ALL RESPONSIBILITY FOR ADEQUACY OF DESIGN
REMAINS WITH THE DESIGN ENGINEER. THE CITY OF
ROCKWALL, IN REVIEWING AND RELEASING PLANS
FOR CONSTRUCTION, ASSUMES NO RESPONSIBILITY
FOR ADEQUACY OR ACCURACY OF DESIGN.

	REVISIONS				
REV NO.	DATE	DESCRIPTION			

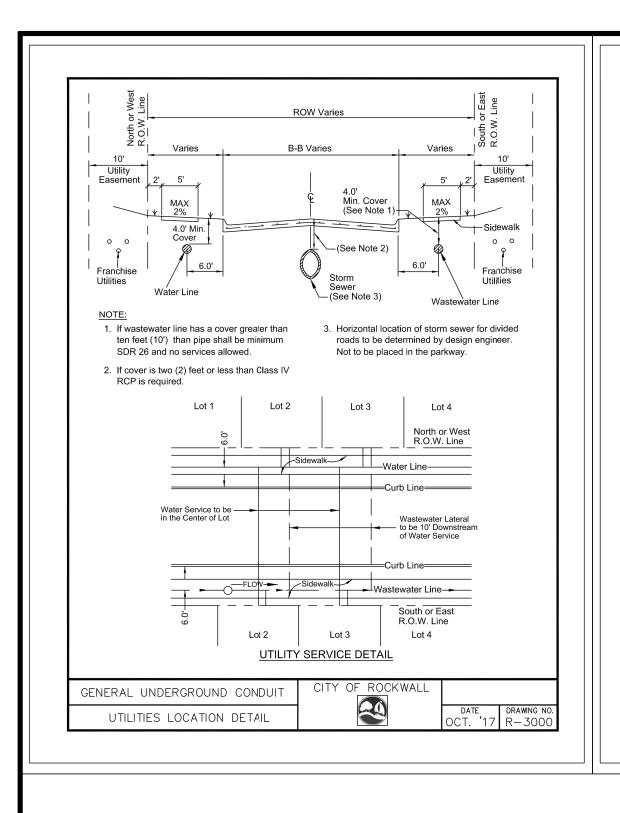

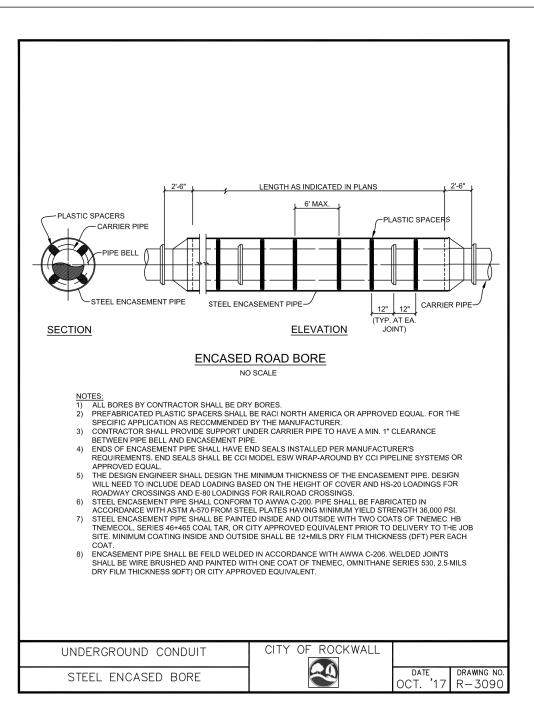

SILT FENCE GENERAL NOTES:

DEVICE IS EMPLOYED.


SIX (6") INCHES MINIMUM.


SILT FENCE


A SPADE OR MECHANICAL TRENCHER, SO THAT THE


5. INSPECTION SHALL BE AS SPECIFIED IN THE SWPPP.


DOWNSLOPE FACE OF THE TRENCH IS FLAT AND

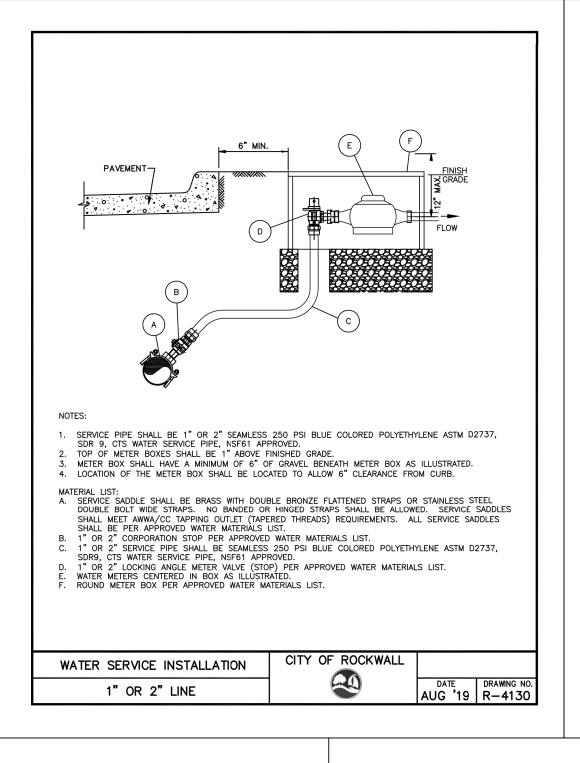


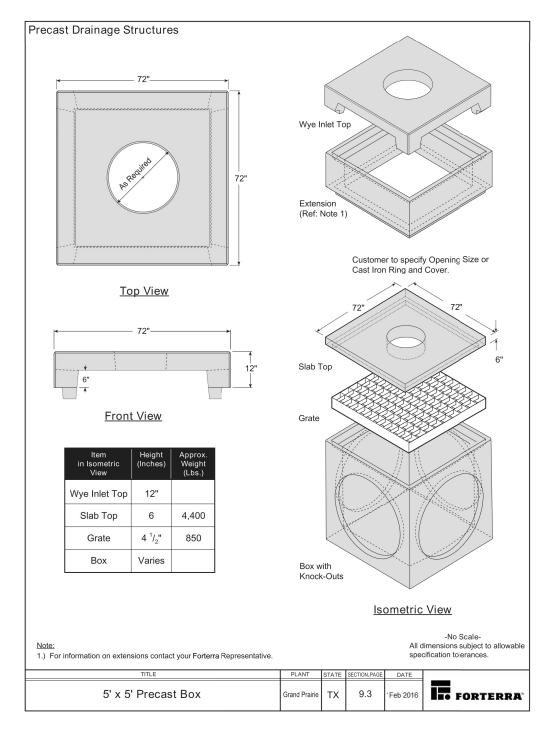


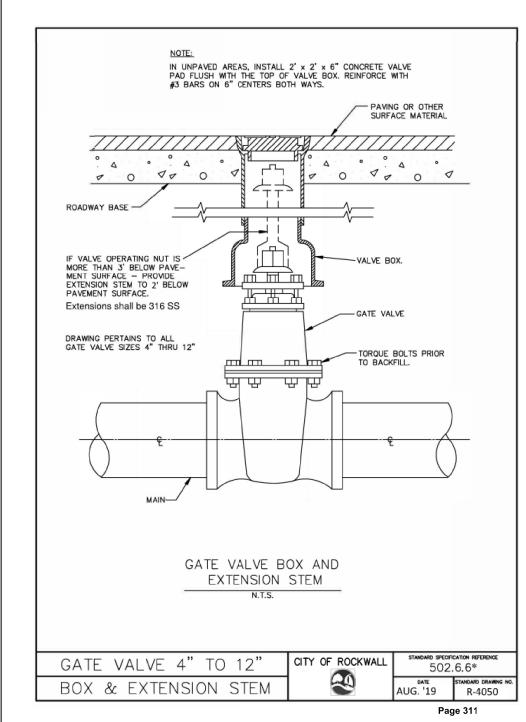


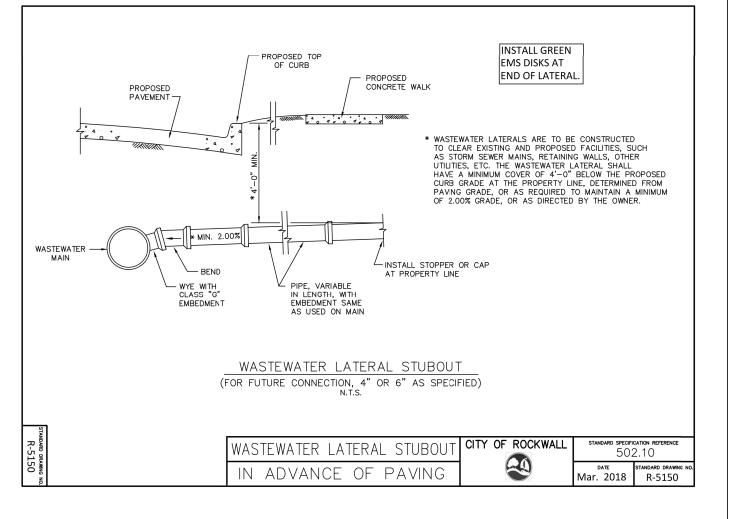


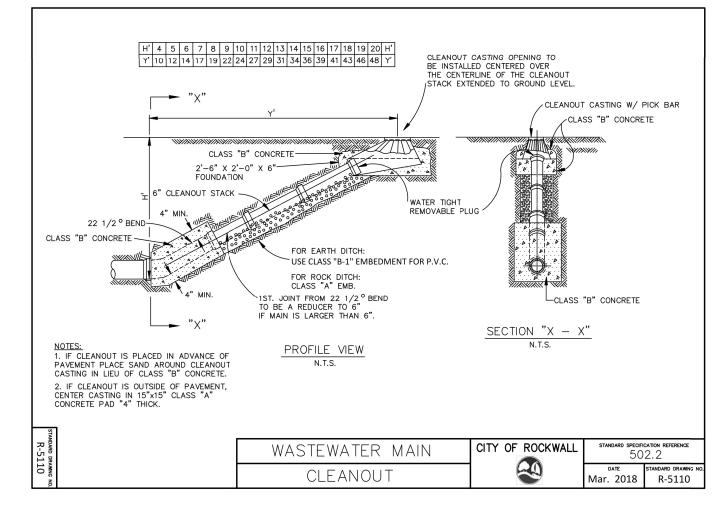

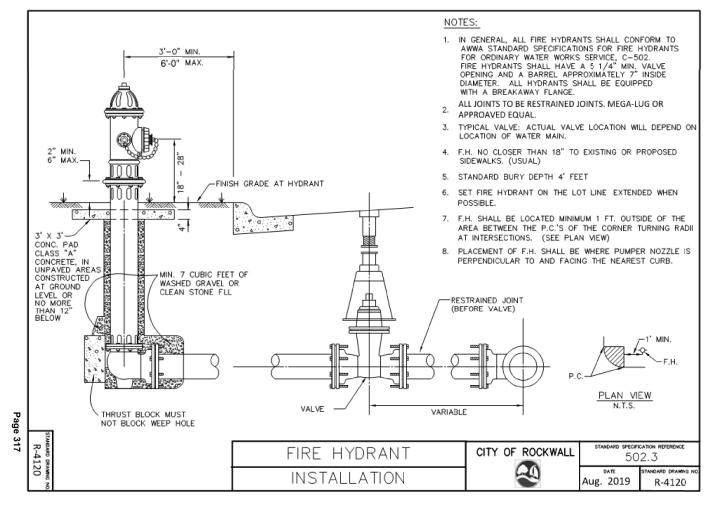

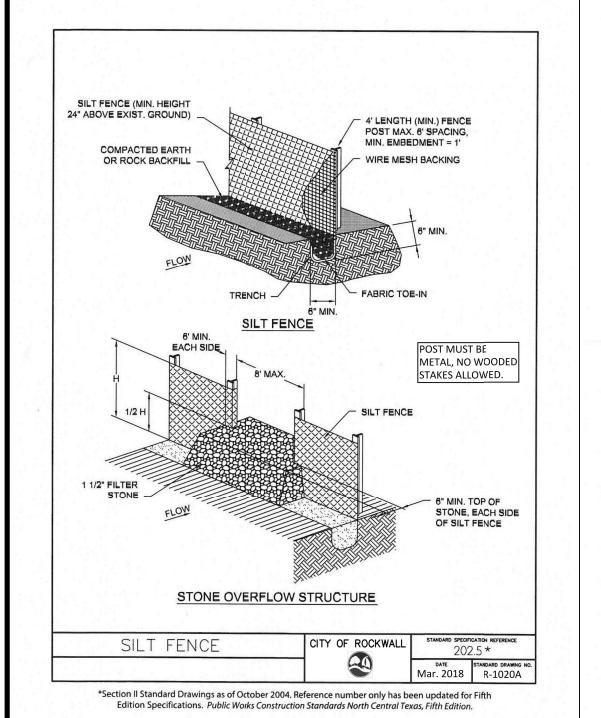

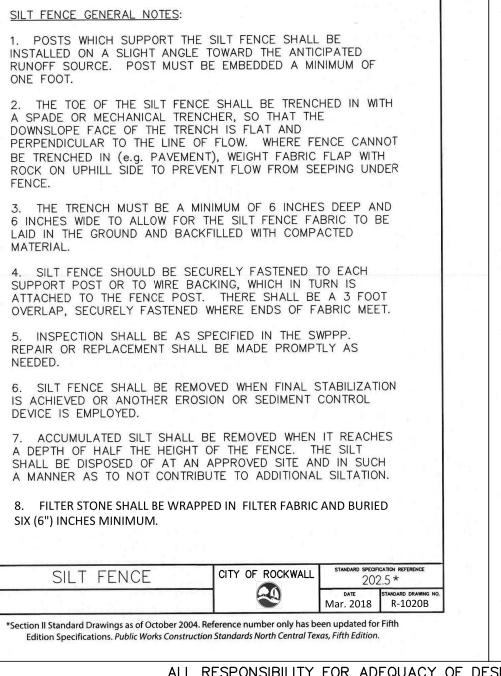

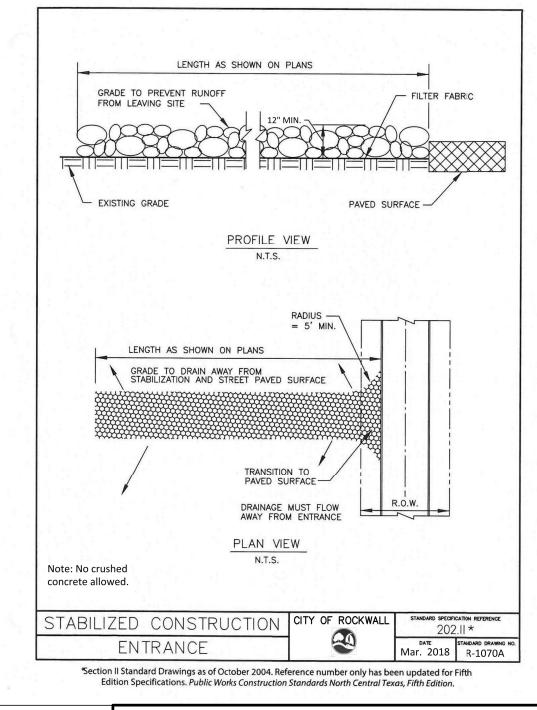

STABILIZED CONSTRUCTION ENTRANCE GENERAL NOTES: 1. STONE SHALL BE 4 TO 6 INCH DIAMETER COARSE 2. MINIMUM LENGTH SHALL BE 50 FEET AND WIDITH SHALL BE 20 FEET. 3. THE THICKNESS SHALL NOT BE LESS THAN 12 INCHES. 4. THE WIDTH SHALL BE NO LESS THAN THE FULL WIDTH OF ALL POINTS OF INGRESS OR EGRESS. 5. WHEN NECESSARY, VEHICLES SHALL BE CLEANED TO REMOVE SEDIMENT PRIOR TO ENTRANCE ONTO A PUBLIC ROADWAY. WHEN WASHING IS REQUIRED, IT SHALL BE DONE ON AN AREA STABILIZED WITH CRUSHED STONE WITH DRAINAGE FLOWING AWAY FROM BOTH THE STREET AND THE STABILIZED ENTRANCE. ALL SEDIMENT SHALL BE PREVENTED FROM ENTERING ANY STORM DRAIN, DITCH OR WATERCOURSE USING APPROVED METHODS. 6. THE ENTRANCE SHALL BE MAINTAINED IN A CONDITION WHICH WILL PREVENT TRACKING OR FLOWING OF SEDIMENT ONTO PAVED SURFACES. THIS MAY REQUIRE PERIODIC TOP DRESSING WITH ADDITIONAL STONE AS CONDITIONS DEMAND. ALL SEDIMENT SPILLED, DROPPED, WASHED, OR TRACKED ONTO PAVED SURFACES MUST BE REMOVED IMMEDIATELY. 7. THE ENTRANCE MUST BE PROPERLY GRADED OR INCORPORATE A DRAINAGE SWALE TO PREVENT RUNOFF FROM LEAVING THE CONSTRUCTION SITE. 8. PREVENT SHORTCUTTING OF THE FULL LENGTH OF THE CONSTRUCTION ENTRANCE BY INSTALLING BARRIERS AS 9. INSPECTION SHALL BE AS SPECIFIED IN THE SWPPP. 10. NO CRUSHED CONCRETE ALLOWED. STABILIZED CONSTRUCTION CITY OF ROCKWALL 20211\* ENTRANCE \*Section II Standard Drawings as of October 2004. Reference number only has been updated for Fifth Edition Specifications. Public Works Construction Standards North Central Texas, Fifth Edition.

ALL RESPONSIBILITY FOR ADEQUACY OF DESIGN REMAINS WITH THE DESIGN ENGINEER. THE CITY OF ROCKWALL, IN REVIEWING AND RELEASING PLANS FOR CONSTRUCTION, ASSUMES NO RESPONSIBILITY FOR ADEQUACY OR ACCURACY OF DESIGN.

CITY OF ROCKWALL

	REVISIONS				
REV NO. DATE DESCRIPTION					

NOTE: THESE AS-BUILT PLANS HAVE BEEN REVISED TO CONFORM WITH THE POST-CONSTRUCTION SURVEY PROVIDED BY THE CONTRACTOR. BY STATING THIS, THE ENGINEER DOES NOT ASSUME RESPONSIBILITY FOR THE WORK PERFORMED BY THE CONTRACTOR. SAID RESPONSIBILITY REMAINS SOLELY WITH THE CONTRACTOR.

Cumulus Design Firm #14810


# 2080 N. Highway 360, Suite 240 Grand Prairie, Texas 75050 Tel. 214.235.0367 PUBLIC DETAILS 2 4649 HIGHWAY 276


CITY OF ROCKWALL


ELEVATION=563.33 CONTRACTOR SHALL COORDINATE WITH THE SURVEYOR FOR SITE BENCHMARKS AND CONTROL POINT

NORTHEAST CORNER OF THE HEADWALL ALONG SH 276

	ROCKWALL COUNTY, TEXAS							
	J.H.	BAILEY S	URVEY,	ABST	NO.	34		
	DATE	PROJECT NO	DRAWING SCALE		SHEET			
DR	10/20/25 CD22011		N.T.S		C16	5.1		

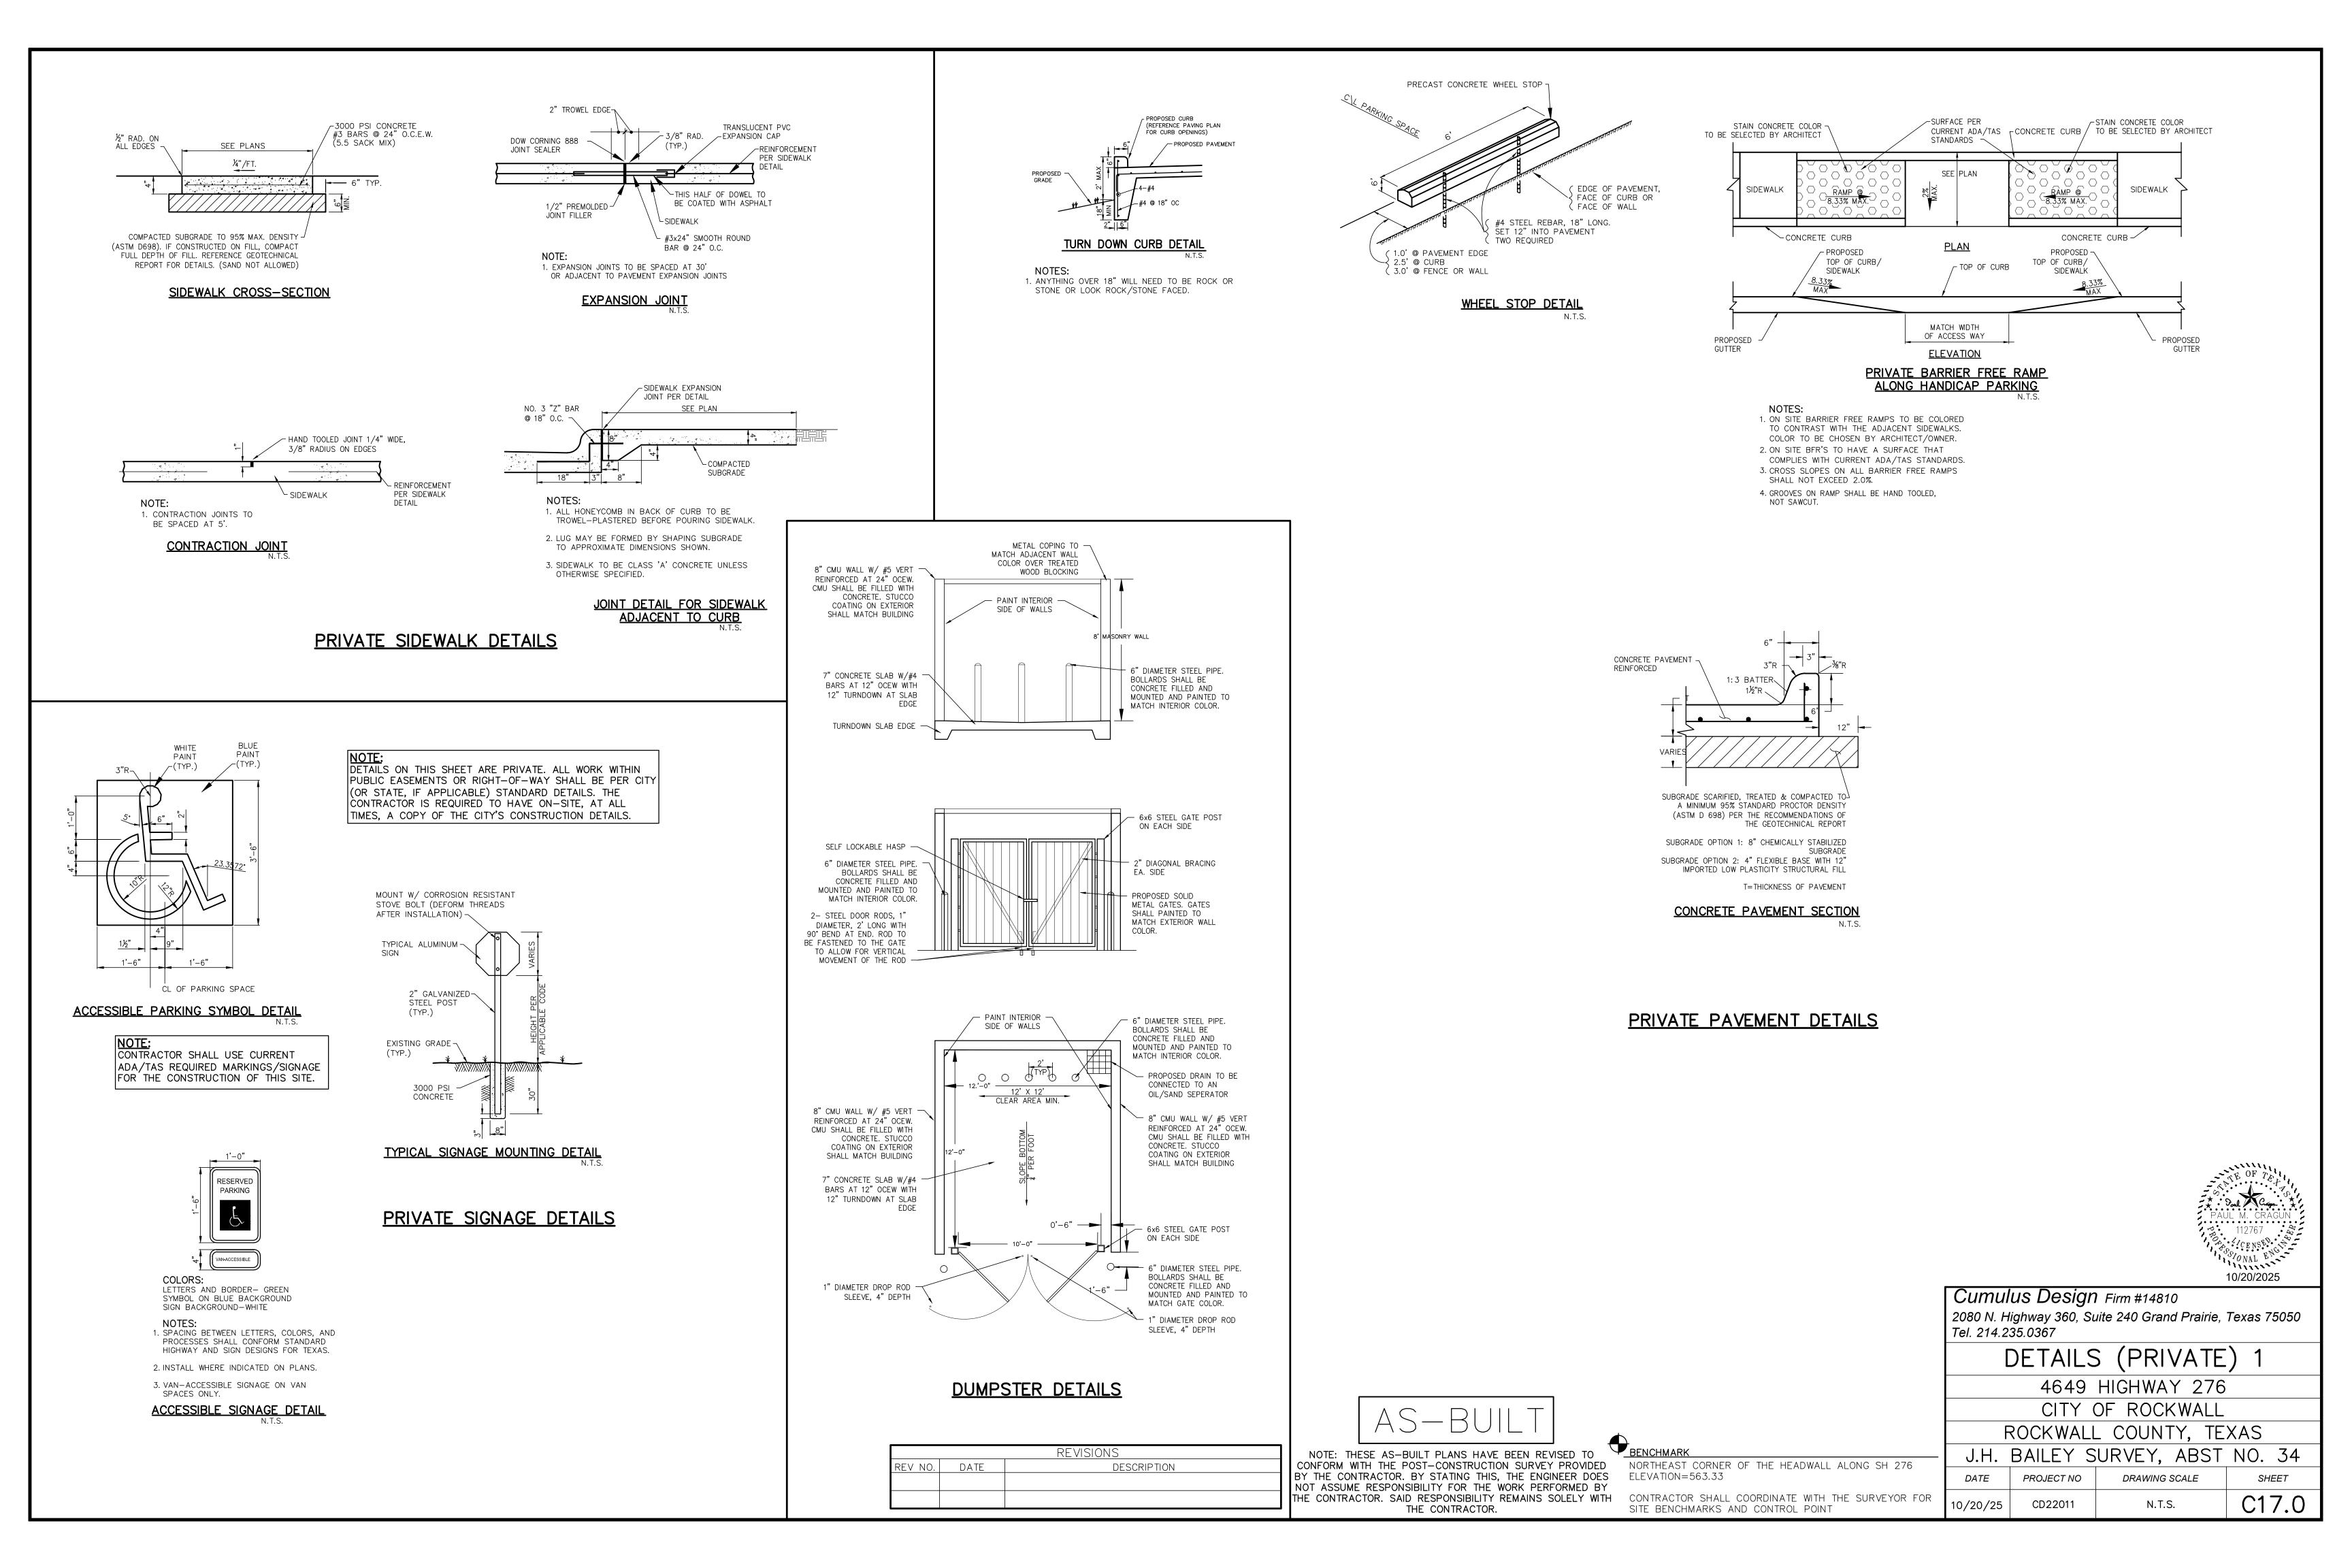


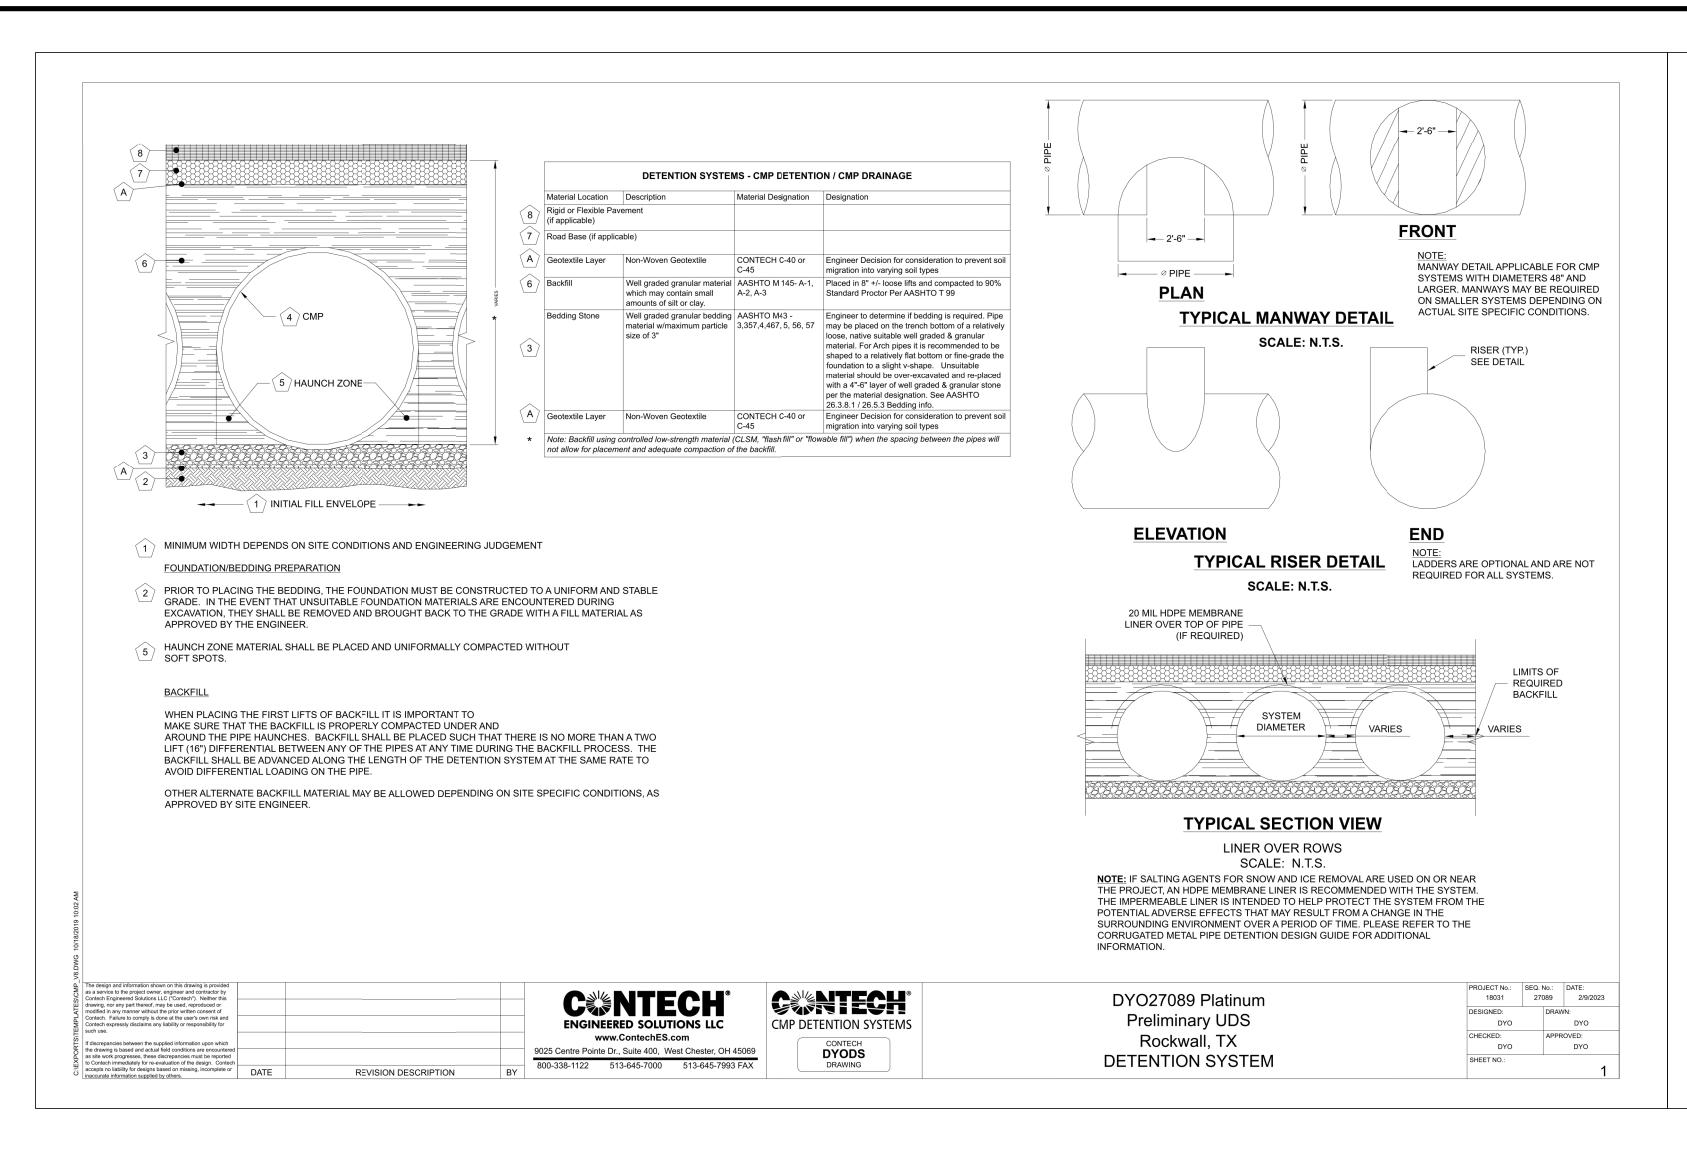

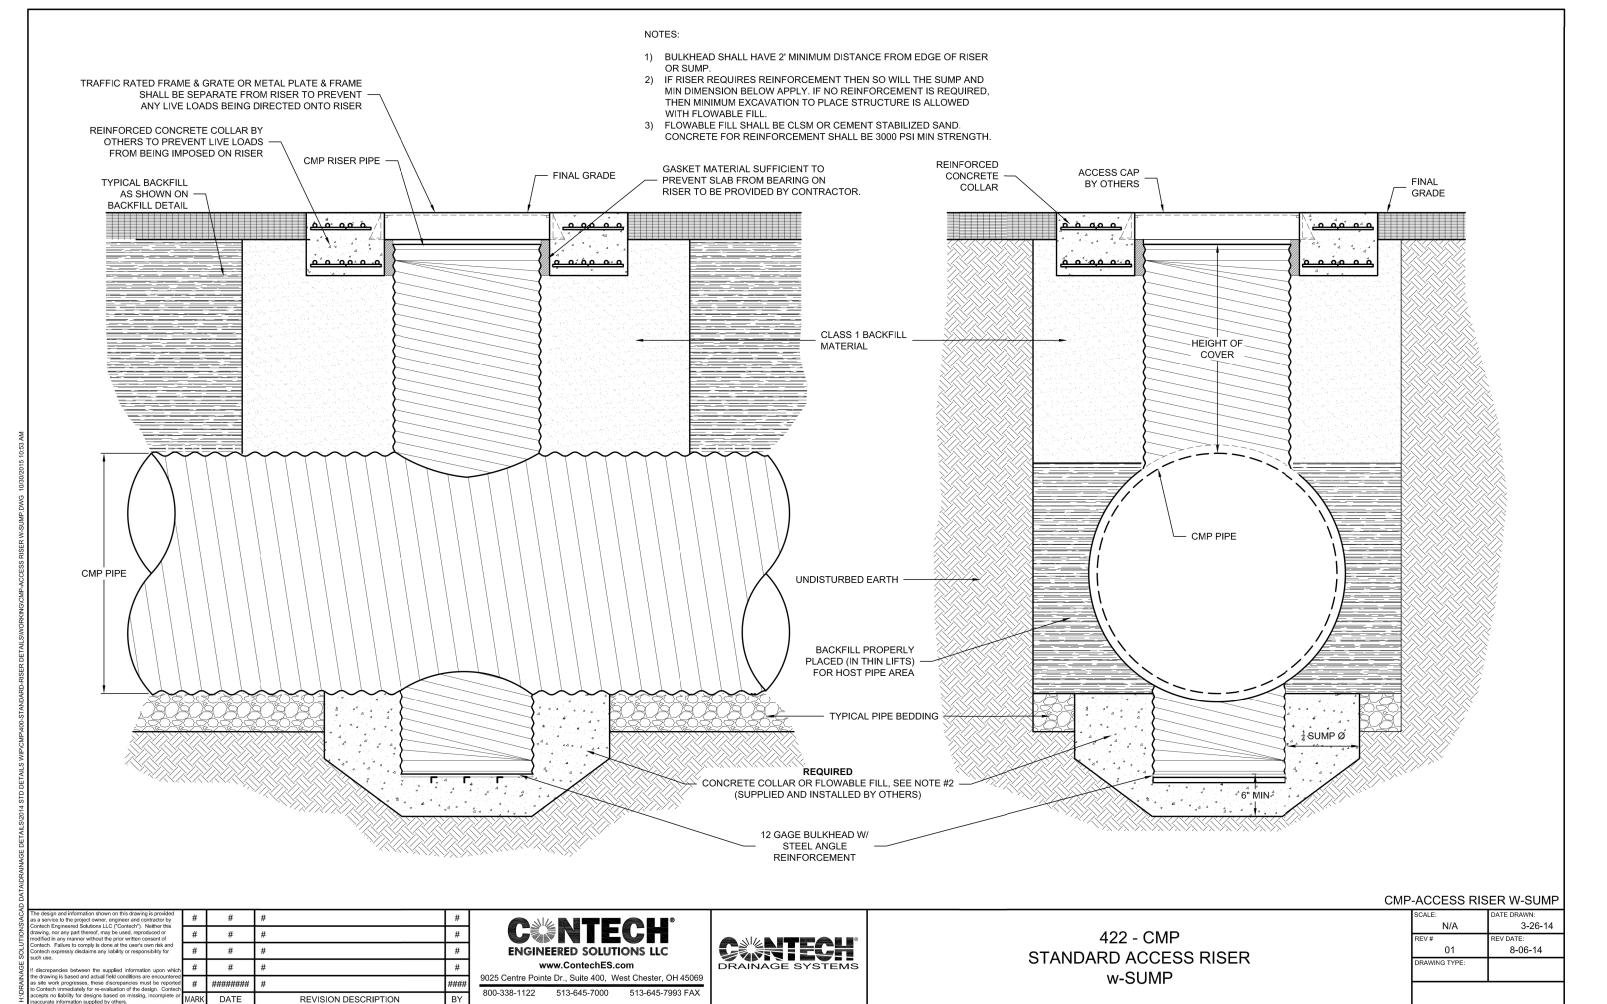



Cumulus Design Firm #14810

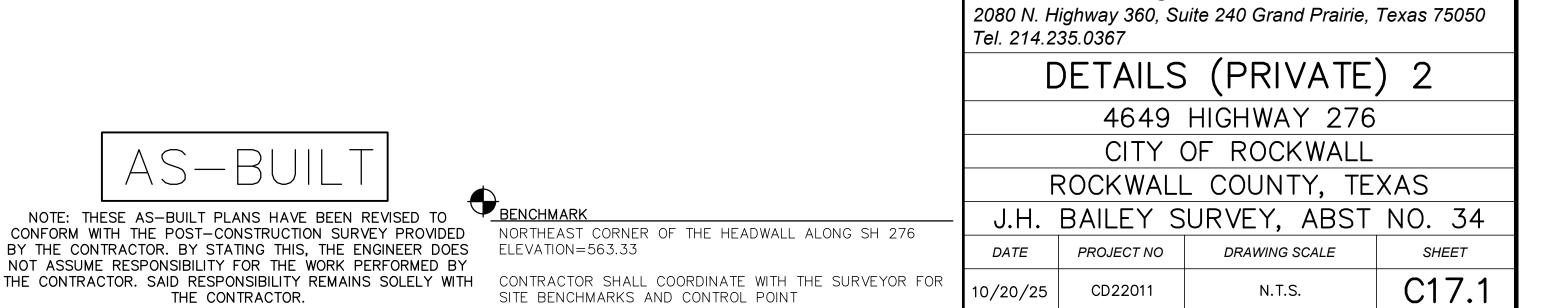

REVISIONS

REV NO. DATE DESCRIPTION