


REVISED TO CONFORM TO CONSTRUCTION RECORDS.  
*W. Douglas* DATE: 12-15-17


SOUTH 67' OF LOT 3  
 BARBARA CRISWELL  
 VOL. 311, PAGE 235  
 D.R.R.C.T.

N. COLLAD STREET  
 S.H. 205  
 EXISTING 50' R.O.W.

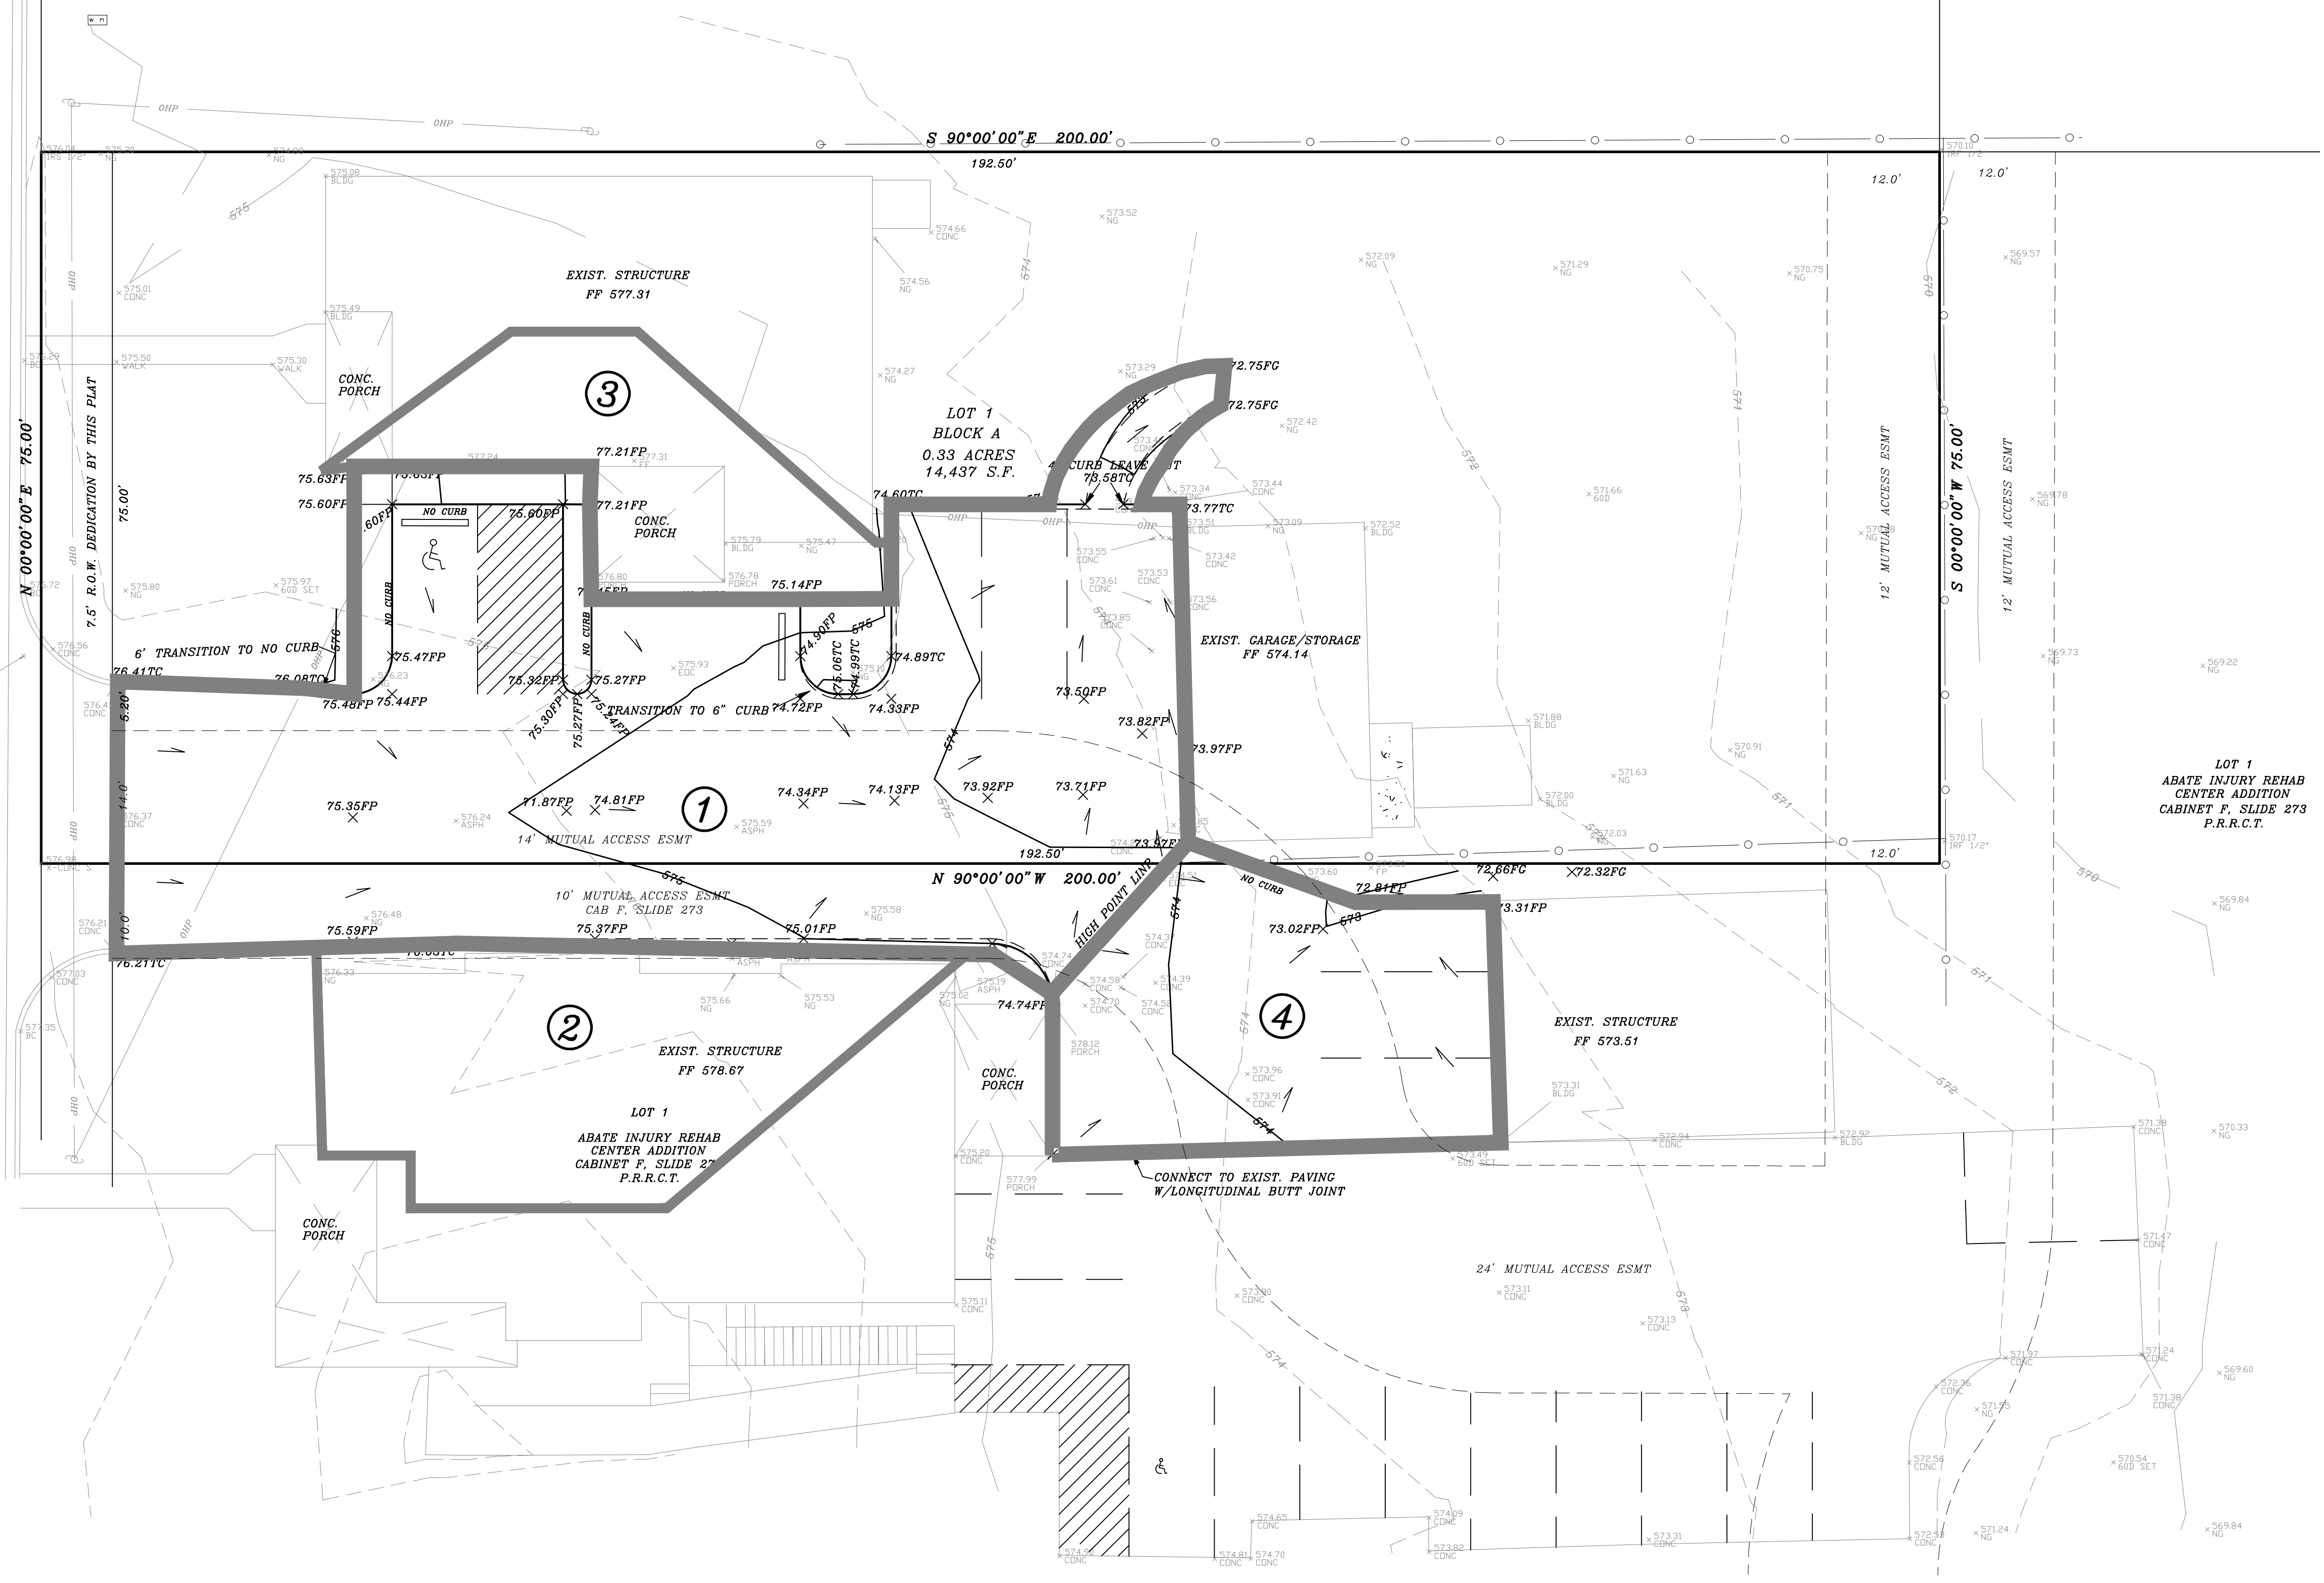

**DRAINAGE TABLE**

DRAINAGE AREA NO.	ACRES	T.C.	C	I 100 YR.	Q 100 YR.	SUM Q 100 YR.
1	0.11	10	0.9	9.8	0.97	
2	0.03	"	"	"	0.26	1.23
3	0.02	"	"	"	0.18	1.41
4	0.03	"	"	"	0.26	1.67

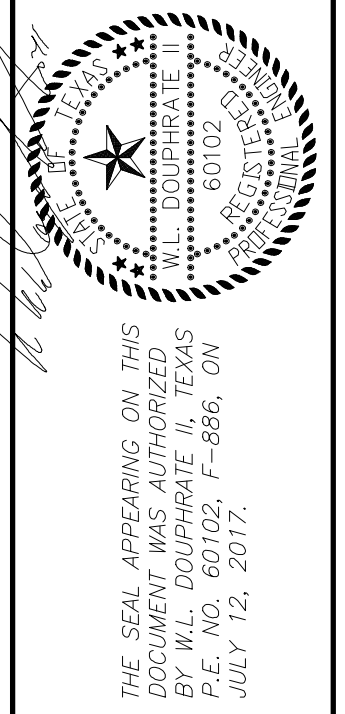

**DOUPHRAE & ASSOCIATES, INC.**  
 ENGINEERING • PROJECT MANAGEMENT • SURVEYING  
 2235 RIDGE RD., # 200 ROCKWALL, TEXAS 75087  
 PHONE: (972)771-9004 FAX: (972)771-9005

**DRAINAGE AREA MAP**  
**ROCKWALL GRACE MEDICAL CLINIC**  
 602 N. COLLAD  
 CITY ROCKWALL  
 ROCKWALL COUNTY, TEXAS

REVISION	W.L.D.
CHECKED	GC.W.
DRAWN	
SCALE	1" = 10' H 1" = 5' V
DATE	JULY, 2017
PROJECT	17004
	6.0