
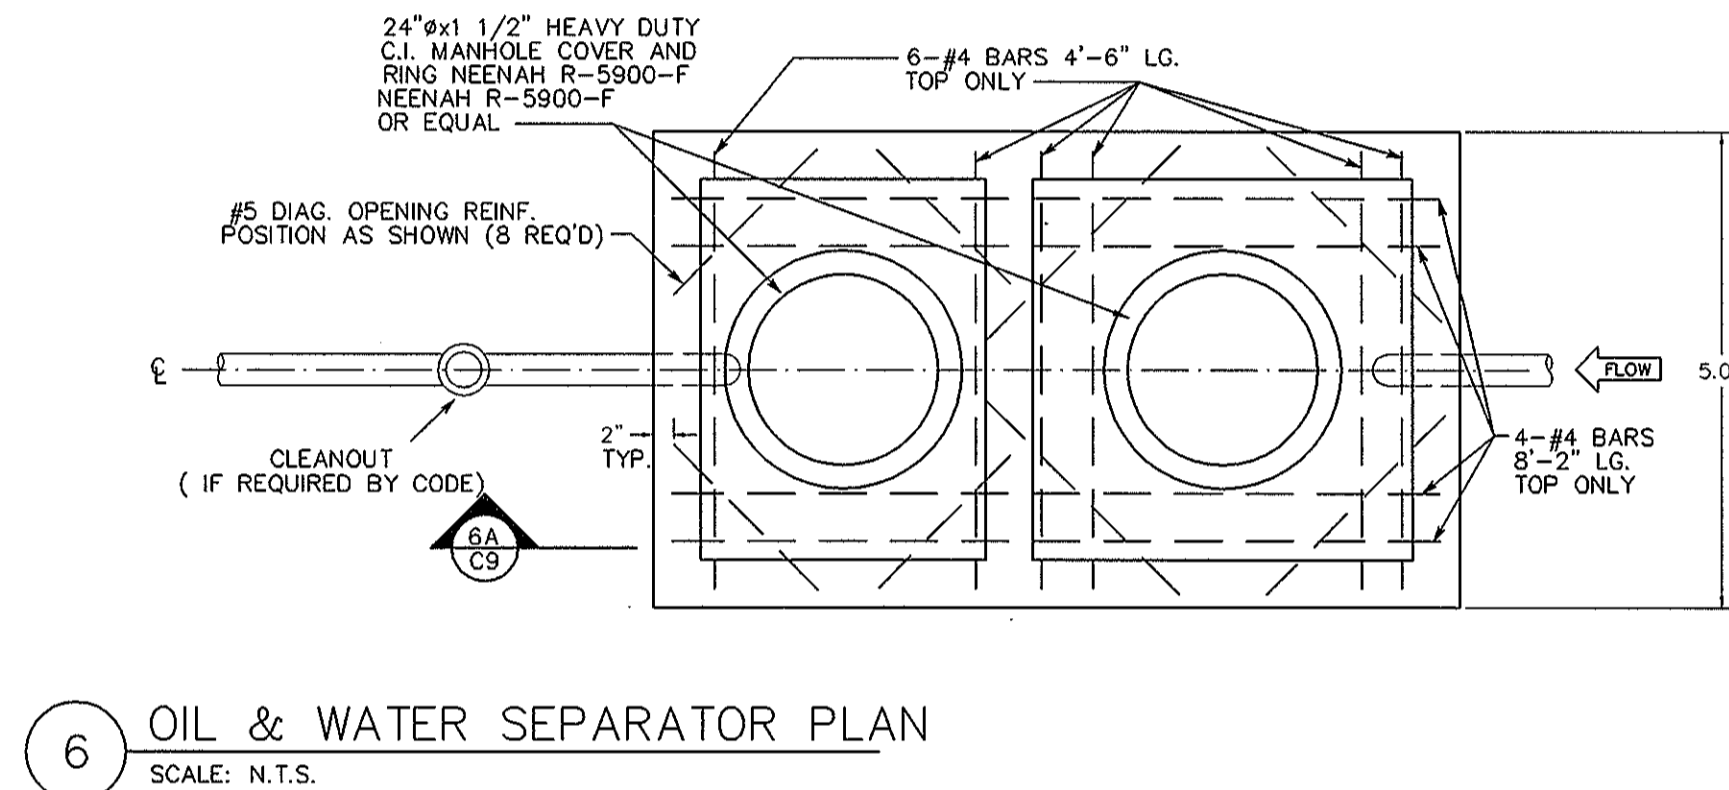


REFER TO NCTCOG 3RD EDITION & CITY OF ROCKWALL STANDARDS.


3 EXPANSION JOINT DETAIL
C9

REFER TO NCTCOG 3RD EDITION & CITY OF ROCKWALL STANDARDS.


4 SAWCUT DETAIL
C9

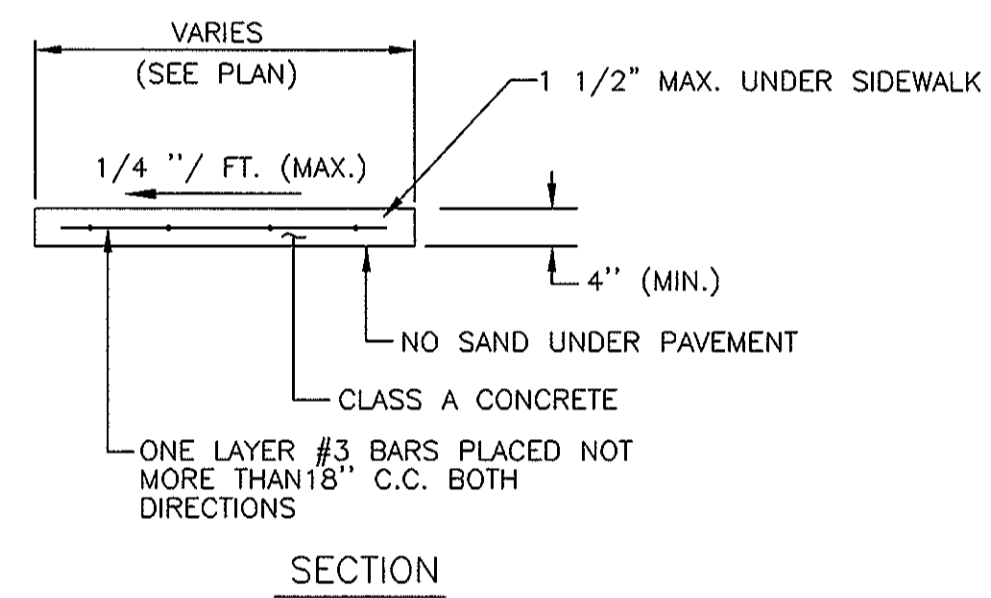


6 OIL & WATER SEPARATOR PLAN
SCALE: N.T.S.

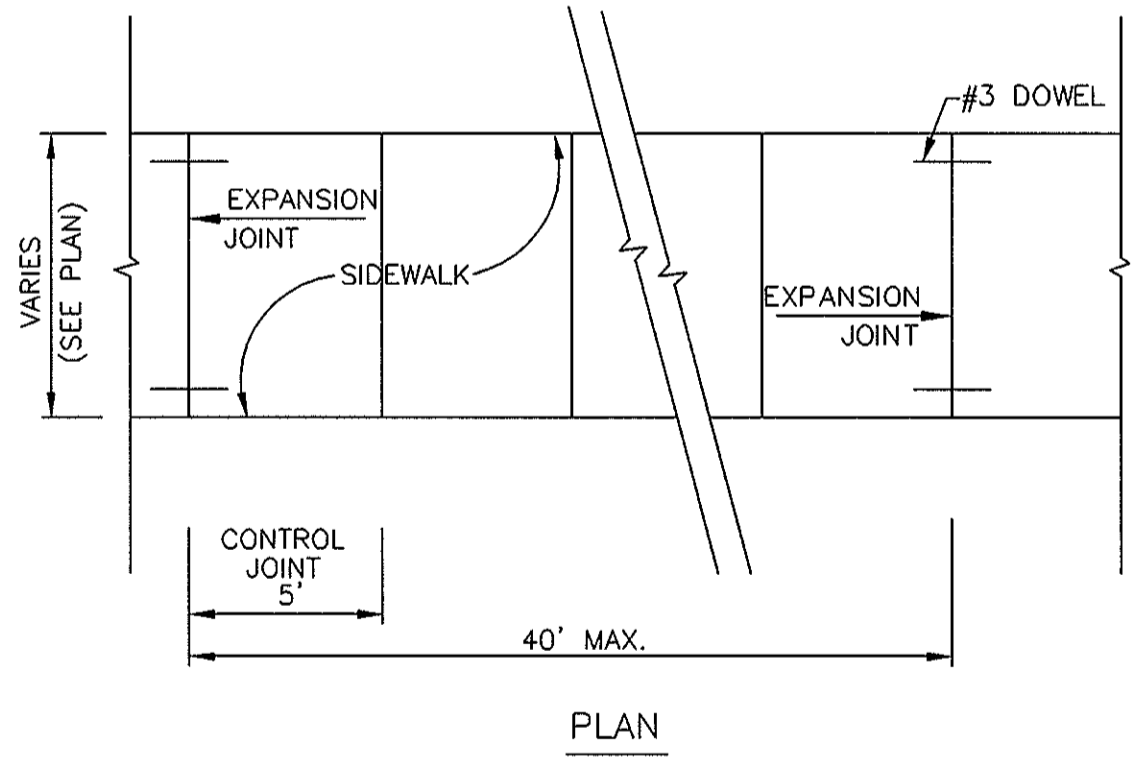

5 SIDEWALK DETAIL
N.T.S.
C9

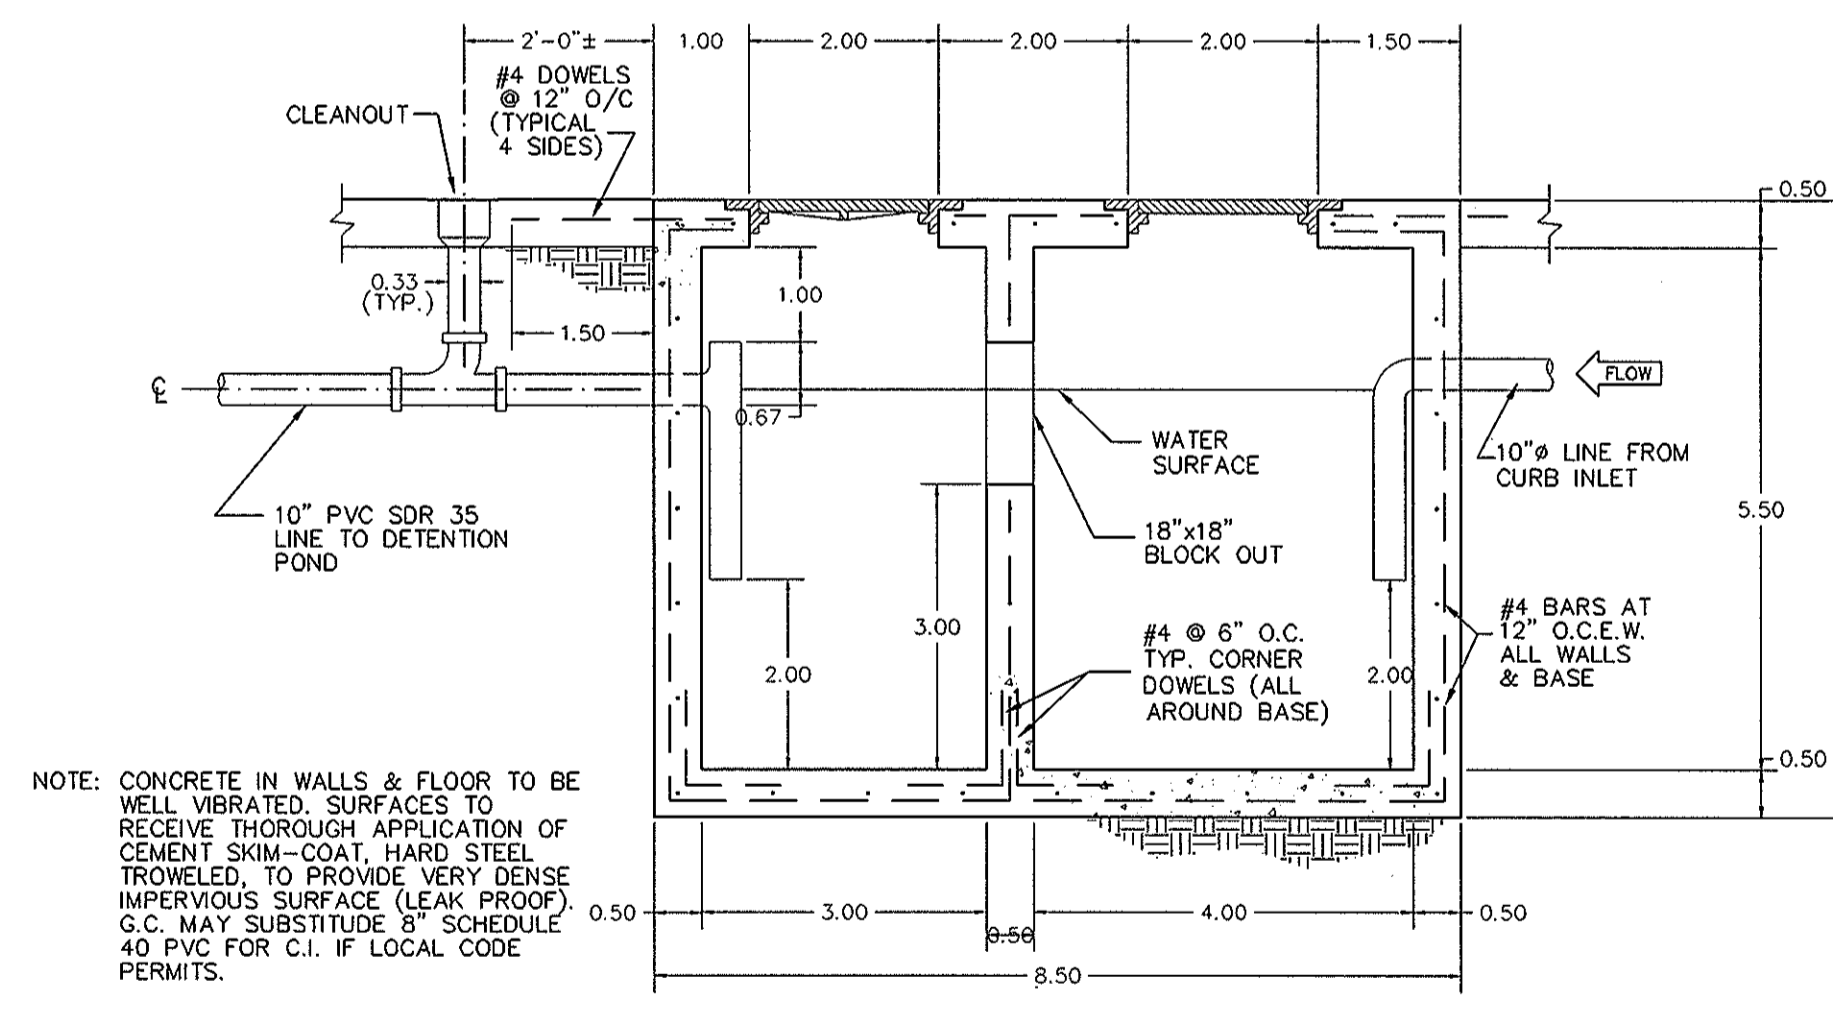

6A OIL & WATER SEPARATOR SECTION
SCALE: N.T.S.

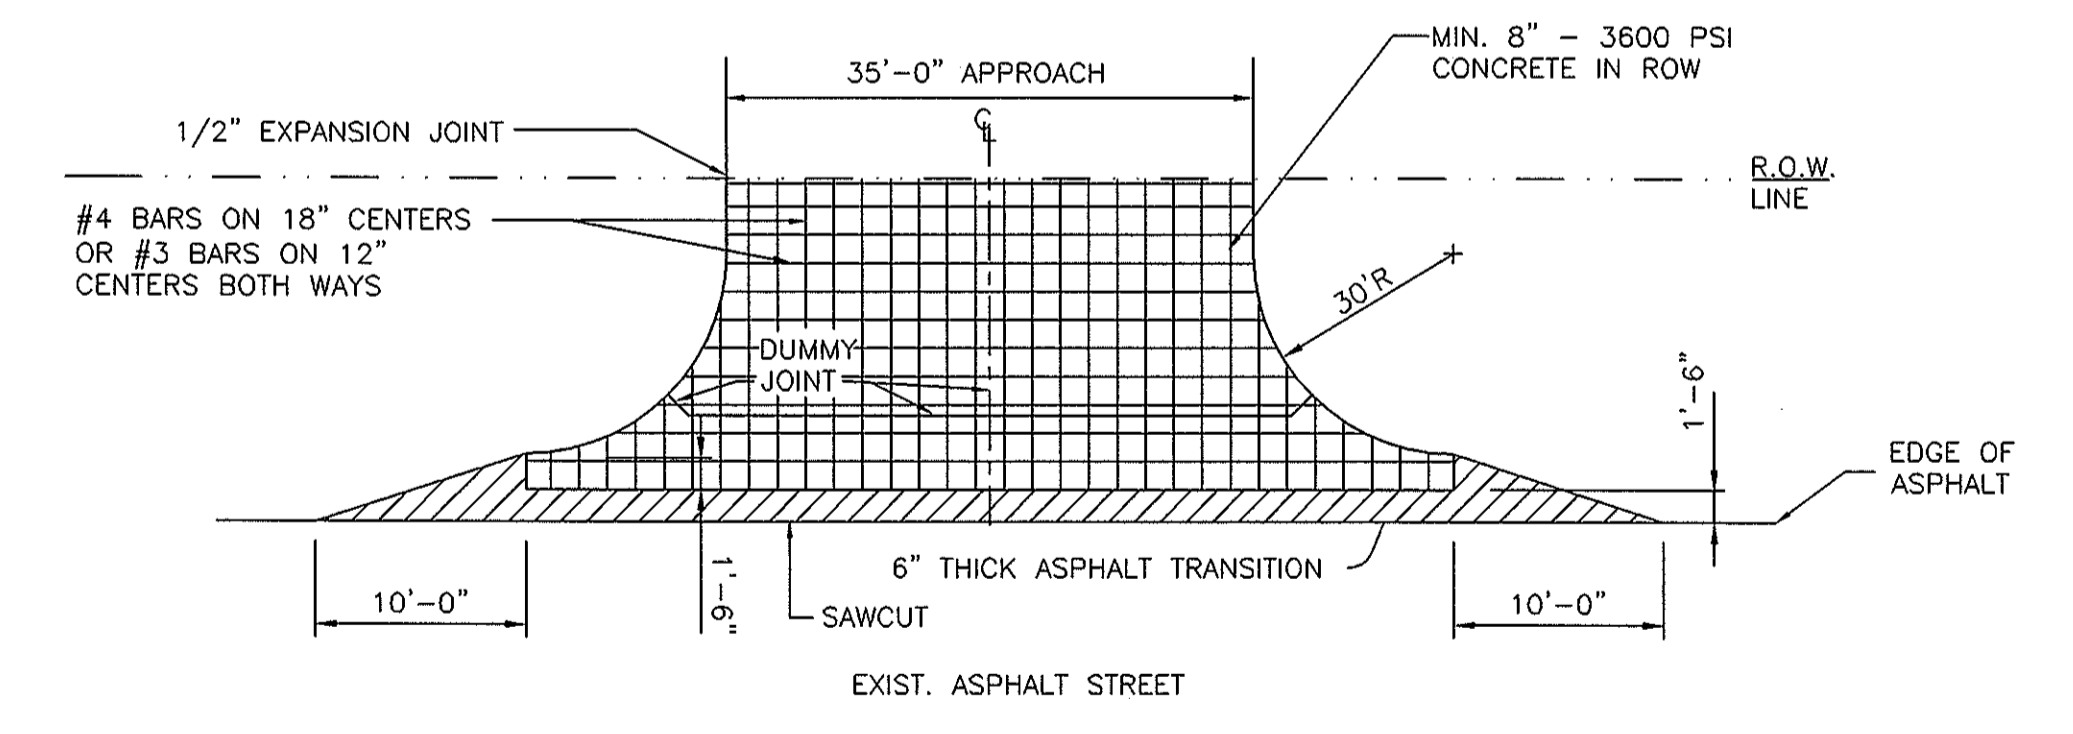

7 TYPICAL DRIVE APPROACH FOR ASPHALT STREETS
N.T.S.
C9

No.	DATE	REVISION / DESCRIPTION	BY	No.	DATE	REVISION / DESCRIPTION	BY

THE DIMENSION GROUP

CIVIL ENGINEERING • LAND DEVELOPMENT • PLANNING • ARCHITECTURE • CONSTRUCTION MANAGEMENT

10755 SANDHILL ROAD, DALLAS, TEXAS 75238 TEL: 214-343-9400 FAX: 214-341-9060


PROJECT INFO.

7-ELEVEN
NE.C. OF N. GOLIAD STREET
& FM 552
ROCKWALL, TEXAS

DRAWING INFO.

AS-BUILT
SITE DETAILS

PROJECT No. 06127
DATE: 05/18/07
DRAWN BY: CS
CHECKED BY: RA

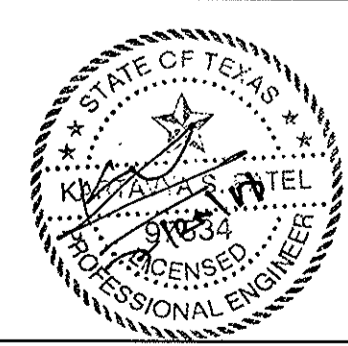

SHEET NUMBER

C9

7-ELEVEN-NE.C. OF N. GOLIAD STREET (SH 205) & FM 552, ROCKWALL, TEXAS