

100 YEAR Weir Calculation

Coefficient C: 3.33
Base b: 1.03 ft
height h: 2 ft
Flow Q: 2.91 cfs

25 YEAR Weir Calculation

Coefficient C: 3.33
Base b: 1.03 ft
height h: 1.708333 ft
Flow Q: 2.30 cfs

10 YEAR Weir Calculation

Coefficient C: 3.33
Base b: 1.03 ft
height h: 1.566667 ft
Flow Q: 2.02 cfs

5 YEAR Weir Calculation

Coefficient C: 3.33
Base b: 1.03 ft
height h: 1.41 ft
Flow Q: 1.72 cfs

NORTH DETENTION POND OFF SITE 100 YEAR DETENTION CALCULATION

Drainage Area (Ac)	Offsite Rate A3 Developed	Offsite Rate A3 Undeveloped	Pre Rate A3 & A4	Pond Bypass Rate A4+A5
0.35	0.35	1.26	1.1	0.03
Comp C-Factor	0.90	0.35	0.35	0.9

Duration Time (min)	Intensity for 100 yr storm (in/hr)	Offsite Rate A3 Developed (cfs)	Offsite Rate A3 Undeveloped (cfs)	Pre Rate A3 & A4 (cfs)	Pond Bypass Rate A4 (cfs)	Outflow Allowed (cfs)	Inflow (cf)	Outflow (cf)	Required Storage (cf)
10	9.8	3.09	4.32	3.20	0.26	2.93	4445.28	1758.54	2687
20	8.3	2.61	3.66	3.20	0.26	2.93	3739.76	2637.81	4892
30	6.9	2.17	3.04	3.20	0.26	2.93	3089.52	3517.08	5872
40	5.8	1.83	2.56	3.20	0.26	2.93	2523.52	4396.35	6127
50	5	1.58	2.21	3.20	0.26	2.93	2134.00	5275.62	6064
60	4.5	1.42	1.98	3.20	0.26	2.93	1824.70	6154.89	6092
70	4	1.26	1.76	3.20	0.26	2.93	1574.00	7034.16	5667
80	3.7	1.17	1.63	3.20	0.26	2.93	13426.56	7913.43	5513
90	3.5	1.10	1.54	3.20	0.26	2.93	11288.40	8792.70	5296
100	3.3	1.04	1.46	3.20	0.26	2.93	10368.80	9671.97	5297
110	2.9	0.91	1.28	3.20	0.26	2.93	14669.84	10551.24	3919

25 YEAR DETENTION CALCULATION

Drainage Area (Ac)	Offsite Rate A3 Developed	Offsite Rate A3 Undeveloped	Pre Rate A3 & A4	Pond Bypass Rate A4+A5
0.35	0.35	1.26	1.1	0.03
Comp C-Factor	0.90	0.35	0.35	0.9

Duration Time (min)	Intensity for 25 yr storm (in/hr)	Offsite Rate A3 Developed (cfs)	Offsite Rate A3 Undeveloped (cfs)	Pre Rate A3 & A4 (cfs)	Pond Bypass Rate A4 (cfs)	Outflow Allowed (cfs)	Inflow (cf)	Outflow (cf)	Required Storage (cf)
10	8.3	2.61	3.66	2.54	0.22	2.32	3764.88	1390.14	2375
20	6.6	2.08	2.91	2.54	0.22	2.32	3087.52	2085.21	3902
30	5.5	1.73	2.43	2.54	0.22	2.32	2484.40	2780.28	4704
40	4.6	1.45	2.03	2.54	0.22	2.32	1946.24	3475.35	4871
50	4	1.26	1.76	2.54	0.22	2.32	1472.00	4170.42	4902
60	3.5	1.10	1.54	2.54	0.22	2.32	1025.60	4865.49	4660
70	3.25	1.02	1.43	2.54	0.22	2.32	10319.40	5560.56	4759
80	3	0.95	1.32	2.54	0.22	2.32	10886.40	6255.63	4631
90	2.8	0.88	1.23	2.54	0.22	2.32	11430.72	6950.70	4480
100	2.4	0.76	1.06	2.54	0.22	2.32	10886.40	7645.77	3241
110	2.2	0.69	0.97	2.54	0.22	2.32	10977.12	8340.84	2636

10 YEAR DETENTION CALCULATION

Drainage Area (Ac)	Offsite Rate A3 Developed	Offsite Rate A3 Undeveloped	Pre Rate A3 & A4	Pond Bypass Rate A4+A5
0.35	0.35	1.26	1.1	0.03
Comp C-Factor	0.90	0.35	0.35	0.9

Duration Time (min)	Intensity for 10 yr storm (in/hr)	Offsite Rate A3 Developed (cfs)	Offsite Rate A3 Undeveloped (cfs)	Pre Rate A3 & A4 (cfs)	Pond Bypass Rate A4 (cfs)	Outflow Allowed (cfs)	Inflow (cf)	Outflow (cf)	Required Storage (cf)
10	7.2	2.27	3.18	2.23	0.19	2.04	3265.92	1223.16	2043
20	5.8	1.83	2.56	2.23	0.19	2.04	2521.76	1834.74	3427
30	4.8	1.51	2.12	2.23	0.19	2.04	1834.84	2446.32	4086
40	4	1.26	1.76	2.23	0.19	2.04	1257.60	3057.90	4200
50	3.4	1.07	1.50	2.23	0.19	2.04	771.20	3669.48	4042
60	3	0.95	1.32	2.23	0.19	2.04	6184.80	4281.06	3884
70	2.9	0.91	1.28	2.23	0.19	2.04	5208.00	4892.64	4315
80	2.7	0.85	1.19	2.23	0.19	2.04	4797.76	5504.22	4294
90	2.4	0.76	1.06	2.23	0.19	2.04	4797.76	6115.80	3682
100	2.2	0.69	0.97	2.23	0.19	2.04	4979.20	6727.38	3252
110	2	0.63	0.88	2.23	0.19	2.04	4979.20	7338.96	2640

5 YEAR DETENTION CALCULATION

Drainage Area (Ac)	Offsite Rate A3 Developed	Offsite Rate A3 Undeveloped	Pre Rate A3 & A4	Pond Bypass Rate A4+A5
0.35	0.35	1.26	1.1	0.03
Comp C-Factor	0.90	0.35	0.35	0.9

Duration Time (min)	Intensity for 5 yr storm (in/hr)	Offsite Rate A3 Developed (cfs)	Offsite Rate A3 Undeveloped (cfs)	Pre Rate A3 & A4 (cfs)	Pond Bypass Rate A4 (cfs)	Outflow Allowed (cfs)	Inflow (cf)	Outflow (cf)	Required Storage (cf)
10	6.2	1.95	2.73	1.89	0.17	1.72	2812.32	1031.46	1781
20	4.9	1.54	2.16	1.89	0.17	1.72	2245.28	1547.19	2898
30	4	1.26	1.76	1.89	0.17	1.72	1543.20	2062.92	3380
40	3.4	1.07	1.50	1.89	0.17	1.72	918.56	2578.65	3500
50	2.9	0.91	1.28	1.89	0.17	1.72	657.20	3094.38	3483
60	2.5	0.79	1.10	1.89	0.17	1.72	6804.00	3610.11	3194
70	2.4	0.76	1.06	1.89	0.17	1.72	7620.48	4125.84	3495
80	2.2	0.69	0.97	1.89	0.17	1.72	7983.36	4641.57	3342
90	2	0.63	0.88	1.89	0.17	1.72	8164.80	5157.30	3008
100	1.8	0.57	0.79	1.89	0.17	1.72	8164.80	5673.03	2492
110	1.6	0.50	0.71	1.89	0.17	1.72	7983.36	6188.76	1795

GENERAL DRAINAGE NOTES

- AREA B DRAINS TO THE INLET ON THE NORTH SIDE OF 276. THIS DRAINAGE AREA LIES IN THE ATMOSPHERIC EASEMENT AND CANNOT BE USED FOR DETENTION. AREA A IS OVER DETAINING FOR THIS POST DEVELOPED AREA.
- THE NORTH DETENTION POND WAS DESIGNED FOR THE DEVELOPMENT OF THE ACCESS DRIVES TO THE NORTH AND EAST OF THE 7-ELEVEN LOT. THIS POND WAS NOT DESIGNED FOR DEVELOPED CONDITIONS FOR BASIN A3. WHEN FUTURE DEVELOPMENT OCCURS THIS POND WILL NEED TO BE ADJUSTED TO ACCOUNT FOR THE ADDITIONAL STORMWATER RUNOFF.

GENERAL GRADING NOTES

- ALL STORM PIPE MATERIAL SHALL COMPLY WITH LOCAL REGULATIONS.
- CONTRACTOR SHALL INSURE THAT ALL STORM PIPE CONNECTIONS ARE WATER TIGHT.
- ALL STORM SEWER STRUCTURES PLACED IN A PAVED AREA SHALL BE FLUSH WITH FINISH GRADE AND SHALL HAVE A TRAFFIC BEARING FRAME AND LID. ALL STORM SEWER STRUCTURES PLACED IN UNPAVED AREAS SHALL BE 6 INCHES ABOVE FINISH GRADE, UNLESS OTHERWISE NOTED.
- CONTRACTOR SHALL ENSURE POSITIVE DRAINAGE AWAY FROM BUILDINGS FOR PAVED AND UNPAVED AREAS.
- ALL STORM STRUCTURES SHALL HAVE A UNIFORM SMOOTH POURED MORTAR SLOPE FROM INVERT IN TO INVERT OUT.
- ALL STORM SEWER TRENCHING AND BEDDING SHALL BE PER NCTCOG 3RD EDITION AND ROCKWALL STANDARDS.
- ALL FILL TO BE COMPACTED TO MIN OF 95% STANDARD DENSITY USING A SHEEPS FOOT ROLLER.
- ALL STORM STRUCTURES TO BE MIN 4,000 PSI WITH A 5.5 GACK MIX MINIMUM.
- ALL DETENTION TO BE INSTALLED AND FUNCTIONING AS DESIGNED PRIOR TO ANY PAVING. FOR ABOVE GROUND DETENTION THE SIDES AND BOTTOM MUST HAVE SOD OR ANCHORED CURLEX PRIOR TO PAVING.

NOTES

- 1IN. SAWCUT LINE/MATCH EXISTING ELEVATIONS. MINIMUM 2 FEET. LONGITUDINAL BUTT JOINT AT 12"
- 2IN. CONNECT TO EXISTING CURB INLET
- 3IN. CONNECT TO EXISTING UNDERGROUND CMP STORAGE
- 4IN. ADS FLARED END SECTION SEE DETAIL SHEET C7.1 FOR SPECIFICATIONS
- 5" CURB CUT
- 6IN. 5" CURB INLET AND OUTFALL STRUCTURE SHALL SHARE A COMMON WALL WITH A 12" ORIFICE TO ALLOW STORM WATER CONVEYANCE.

DETAILS

- 1D. 4x4" DROP INLET OUTFALL STRUCTURE
- 2D. 5" CURB INLET
- 3D. CONTECH CMP UNDERGROUND DETENTION
- 4D. 5" JUNCTION BOX OUTFALL STRUCTURE
- 5D. CONTECH VORTICLAREX OIL/WATER SEPARATOR

UNDERGROUND DETENTION 100 YEAR DETENTION CALCULATION

Drainage Area (Ac)	Onsite Rate A1	Pre Rate A1 & A2	Pond Bypass Rate A2
0.35	0.77	0.91	0.14
Comp C-Factor	0.90	0.35	0.9

Duration Time (min)	Intensity for 100 yr storm (in/hr)	Onsite Rate A1 (cfs)	Pre Rate A1 & A2 (cfs)	Pond Bypass Rate A2 (cfs)	Outflow Allowed (cfs)	Inflow (cf)	Outflow (cf)	Required Storage (cf)
10	9.8	6.79	2.64	1.23	1.41	4074.84	845.25	3320
20	8.3	5.75	2.64	1.23	1.41	3402.28	1267.88	5634
30	6.9	4.78	2.64	1.23	1.41	2807.06	1690.50	6917
40	5.8	4.02	2.64	1.23	1.41	2266.56	2113.23	7533
50	5	3.47	2.64	1.23	1.41	1895.00	2536.75	7899
60	4.5	3.12	2.64	1.23	1.41	1526.60	2958.38	8268
70	4	2.77	2.64	1.23	1.41	1164.40	3381.00	8201
80	3.7	2.56	2.64	1.23	1.41	8079.56	3803.63	8554
90	3.5	2.41	2.64	1.23	1.41	13957.70	4226.25	8871
100	3.3	2.29	2.64	1.23	1.41	13721.40	4648.88	9073
110	2.9	2.01	2.64	1.23	1.41	13264.00	5071.50	8193

25 YEAR DETENTION CALCULATION

Drainage Area (Ac)	Onsite Rate A1	Pre Rate A1 & A2	Pond Bypass Rate A2
0.35	0.77	0.91	0.14
Comp C-Factor	0.90	0.35	0.9

Duration Time (min)	Intensity for 25 yr storm (in/hr)	Onsite Rate A1 (cfs)	Pre Rate A1 & A2 (cfs)	Pond Bypass Rate A2 (cfs)	Outflow Allowed (cfs)	Inflow (cf)	Outflow (cf)	Required Storage (cf)
10	8.3	5.75	2.10	1.05	1.06	3451.14	633.78	2817
20	6.6	4.57	2.10	1.05	1.06	2888.56	950.67	4538
30	5.5	3.81	2.10	1.05	1.06	2267.00	1267.56	5593
40	4.6	3.19	2.10	1.05	1.06	1650.72	1584.45	6266
50	4	2.77	2.10	1.05	1.06	1035.00	1901.34	6533
60	3.5	2.41	2.10	1.05	1.06	873.80	2218.23	6514
70	3.25	2.25	2.10	1.05	1.06	9454.45	2535.12	6924
80	3	2.08	2.10	1.05	1.06	9979.20	2852.01	7127
90	2.8	1.94	2.10	1.05	1.06	10079.56	3168.90	7289
100	2.4	1.66	2.10	1.05	1.06	9979.20	3485.79	6493
110	2.2	1.52	2.10	1.05	1.06	10062.36	3802.68	6260

10 YEAR DETENTION CALCULATION

Drainage Area (Ac)	Onsite Rate A1	Pre Rate A1 & A2	Pond Bypass Rate A2
0.35	0.77	0.91	0.14
Comp C-Factor	0.90	0.35	0.9

Duration Time (min)	Intensity for 10 yr storm (in/hr)	Onsite Rate A1 (cfs)	Pre Rate A1 & A2 (cfs)	Pond Bypass Rate A2 (cfs)	Outflow Allowed (cfs)	Inflow (cf)	Outflow (cf)	Required Storage (cf)
10	7.2	4.09	1.85	0.91	0.94	2993.76	564.06	2430
20	5.8	4.02	1.85	0.91	0.94	2423.28	855.09	3977
30	4.8	3.38	1.85	0.91	0.94	1987.52	1128.12	4859
40	4	2.77	1.85	0.91	0.94	1465.80	1410.15	5243
50	3.4	2.36	1.85	0.91	0.94	1068.00	1692.18	5376
60	3	2.08	1.85	0.91	0.94	835.00	1974.21	5330
70	2.9	2.01	1.85	0.91	0.94	8440.74	2256.24	6185
80	2.7	1.87	1.85	0.91	0.94	8981.28	2538.27	6443
90	2.4	1.66	1.85	0.91	0.94	8981.28	2820.30	6161
100	2.2	1.52	1.85	0.91	0.94	9147.60	3102.33	6285
110	2	1.39	1.85	0.91	0.94	9147.60	3384.36	5763


5 YEAR DETENTION CALCULATION

Drainage Area (Ac)	Onsite Rate A1	Pre Rate A1 & A2	Pond Bypass Rate A2
0.35	0.77	0.91	0.14
Comp C-Factor	0.90	0.35	0.9



Duration Time (min)	Intensity for 5 yr storm (in/hr)	Onsite Rate A1 (cfs)	Pre Rate A1 & A2 (cfs)	Pond Bypass Rate A2 (cfs)	Outflow Allowed (cfs)	Inflow (cf)	Outflow (cf)	Required Storage (cf)
10	6.2	4.30	1.56	0.78	0.78	2577.96	467.67	2110
20	4.9	3.40	1.56	0.78	0.78	2074.84	701.51	3373
30	4	2.77	1.56	0.78	0.78	1495.00	935.34	4054
40	3.4	2.36	1.56	0.78	0.78	956.88	1169.18	4486
50	2.9	2.01	1.56	0.78	0.78	6009.10	1403.01	4626
60	2.5	1.73	1.56	0.78	0.78	6377.00	1636.85	4600
70	2.4	1.66	1.56	0.78	0.78	6865.44	1870.58	

Feb04.2013 11:28am - User: nick.jennett
 J:\2011 Projects\11-99009 Rockwall, TX Hwy 276\Civil\Drawings\Rev-8 (01-31-13) Record Drawings\11-99009 PROJ.dwg

Cambridge Companies
 Volume-99 Page-1022

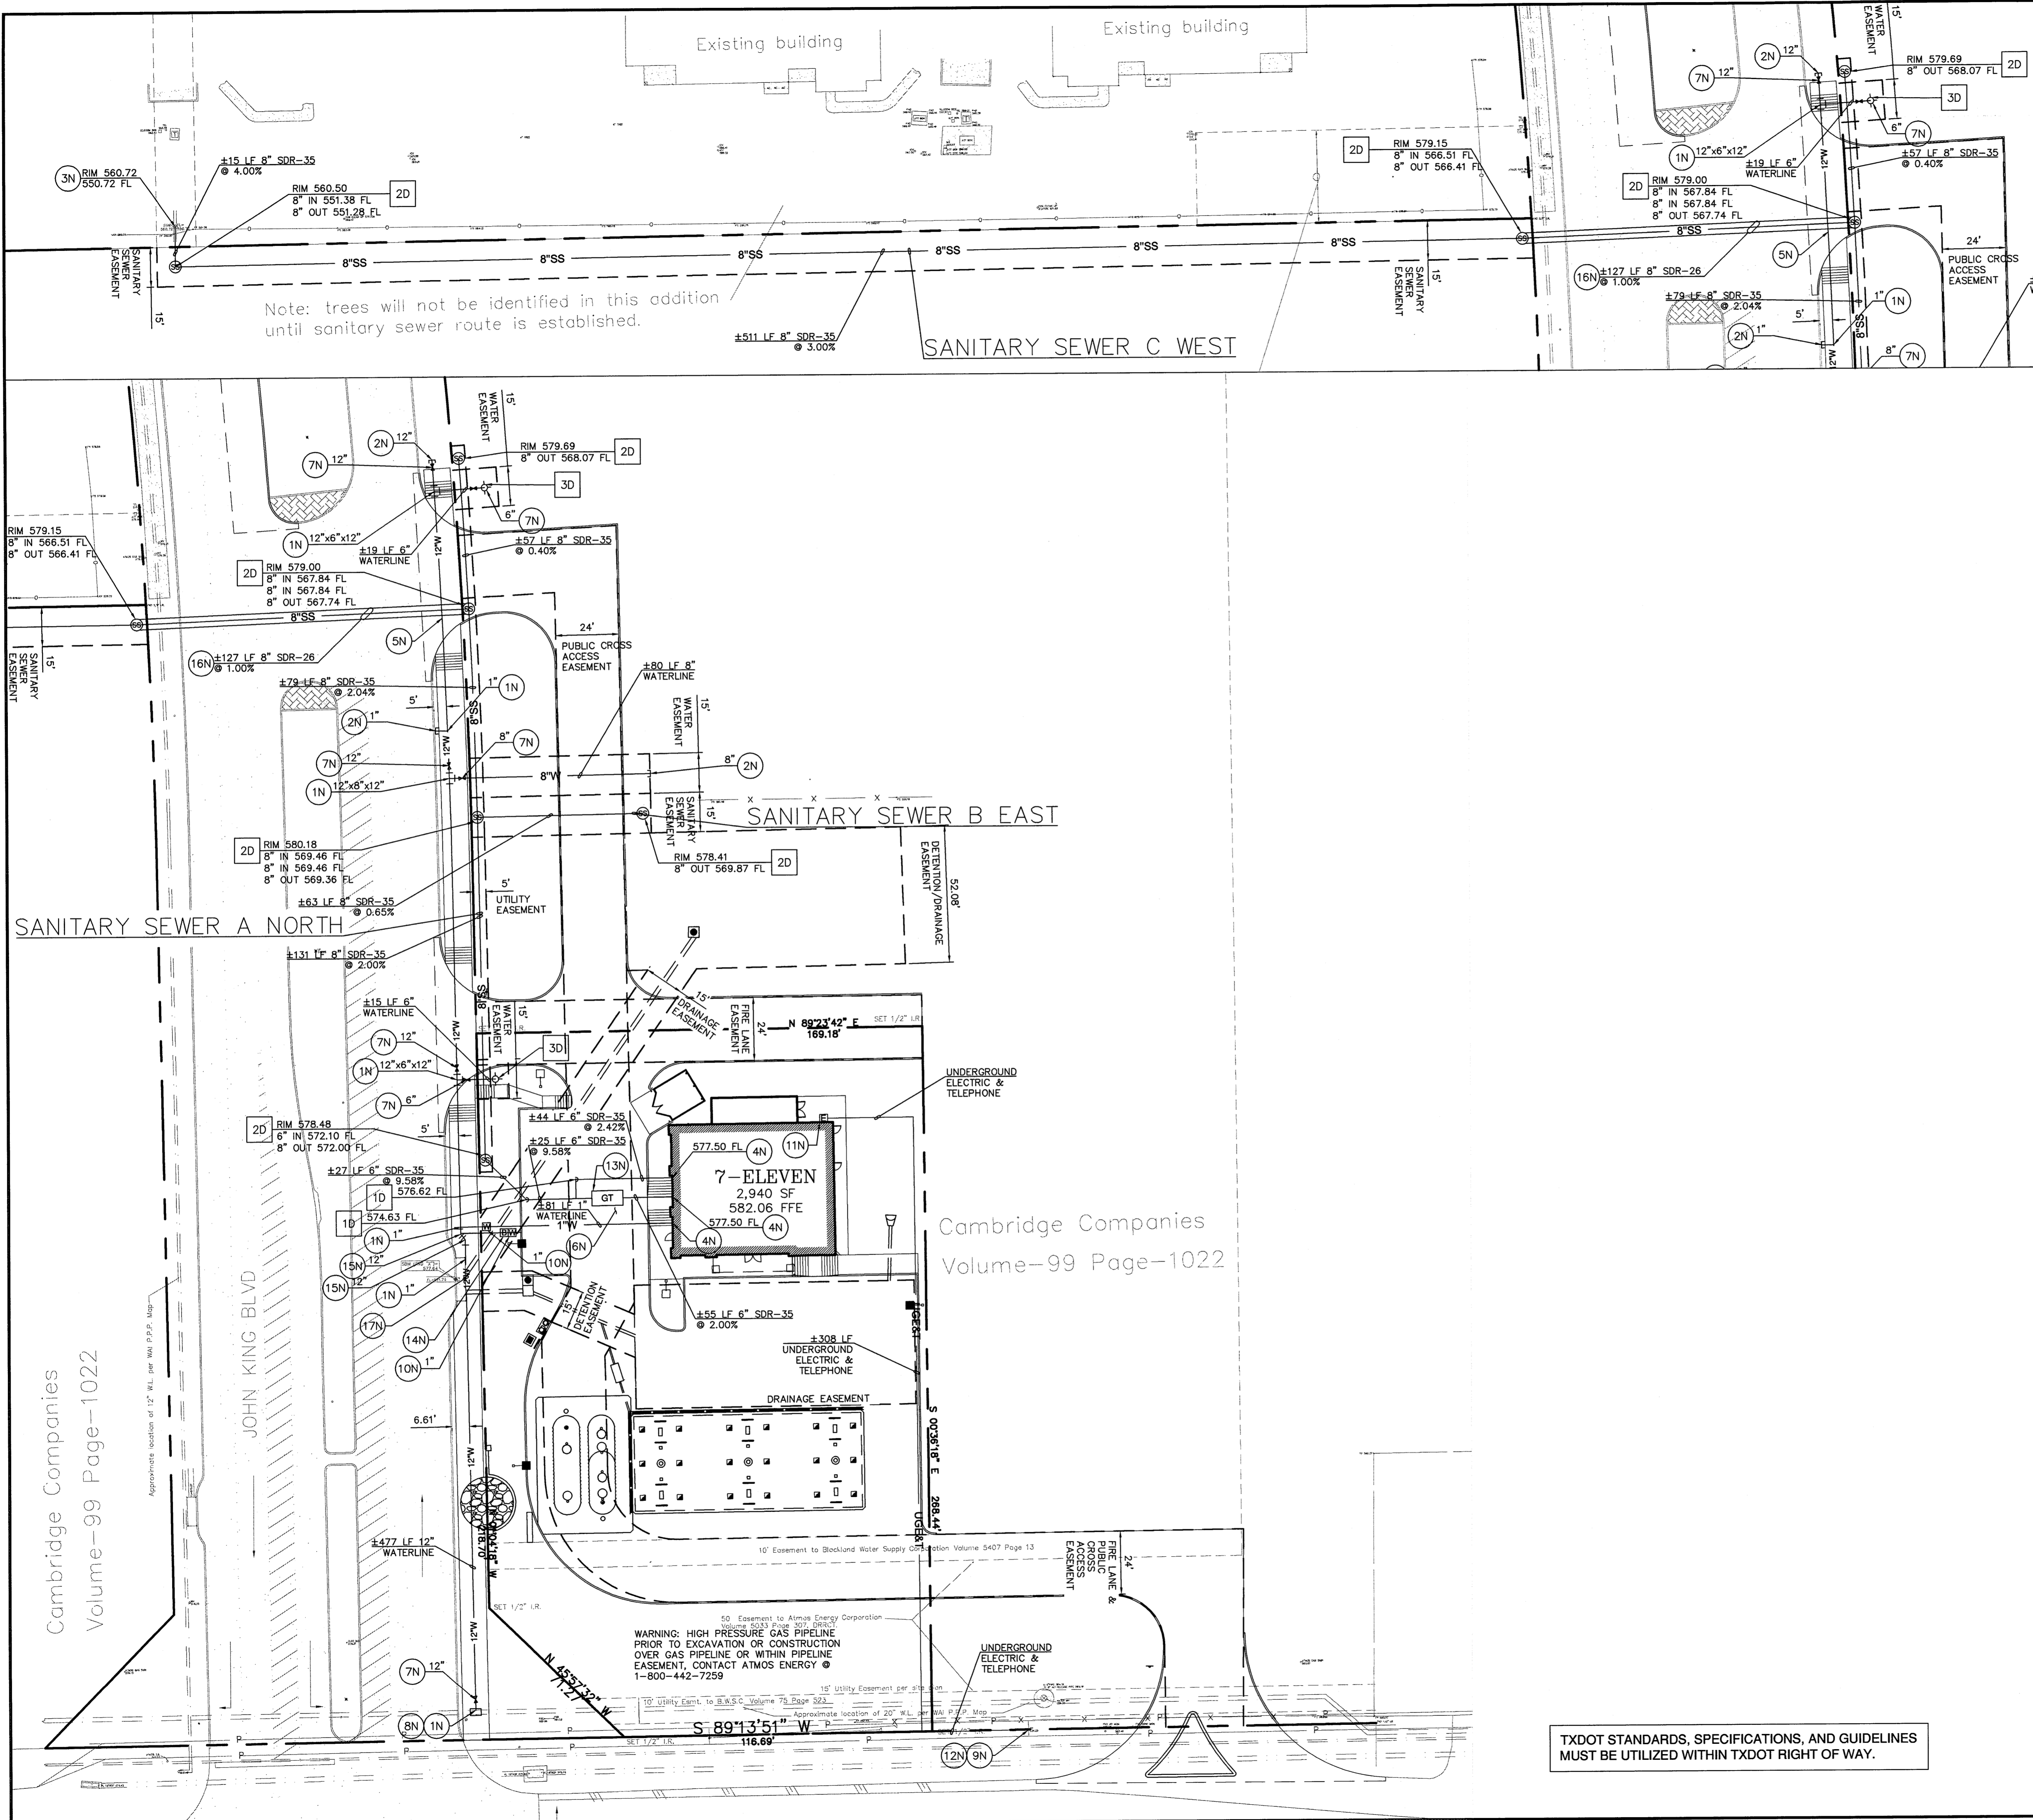

Note: trees will not be identified in this addition until sanitary sewer route is established.

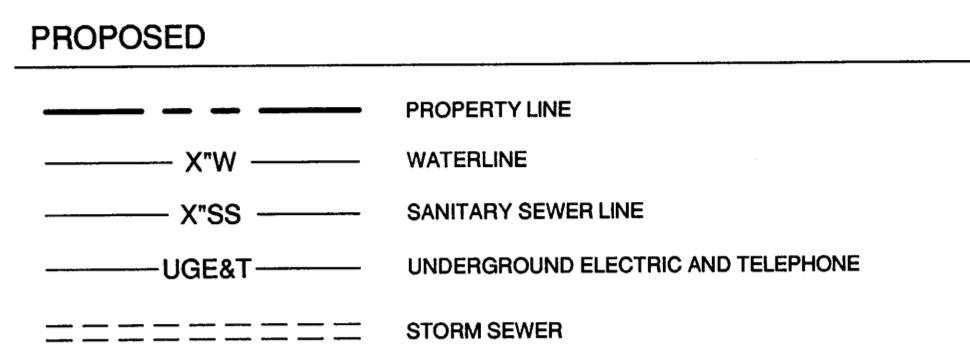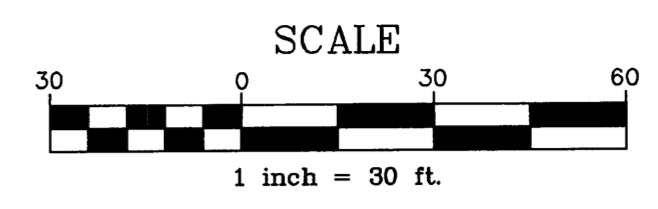

- GENERAL UTILITY NOTES**
- CONTRACTOR SHALL PROTECT ALL EXISTING UTILITIES AND IS RESPONSIBLE TO REPAIR ANY DAMAGE TO EXISTING UTILITIES AND ADJUSTMENTS DUE TO CHANGE IN GRADE OF ALL EXISTING UTILITIES, INCLUDING DRAINAGE, DURING CONSTRUCTION AT NO COST TO THE OWNER.
 - ALL UTILITIES ARE SHOWN FROM INFORMATION GATHERED AND SHOULD NOT BE USED AS EXACT. CONTRACTOR SHALL VERIFY EXACT DEPTHS AND LOCATIONS PRIOR TO UTILITY INSTALLATION.
 - CONTRACTOR SHALL CONTACT THE APPROPRIATE UTILITY COMPANY FOR INSTALLATION AND SPECIFICATION REQUIREMENTS.
 - ALL PIPE MATERIALS SHALL COMPLY WITH LOCAL REGULATIONS.
 - ALL TRENCHING AND BEDDING SHALL BE PER THE UTILITY TRENCH AND BEDDING DETAIL.
 - CONTRACTOR SHALL REFER TO ARCHITECTURAL PLANS FOR ALL BUILDING UTILITY TIE INS.
 - ALL THRUST BLOCKING SHALL BE PER NCTCOG 3RD EDITION AND ROCKWALL STANDARDS.
 - WATER LINES CROSSING THE ATMOS EASEMENT WILL NEED TO BE PLACED AT LEAST 2 FEET BELOW THE TRANSMISSION LINE.
 - ALL WATER LINES SHALL BE CLASS 200
 - ALL DOMESTIC AND IRRIGATION TAPS TO HAVE BACKFLOW WITH DOUBLE CHECKS AT ALL METERS.
 - ALL MANHOLES TO BE RAVEN LINED OR APPROVED EQUAL.
 - INSTALL BLUE EMS DISKS ON THE WATER LINE AT EVERY CHANGE IN DIRECTION, VALVE, FIRE HYDRANT, OR SERVICE.
 - INSTALL GREEN EMS DISKS ON THE SANITARY SEWER LINE AT EVERY CHANGE IN DIRECTION, MANHOLE, CLEANOUT, AND SERVICE CONNECTION.
 - RIM ELEVATIONS FOR SANITARY SEWER MANHOLES TO THE WEST OF JOHN KING BLVD SHALL BE FIELD VERIFIED TO WORK WITH EXISTING GRADES. TOPOGRAPHIC INFORMATION WAS NOT DETERMINED IN THIS AREA AND RIM ELEVATIONS HAVE BEEN ESTIMATED.

- NOTES**
- M.J. TEE
 - CAP AND PLUG
 - CONNECT TO EXISTING MANHOLE
 - CONNECT TO BUILDING PER MEP PLANS
 - MAINTAIN 24" VERTICAL SEPARATION
 - MAINTAIN 10' HORIZONTAL SEPARATION
 - GATE VALVE
 - CONNECT TO EXISTING 20" WATER LINE WITH TAPPING SLEEVE PER CITY OF ROCKWALL
 - CONNECT TO EXISTING ELECTRICAL SERVICE PER ONCOR
 - 1" WATER METER PER CITY OF ROCKWALL
 - ELECTRIC METER PER ONCOR
 - CONNECT TO EXISTING TELEPHONE SERVICE PER VERIZON
 - GREASE TRAP PER MECHANICAL PLANS
 - BACKFLOW PREVENTER PER IRRIGATION PLAN, SEE SHEET C6.0
 - 45° BEND SEE PLAN FOR SIZE
 - DIRECTIONAL BORE PER THE CITY OF ROCKWALL
 - CONCRETE ENCASE WATER PIPE TO 10 FEET ON BOTH SIDES OF STORM SEWER CROSSING.

- DETAILS**
- CLEANOUT PER NCTCOG 3RD EDITION AND ROCKWALL STANDARDS
 - 5" SANITARY SEWER MANHOLE PER NCTCOG 3RD EDITION AND ROCKWALL STANDARDS
 - FIRE HYDRANT

TXDOT STANDARDS, SPECIFICATIONS, AND GUIDELINES MUST BE UTILIZED WITHIN TXDOT RIGHT OF WAY.

HFA
 ARCHITECTS
 ENGINEERS
 INTERIORS

HARRISON FRENCH & ASSOCIATES, LTD.
 809 S.W. A Street, Suite 201
 Bentonville, Arkansas 72712
 t 479.273.7780
 f 479.273.9436
 www.hfa-ac.com

STIPULATION FOR REUSE
 THIS DRAWING WAS PREPARED FOR USE ON A SPECIFIC SITE AT A SPECIFIC TIME AND DATE AND IS NOT TO BE REUSED OR REPRODUCED IN ANY MANNER WITHOUT THE WRITTEN CONSENT OF HFA. ANY REUSE OF THIS DRAWING FOR ANY OTHER PROJECT WITHOUT THE WRITTEN CONSENT OF HFA IS STRICTLY PROHIBITED. THE USER OF THIS DRAWING AGREES TO HOLD HFA HARMLESS FROM AND AGAINST ALL CLAIMS, DAMAGES, LOSSES AND EXPENSES, INCLUDING REASONABLE ATTORNEY'S FEES, THAT MAY BE ASSERTED AGAINST HFA BY ANY THIRD PARTY AS A RESULT OF SUCH REUSE.

7-ELEVEN

JOHN KING BLVD & HWY 276
 ROCKWALL, TEXAS

PROJ. NUMBER: 12-11-99009

ISSUE BLOCK

NO.	DESCRIPTION	DATE

STORE NO.: 1029049
 DOCUMENT DATE: 2/1/2013
 CHECKED BY: JWK
 DRAWN BY: TAB

Verdad
 REAL ESTATE






STATE OF TEXAS
 THOMAS A. BARRY
 111978
 LICENSED PROFESSIONAL ENGINEER

TEXAS COA
 #F-8576

UTILITY PLAN
 AS-BUILT

SHEET:
C4.0

F:\04\2013\11-30\11-30.dwg - User: nicksjwett
 J:\2011 Projects\11-99009 Rockwall, TX Hwy 276\Civil\Civil Drawings\Rev-8 (01-31-13) Record Drawings\11-99009 PROJ.dwg

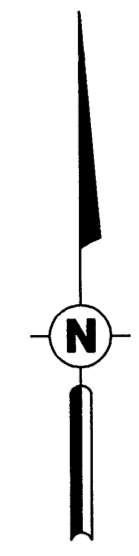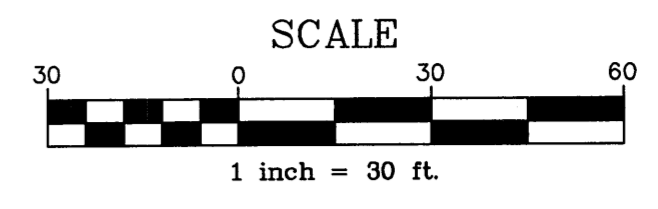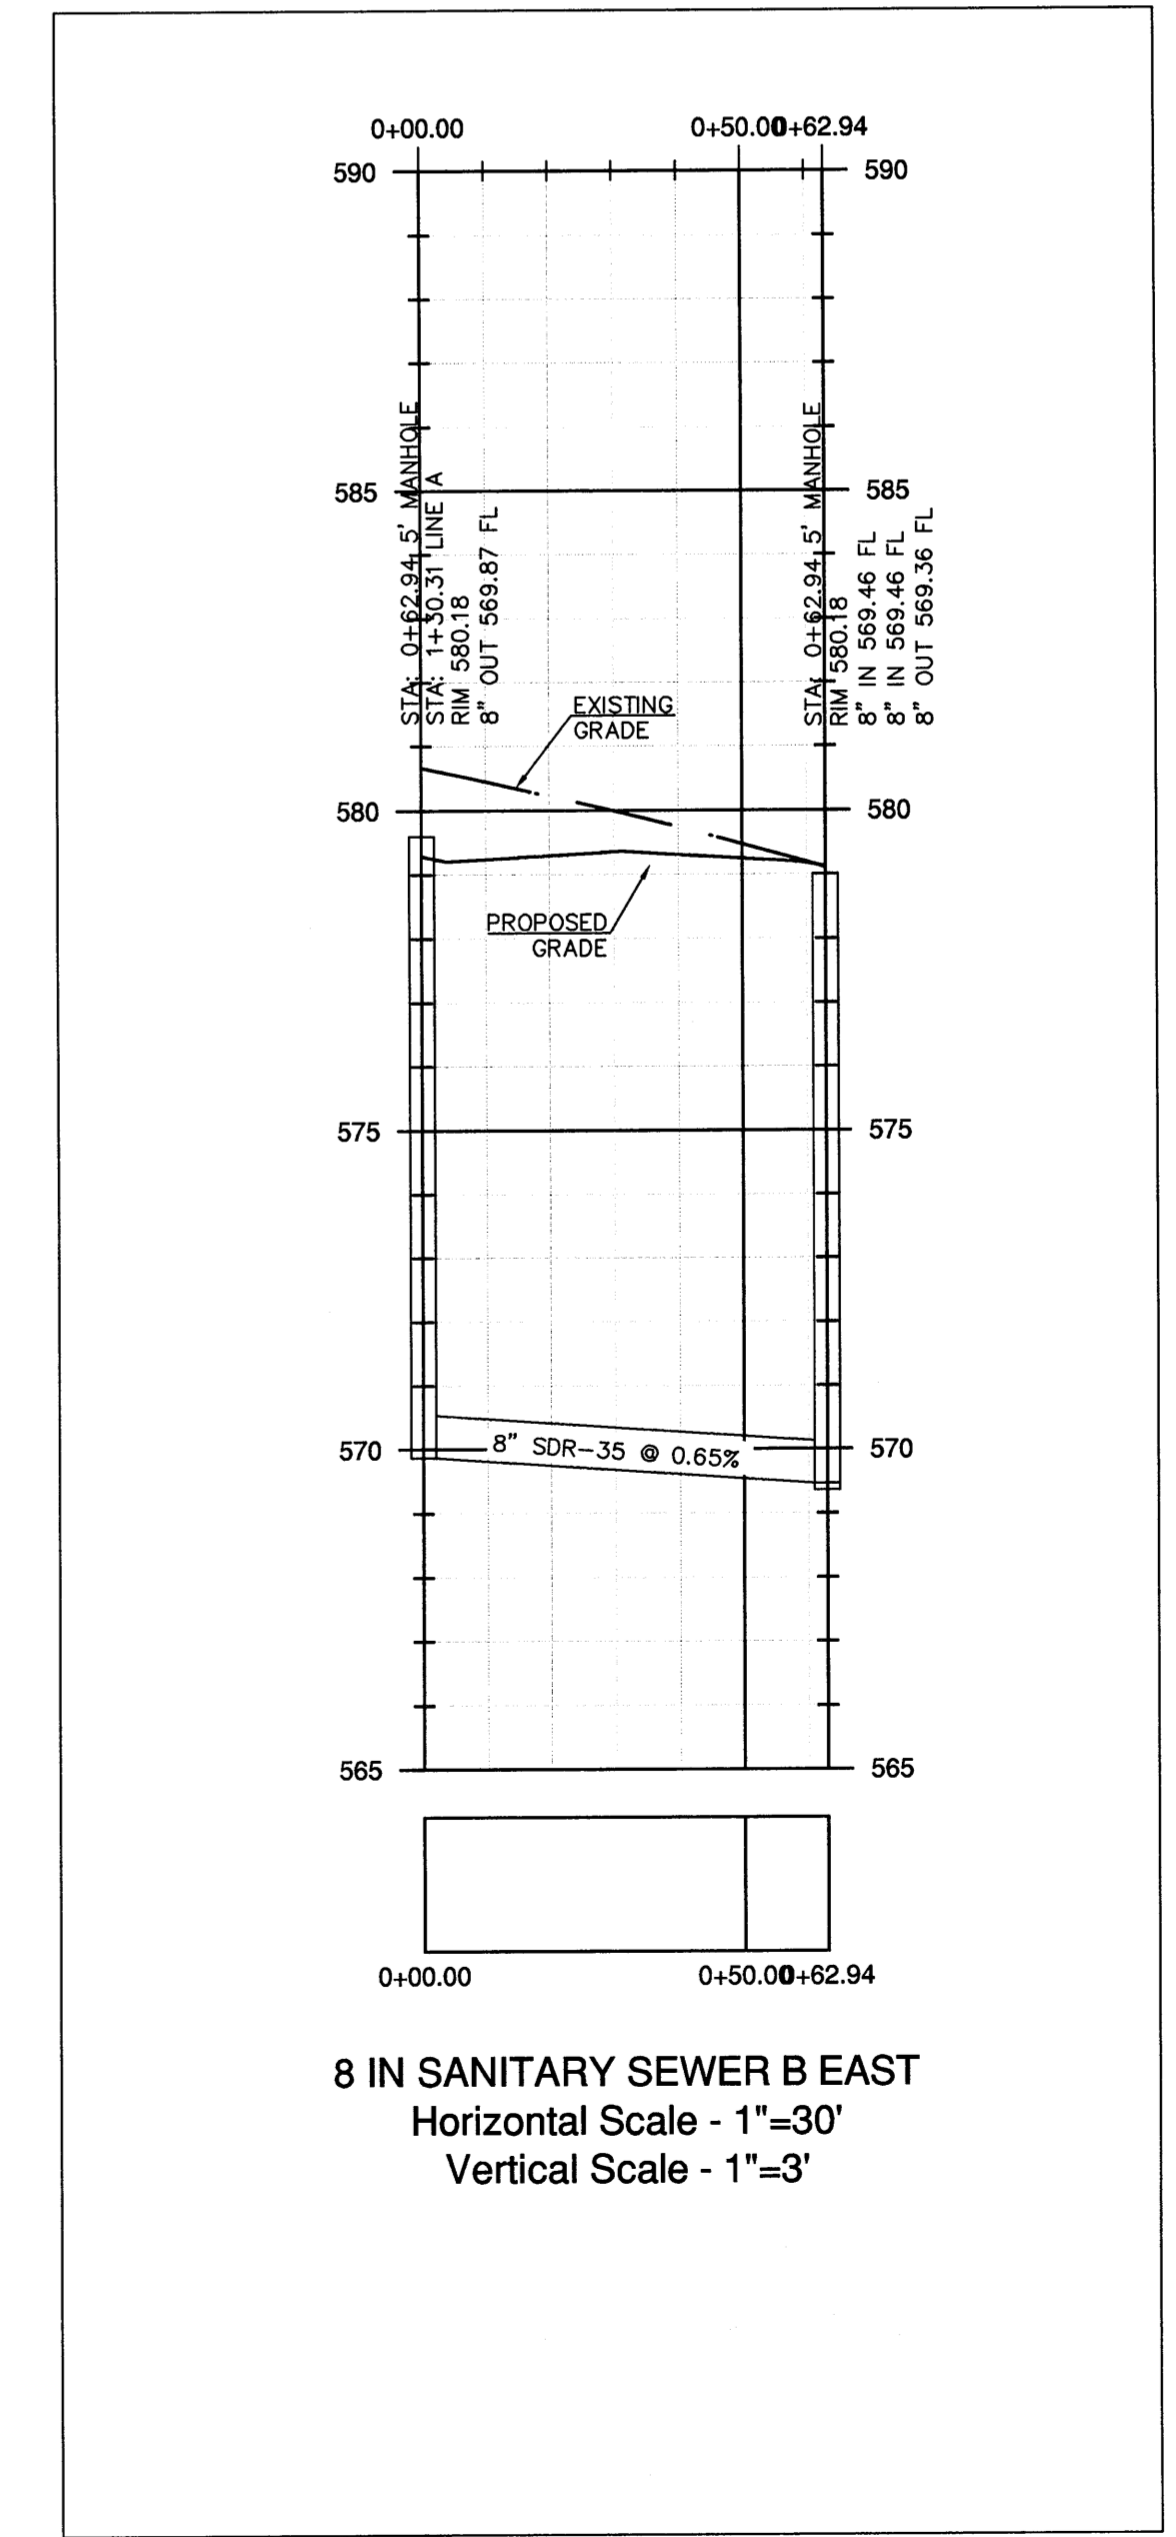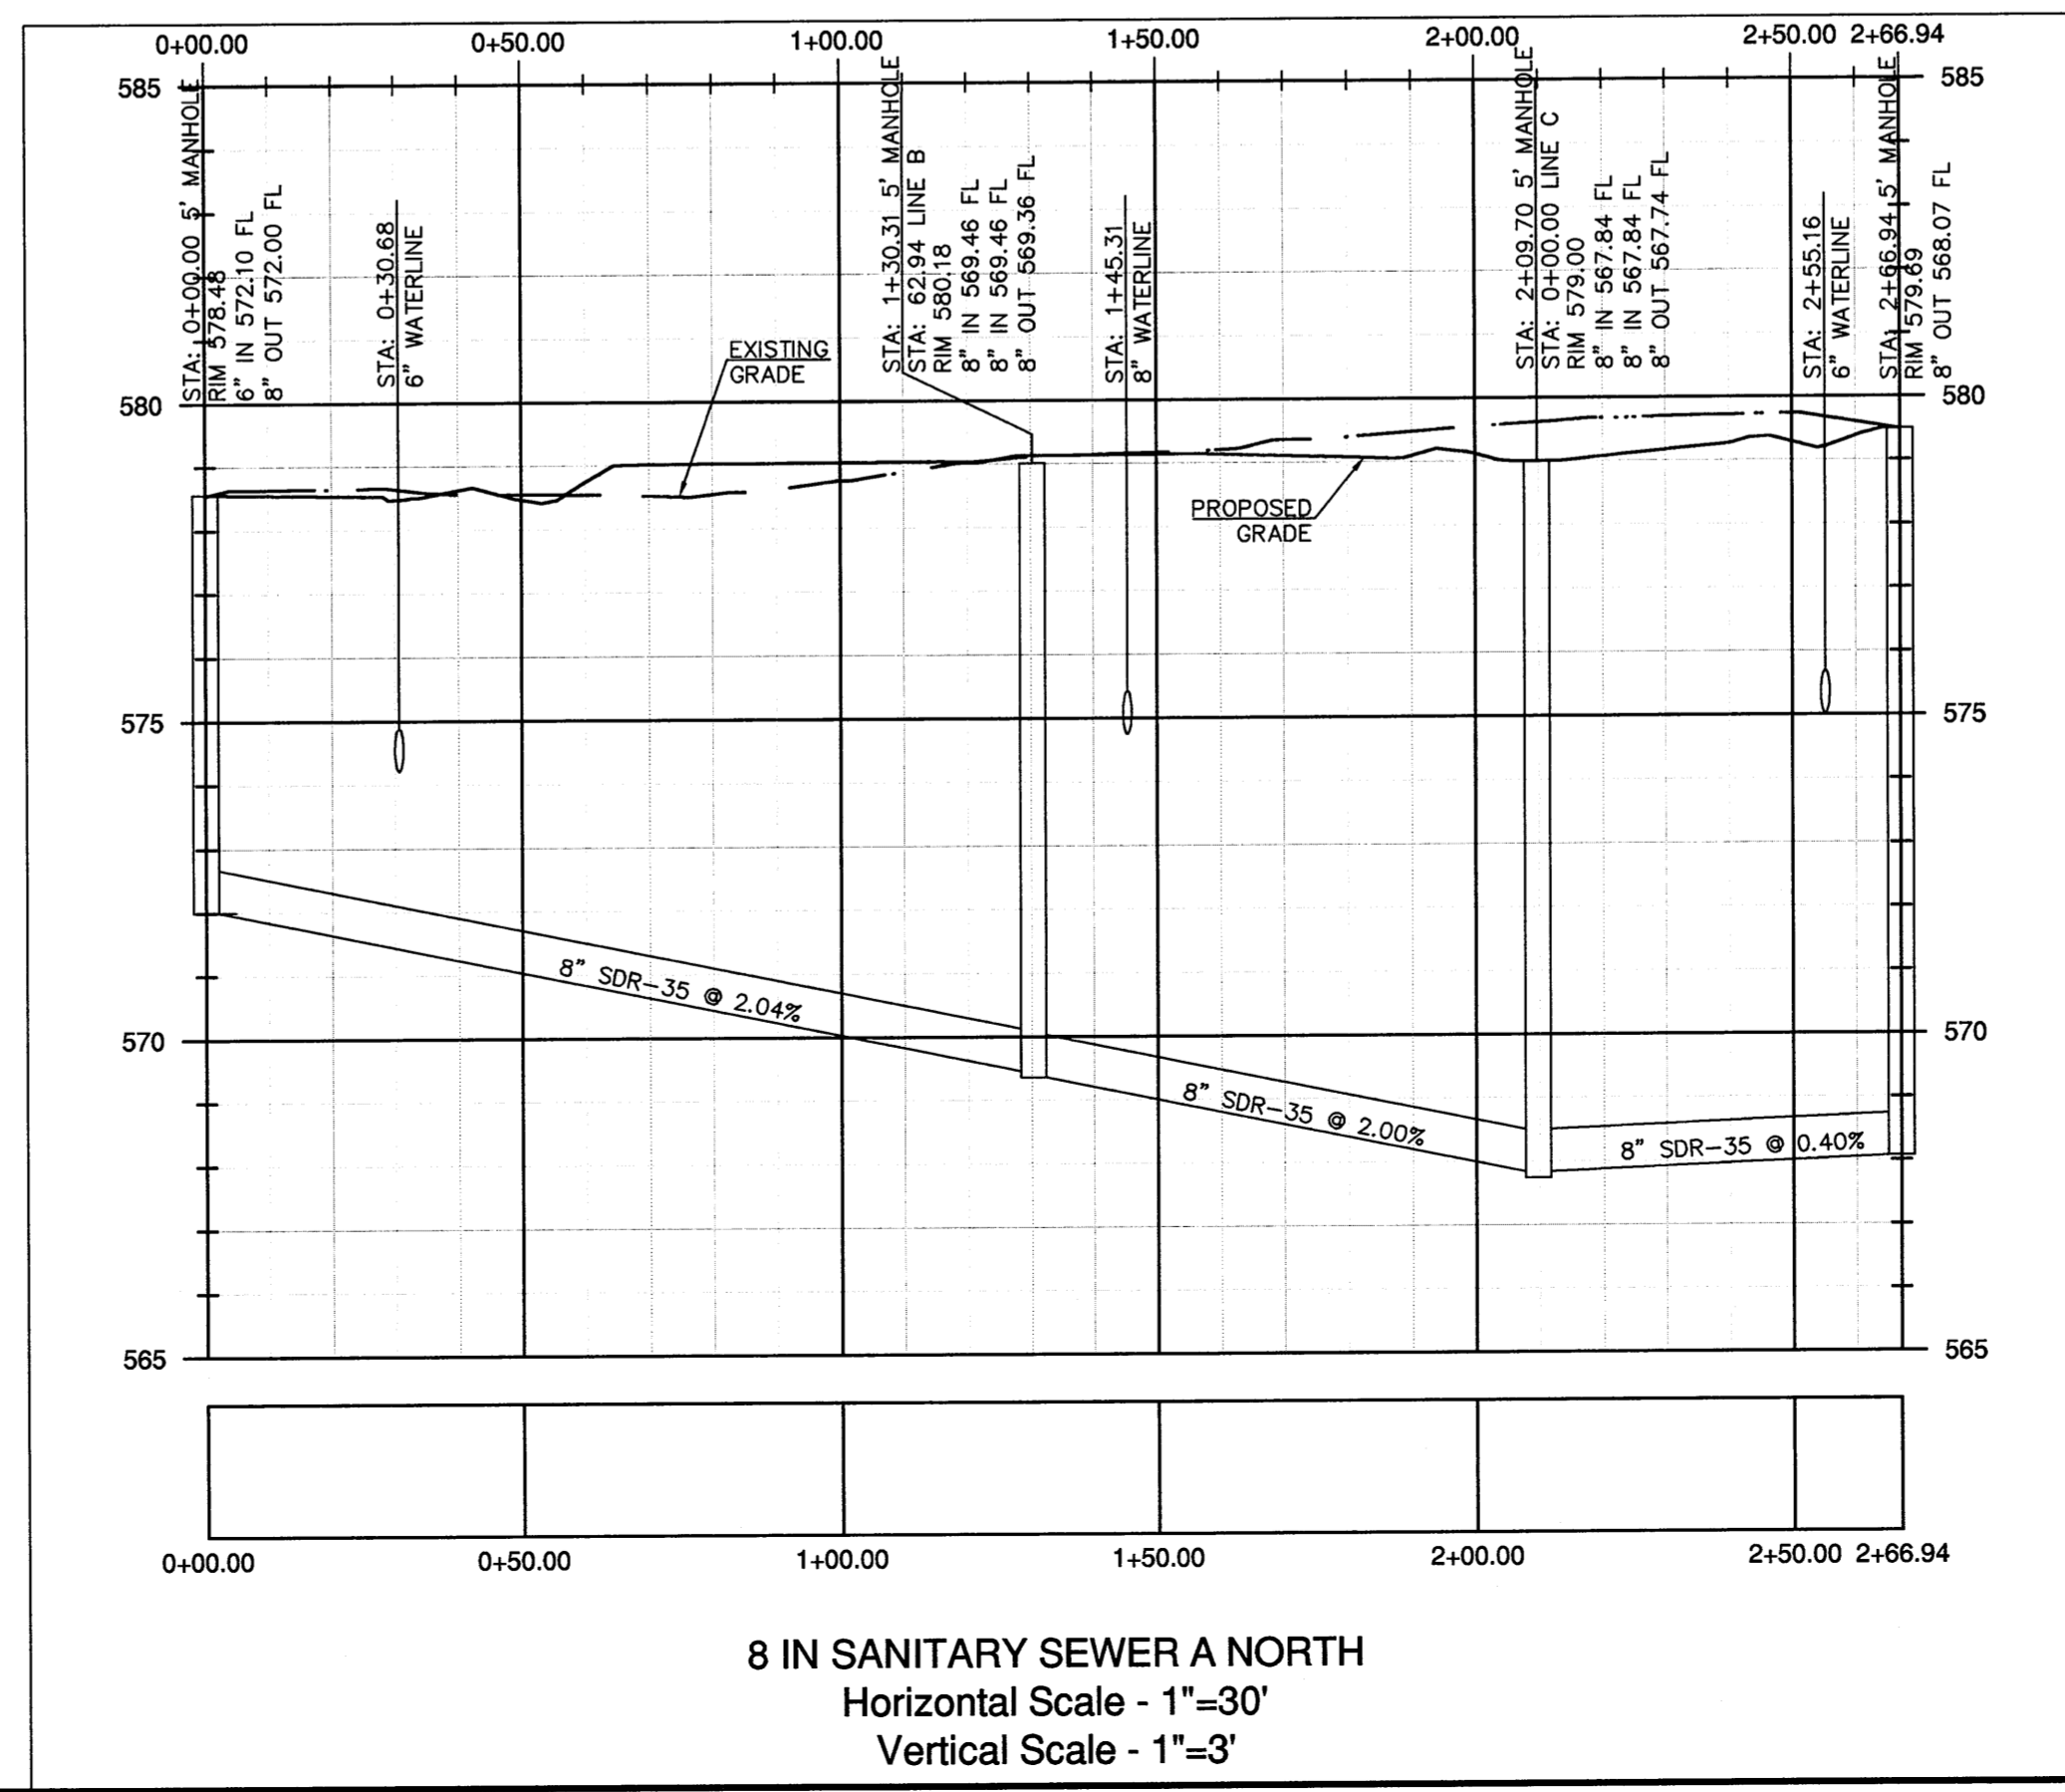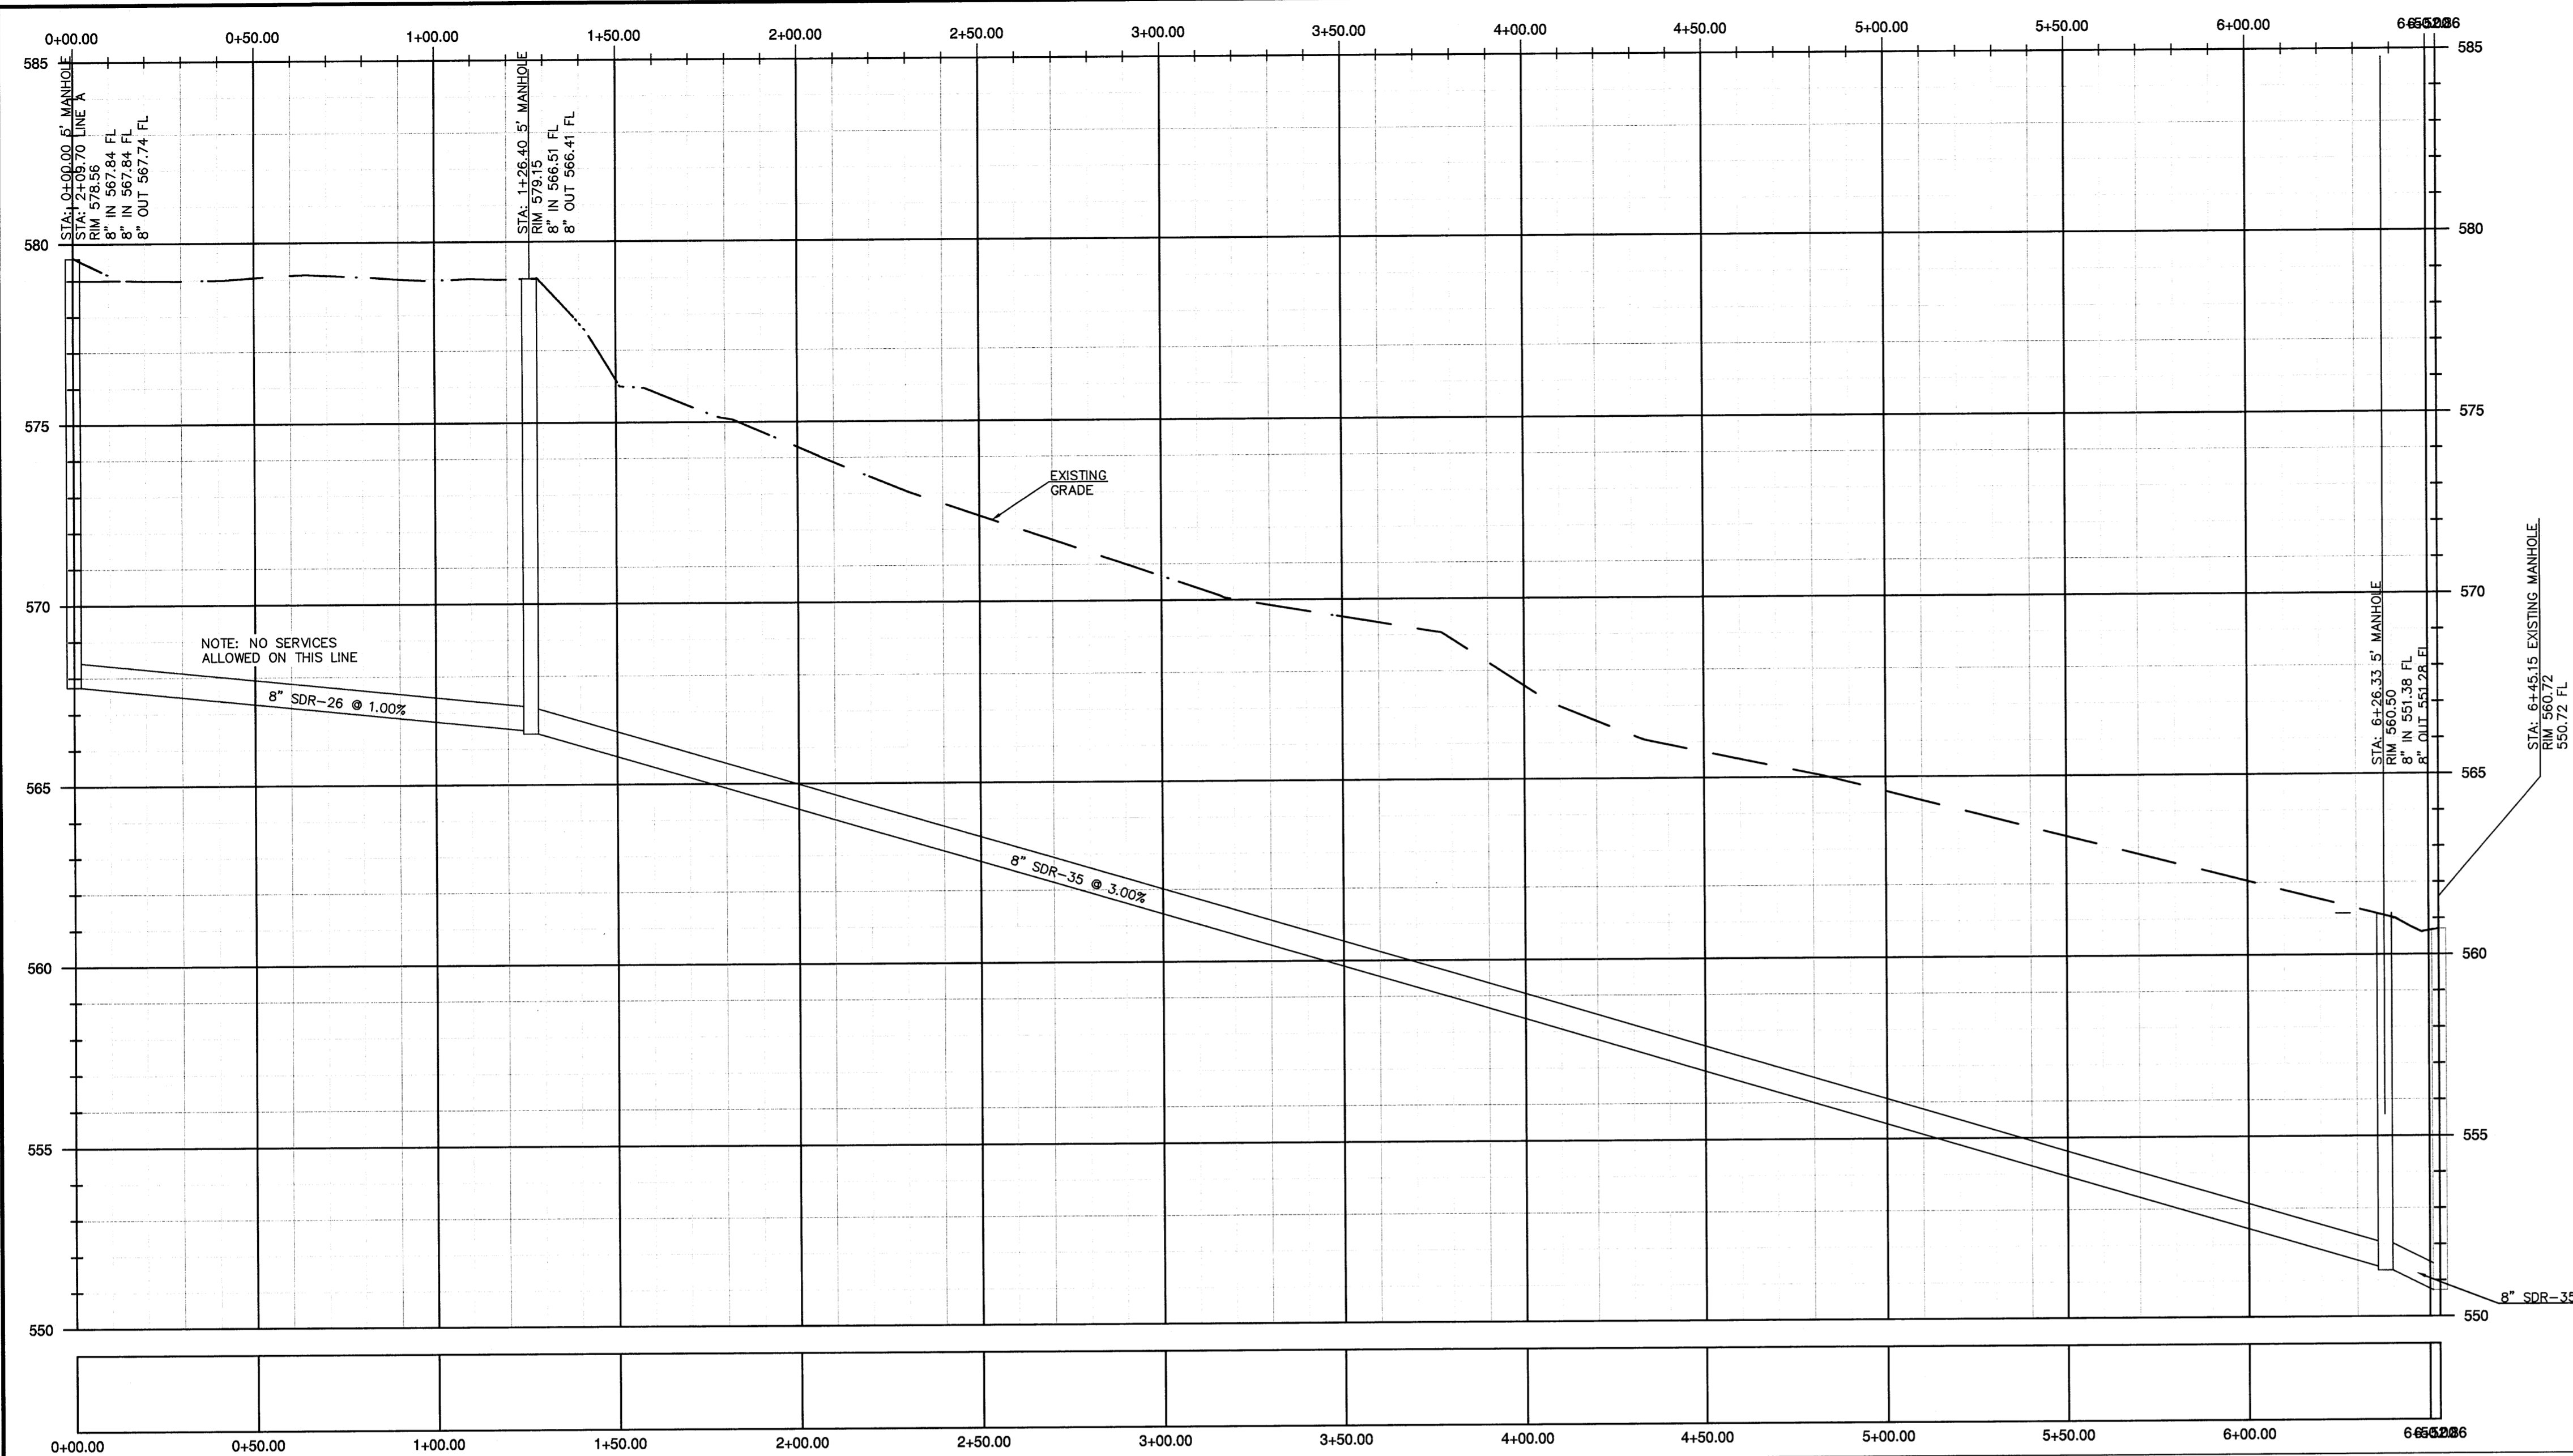

TXDOT STANDARDS, SPECIFICATIONS, AND GUIDELINES
 MUST BE UTILIZED WITHIN TXDOT RIGHT OF WAY.

HFA
 ARCHITECTS
 ENGINEERS
 INTERIORS

HARRISON FRENCH
 & ASSOCIATES, LTD

809 S.W. A Street, Suite 201
 Bentonville, Arkansas 72712
 t 479.273.7780
 f 479.273.9436
 www.hfa-ac.com

STIPULATION FOR REUSE
 THIS DRAWING WAS PREPARED FOR USE
 ON A SPECIFIC SITE. IT IS NOT TO BE
 REPRODUCED OR TRANSMITTED IN ANY
 FORM OR BY ANY MEANS, ELECTRONIC
 OR MECHANICAL, INCLUDING PHOTOCOPYING,
 RECORDING, OR BY ANY INFORMATION
 STORAGE AND RETRIEVAL SYSTEM, WITHOUT
 THE WRITTEN PERMISSION OF THE
 ENGINEER. REPRODUCTION OF THIS
 PROJECT REQUIRES THE SERVICES OF
 AN ENGINEER LICENSED IN THE STATE OF
 ARKANSAS. REPRODUCTION OF THIS
 PROJECT IS NOT AUTHORIZED AND MAY
 BE CONSIDERED A VIOLATION OF THE
 PROFESSIONAL ENGINEERING ACT.



7-ELEVEN


JOHN KING BLVD & HWY 276
 ROCKWALL, TEXAS

PROJ. NUMBER: 12-11-99009

ISSUE BLOCK

NO.	DATE	DESCRIPTION

STORE NO.: 1029049
 DOCUMENT DATE: 2/1/2013
 CHECKED BY: JWK
 DRAWN BY: TAB

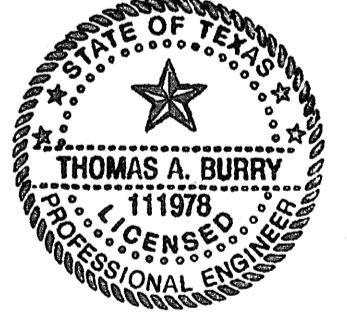

TEXAS COA
 #F-8576

SANITARY
 SEWER
 PROFILES

AS-BUILT

SHEET:
C4.1