



Feb04.2013, 12:04pm - User: nick.innett  
Projects\11-99009 - Rockwall, TX Hwy 276\Civil\Drawings\8-01-31-13 Record Drawings\11-99009 PROJ.dwg

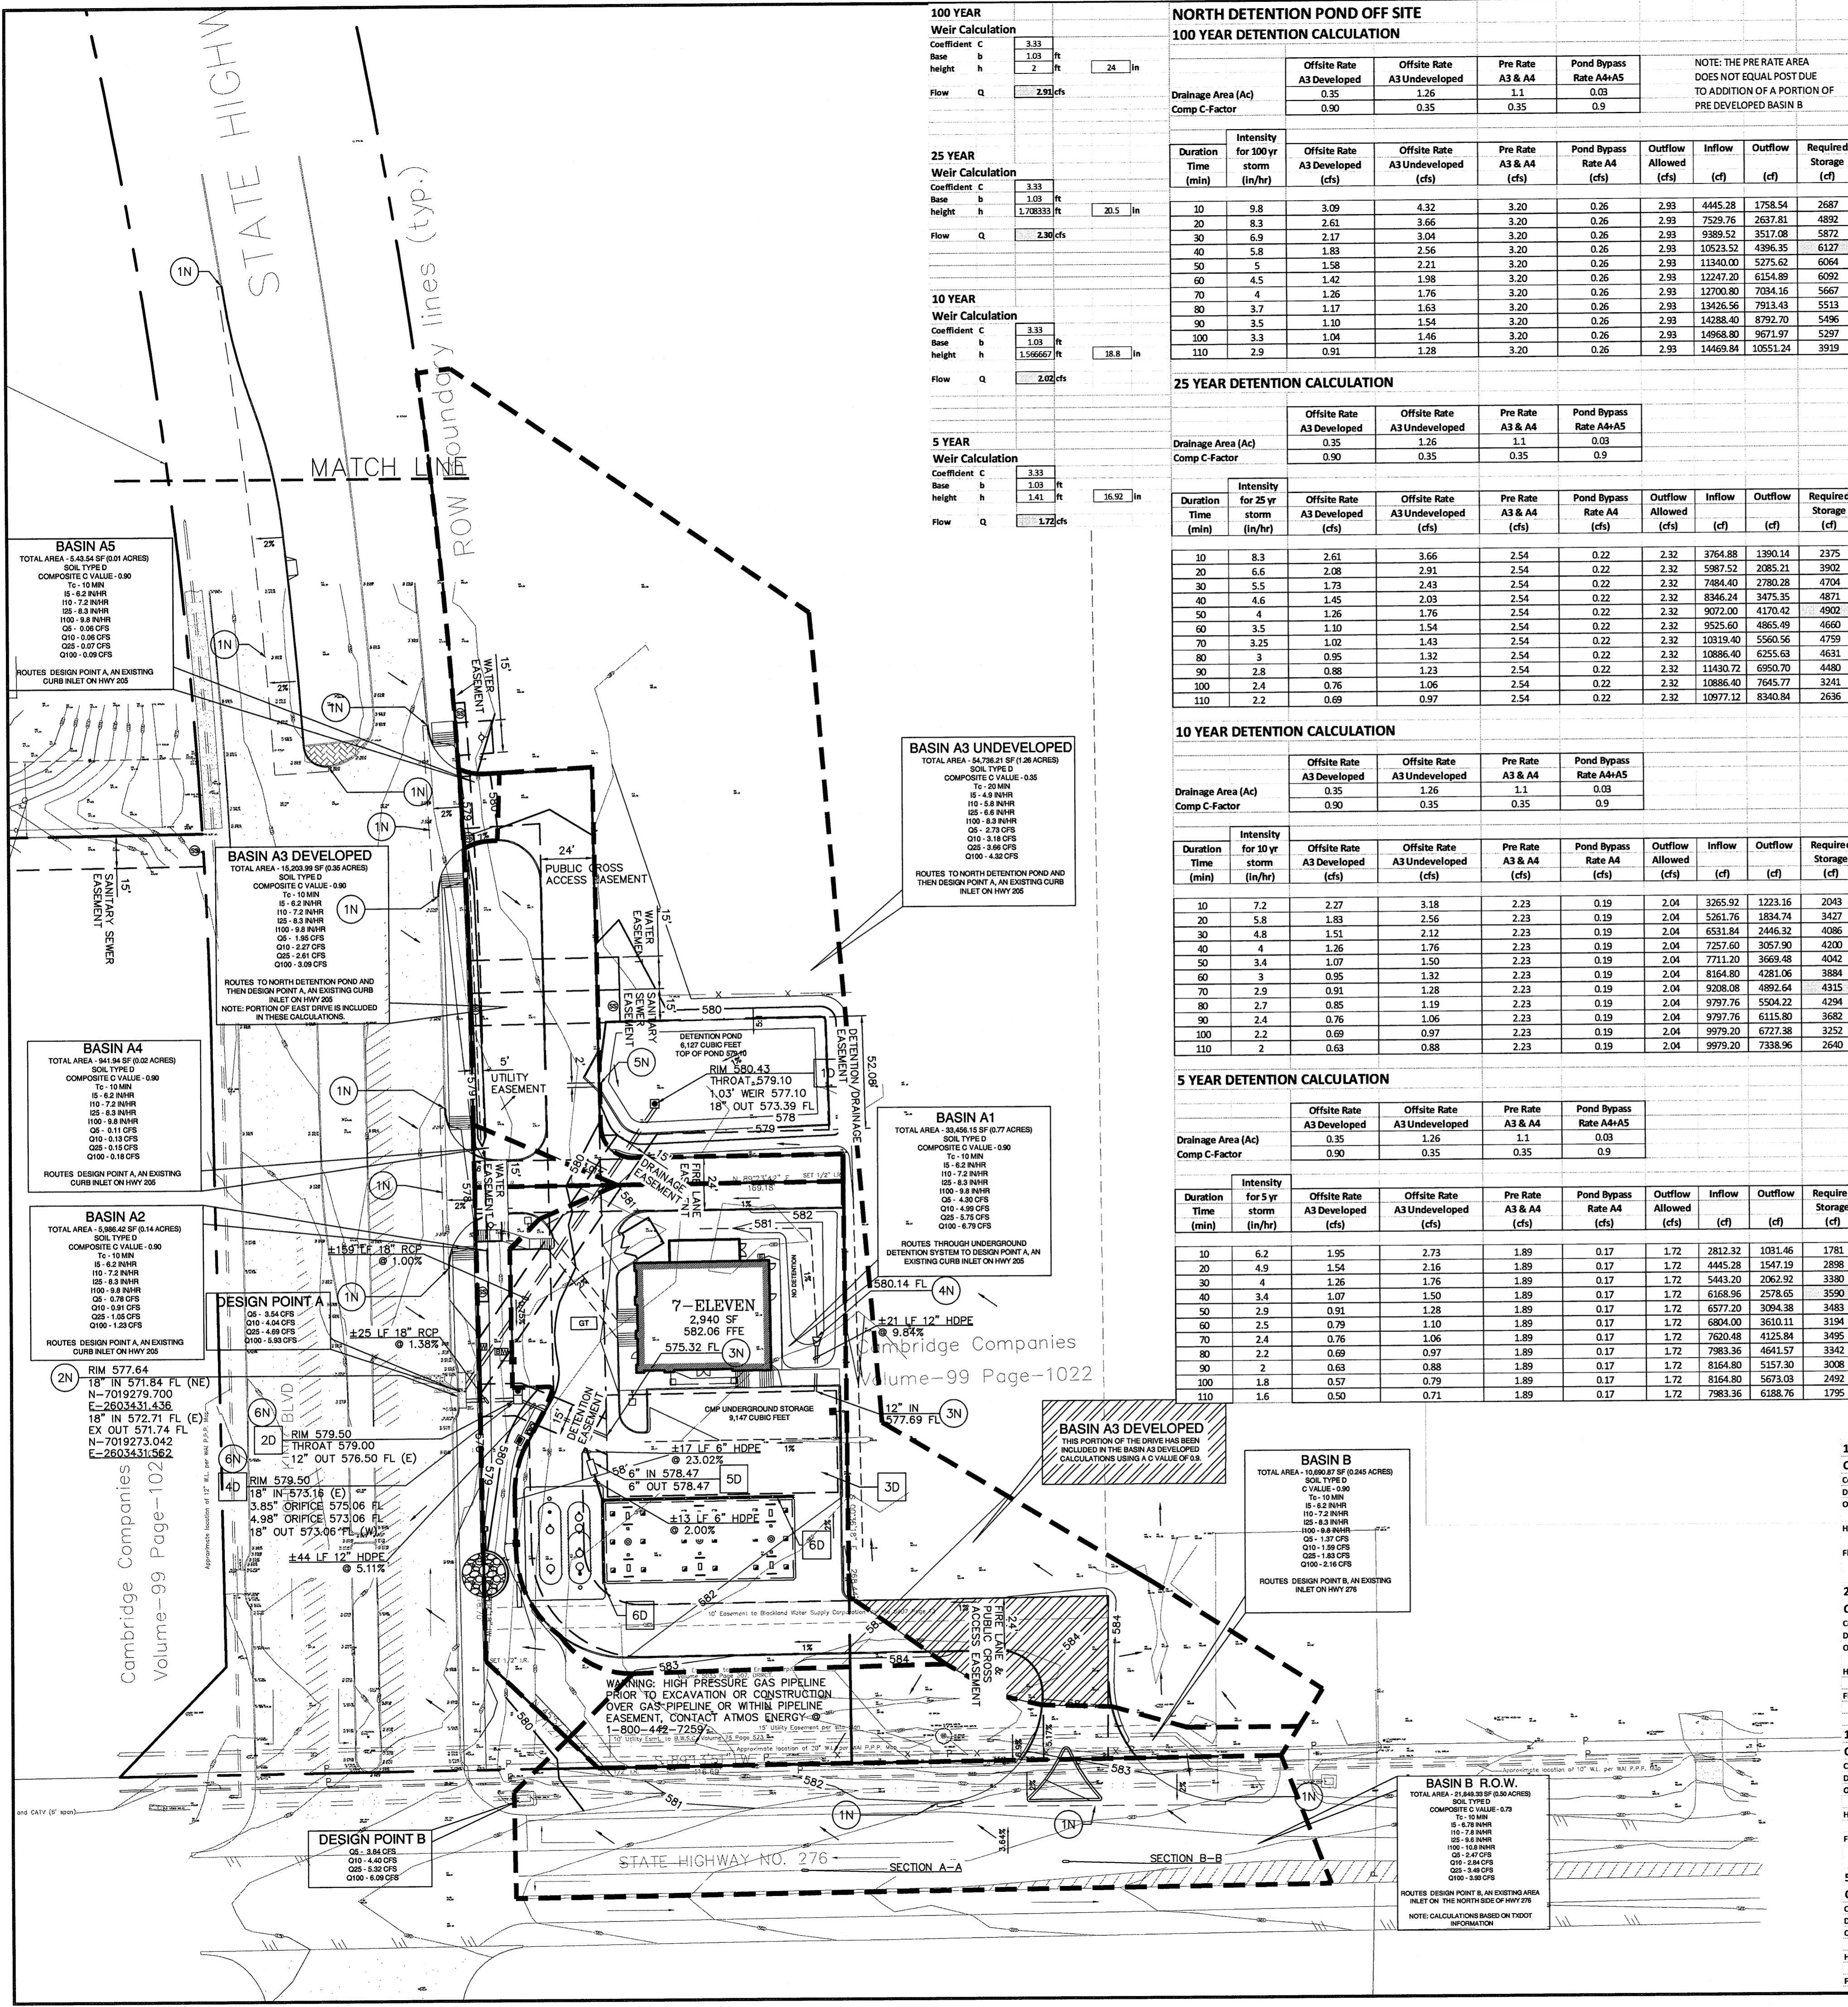

**GENERAL DRAINAGE NOTES**

- AREA B DRAINS TO THE INLET ON THE NORTH SIDE OF 276. THIS DRAINAGE AREA LIES IN THE ATMOSPHERIC ENERGY EASEMENT AND CANNOT BE USED FOR DETENTION. AREA A IS OVER DETAINING FOR THIS POST DEVELOPED AREA.
- THE NORTH DETENTION POND WAS DESIGNED FOR THE DEVELOPMENT OF THE ACCESS DRIVES TO THE NORTH AND EAST OF THE 7-ELEVEN LOT. THIS POND WAS NOT DESIGNED FOR DEVELOPED CONDITIONS FOR BASIN A3. WHEN FUTURE DEVELOPMENT OCCURS THIS POND WILL NEED TO BE ADJUSTED TO ACCOUNT FOR THE ADDITIONAL STORMWATER RUNOFF.

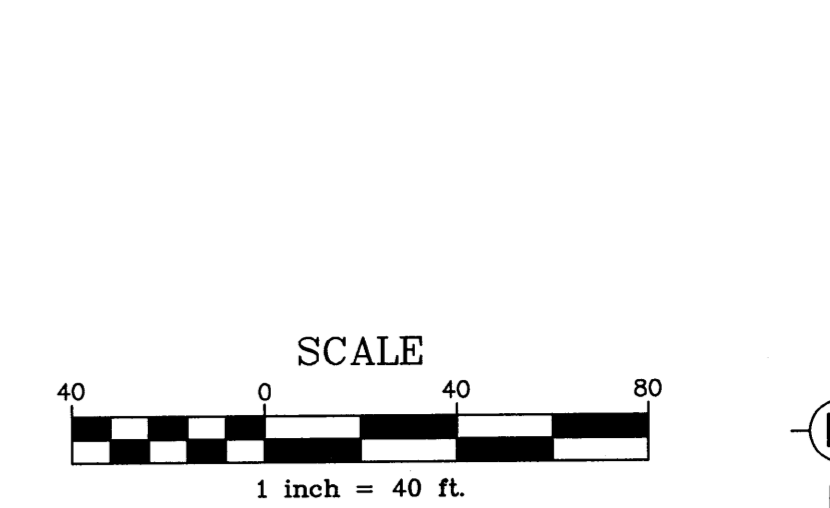

**GENERAL GRADING NOTES**

- ALL STORM PIPE MATERIAL SHALL COMPLY WITH LOCAL REGULATIONS.
- CONTRACTOR SHALL INSURE THAT ALL STORM PIPE CONNECTIONS ARE WATER TIGHT.
- ALL STORM SEWER STRUCTURES PLACED IN A PAVED AREA SHALL BE FLUSH WITH FINISH GRADE AND SHALL HAVE A TRAFFIC BEARING FRAME AND LID. ALL STORM SEWER STRUCTURES PLACED IN UNPAVED AREAS SHALL BE 6 INCHES ABOVE FINISH GRADE, UNLESS OTHERWISE NOTED.
- CONTRACTOR SHALL ENSURE POSITIVE DRAINAGE AWAY FROM BUILDINGS FOR PAVED AND UNPAVED AREAS.
- ALL STORM STRUCTURES SHALL HAVE A UNIFORM SMOOTH POURED MORTAR SLOPE FROM INVERT IN TO INVERT OUT.
- ALL STORM SEWER TRENCHING AND BEDDING SHALL BE PER NCTCOG 3RD EDITION AND ROCKWALL STANDARDS.
- ALL FILL TO BE COMPACTED TO MIN OF 95% STANDARD DENSITY USING A SHEEPS FOOT ROLLER.
- ALL STORM STRUCTURES TO BE MIN 4,000 PSI WITH A 5.6 SACK MIX MINIMUM.
- ALL DETENTION TO BE INSTALLED AND FUNCTIONING AS DESIGNED PRIOR TO ANY PAVING. FOR ABOVE GROUND DETENTION THE SIDES AND BOTTOM MUST HAVE SOD OR ANCHORED CURLEX PRIOR TO PAVING.

**NOTES**

- 1IN. SAWCUT LINE/MATCH EXISTING ELEVATIONS. MINIMUM 2 FEET. LONGITUDINAL BUTT JOINT AT 12'
- 2IN. CONNECT TO EXISTING CURB INLET
- 3IN. CONNECT TO EXISTING UNDERGROUND CMP STORAGE
- 4IN. ADS FLARED END SECTION SEE DETAIL SHEET C7.1 FOR SPECIFICATIONS
- 5' CURB CUT
- 6IN. 5' CURB INLET AND OUTFALL STRUCTURE SHALL SHARE A COMMON WALL WITH A 12" ORIFICE TO ALLOW STORM WATER CONVEYANCE.

**DETAILS**

- 1D. 4x4 DROP INLET OUTFALL STRUCTURE
- 2D. 5' CURB INLET
- 3D. CONTECH CMP UNDERGROUND DETENTION
- 4D. 5' JUNCTION BOX OUTFALL STRUCTURE
- 5D. CONTECH VORTICLAREX LIQUID WATER SEPARATOR

**NORTH DETENTION POND OFF SITE**

**100 YEAR DETENTION CALCULATION**

| Drainage Area (Ac) | Offsite Rate A3 Developed | Offsite Rate A3 Undeveloped | Pre Rate A3 & A4 | Pond Bypass Rate A4+A5 |
|--------------------|---------------------------|-----------------------------|------------------|------------------------|
| 0.35               | 0.35                      | 1.26                        | 1.1              | 0.03                   |
| Comp C-Factor      | 0.90                      | 0.35                        | 0.35             | 0.9                    |

NOTE: THE PRE RATE AREA DOES NOT EQUAL POST DUE TO ADDITION OF A PORTION OF PRE DEVELOPED BASIN B

| Duration Time (min) | Intensity for 100 yr storm (in/hr) | Offsite Rate A3 Developed (cfs) | Offsite Rate A3 Undeveloped (cfs) | Pre Rate A3 & A4 (cfs) | Pond Bypass Rate A4 (cfs) | Outflow Allowed (cfs) | Inflow (cfs) | Outflow (cfs) | Required Storage (cf) |
|---------------------|------------------------------------|---------------------------------|-----------------------------------|------------------------|---------------------------|-----------------------|--------------|---------------|-----------------------|
| 10                  | 9.8                                | 3.09                            | 4.32                              | 3.20                   | 0.26                      | 2.93                  | 4445.28      | 1758.54       | 2687                  |
| 20                  | 8.3                                | 2.61                            | 3.66                              | 3.20                   | 0.26                      | 2.93                  | 7539.76      | 2637.81       | 4892                  |
| 30                  | 6.9                                | 2.17                            | 3.04                              | 3.20                   | 0.26                      | 2.93                  | 9389.52      | 3517.08       | 5872                  |
| 40                  | 5.8                                | 1.83                            | 2.56                              | 3.20                   | 0.26                      | 2.93                  | 10523.52     | 4396.35       | 6127                  |
| 50                  | 5                                  | 1.58                            | 2.21                              | 3.20                   | 0.26                      | 2.93                  | 11340.00     | 5275.62       | 6064                  |
| 60                  | 4.5                                | 1.42                            | 1.98                              | 3.20                   | 0.26                      | 2.93                  | 12247.20     | 6154.89       | 6092                  |
| 70                  | 4                                  | 1.26                            | 1.76                              | 3.20                   | 0.26                      | 2.93                  | 12700.80     | 7034.16       | 5667                  |
| 80                  | 3.7                                | 1.17                            | 1.63                              | 3.20                   | 0.26                      | 2.93                  | 13426.56     | 7913.43       | 5513                  |
| 90                  | 3.5                                | 1.10                            | 1.54                              | 3.20                   | 0.26                      | 2.93                  | 14286.40     | 8792.70       | 5296                  |
| 100                 | 3.3                                | 1.04                            | 1.46                              | 3.20                   | 0.26                      | 2.93                  | 14968.80     | 9671.97       | 5297                  |
| 110                 | 2.9                                | 0.91                            | 1.28                              | 3.20                   | 0.26                      | 2.93                  | 14469.84     | 10551.24      | 3919                  |

**25 YEAR DETENTION CALCULATION**

| Drainage Area (Ac) | Offsite Rate A3 Developed | Offsite Rate A3 Undeveloped | Pre Rate A3 & A4 | Pond Bypass Rate A4+A5 |
|--------------------|---------------------------|-----------------------------|------------------|------------------------|
| 0.35               | 0.35                      | 1.26                        | 1.1              | 0.03                   |
| Comp C-Factor      | 0.90                      | 0.35                        | 0.35             | 0.9                    |

| Duration Time (min) | Intensity for 25 yr storm (in/hr) | Offsite Rate A3 Developed (cfs) | Offsite Rate A3 Undeveloped (cfs) | Pre Rate A3 & A4 (cfs) | Pond Bypass Rate A4 (cfs) | Outflow Allowed (cfs) | Inflow (cfs) | Outflow (cfs) | Required Storage (cf) |
|---------------------|-----------------------------------|---------------------------------|-----------------------------------|------------------------|---------------------------|-----------------------|--------------|---------------|-----------------------|
| 10                  | 8.3                               | 2.61                            | 3.66                              | 2.54                   | 0.22                      | 2.32                  | 3764.88      | 1390.14       | 2375                  |
| 20                  | 6.6                               | 2.08                            | 2.91                              | 2.54                   | 0.22                      | 2.32                  | 5987.52      | 2085.21       | 3902                  |
| 30                  | 5.5                               | 1.73                            | 2.43                              | 2.54                   | 0.22                      | 2.32                  | 7844.40      | 2780.28       | 4704                  |
| 40                  | 4.6                               | 1.45                            | 2.03                              | 2.54                   | 0.22                      | 2.32                  | 9346.24      | 3475.35       | 4871                  |
| 50                  | 4                                 | 1.26                            | 1.76                              | 2.54                   | 0.22                      | 2.32                  | 9772.00      | 4170.42       | 4902                  |
| 60                  | 3.5                               | 1.10                            | 1.54                              | 2.54                   | 0.22                      | 2.32                  | 9525.60      | 4865.49       | 4660                  |
| 70                  | 3.25                              | 1.02                            | 1.43                              | 2.54                   | 0.22                      | 2.32                  | 10319.40     | 5560.56       | 4759                  |
| 80                  | 3                                 | 0.95                            | 1.32                              | 2.54                   | 0.22                      | 2.32                  | 10886.40     | 6255.63       | 4631                  |
| 90                  | 2.8                               | 0.88                            | 1.23                              | 2.54                   | 0.22                      | 2.32                  | 11430.72     | 6950.70       | 4480                  |
| 100                 | 2.4                               | 0.76                            | 1.06                              | 2.54                   | 0.22                      | 2.32                  | 10886.40     | 7645.77       | 3241                  |
| 110                 | 2.2                               | 0.69                            | 0.97                              | 2.54                   | 0.22                      | 2.32                  | 10977.12     | 8340.84       | 2636                  |

**10 YEAR DETENTION CALCULATION**

| Drainage Area (Ac) | Offsite Rate A3 Developed | Offsite Rate A3 Undeveloped | Pre Rate A3 & A4 | Pond Bypass Rate A4+A5 |
|--------------------|---------------------------|-----------------------------|------------------|------------------------|
| 0.35               | 0.35                      | 1.26                        | 1.1              | 0.03                   |
| Comp C-Factor      | 0.90                      | 0.35                        | 0.35             | 0.9                    |

| Duration Time (min) | Intensity for 10 yr storm (in/hr) | Offsite Rate A3 Developed (cfs) | Offsite Rate A3 Undeveloped (cfs) | Pre Rate A3 & A4 (cfs) | Pond Bypass Rate A4 (cfs) | Outflow Allowed (cfs) | Inflow (cfs) | Outflow (cfs) | Required Storage (cf) |
|---------------------|-----------------------------------|---------------------------------|-----------------------------------|------------------------|---------------------------|-----------------------|--------------|---------------|-----------------------|
| 10                  | 7.2                               | 2.27                            | 3.18                              | 2.23                   | 0.19                      | 2.04                  | 3265.92      | 1223.16       | 2043                  |
| 20                  | 5.8                               | 1.83                            | 2.56                              | 2.23                   | 0.19                      | 2.04                  | 5261.76      | 1834.74       | 3427                  |
| 30                  | 4.8                               | 1.51                            | 2.12                              | 2.23                   | 0.19                      | 2.04                  | 6531.84      | 2446.32       | 4086                  |
| 40                  | 4                                 | 1.26                            | 1.76                              | 2.23                   | 0.19                      | 2.04                  | 7257.60      | 3057.90       | 4200                  |
| 50                  | 3.4                               | 1.07                            | 1.50                              | 2.23                   | 0.19                      | 2.04                  | 7711.20      | 3669.48       | 4042                  |
| 60                  | 3                                 | 0.95                            | 1.32                              | 2.23                   | 0.19                      | 2.04                  | 8164.80      | 4281.06       | 3894                  |
| 70                  | 2.9                               | 0.91                            | 1.28                              | 2.23                   | 0.19                      | 2.04                  | 8208.00      | 4892.64       | 4315                  |
| 80                  | 2.7                               | 0.85                            | 1.19                              | 2.23                   | 0.19                      | 2.04                  | 8797.76      | 5504.22       | 4294                  |
| 90                  | 2.4                               | 0.76                            | 1.06                              | 2.23                   | 0.19                      | 2.04                  | 8797.76      | 6115.80       | 3682                  |
| 100                 | 2.2                               | 0.69                            | 0.97                              | 2.23                   | 0.19                      | 2.04                  | 9979.20      | 6727.38       | 3252                  |
| 110                 | 2                                 | 0.63                            | 0.88                              | 2.23                   | 0.19                      | 2.04                  | 9979.20      | 7338.96       | 2640                  |

**5 YEAR DETENTION CALCULATION**

| Drainage Area (Ac) | Offsite Rate A3 Developed | Offsite Rate A3 Undeveloped | Pre Rate A3 & A4 | Pond Bypass Rate A4+A5 |
|--------------------|---------------------------|-----------------------------|------------------|------------------------|
| 0.35               | 0.35                      | 1.26                        | 1.1              | 0.03                   |
| Comp C-Factor      | 0.90                      | 0.35                        | 0.35             | 0.9                    |

| Duration Time (min) | Intensity for 5 yr storm (in/hr) | Offsite Rate A3 Developed (cfs) | Offsite Rate A3 Undeveloped (cfs) | Pre Rate A3 & A4 (cfs) | Pond Bypass Rate A4 (cfs) | Outflow Allowed (cfs) | Inflow (cfs) | Outflow (cfs) | Required Storage (cf) |
|---------------------|----------------------------------|---------------------------------|-----------------------------------|------------------------|---------------------------|-----------------------|--------------|---------------|-----------------------|
| 10                  | 6.2                              | 1.95                            | 2.73                              | 1.89                   | 0.17                      | 1.72                  | 2812.32      | 1031.46       | 1781                  |
| 20                  | 4.9                              | 1.54                            | 2.16                              | 1.89                   | 0.17                      | 1.72                  | 4445.28      | 1547.19       | 2898                  |
| 30                  | 4                                | 1.26                            | 1.76                              | 1.89                   | 0.17                      | 1.72                  | 5443.20      | 2062.92       | 3380                  |
| 40                  | 3.4                              | 1.07                            | 1.50                              | 1.89                   | 0.17                      | 1.72                  | 6168.96      | 2578.65       | 3500                  |
| 50                  | 2.9                              | 0.91                            | 1.28                              | 1.89                   | 0.17                      | 1.72                  | 6577.20      | 3094.38       | 3483                  |
| 60                  | 2.5                              | 0.79                            | 1.10                              | 1.89                   | 0.17                      | 1.72                  | 6804.00      | 3610.11       | 3194                  |
| 70                  | 2.4                              | 0.76                            | 1.06                              | 1.89                   | 0.17                      | 1.72                  | 7620.48      | 4125.84       | 3495                  |
| 80                  | 2.2                              | 0.69                            | 0.97                              | 1.89                   | 0.17                      | 1.72                  | 7983.36      | 4641.57       | 3342                  |
| 90                  | 2                                | 0.63                            | 0.88                              | 1.89                   | 0.17                      | 1.72                  | 8164.80      | 5157.30       | 3008                  |
| 100                 | 1.8                              | 0.57                            | 0.79                              | 1.89                   | 0.17                      | 1.72                  | 8164.80      | 5673.03       | 2492                  |
| 110                 | 1.6                              | 0.50                            | 0.71                              | 1.89                   | 0.17                      | 1.72                  | 7983.36      | 6188.76       | 1795                  |

TXDOT STANDARDS, SPECIFICATIONS, AND GUIDELINES MUST BE UTILIZED WITHIN TXDOT RIGHT OF WAY.

**100 YEAR**

**Orifice 1 Calculation**

|               |               |
|---------------|---------------|
| Coefficient C | 0.6           |
| Diameter d    | 4.98 in       |
| Open Area A   | 0.415 sq. ft. |
| Head H        | 32.2 ft       |
| Flow Q        | 35 cfs        |

**Orifice 2 Calculation**

|               |                 |
|---------------|-----------------|
| Coefficient C | 0.6             |
| Diameter d    | 3.85 in         |
| Open Area A   | 0.32833 sq. ft. |
| Head H        | 11 in           |
| Flow Q        | 0.36 cfs        |

**25 YEAR**

**Orifice 1 Calculation**

|               |               |
|---------------|---------------|
| Coefficient C | 0.6           |
| Diameter d    | 4.98 in       |
| Open Area A   | 0.415 sq. ft. |
| Head H        | 32.2 ft       |
| Flow Q        | 0.91 cfs      |

**Orifice 2 Calculation**

|               |                 |
|---------------|-----------------|
| Coefficient C | 0.6             |
| Diameter d    | 3.85 in         |
| Open Area A   | 0.32833 sq. ft. |
| Head H        | 3 in            |
| Flow Q        | 0.12 cfs        |

**10 YEAR**

**Orifice 1 Calculation**

|               |               |
|---------------|---------------|
| Coefficient C | 0.6           |
| Diameter d    | 4.98 in       |
| Open Area A   | 0.415 sq. ft. |
| Head H        | 32.2 ft       |
| Flow Q        | 0.87 cfs      |

**5 YEAR**

**Orifice 1 Calculation**

|               |               |
|---------------|---------------|
| Coefficient C | 0.6           |
| Diameter d    | 4.98 in       |
| Open Area A   | 0.415 sq. ft. |
| Head H        | 32.2 ft       |
| Flow Q        | 0.78 cfs      |

**UNDERGROUND DETENTION**

**100 YEAR DETENTION CALCULATION**

| Drainage Area (Ac) | Onsite Rate A1 | Pre Rate A1 & A2 | Pond Bypass Rate A2 |
|--------------------|----------------|------------------|---------------------|
| 0.90               | 0.77           | 0.91             | 0.14                |
| Comp C-Factor      | 0.90           | 0.35             | 0.9                 |

| Duration Time (min) | Intensity for 100 yr storm (in/hr) | Onsite Rate A1 (cfs) | Pre Rate A1 & A2 (cfs) | Pond Bypass Rate A2 (cfs) | Outflow Allowed (cfs) | Inflow (cfs) | Outflow (cfs) | Required Storage (cf) |
|---------------------|------------------------------------|----------------------|------------------------|---------------------------|-----------------------|--------------|---------------|-----------------------|
| 10                  | 9.8                                | 6.79                 | 2.64                   | 1.23                      | 1.41                  | 4074.84      | 845.25        | 3320                  |
| 20                  | 8.3                                | 5.75                 | 2.64                   | 1.23                      | 1.41                  | 6902.28      | 1267.88       | 5634                  |
| 30                  | 6.9                                | 4.78                 | 2.64                   | 1.23                      | 1.41                  | 8607.06      | 1690.50       | 6917                  |
| 40                  | 5.8                                | 4.02                 | 2.64                   | 1.23                      | 1.41                  | 9666.56      | 2113.13       | 7533                  |
| 50                  | 5                                  | 3.47                 | 2.64                   | 1.23                      | 1.41                  | 10395.00     | 2535.75       | 7899                  |
| 60                  | 4.5                                | 3.12                 | 2.64                   | 1.23                      | 1.41                  | 11266.40     | 2958.38       | 8268                  |
| 70                  | 4                                  | 2.77                 | 2.64                   | 1.23                      | 1.41                  | 11642.40     | 3381.00       | 8201                  |
| 80                  | 3.7                                | 2.56                 | 2.64                   | 1.23                      | 1.41                  | 12079.36     | 3803.62       | 8554                  |
| 90                  | 3.5                                | 2.41                 | 2.64                   | 1.23                      | 1.41                  | 13097.70     | 4226.25       | 8871                  |
| 100                 | 3.3                                | 2.29                 | 2.64                   | 1.23                      | 1.41                  | 13721.40     | 4648.88       | 9073                  |
| 110                 | 2.9                                | 2.01                 | 2.64                   | 1.23                      | 1.41                  | 13264.00     | 5071.50       | 8193                  |

**25 YEAR DETENTION CALCULATION**

| Drainage Area (Ac) | Onsite Rate A1 | Pre Rate A1 & A2 | Pond Bypass Rate A2 |
|--------------------|----------------|------------------|---------------------|
| 0.90               | 0.77           | 0.91             | 0.14                |
| Comp C-Factor      | 0.90           | 0.35             | 0.9                 |

| Duration Time (min) | Intensity for 25 yr storm (in/hr) | Onsite Rate A1 (cfs) | Pre Rate A1 & A2 (cfs) | Pond Bypass Rate A2 (cfs) | Outflow Allowed (cfs) | Inflow (cfs) | Outflow (cfs) | Required Storage (cf) |
|---------------------|-----------------------------------|----------------------|------------------------|---------------------------|-----------------------|--------------|---------------|-----------------------|
| 10                  | 8.3                               | 5.75                 | 2.10                   | 1.05                      | 1.06                  | 3451.14      | 633.78        | 2817                  |
| 20                  | 6.6                               | 4.57                 | 2.10                   | 1.05                      | 1.06                  | 5488.56      | 950.67        | 4538                  |
| 30                  | 5.5                               | 3.81                 | 2.10                   | 1.05                      | 1.06                  | 6860.70      | 1267.56       | 5593                  |
| 40                  | 4.6                               | 3.19                 | 2.10                   | 1.05                      | 1.06                  | 7650.72      | 1584.45       | 6066                  |
| 50                  | 4                                 | 2.77                 | 2.10                   | 1.05                      | 1.06                  | 8376.00      | 1901.34       | 6233                  |
| 60                  | 3.5                               | 2.41                 | 2.10                   | 1.05                      | 1.06                  | 8731.80      | 2218.23       | 6514                  |
| 70                  | 3.25                              | 2.25                 | 2.10                   | 1.05                      | 1.06                  | 9459.45      | 2535.12       | 6924                  |
| 80                  | 3                                 | 2.08                 | 2.10                   | 1.05                      | 1.06                  | 9979.20      | 2852.01       | 7127                  |
| 90                  | 2.8                               | 1.94                 | 2.10                   | 1.05                      | 1.06                  | 10079.36     | 3168.90       | 7289                  |
| 100                 | 2.4                               | 1.66                 | 2.10                   | 1.05                      | 1.06                  | 9979.20      | 3485.79       | 6493                  |
| 110                 | 2.2                               | 1.52                 | 2.10                   | 1.05                      | 1.06                  | 10062.36     | 3802.68       | 6260                  |

**10 YEAR DETENTION CALCULATION**

| Drainage Area (Ac) | Onsite Rate A1 | Pre Rate A1 & A2 | Pond Bypass Rate A2 |
|--------------------|----------------|------------------|---------------------|
| 0.90               | 0.77           | 0.91             | 0.14                |
| Comp C-Factor      | 0.90           | 0.35             | 0.9                 |

| Duration Time (min) | Intensity for 10 yr storm (in/hr) | Onsite Rate A1 (cfs) | Pre Rate A1 & A2 (cfs) | Pond Bypass Rate A2 (cfs) | Outflow Allowed (cfs) | Inflow (cfs) | Outflow (cfs) | Required Storage (cf) |
|---------------------|-----------------------------------|----------------------|------------------------|---------------------------|-----------------------|--------------|---------------|-----------------------|
| 10                  | 7.2                               | 4.99                 | 1.85                   | 0.91                      | 0.94                  | 2993.76      | 564.06        | 2430                  |
| 20                  | 5.8                               | 4.02                 | 1.85                   | 0.91                      | 0.94                  | 4923.28      | 855.09        | 3977                  |
| 30                  | 4.8                               | 3.33                 | 1.85                   | 0.91                      | 0.94                  | 5987.52      | 1128.12       | 4859                  |
| 40                  | 4                                 | 2.77                 | 1.85                   | 0.91                      | 0.94                  | 6652.80      | 1410.15       | 5243                  |
| 50                  | 3.4                               | 2.36                 | 1.85                   | 0.91                      | 0.94                  | 7068.60      | 1692.18       | 5376                  |
| 60                  | 3                                 | 2.08                 | 1.85                   | 0.91                      | 0.94                  | 8376.00      | 1974.21       | 5530                  |
| 70                  | 2.9                               | 2.01                 | 1.85                   | 0.91                      | 0.94                  | 8440.74      | 2256.24       | 6185                  |
| 80                  | 2.7                               | 1.87                 | 1.85                   | 0.91                      | 0.94                  | 8981.28      | 2538.27       | 6443                  |
| 90                  | 2.4                               | 1.66                 | 1.85                   | 0.91                      | 0.94                  | 8981.28      | 2820.30</     |                       |