

7-11
SH-205
file




Install 16" 45 degree bend

SH. 205

Install 16" 90 degree bend

Install 16" .021 casing by bore 9

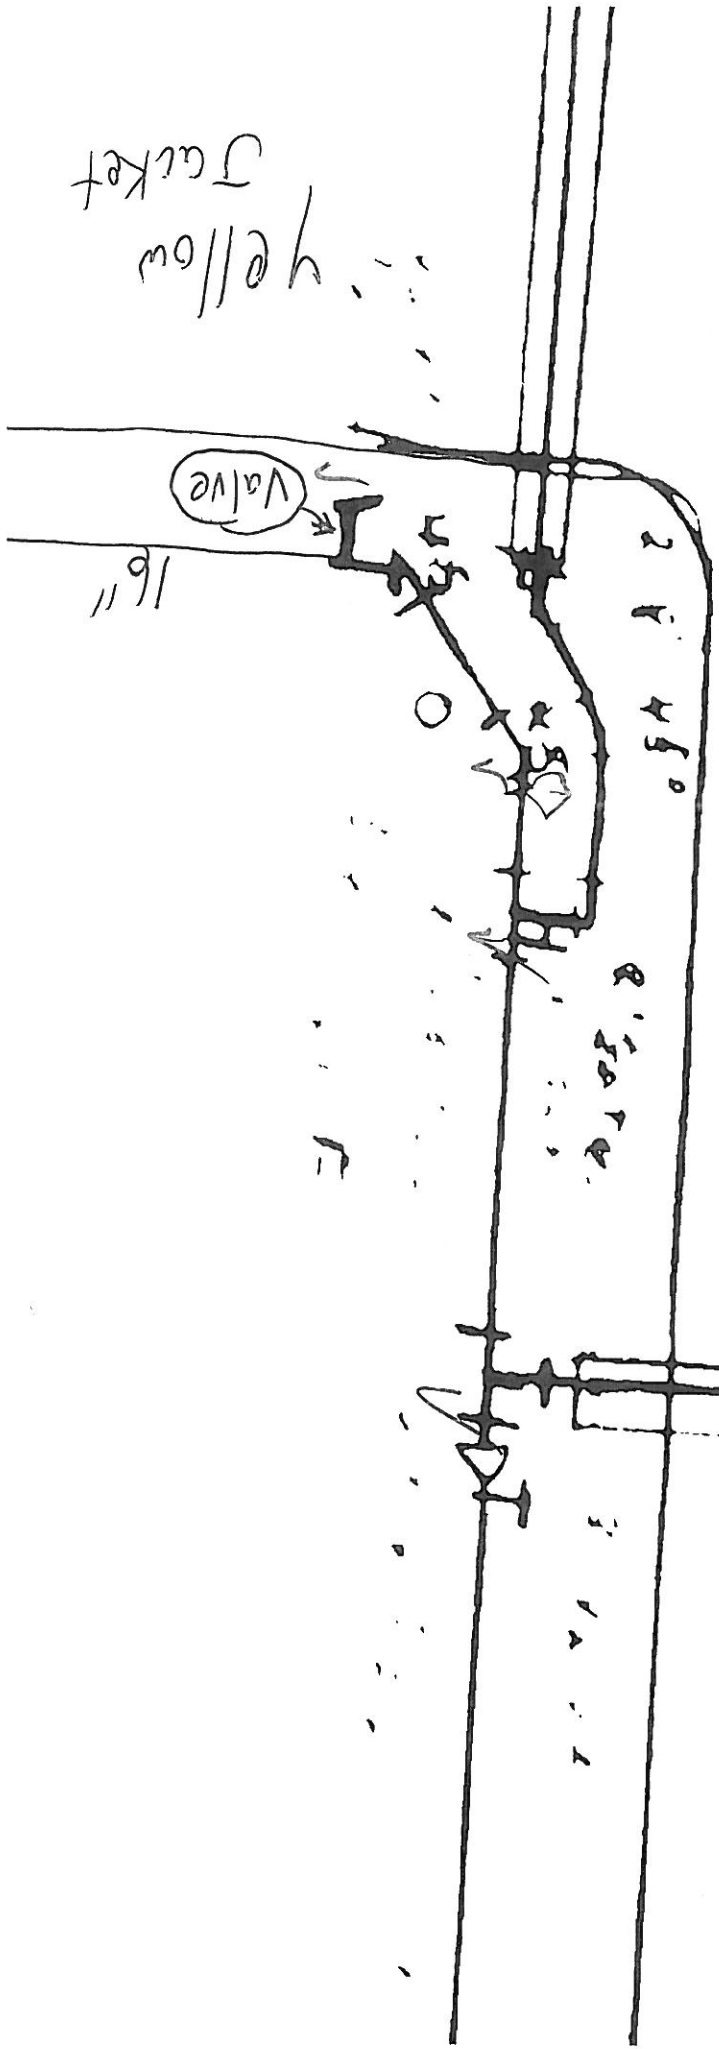

yellow
Jacket