


LOCATION MAP  
NO SCALE

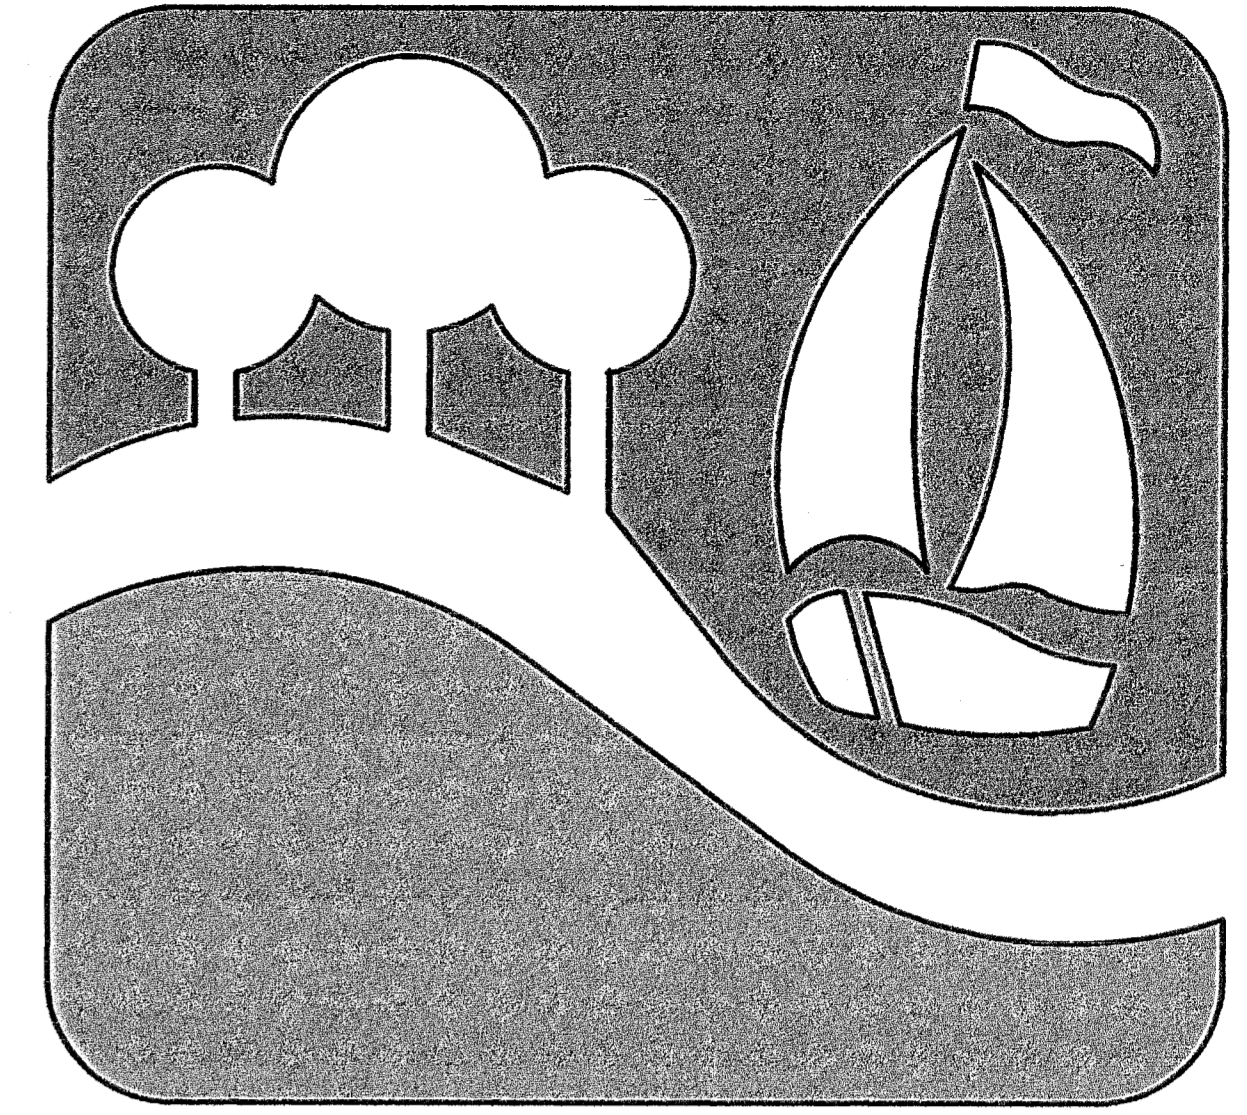

"THE NEW HORIZON"

**SITE CONSTRUCTION PLANS**

**FOR**

**ALBRIGHT, HILL & SUMPTER, PC**

**ALBRIGHT-HILL ADDITION**

**LOT 1, BLOCK 1**

**IN THE**


**CITY OF ROCKWALL, TEXAS**

SHEET INDEX

Sheet No.	Description
1	Cover Sheet
2	Plat - 1 of 2
3	Plat - 2 of 2
A1.02	Site Plan
L1.02	Landscape Plan
C1	Grading/Demo Plan
C2	Drainage Area Map
C3	Water/Sewer Plan
C4	Erosion Control
C5	Private Onsite Details

**Bentley**  
ENGINEERING, INC.

1855 EMERALD BAY DRIVE  
ROCKWALL, TEXAS 75087  
PH. 214.957.1407  
FIRM REG. NO. 674

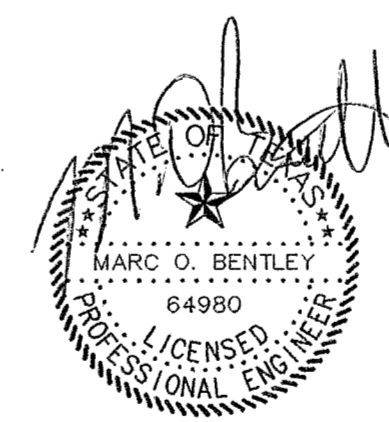

THE SEAL APPEARING ON THIS DOCUMENT WAS AUTHORIZED BY MARC O. BENTLEY, P.E. NO. 64980 ON 07/01/14

AUGUST 2014

RECORD DRAWING

TO THE BEST OF OUR KNOWLEDGE, BENTLEY ENGINEERING, INC. HEREBY STATES THAT THIS PLAN IS AS-BUILT. THE INFORMATION PROVIDED IS BASED ON SURVEYING PERFORMED AT THE SITE BY RUDY RANGEL, R.P.L.S. AND THE INFORMATION PROVIDED BY THE CONTRACTOR.

DATE: JUNE 18, 2015

ALL RESPONSIBILITY FOR ADEQUACY OF DESIGN REMAINS WITH THE DESIGN ENGINEER. THE CITY OF ROCKWALL, IN REVIEWING AND RELEASING PLANS FOR CONSTRUCTION, ASSUMES NO RESPONSIBILITY FOR ADEQUACY OR ACCURACY OF DESIGN.