


BENCH MARK:
EXISTING TOP OF CURB AT P.I. ON
EAST CURB LINE OF CAR WASH LOT
AT SOUTH LINE OF FIRE LANE
ELEV. 551.92

X 48.40 = PROPOSED TOP OF CONC. ELEV.
X TC 50.17 = PROPOSED TOP OF CURB ELEV.

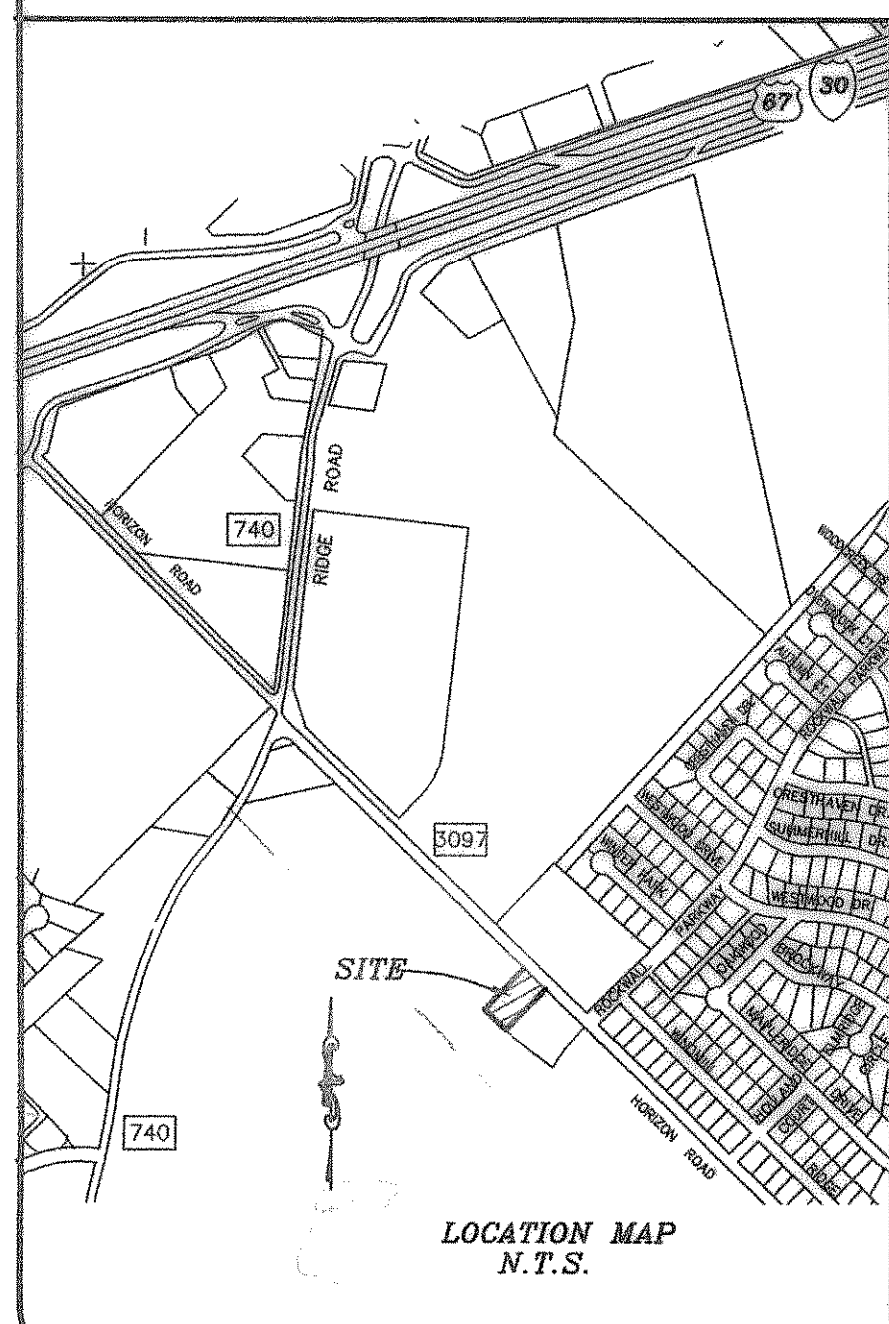

OUR SAVIOR LUTHERAN CHURCH
SLIDE B, PAGE 167

AREA = 5.85 ACRES
T.C. = 10 MIN.
C = 0.80
Q = (0.80)(9.8)(5.85) = 45.86
Q/PIPE = 22.93
V = 7.30 FPS

LOT 1
BLOCK A
MARK CARSON ADDITION


CAR WASH

CAR WASH

PROPOSED OFFICE BLDG.
TOTAL BLDG AREA = 4,098 SQ. FT.
PAVED FOOT = 652.00'

LOT 2
49,779 S.F.
1.1428 ACRES
BLOCK A

AS BUILT

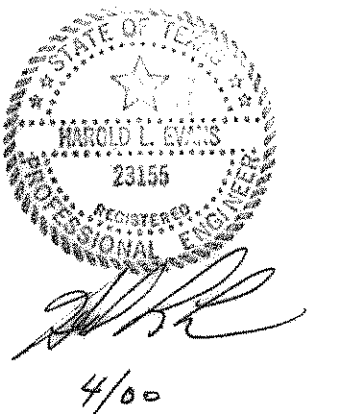

REVISED PARKING	12-9-99
REVISED GRADING & RADIUS	1-5-2000
REVISED	3-31-2000
REVISED	4-6-2000

HAROLD L. EVANS
CONSULTING ENGINEER
P.O. BOX 28395
2831 GUS THOMASSON ROAD, SUITE 102
DALLAS, TEXAS 75228, (214) 328-8133

SITE PLAN
LOT 1 ALLEN ANDERSON ADDITION
CITY OF ROCKWALL
ROCKWALL COUNTY, TEXAS

SHEET NO.	3
JOB NO.	9981

REVISION DESCRIPTION	DATE	SCALE	DESIGN	DRAWN
	11-15-99	1" = 20'	H.L.E.	JMA

A = 0.4148 AC.
Q = 3.25
AREA = (.5)(3) = 1.5
V = 3.25/1.5 = 2.16

REF: 9947 PREL