

MASONRY WALL SCHEDULE
1500 psf - BEARING CAPACITY (STIFF NATURAL UNDISTURBED SOILS SEE GENERAL NOTES SHEET RW1)

WALL HEIGHT H	BASE WIDTH B	TOE B1	BASE DEPTH (TOE) C	BASE DEPTH (HEEL) C1	BATTER A	FULLY MORTARED ZONE E	THICKNESS OF WALL T	DRAINAGE ZONE THICKNESS G	BEARING CAPACITY
1'-0"	1'-0"	0'-2"	0'-6"	0'-2"	0'-2"	FULLY MORTARED	1'-0"	SEE A/RW2	1500 psf
2'-0"	1'-2"	0'-2"	0'-9"	0'-3"	0'-4"	FULLY MORTARED	1'-0"	SEE A/RW2	
3'-0"	1'-7"	0'-3"	0'-9"	0'-4"	0'-6"	FULLY MORTARED	1'-4"	SEE A/RW2	
4'-0"	2'-3"	0'-4"	1'-0"	0'-5"	0'-8"	FULLY MORTARED	1'-11"	SEE A/RW2	
5'-0"	2'-9"	0'-5"	1'-3"	0'-6"	0'-10"	0'-8"	2'-4"	1'-0"	
6'-0"	3'-4"	0'-6"	1'-6"	0'-8"	1'-0"	0'-10"	2'-10"	1'-0"	
7'-0"	4'-0"	0'-7"	1'-9"	0'-9"	1'-2"	0'-10"	3'-5"	1'-0"	
8'-0"	4'-9"	0'-8"	2'-0"	0'-11"	1'-4"	1'-0"	4'-1"	1'-0"	

WALL DESIGN CRITERIA

BEARING q_u	SLOPE TOP β	SLOPE BOT β_1	ACTIVE PRESSURE o_a	PASSIVE PRESSURE o_p	FRICTION ANGLE BASE δ	SLOPE OF BACK OF WALL α	SURCHARGE q
1500PSF	5.71 deg	7.13 deg	26 deg	26 deg	17 deg	99.46 deg	0 psf

USE THIS SCHEDULE FOR 3/RW2

MASONRY WALL SCHEDULE
1500 psf - BEARING CAPACITY (STIFF NATURAL UNDISTURBED SOILS SEE GENERAL NOTES SHEET RW1)

WALL HEIGHT H	BASE WIDTH B	TOE B1	BASE DEPTH (TOE) C	BASE DEPTH (HEEL) C1	BATTER A	FULLY MORTARED ZONE E	THICKNESS OF WALL T	DRAINAGE ZONE THICKNESS G	BEARING CAPACITY
1'-0"	1'-2"	0'-2"	0'-6"	0'-7"	0'-2"	FULLY MORTARED	1'-0"	SEE A/RW2	1500 psf
2'-0"	1'-3"	0'-2"	0'-9"	0'-7"	0'-4"	FULLY MORTARED	1'-1"	SEE A/RW2	
3'-0"	1'-9"	0'-3"	0'-9"	0'-8"	0'-6"	FULLY MORTARED	1'-6"	SEE A/RW2	

WALL DESIGN CRITERIA

BEARING q_u	SLOPE TOP β	SLOPE BOT β_1	ACTIVE PRESSURE o_a	PASSIVE PRESSURE o_p	FRICTION ANGLE BASE δ	SLOPE OF BACK OF WALL α	SURCHARGE q
1500PSF	14 deg	7.13 deg	26 deg	26 deg	17 deg	99.46 deg	0 psf

USE THIS SCHEDULE FOR 2/RW2

MASONRY WALL SCHEDULE
1500 psf - BEARING CAPACITY (STIFF NATURAL UNDISTURBED SOILS SEE GENERAL NOTES SHEET RW1)

WALL HEIGHT H	BASE WIDTH B	TOE B1	BASE DEPTH (TOE) C	BASE DEPTH (HEEL) C1	BATTER A	FULLY MORTARED ZONE E	THICKNESS OF WALL T	DRAINAGE ZONE THICKNESS G	BEARING CAPACITY
1'-0"	3'-7"	1'-6"	2'-6"	0'-7"	0'-2"	FULLY MORTARED	2'-1"	SEE A/RW2	1500 psf
2'-0"	3'-8"	1'-6"	2'-6"	0'-7"	0'-4"	FULLY MORTARED	2'-2"	SEE A/RW2	
3'-0"	3'-9"	1'-6"	2'-6"	0'-8"	0'-6"	FULLY MORTARED	2'-3"	SEE A/RW2	
4'-0"	3'-11"	1'-6"	2'-6"	0'-8"	0'-8"	FULLY MORTARED	2'-5"	SEE A/RW2	
5'-0"	4'-0"	1'-6"	2'-6"	0'-9"	0'-10"	FULLY MORTARED	2'-6"	1'-0"	

WALL DESIGN CRITERIA

BEARING q_u	SLOPE TOP β	SLOPE BOT β_1	ACTIVE PRESSURE o_a	PASSIVE PRESSURE o_p	FRICTION ANGLE BASE δ	SLOPE OF BACK OF WALL α	SURCHARGE q	IMPACT i
1500PSF	14 deg	7.13 deg	26 deg	26 deg	17 deg	99.46 deg	0 psf	417 psf

USE THIS SCHEDULE FOR 1/RW2

RECEIVED
By DANA ADKINS at 8:30 am, Aug 31, 2021

3
RW2 TYPICAL WALL SECTION - 1V:10H MAX SLOPE ABOVE WALL
1/2H MAX SLOPE BELOW WALL
BEARING IN CLAYEY OR SANDY SOILS

1/2" = 1'-0"

2
RW2 TYPICAL WALL SECTION - 1V:4H MAX SLOPE ABOVE WALL
1/2H MAX SLOPE BELOW WALL
BEARING IN BEDROCK

1/2" = 1'-0"

1
RW2 TYPICAL WALL SECTION - 1V:4H MAX SLOPE ABOVE WALL
1/2H MAX SLOPE BELOW WALL
BEARING IN BEDROCK

1/2" = 1'-0"


DATE	BY	CHK.	DRN.	DES.	MMR	IND.	DATE	REVISION
08-18-21	MMR							
08-18-21	BDB							
08-18-21	MMR							

Falkofsk Engineering, Inc.
Structural Engineering Consultants
TX Reg. Engineering Firm F-4038
722 North Fielder Road
Arlington, Texas 76012
(817) 261-8300



The use of these plans and specifications shall be restricted to the project for which they were prepared. Any use for other projects, in whole or in part, is prohibited without the express written consent of Falkofsk Engineering, Inc. All information contained herein is the property of Falkofsk Engineering, Inc.

MASONRY RETAINING WALLS
RANDALL NDE ALLIANCE ADDITION
6601 HORIZON ROAD
ROCKWALL, TEXAS
RPM xCONSTRUCTION, LLC
PLANO, TEXAS

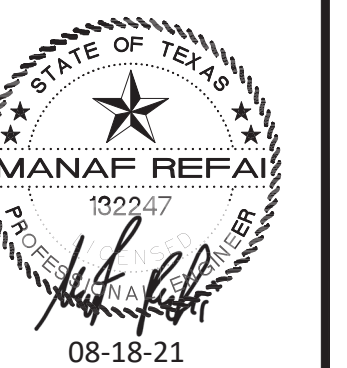

JOB NO. 575.21

RW2