


VICINITY MAP  
NOT TO SCALE

- FIRELANE PAVEMENT**  
5' 3600 PSI CONCRETE WITH NO. 3 BARS ON 18" CENTERS BOTH WAYS ON COMPACTED SUBGRADE WITH 6 1/2 SACK - NO SAND ALLOWED
- PARKING LOT PAVEMENT**  
5' 3600 PSI CONCRETE WITH NO. 3 BARS ON 18" CENTERS BOTH WAYS ON COMPACTED SUBGRADE WITH 6 1/2 SACK - NO SAND ALLOWED
- SIDEWALK PAVEMENT**  
4" 3600 PSI CONCRETE WITH NO. 4 BARS ON 18" CENTERS BOTH WAYS ON COMPACTED SUBGRADE WITH 6 1/2 SACK - NO SAND ALLOWED
- All dimensions are to back of curb or edge of pavement

- LINE LEGEND:**
- PROPERTY LINE
  - DRAINAGE FLOW
  - PROPOSED WATER LINE
  - ROAD CENTER LINE
  - PROPOSED STORM SEWER
  - PROPOSED STREET
  - EXISTING CONTOUR LINE
  - PROPOSED CONTOUR LINE
  - BUILDING SETBACK LINE
  - DRAINAGE EASEMENT
  - DRAINAGE DIVIDE LINE
  - ROW / LOT LINE
  - PROPOSED FENCE

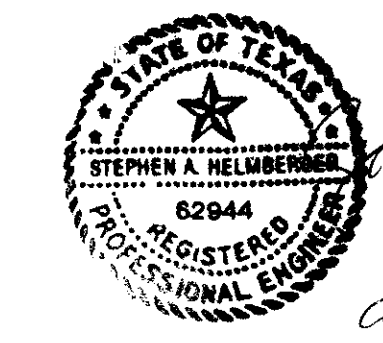

*AS-BUILT*  
9/10/20

AS-BUILT DRAWING 09-10-2020

THIS DOCUMENT IS SUBMITTED AS AN "AS-BUILT DRAWING" FOR RECORD PURPOSES ONLY. ANY MODIFICATION OR CHANGES THAT HAVE BEEN MADE DURING CONSTRUCTION AND NOTED ON THIS DRAWING HAVE BEEN SUPPLIED BY THE OWNER, HIS REPRESENTATIVE OR THE CONTRACTOR. FIELD INSPECTION/CONTRACT SUPERVISION OF THE CONSTRUCTION WAS PERFORMED BY OTHERS. IT IS NOT GUARANTEED BY HELMBERGER ASSOCIATES, INC. THAT THIS DOCUMENT REPRESENTS "AS-BUILT" CONDITIONS. TPBE FIRM NO. 000756

OWNER:  
RANDALL NOE ENTERPRISES INC.  
P.O. BOX 369  
ROCKWALL, TEXAS 75087  
MR. ROB WHITTLE  
(972) 771-5253

ENGINEER:  
HELMBERGER ASSOCIATES, INC.  
1525 BOZMAN ROAD  
WYLIE, TEXAS 75098  
MR. STEPHEN A. HELMBERGER, P.E.  
(972) 442-7459



PAVING AND UTILITY PLAN						
LOTS 14/15 BLOCK 2 - ALLIANCE ADDITION PH 2						
RANDALL NOE ENTERPRISES INC.						
CITY OF ROCKWALL, TEXAS						
TYPE REGISTRATION NO. 000756	<b>HELMBERGER ASSOCIATES, INC.</b> CIVIL AND ENVIRONMENTAL ENGINEERS 1525 BOZMAN ROAD, WYLIE, TEXAS 75098 (972) 442-7459					
DESIGN	DRAWN	DATE	SCALE	NOTES	FILE	NO.
HELM.	CADD	FEB 2018	1"=20'	PBORDER	1727	C2