
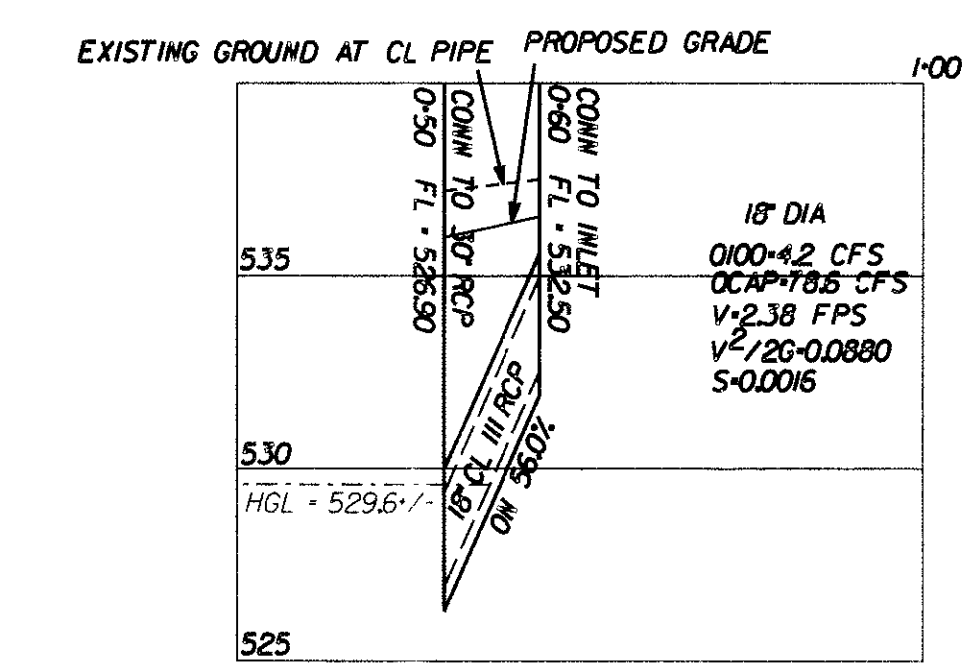


- LINE LEGEND:**
- PROPERTY LINE
 - DRAINAGE FLOW
 - PROPOSED WATER LINE
 - ROAD CENTER LINE
 - PROPOSED STORM SEWER
 - PROPOSED STREET
 - - - - - EXISTING CONTOUR LINE
 - - - - - PROPOSED CONTOUR LINE
 - - - - - BUILDING SETBACK LINE
 - - - - - DRAINAGE EASEMENT
 - - - - - DRAINAGE DIVIDE LINE
 - - - - - ROW / LOT LINE
 - - - - - PROPOSED FENCE

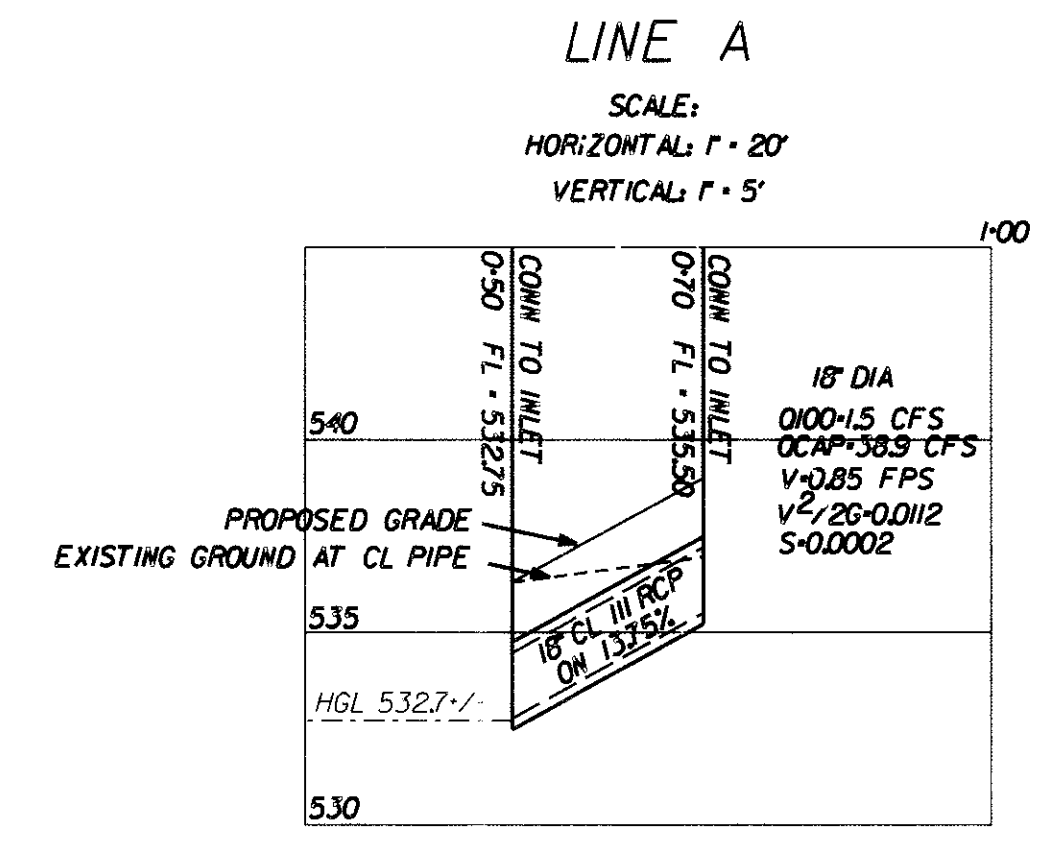



9/10/20

AS-BUILT DRAWING 09-10-2020

THIS DOCUMENT IS SUBMITTED AS AN "AS-BUILT DRAWING" FOR RECORD PURPOSES ONLY. ANY MODIFICATION OR CHANGES THAT HAVE BEEN MADE DURING CONSTRUCTION AND NOTED ON THIS DRAWING HAVE BEEN SUPPLIED BY THE OWNER. HIS REPRESENTATIVE OR THE CONTRACTOR. FIELD INSPECTION/CONTRACT SUPERVISION OF THE CONSTRUCTION WAS PERFORMED BY OTHERS. IT IS NOT GUARANTEED BY HELMBERGER ASSOCIATES, INC. THAT THIS DOCUMENT REPRESENTS "AS-BUILT" CONDITIONS. TBPE FIRM NO. 000756

OWNER:
RANDALL NOE ENTERPRISES INC.
P.O. BOX 369
ROCKWALL, TEXAS 75087
MR. ROB WHITTLE
(972) 771-5253

ENGINEER:
HELMBERGER ASSOCIATES, INC.
1525 BOZMAN ROAD
WYLIE, TEXAS 75098
MR. STEPHEN A. HELMBERGER P.E.
(972) 442-7459

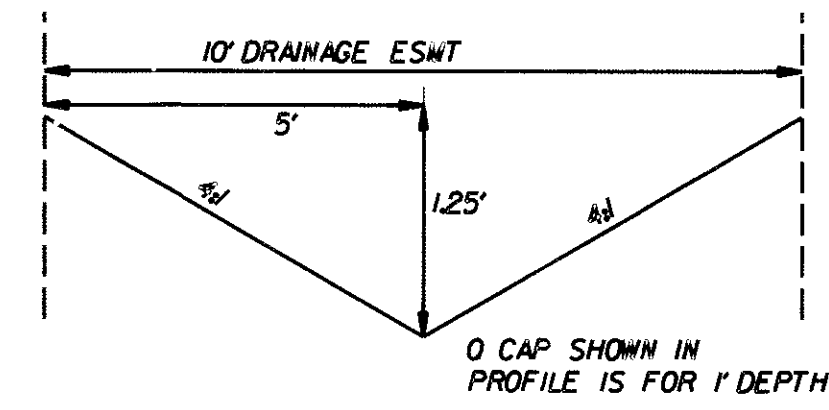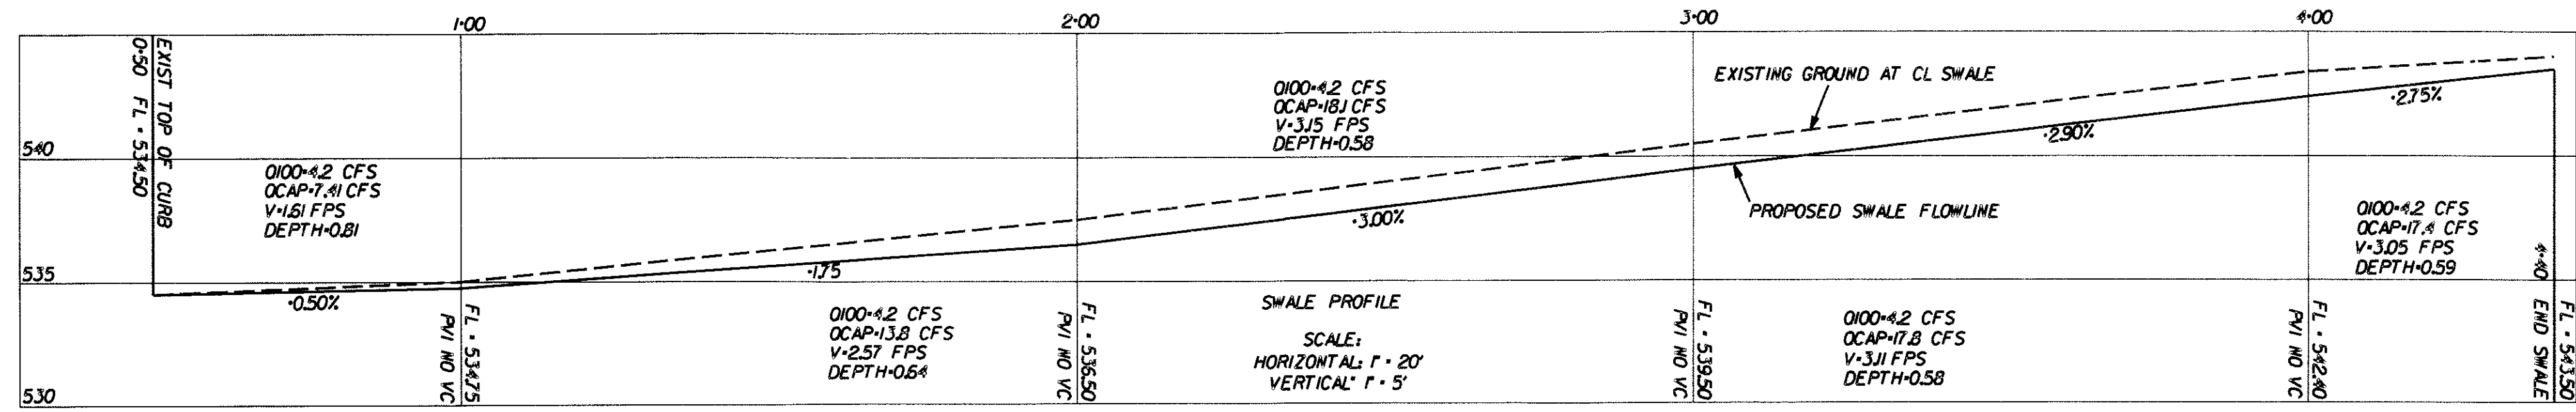

SECTION A-A
NOT TO SCALE

GRADING AND DRAINAGE PLAN					
LOTS 14/15 BLOCK 2 - ALLIANCE ADDITION PH 2					
RANDALL NOE ENTERPRISES INC.					
CITY OF ROCKWALL, TEXAS					
HELMBERGER ASSOCIATES, INC. CIVIL AND ENVIRONMENTAL ENGINEERS 1525 BOZMAN ROAD, WYLIE, TEXAS 75098 (972) 442-7459					
DESIGN	DRAWN	DATE	SCALE	NOTES	FILE
HELM	CADD	FEB 2018	1"=20'	GOBORDER	1727
					C3