


DEVELOPMENT PLANS

ALLIANCE ADDITION PH. 2

CITY OF ROCKWALL, TEXAS


INDEX of SHEETS

Sheet No.	Title
1	Cover Sheet
2	Final Plat
3	Legal Description
4	Alliance Drive Paving Plan & Profile
5	Andrews Drive Paving Plan & Profile
6	Wallace Road Paving Plan & Profile
7	Jeff Boyd Road Paving Plan & Profile
8	Grading Plan
9	Drainage Area Map
10	Storm Sewer Plan
11	Storm Sewer Profiles
12	Storm Sewer Profiles
13	Water and Sanitary Sewer Plan
14	Sanitary Sewer Profiles
15	Erosion Control Plan

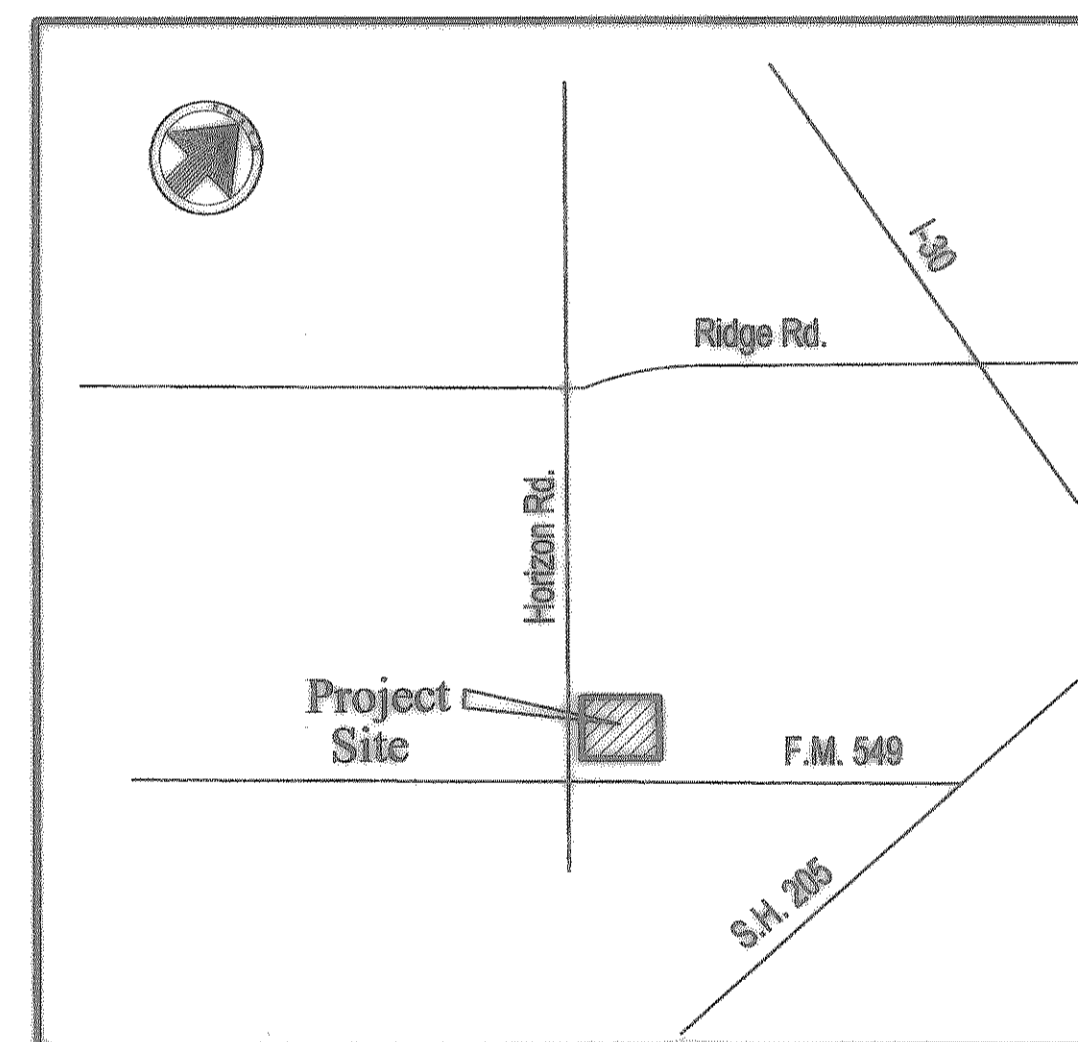


LOCATION MAP

THE SEAL APPEARING ON THIS DOCUMENT WAS AUTHORIZED BY CHRISTOPHER R. CUNY, P.E. 65642

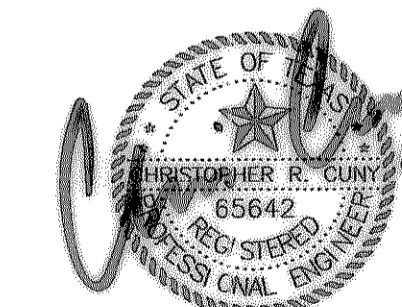

~ Engineer ~

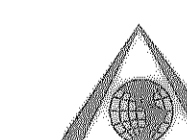

F.C. CUNY CORPORATION

#2 Horizon Court • Heath, Texas 75032 • (469) 402-7700

Applicant ~ Developer
WHITTLE DEVELOPMENT CO.
 P.O. Box 369
 Rockwall, Texas 75087
 (972) 771-5253

Record Drawings
 January 2009

Surveyor:
MADDOX SURVEYING
 P.O. Box 2109
 Forney, Texas 75126
 (972) 564-4416