


Revision	Date	Description
1	7/1/08	Added Line "D"


Owner:
Whittle Development Co.
 PO Box 369 • Rockwall, Texas • 75087
 Phone: 972-771-5253

**ALLIANCE
 ADDITION**

F.C. CUNY CORPORATION
 #2 Horizon Court • Ste. 500 • Heath, Texas 75032
 Phone: 469-402-7700
 Fax: 469-402-0700

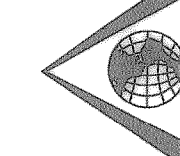

THE SEAL APPEARING ON THIS DOCUMENT WAS AUTHORIZED BY CHRISTOPHER R. CUNY, P.E. 65642

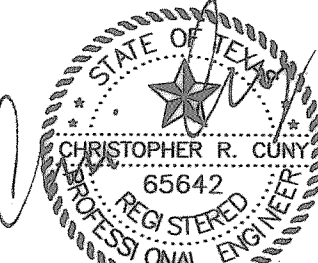

1-15-2009

Drawn By: F.C. CUNY
 Checked By: F.C. CUNY

Date: 1-09
 Project No.: 07-003

Sheet Title:

Sanitary Sewer Profile

Scale: 1" = 40'
 Sheet No.: 14 of 15



CONSTRUCTION RECORD DRAWINGS
 JANUARY 2009