


LINE LEGEND:

- PROPERTY LINE
- DRAINAGE FLOW
- PROPOSED WATER LINE
- ROAD CENTER LINE
- PROPOSED STORM SEWER
- PROPOSED STREET
- 610- EXISTING CONTOUR LINE
- 610- PROPOSED CONTOUR LINE
- BUILDING SETBACK LINE
- DRAINAGE EASEMENT
- DRAINAGE DIVIDE LINE
- ROW / LOT LINE
- PROPOSED FENCE

- FIRELANE PAVEMENT AND DUMPSTER
6" 3600 PSI CONCRETE WITH NO. 4 BARS ON 18" CENTERS BOTH WAYS ON 6" THICK LIME STABILIZED SUBGRADE
- PARKING LOT PAVEMENT
5" 3600 PSI CONCRETE WITH NO. 3 BARS ON 18" CENTERS BOTH WAYS ON COMPACTED SUBGRADE
- SIDEWALK PAVEMENT
7" 3600 PSI CONCRETE WITH NO. 4 BARS ON 18" CENTERS BOTH WAYS ON 6" THICK LIME STABILIZED SUBGRADE

AS-BUILT DRAWING 2-15-16

THIS DOCUMENT IS SUBMITTED AS AN "AS-BUILT DRAWING" FOR RECORD PURPOSES ONLY. ANY MODIFICATION OR CHANGES THAT HAVE BEEN MADE DURING CONSTRUCTION AND NOTED ON THIS DRAWING HAVE BEEN SUPPLIED BY THE OWNER, HIS REPRESENTATIVE OR THE CONTRACTOR. FIELD INSPECTION/CONTRACT SUPERVISION OF THE CONSTRUCTION WAS PERFORMED BY OTHERS. IT IS NOT GUARANTEED BY HELMBERGER ASSOCIATES, INC. THAT THIS DOCUMENT REPRESENTS "AS-BUILT" CONDITIONS. TBPE FIRM NO. 000756

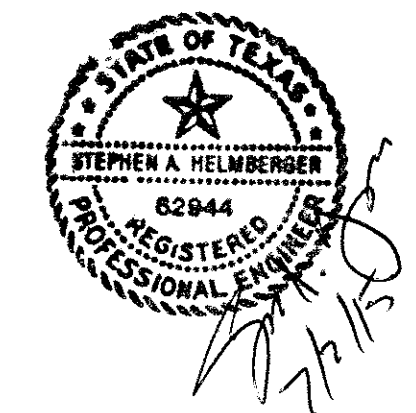

OWNER:
RANDALL NOE ENTERPRISES INC.
P.O. BOX 369
ROCKWALL, TEXAS 75087
MR. ROB WHITTLE
(972) 771-5253

ENGINEER:
HELMBERGER ASSOCIATES, INC.
1525 BOZMAN ROAD
WYLIE, TEXAS 75098
MR. STEPHEN A. HELMBERGER, P.E.
(972) 442-7459

PAVING AND UTILITY PLAN					
LOT 11 BLOCK 2 - ALLIANCE ADDITION PH 2					
RANDALL NOE ENTERPRISES INC.					
CITY OF ROCKWALL, TEXAS					
TBPE REGISTRATION NO. 000756		H HELMBERGER ASSOCIATES, INC. CIVIL AND ENVIRONMENTAL ENGINEERS <small>1525 BOZMAN ROAD, WYLIE, TEXAS 75098 (972) 442-7459</small>			
DESIGN	DRAWN	DATE	SCALE	NOTES	FILE
HELM.	CADD	APR 2015	1"=20'	PA	1507
					C2