

NOTE!  
OFFSITE GRADING PERMITTED  
SAME OWNER BOTH LOTS


CONNECT TO EXISTING 30" RCP  
FL 30' - 533.74'  
FL 18" - 534.00'  
INSTALL 3X3 DROP INLET  
W/ 3' APRON P/MT  
THROAT - 536.50'  
FL 18" - 534.00' HGL - 536.34'

NOT IN CONTRACT  
DRAINAGE SWALE - APPROX 1' DEEP  
PROPOSED 4:1 SIDE SLOPES

FIELD VERIFY PRIOR TO CONSTRUCTION  
CONNECT TO EXISTING 30" RCP  
FL EXIST 30" - 529.04'  
FL 18" - 533.50' HGL - 529.90'

FIELD VERIFY PRIOR TO CONSTRUCTION  
CONNECT TO EXISTING 30" RCP  
FL EXIST 30" - 529.04'  
FL 18" - 529.50' HGL - 529.90'

REMOVE AND DISPOSE  
OF EXISTING DROP INLET  
PLUS 18" RCP

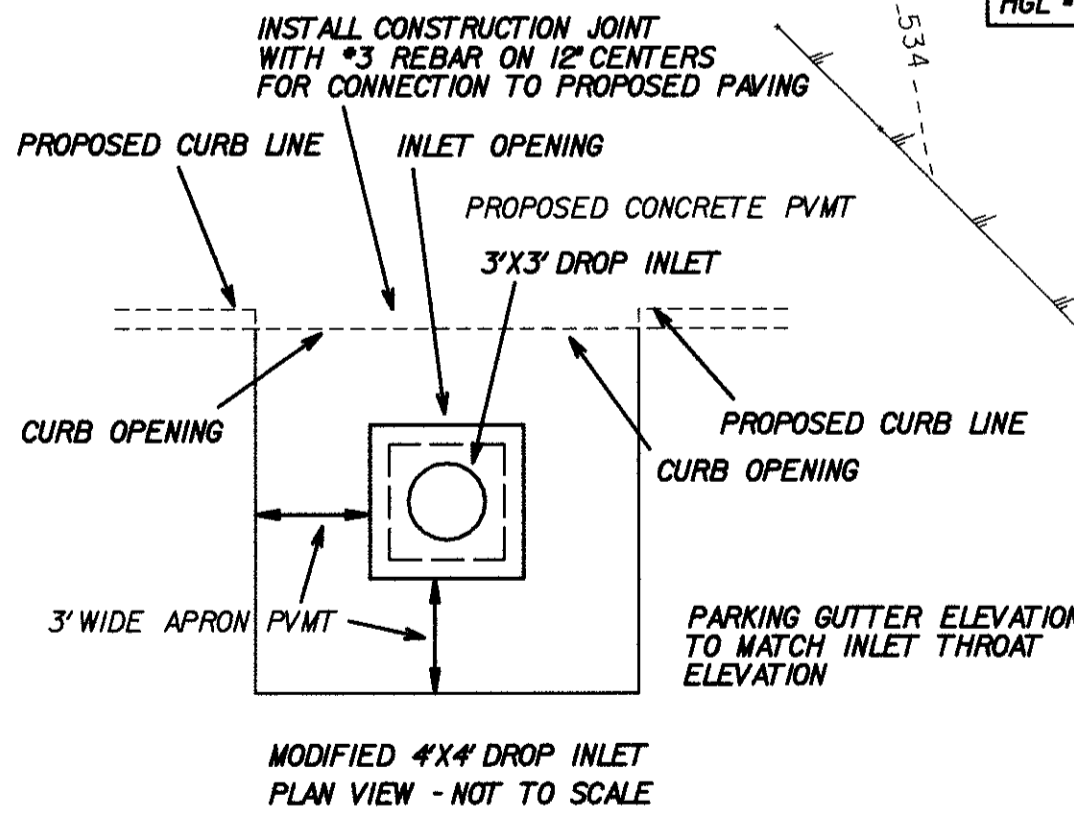


**LINE LEGEND:**

- PROPERTY LINE
- DRAINAGE FLOW
- PROPOSED WATER LINE
- ROAD CENTER LINE
- PROPOSED STORM SEWER
- PROPOSED STREET
- 610- EXISTING CONTOUR LINE
- 610- PROPOSED CONTOUR LINE
- BUILDING SETBACK LINE
- DRAINAGE EASEMENT
- DRAINAGE DIVIDE LINE
- ROW / LOT LINE
- PROPOSED FENCE

AS-BUILT DRAWING 2-15-16

THIS DOCUMENT IS SUBMITTED AS AN "AS-BUILT DRAWING" FOR RECORD PURPOSES ONLY. ANY MODIFICATION OR CHANGES THAT HAVE BEEN MADE DURING CONSTRUCTION AND NOTED ON THIS DRAWING HAVE BEEN SUPPLIED BY THE OWNER, HIS REPRESENTATIVE OR THE CONTRACTOR. FIELD INSPECTION/CONTRACT SUPERVISION OF THE CONSTRUCTION WAS PERFORMED BY OTHERS. IT IS NOT GUARANTEED BY HELMBERGER ASSOCIATES, INC. THAT THIS DOCUMENT REPRESENTS "AS-BUILT" CONDITIONS. TPBE FIRM NO. 000758

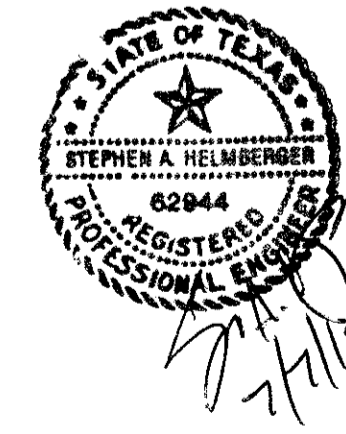

OWNER:  
RANDALL NOE ENTERPRISES INC.  
P.O. BOX 369  
ROCKWALL, TEXAS 75087  
MR. ROB WHITTLE  
(972) 771-5253

ENGINEER:  
HELMBERGER ASSOCIATES, INC.  
1525 BOZMAN ROAD  
WYLIE, TEXAS 75098  
MR. STEPHEN A. HELMBERGER, P.E.  
(972) 442-7459

GRADING AND DRAINAGE PLAN						
LOT 11 BLOCK 2 - ALLIANCE ADDITION PH 2						
RANDALL NOE ENTERPRISES INC.						
CITY OF ROCKWALL, TEXAS						
TPBE REGISTRATION NO. 000758	<b>H HELMBERGER ASSOCIATES, INC.</b> CIVIL AND ENVIRONMENTAL ENGINEERS 1525 BOZMAN ROAD, WYLIE, TEXAS 75098 (972) 442-7459					
DESIGN	DRAWN	DATE	SCALE	NOTES	FILE	NO.
HELM.	CADD	APR 2015	1"=20'	GDA	1507	C3