

VICINITY MAP
NOT TO SCALE

LINE LEGEND:


	PROPERTY LINE
	DRAINAGE FLOW
	PROPOSED WATER LINE
	ROAD CENTER LINE
	PROPOSED STORM SEWER
	PROPOSED STREET
	EXISTING CONTOUR LINE
	PROPOSED CONTOUR LINE
	BUILDING SETBACK LINE
	DRAINAGE EASEMENT
	DRAINAGE DIVIDE LINE
	ROW / LOT LINE
	PROPOSED FENCE

STRIPING - FIRELANE APPARATUS ROADS SHALL BE MARKED BY PAINTED LINES OF RED TRAFFIC PAINT (6") IN WIDTH TO SHOW THE BOUNDARIES OF THE LANE. THE WORDS "NO PARKING FIRE LANE" OR "FIRE LANE NO PARKING" SHALL APPEAR IN FOUR INCH (4") WHITE LETTERS AT 25'-INTERVALS ON THE RED BORDER MARKINGS ALONG BOTH SIDES OF THE FIRE LANES. WHERE A CURB IS AVAILABLE, THE STRIPING SHALL BE ON BOTH THE VERTICAL AND HORIZONTAL FACES OF THE CURB.

NOTE:
ALL DIMENSIONS ARE TO BACK OF CURB

AS-BUILT DRAWING 01-23-14

To the best of our knowledge, Helmberger Associates, Inc., states that this plan is representative of asbuilt conditions. This information is based on a visual observations and limited surveying of post construction conditions at the site and information provided by the Owner and Contractor. Field inspection and construction supervision was performed by others.

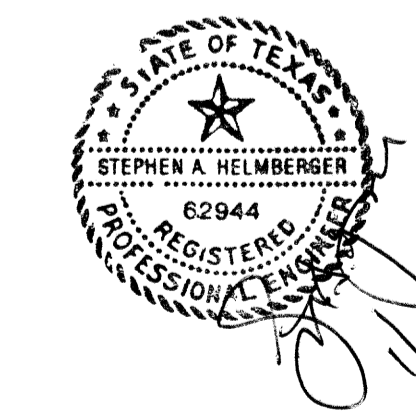

OWNER:
RANDALL NOE ENTERPRISES INC.
P.O. BOX 369
ROCKWALL, TEXAS 75087
MR. ROB WHITTLE
(972) 771-5253

ENGINEER:
HELMBERGER ASSOCIATES, INC.
1525 BOZMAN ROAD
WYLIE, TEXAS 75098
MR. STEPHEN A. HELMBERGER, P.E.
(972) 442-7459

PAVING AND UTILITY PLAN						
LOTS 11 & 12 BLOCK 2 - ALLIANCE ADDITION PH 2						
RANDALL NOE ENTERPRISES INC.						
CITY OF ROCKWALL, TEXAS						
TYPE REGISTRATION NO. 000756						
HELMBERGER ASSOCIATES, INC. CIVIL AND ENVIRONMENTAL ENGINEERS 1025 BOZMAN ROAD, WYLIE, TEXAS 75098 (972) 442-7459						
DESIGN	DRAWN	DATE	SCALE	NOTES	FILE	NO.
HELM.	CADD	JAN 2014	1"=20'	PBORDER	1308	C2