

INSTALL:
2' CONCRETE FLUME
PER "MISC. CONSTRUCTION
DETAILS" SHEET

INSTALL:
16 C.Y. GROUTED
ROCK RIP-RAP TPOOT
432 TYPE R WITH
GEOTEXTILE MAT BELOW

ON-SITE IMPROVEMENTS
REFERENCE "STORM DRAINAGE
PLAN" SHEET C-14


INSTALL:
2' CONCRETE FLUME
PER "MISC. CONSTRUCTION
DETAILS" SHEET

FOR CONTINUATION,
SEE "OFF-SITE GRADING
AND DETENTION POND PLAN"

JEFF BOYD ROAD

ALLIANCE DRIVE

F.M. HIGHWAY 549

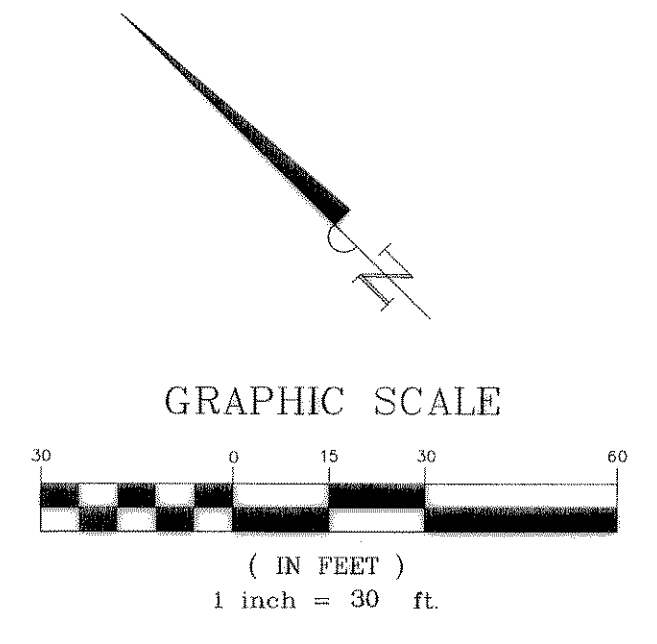

LEGEND

---	EXISTING CONTOUR LINE
—	PROPOSED CONTOUR LINE
x 500.00	SPOT ELEVATION
TC	TOP OF CURB GRADE
—	PROPOSED RETAINING WALL
⊕	TELEPHONE MANHOLE
△	BURIED TELE. CABLE MARKER

GRADES SHOWN OUTSIDE OF PAVED AREAS ARE FOR BIDDING PURPOSES ONLY. REFERENCE LANDSCAPE PLANS FOR FINE GRADING IN OFF-PAVING AREAS AND FENCING (TYP.)

ALL PROPOSED GRADES AND CONTOURS ARE TOP OF PAVING UNLESS OTHERWISE NOTED.

EXCESS CUT MATERIAL SHALL NOT BE REMOVED OFF-SITE WITHOUT PRIOR CONSENT FROM OWNER.

ALL SIDEWALKS AND ACCESSIBLE ROUTES SHALL NOT EXCEED 5% RUNNING SLOPE, 2% CROSS SLOPE, OR 8.33% FOR RAMPS. CONTRACTOR SHALL FIELD VERIFY THAT THESE CRITERIA WILL BE MET.

BENCHMARK #1 (BM1)
TOP OF FLANGE NUT ON CONCRETE BASE OF
LIGHT POLE OF THE FOOTBALL FIELD AND TRACK
AT THE NORTHWEST END.
E.L. = 529.40

RECORD DRAWING
THIS DRAWING IS TO BE USED AS A RECORD DRAWING TO THE BEST OF THE DESIGN ENGINEER'S KNOWLEDGE, THE APPROXIMATE LOCATION OF THE CONSTRUCTED WORK, USING INFORMATION SUPPLIED BY THE INFORMATION CONTRACTORS.

No.	Date	Revisions	App.

Kimley-Horn and Associates, Inc.
17700 Fort Central Drive, Suite 1800
Dallas, Texas 75241
Tel. No. (972) 770-1300
Fax No. (972) 259-5820

**ALLIANCE
ROCKWALL COUNTY
CITY OF ROCKWALL, TEXAS**

GRADING PLAN - 1

Scale: 1" = 30'

Designed by: KHA
Drawn by: MSM
Checked by: NES
Date: SEPTEMBER 2005
Project No.: 06-4015000

SHEET
C-7