



**LEGEND**

	DESIGNATES PROPOSED FIRELANE, REFERENCE GENERAL NOTES & CITY DETAILS FOR CONSTRUCTION
	<ul style="list-style-type: none"> <li>* PROPOSED 5' PORTLAND CEMENT CONCRETE, MIN. 28 DAY COMPRESSIVE STRENGTH OF 3000 PSI WITH #3 BARS ON 18" C.C.E.W. OVER 6" LIME STABILIZED SUBGRADE. (PARKING SPACES RECEIVING AUTOMOBILES AND LIGHT TRUCKS)</li> </ul>
	<ul style="list-style-type: none"> <li>* PROPOSED 6' PORTLAND CEMENT CONCRETE, MIN. 28 DAY COMPRESSIVE STRENGTH OF 3600 PSI WITH #3 BARS ON 18" C.C.E.W. OVER 6" LIME STABILIZED SUBGRADE. (SIX SACK MIN. FOR MACHINE POURS AND 5.5 SACK MIN. FOR HAND POURS.) (DRIVING LANES WITH MEDIUM TO LIGHT TRAFFIC AND FIRELANES)</li> </ul>
	<ul style="list-style-type: none"> <li>* PROPOSED 7' PORTLAND CEMENT CONCRETE, MIN. 28 DAY COMPRESSIVE STRENGTH OF 3600 PSI WITH #3 BARS ON 18" C.C.E.W. OVER 6" LIME STABILIZED SUBGRADE. (SIX SACK MIN. FOR MACHINE POURS AND 5.5 SACK MIN. FOR HAND POURS.) (DUMPSTER PAD)</li> </ul>
	<ul style="list-style-type: none"> <li>* ALL PROPOSED ON-SITE PAVEMENT SHALL COMPLY WITH THE GEOTECHNICAL ENGINEERING REPORT BY ALPHA TESTING, PROJECT NO. 004764 DATED SEPTEMBER 1, 2004 OR LATEST EDITION, AND THE CITY OF ROCKWALL REQUIREMENTS FOR FIRE LANES. IF IN CONFLICT, THE MORE RESTRICTIVE STANDARD SHALL APPLY.</li> </ul>

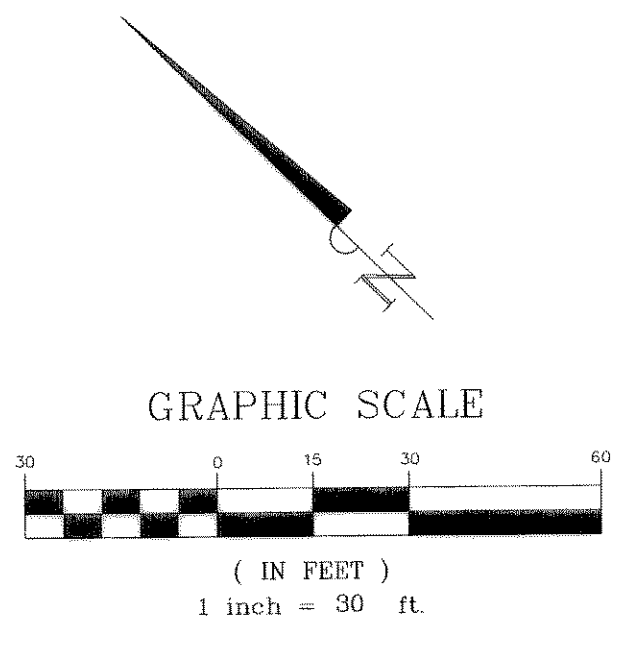

**RECORD DRAWING**  
 THIS RECORD DRAWING HEREIN REFLECTS TO THE BEST OF THE DESIGN ENGINEER'S KNOWLEDGE, THE APPROXIMATE LOCATION OF UTILITIES AS SHOWN ON THIS DRAWING IS INFORMATION AS PROVIDED BY THE CONTRACTORS.

**Kimley-Horn and Associates, Inc.**  
 12700 Park Central Drive, Suite 1800  
 Dallas, Texas 75251  
 Tel. No. (972) 770-1300  
 Fax No. (972) 239-3520

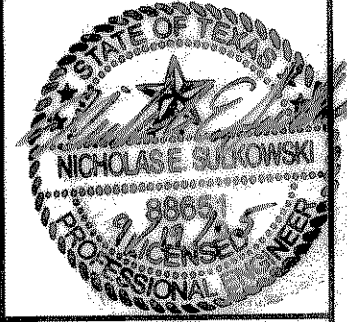

**ALLIANCE**  
**ROCKWALL COUNTY**  
**CITY OF ROCKWALL, TEXAS**

**PAVING PLAN - 1**

Scale: 1" = 30'  
 Designed by: NES  
 Drawn by: SAW  
 Checked by: NES  
 Date: SEPTEMBER 2005  
 Project No. 064015000

BENCHMARK #1 (BM1)  
 TOP OF FLANGE NUT ON CONCRETE BASE OF LIGHT POLE OF THE FOOTBALL FIELD AND TRACK AT THE NORTHWEST END.  
 EL. = 529.40

SHEET  
 C-18

Approved for the City of Rockwall: [Signature] 9/12/2005