

RECORD DRAWING
THIS RECORD DRAWING IS TO BE USED TO THE BEST OF THE DESIGN ENGINEER'S KNOWLEDGE, THE APPROXIMATE LOCATION OF THE CONSTRUCTION SHALL BE DETERMINED BY THE CONTRACTOR.

No. _____ Date _____ Revisions _____
App. _____



ALLIANCE
ROCKWALL COUNTY
CITY OF ROCKWALL, TEXAS

CITY OF ROCKWALL
STANDARD DETAILS
PAVING - 3

Scale: N/A
Designed by: KHA
Drawn by: KHA
Checked by: NES
Date: SEPTEMBER 2005
Project No. 06-4015000

SHEET
C-23

File: C:\G:\V4015000\W001-CITY-PAVING.dwg [L:pen] 8/17/2005 10:28:00 AM

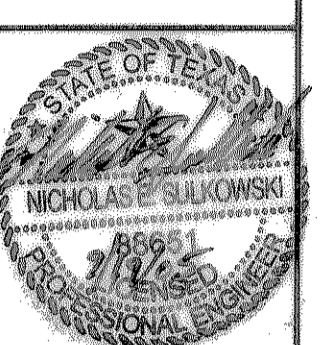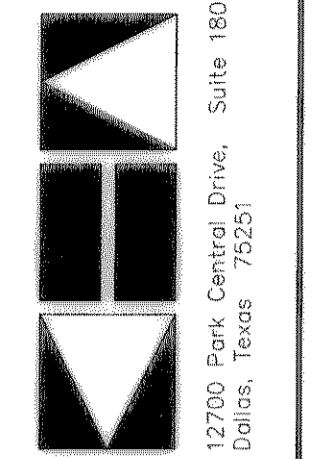

19700 Park Center Drive, Suite 1800
Dallas, Texas 75228
Tel. No. (972) 770-1900
Fax No. (972) 239-3920

Kimley-Horn
and Associates, Inc.