

BENCHMARK #1 (BM1)  
 TOP OF FLANGE NUT ON CONCRETE BASE OF  
 LIGHT POLE OF THE FOOTBALL FIELD AND TRACK  
 AT THE NORTHWEST END.  
 EL. = 529.40

**RECORD DRAWING**  
 THIS RECORD DRAWING REFLECTS  
 TO THE BEST OF THE DESIGN ENGINEER'S  
 KNOWLEDGE AND BELIEFS, THE ACCURATE  
 LOCATION AND DEPTH OF ALL UTILITIES  
 INFORMATION AS PROVIDED BY THE  
 CONTRACTORS.


Scale: 1"=40' H., 1"=4' V.  
 Designed by: B-JG  
 Drawn by: D-LC  
 Checked by: J-RH  
 Date: SEPTEMBER 2005  
 Project No. 064015000  
 9/17/2005 10:45am

**ALLIANCE**  
**ROCKWALL COUNTY**  
**CITY OF ROCKWALL, TEXAS**

**STORM SEWER**  
**PROFILES**

SHEET  
 C-15

**Kimley-Horn**  
**and Associates, Inc.**  
 12700 Park Central Drive, Suite 1800  
 Dallas, Texas 75251  
 Tel. No. (972) 770-1300  
 Fax. No. (972) 239-3820

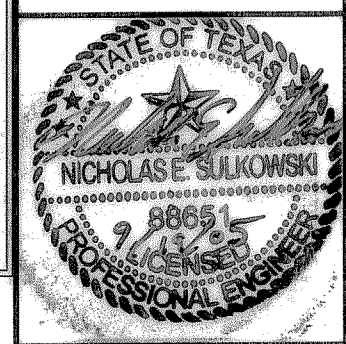

No.	Date	Revisions	App.