

STANDARD DRAWINGS OF THE STANDARD SPECIFICATIONS
FOR PUBLIC WORKS CONSTRUCTING
NORTH CENTRAL TEXAS, THIRD EDITION, DATED 1998

(CITY'S REVISIONS - AUGUST 2003)
DRAWINGS TO BE MODIFIED AS FOLLOWS:

STANDARD DRAWING NO. 2170 -

1. MAXIMUM 1-1/2" COMPACTED SAND CUSHION.

2. NO SIDEWALK ADJACENT TO CURB WITHOUT CITY APPROVAL. SIDEWALK AGAINST CURB IS FIVE (5) FEET WIDE.

STANDARD DRAWING NO. 2190


1. NUMBER 2, SUBGRADE - REPLACE "A" WITH REVISED "A". REVISED "A" TO READ: SUBGRADE UNDER ALL PAVEMENTS SHALL BE STABILIZED TO A MINIMUM DEPTH OF SIX INCHES (6") WITH HYDRATED LIME OR CEMENT. LABORATORY TESTS WILL BE PERFORMED TO DETERMINE THE AMOUNT OF LIME OR CEMENT TO BE USED.

2. NUMBER 2, SUBGRADE, DELETE "B".

3. DELETE NUMBER 3.

Kimley-Horn
and Associates,
Tel. No. (972) 770

AS PROVIDED BY THE NO.

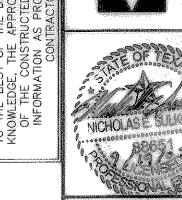

CEWALL COUNTY

CITY OF ROCKWAL STANDARD DETAILS PAVING - 2

hecked by: NES
ate: SEPTEMBER 2005
roject No. 064015000

SHEET

C-22