


Sanitary Sewer Curve Data

Curve	Stationing	Radius	Length
Curve 1	Δ=12°13'25"	R=200.0'	L=42.61'
Curve 2	Δ=13°16'00"	R=200.0'	L=46.91'
Curve 3	Δ=32°14'00"	R=200.0'	L=112.52'

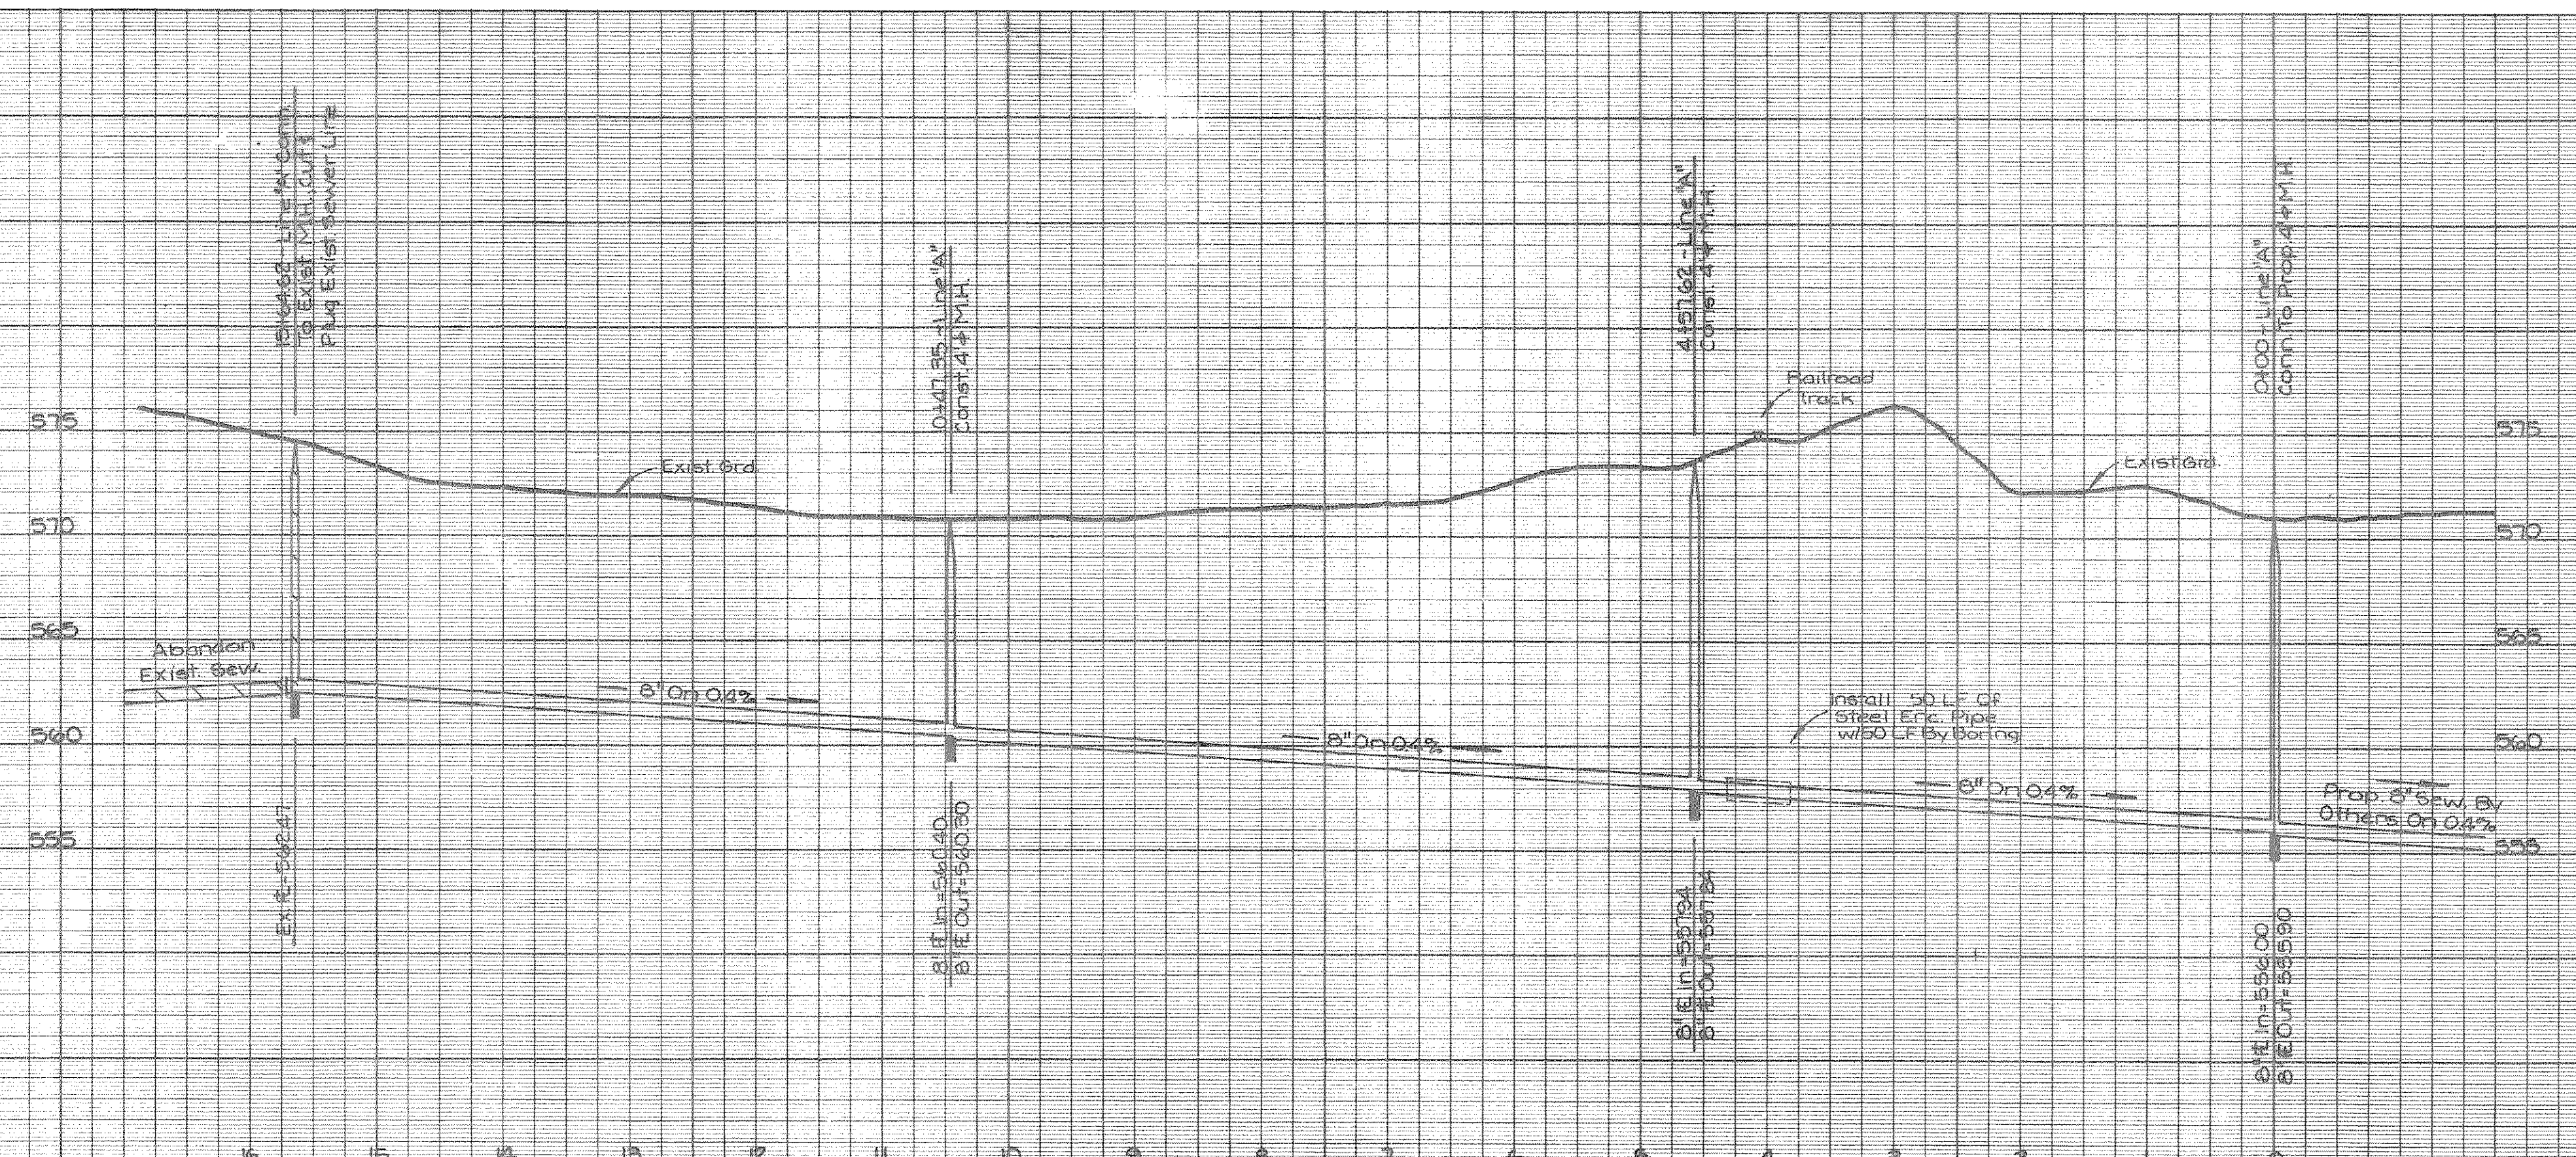

OFFSITE SANI. SEWER
ALUMAX INDUSTRY
ROCKWALL, TEXAS

Don A. Tipton, Inc. Consulting Engineers
 6330 Belt Line Rd. Garland, Texas 75043

DESIGN	DRAWN	DATE	SCALE	NOTES	FILE	NO.
D.A.T. INC	D.A.T. INC	10-85	1"=100'H 1"=6'V			

1