
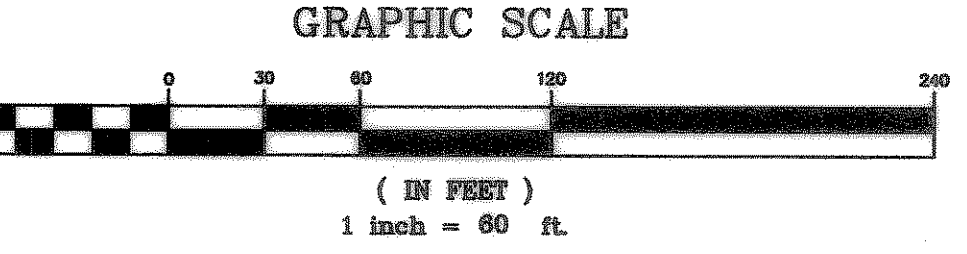


NOTE:  
LOCATION OF EXISTING 8" WATER LINE AND 24" WATER LINES ARE UNKNOWN. CONTRACTOR SHALL FIELD VERIFY THESE LOCATIONS PRIOR TO EXCAVATING FOR THE 8" WATER LINE.

GENERAL NOTES

- 1. IT SHALL BE THE RESPONSIBILITY OF THE CONTRACTOR TO LOCATE AND VERIFY ALL EXISTING UTILITIES PRIOR TO THE BEGINNING OF CONSTRUCTION TO INSURE NO CONFLICT BETWEEN ALL UTILITY LINES.
- 2. WHERE WATER PIPELINES EITHER CROSS OR OTHERWISE COME WITHIN 9 FEET OF A SANITARY SEWER PIPELINE THE SEWER PIPELINE SHALL BE OR PVC PIPE WITH A MINIMUM WORKING PRESSURE CLASS 150 PSI.
- 3. RESILIENT SEATED GATE VALVES ONLY WILL BE ALLOWED.
- 4. BLUE MARKER E. M. S. #1252 SHALL BE PLACED UNDER EACH CORPORATION STOP
- 5. WATER LINES TO BE CLASS 200 PVC - C900 (6" - 12") AND C905 (LARGER THAN 12")
- 6. FITTINGS TO HAVE MEGA LUG CONNECTIONS AT ALL BENDS (VERTICAL AND HORIZONTAL) ADD ONE JOINT EACH DIRECTION.
- 7. COMPACTION SHOULD BE 95%.
- 8. SAND EMBEDMENT.

AS BUILT

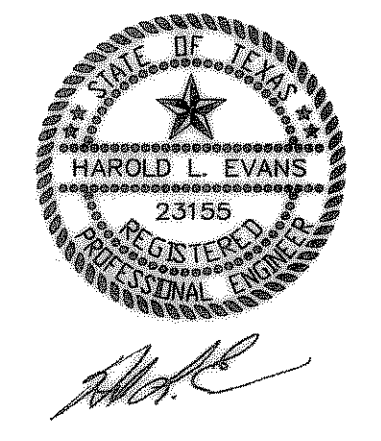

INSTALL:  
1-16" X8" TAPPING SLEEVE AND VALVE  
REINFORCED CONCRETE CYLINDER PIPE  
TAP TO BE BY HANSON PIPE

NOTE:  
LOCATION OF 16" WATER LINES ARE UNKNOWN.  
CONTRACTOR SHALL FIELD VERIFY THESE  
LOCATIONS PRIOR TO EXCAVATING FOR THE 8"  
WATER LINE.

DRAGO RAKICH &  
CHRISTIAN RAKSICH  
Vol. 1881, Pg. 124  
R.P.R.R.C.T.

REVISION DESCRIPTION 04018-AS-BUILT-WATER	DATE	SCALE	DESIGN	DRAWN
	4/14/05	1" = 60'	H.L.E.	AC
HAROLD L. EVANS CONSULTING ENGINEER P.O. BOX 23355 DALLAS, TEXAS 75226, (214) 328-8133		AS-BUILT UTILITIES BURKS PLAZA 7.09 ACRES CITY OF ROCKWALL, ROCKWALL CO., TX.		
SHEET NO.				04012