

LEGEND

- B. BOLLARD
- EM. ELECTRIC METER
- FP. POWER POLE
- LS. LIGHT STANDARD
- WM. WATER METER
- WV. WATER VALVE
- ICV. IRRIGATION CONTROL VALVE
- FH. FIRE HYDRANT
- FDC. FIRE DEPARTMENT CONNECTION
- CO. CLEAN OUT
- WM. GAS METER
- TSP. TRAFFIC SIGNAL CONTROL
- SPN. TRAFFIC SIGNAL POLE
- TR. TRAFFIC SIGN
- TE. TELEPHONE BOX
- TV. TV BOX
- FP. FLAG POLE
- L.A. LANDSCAPE AREA
- PROPERTY LINE
- O.H. POWER LINES
- TEL. U/G TELEPHONE LINES
- U/G WATER LINE
- U/G GAS LINE
- FENCE
- EXISTING CONTOURS
- PROPOSED CONTOURS
- EXISTING SPOT GRADES
- PROPOSED SPOT GRADES
- PROPOSED EROSION CONTROL
- PROPOSED DRAINAGE DIVIDES

NOTE:
FOR STORM DETAILS SEE CITY OF ROCKWALL/STANDARDS AND NTCOG

NOTE: (PRIVATE STORM LINES)
UNLESS OTHERWISE NOTED, THE STORM DRAIN LINES MAY BE OF THE FOLLOWING MATERIALS:
A. CLASS III, RCP C-76 (CIRCULAR)
B. ADS N-12
C. HANCOR HI-Q
INSTALLED IN ACCORDANCE WITH THE MANUFACTURER'S SPECIFICATIONS.

RECORD DRAWINGS:
IT WAS THE INTENT THAT THE IMPROVEMENTS SHOWN BE CONSTRUCTED ACCORDING TO THESE PLANS AS APPROVED BY THE CITY. THE LINES AND GRADES WERE SET ON THE GROUND FOR CONSTRUCTION ACCORDING TO SAID PLANS. THE CITY INSPECTED THE CONSTRUCTION. THE ENGINEER DID NOT VERIFY LINES OR GRADES AFTER CONSTRUCTION. WE ARE NOT AWARE OF ANY CHANGES OR REVISIONS TO THESE PLANS DURING CONSTRUCTION OTHER THAN THOSE SHOWN.

RANDALL P. POGUE, P.E.
TX LIC. NO. 84780

DATE: OCTOBER 16, 2006

CAUTION!
UNDERGROUND UTILITIES ARE LOCATED IN THIS AREA. 48 HOURS PRIOR TO ANY CONSTRUCTION ACTIVITIES, CONTACT LINE LOCATES FOR UTILITY INFO. CALL BEFORE YOU DIG!
TEXAS EXCAVATION SAFETY SYSTEM (TESS)
1-800-344-8377
TEXAS ONE CALL SYSTEMS
1-800-245-4545
LONE STAR NOTIFICATION CENTER
1-800-669-8344 EXT. 5

BEFORE YOU DIG...

FRANCHISE UTILITY NOTES:
1. TXU ELECTRIC - (972) 771-3979 - JOE PECINA
2. ATMOS ENERGY (GAS) - (972) 485-6277 - MS. DINAH WOOD
3. SBC - (903) 457-2092 - CAROLYN NAYLOR
4. CHARTER COMM. (CABLE) - (817) 509-6272 x6896 - HECTOR EUZONDO

BENCH MARK LIST:
BENCHMARK: SQUARE CUT ON THE TOP OF THE WEST END OF A CONCRETE HEADWALL AT THE INTERSECTION OF THE WEST RIGHT-OF-WAY LINE OF STATE HIGHWAY NO. 205 AND THE SOUTH RIGHT-OF-WAY LINE OF CARUTH LANE. ELEVATION = 481.95
REFERENCE NAVD 88


NO.	DATE	REVISION / DESCRIPTION	SCALE	NOTES
10-16-06		RECORD DRAWINGS		
05-26-06		REVISED TO COMPLY WITH ADA COMMENTS		
05-19-06		MODIFIED TO 8"x8" CUT IN TEE		
04-17-06		ADDED FIRE HYDRANT TO NORTH LANDSCAPE ISLAND		

OWNER
AMERICAN NATIONAL BANK OF TEXAS
P.O. BOX 40
TERRELL, TEXAS 75160
MR. MIKE CRONIN
(214) 863-6532 PHONE
(214) 863-5704 FAX

PROJECT INFORMATION
AMERICAN NATIONAL BANK OF TEXAS
1.07± ACRE TRACT
BLOCK A, LOT 2, BURKS ADDITION
CITY OF ROCKWALL, ROCKWALL COUNTY, TEXAS
J.H.B. JONES SURVEY, ABSTRACT NO. 124
PROPOSED: BANK

THE SEAL APPEARING ON THIS DOCUMENT WAS AUTHORIZED BY RANDALL P. POGUE, P.E. 84780 ON 04-17-06. ALTERATION OF A SEALED DOCUMENT WITHOUT PROPER NOTIFICATION TO THE RESPONSIBLE ENGINEER IS AN OFFENSE UNDER THE TEXAS ENGINEERING PRACTICE ACT.

RANDALL P. POGUE, P.E.
TX LIC. NO. 84780

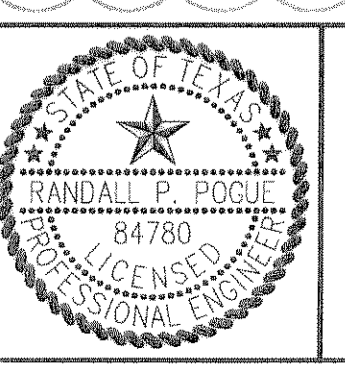

POGUE
ENGINEERING & DEVELOPMENT COMPANY, INC.

1515 HERITAGE DRIVE
SUITE 105
MCKINNEY, TEXAS 75069

(214) 544-8880 PHONE
(214) 544-8882 FAX
r.pogue@pogueengineering.com

STORM SEWER PLAN

AMERICAN NATIONAL BANK OF TEXAS
BLOCK A, LOT 2, BURKS ADDITION
J.H.B. JONES SURVEY, ABSTRACT NO. 124
CITY OF ROCKWALL, TEXAS

SHEET NO. C5.01

T:\1111\1013\2006 - 10-15-06
 SA 1005\1200-1269\1269-05-015.DWG
 © POGUE ENGINEERING & DEVELOPMENT COMPANY, INC. 2006. ALL RIGHTS RESERVED. THE ENGINEERING DESIGN, DETAIL AND ENGINEERING DRAWINGS FOR THIS PROJECT AND/OR OVERALL PROJECT ARE THE LEGAL PROPERTY OF POGUE ENGINEERING & DEVELOPMENT COMPANY, INC. THEIR USE FOR REPRODUCTION, CONSTRUCTION, OR DISTRIBUTION IS PROHIBITED UNLESS AUTHORIZED IN WRITING BY POGUE ENGINEERING & DEVELOPMENT COMPANY, INC.