


WILLIAMS, 10/13/2006 - 10:16AM  
 S:\005\1200-1299\1269-06-015.DWG\1269-07A.DWG  
 © POGUE ENGINEERING & DEVELOPMENT COMPANY, INC. 2006. ALL RIGHTS RESERVED. THE ENGINEERING DESIGN, DETAIL AND ENGINEERING DRAWINGS FOR THIS PROJECT AND/OR OVERALL PROJECT ARE THE LEGAL PROPERTY OF POGUE ENGINEERING & DEVELOPMENT COMPANY, INC. THEIR USE FOR REPRODUCTION, CONSTRUCTION OR DISTRIBUTION IS PROHIBITED UNLESS AUTHORIZED IN WRITING BY POGUE ENGINEERING & DEVELOPMENT COMPANY, INC.

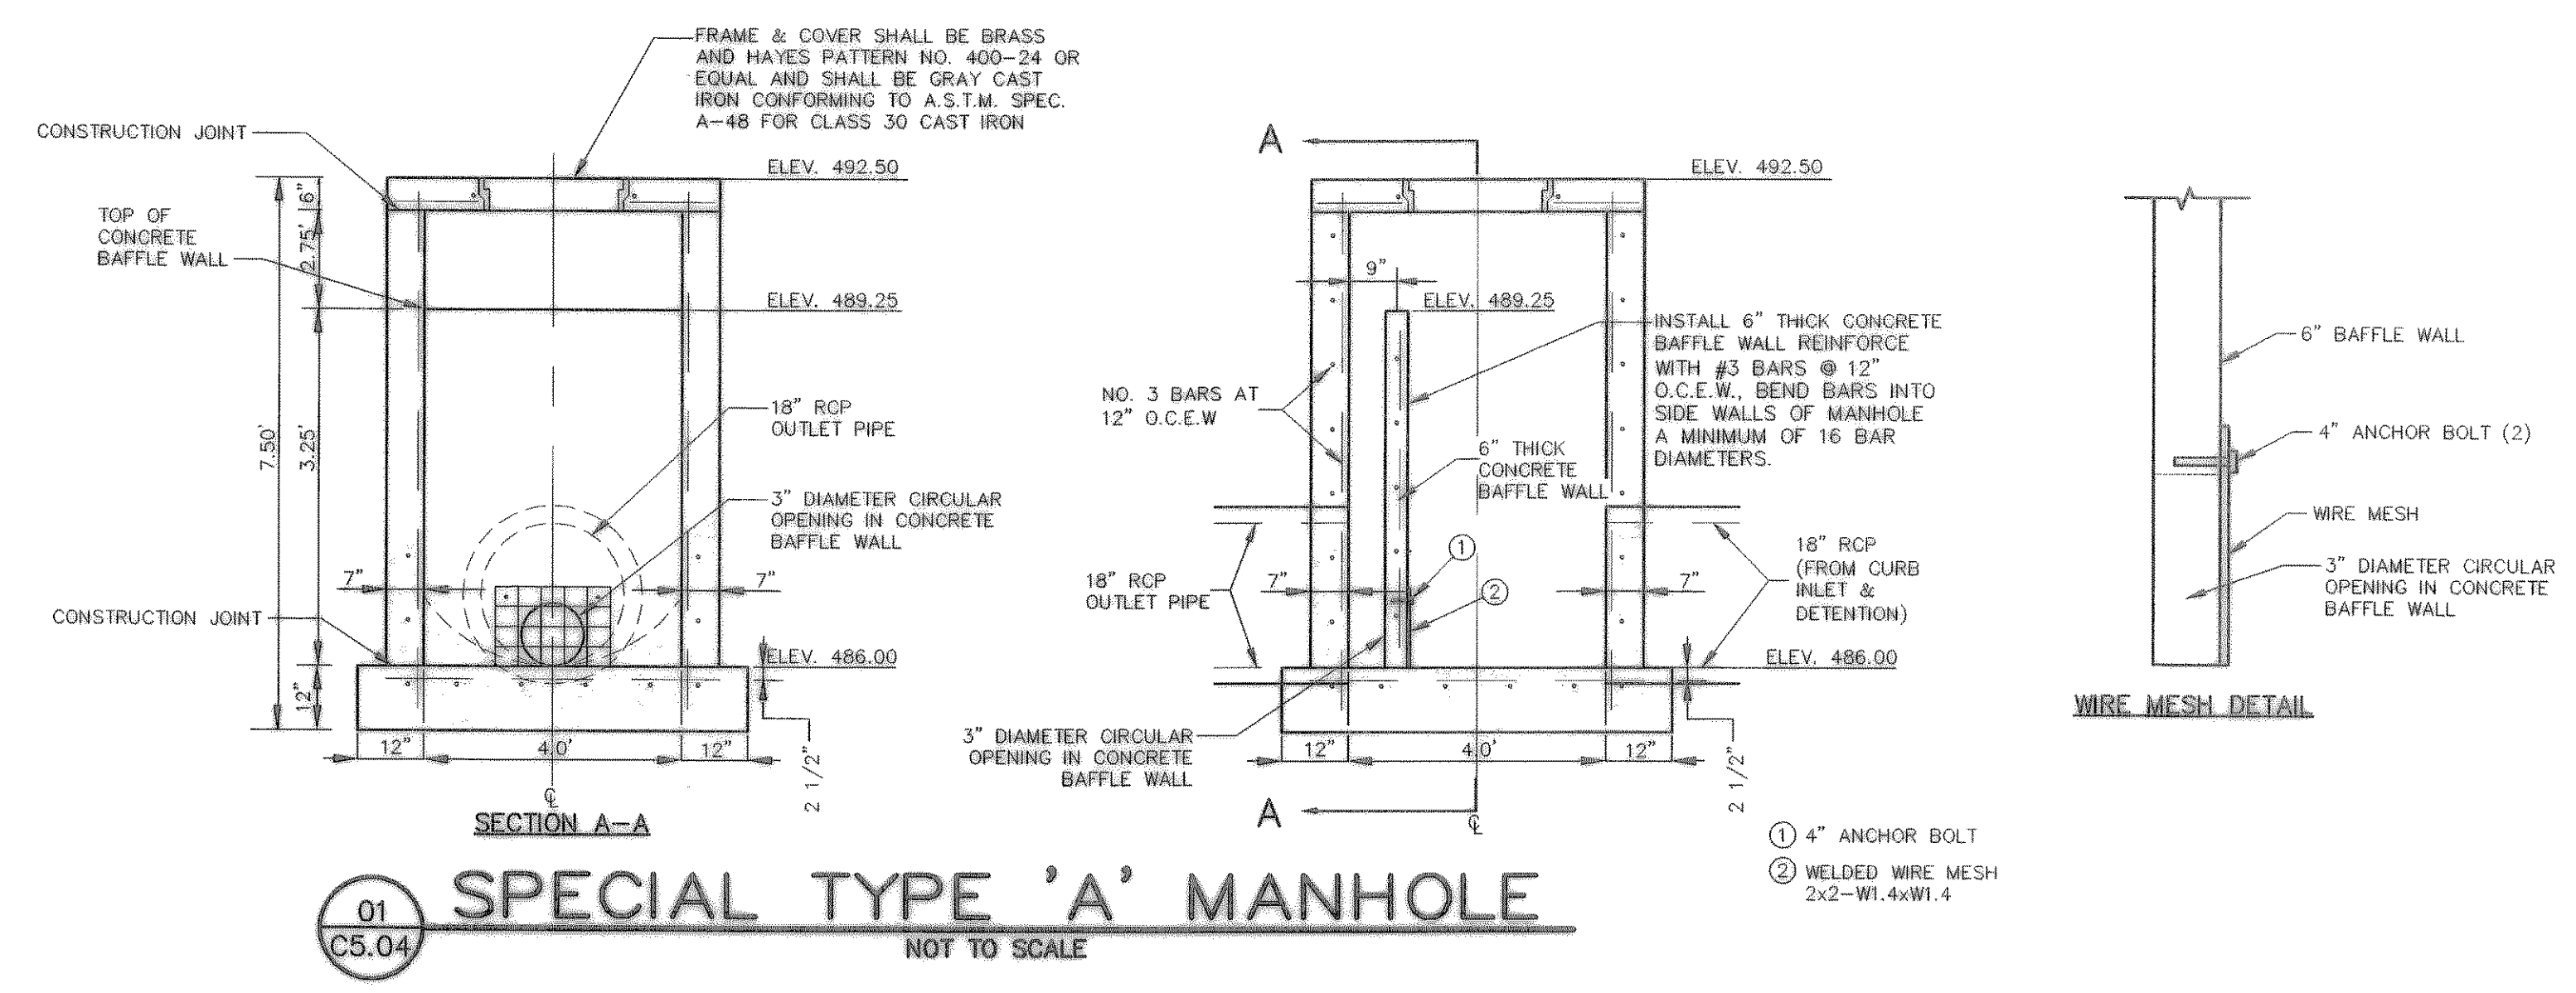

**NOTE:**  
FOR ALL OTHER STORM DETAILS SEE CITY OF ROCKWALL/STANDARDS AND NTCOG

**RECORD DRAWINGS:**  
 IT WAS THE INTENT THAT THE IMPROVEMENTS SHOWN BE CONSTRUCTED ACCORDING TO THESE PLANS AS APPROVED BY THE CITY. THE LINES AND GRADES WERE SET ON THE GROUND FOR CONSTRUCTION ACCORDING TO SAID PLANS. THE CITY INSPECTED THE CONSTRUCTION. THE ENGINEER DID NOT VERIFY LINES OR GRADES AFTER CONSTRUCTION. WE ARE NOT AWARE OF ANY CHANGES OR REVISIONS TO THESE PLANS DURING CONSTRUCTION OTHER THAN THOSE SHOWN.  
 RANDALL P. POGUE, P.E. DATE: OCTOBER 16, 2006  
 TX LIC. NO. 84780


NO.	DATE	REVISION / DESCRIPTION
10-16-06		RECORD DRAWINGS
05-26-06		REVISED TO COMPLY WITH ADA COMMENTS
05-19-06		MODIFIED TO 8"x8" CUT IN TEE
04-17-06		ADDED FIRE HYDRANT TO NORTH LANDSCAPE ISLAND

DESIGN	DRAWN	DATE	SCALE	NOTES
RPP	BEC/WTW	04-17-06	AS SHOWN	-

**OWNER**  
 AMERICAN NATIONAL BANK OF TEXAS  
 P.O. BOX 40  
 TERRELL, TEXAS 75160  
 MR. MIKE CRONIN  
 (214) 863-6532 PHONE  
 (214) 863-5704 FAX

**PROJECT INFORMATION**  
 AMERICAN NATIONAL BANK OF TEXAS  
 1.07± ACRE TRACT  
 BLOCK A, LOT 2, BURKS ADDITION  
 CITY OF ROCKWALL, ROCKWALL COUNTY, TEXAS  
 J.H.B. JONES SURVEY, ABSTRACT NO. 124  
 PROPOSED: BANK

THE SEAL APPEARING ON THIS DOCUMENT WAS AUTHORIZED BY RANDALL P. POGUE, P.E. 84780 ON 04-17-06 ALTERATION OF A SEALED DOCUMENT WITHOUT PROPER NOTIFICATION TO THE RESPONSIBLE ENGINEER IS AN OFFENSE UNDER THE TEXAS ENGINEERING PRACTICE ACT.  
*R.P.P. 4-17-06*

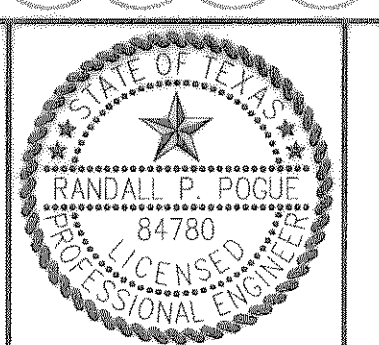

**POGUE**  
 ENGINEERING & DEVELOPMENT COMPANY, INC.  
 1515 HERITAGE DRIVE  
 SUITE 105  
 MCKINNEY, TEXAS 75069  
 (214) 544-8880 PHONE  
 (214) 544-8882 FAX  
 rpogue@pogueengineering.com

**STORM SEWER DETAILS**  
 AMERICAN NATIONAL BANK OF TEXAS  
 BLOCK A, LOT 2, BURKS ADDITION  
 J.H.B. JONES SURVEY, ABSTRACT NO. 124  
 CITY OF ROCKWALL, TEXAS

SHEET NO.  
**C5.04**