

CONSTRUCTION PLANS FOR ARBOR HOUSE ASSISTED LIVING LOT 7, BLOCK C HORIZON RIDGE MEDICAL PARK IN CITY OF ROCKWALL, TEXAS

SHEET INDEX

- G-1 COVER SHEET
- G-2 HORIZON CONTROL PLAN
- C-1 SITE PLAN
- C-2 DRAINAGE AREA MAP
- C-3 GRADING PLAN
- C-4 STORM DRAINAGE PLAN AND PROFILE
- C-5 PAVING PLAN
- C-6 UTILITY PLAN

**STANDARD CONSTRUCTION DETAILS FOR CITY OF ROCKWALL NOT INCLUDE IN THIS SET

**MAYOR
BILL CECIL**

CITY COUNCIL

**STEPHEN STRAUGHAN, Mayor Pro Tem
MARGO NIELSEN
GLEN FARRIS**

**MATT SCOTT
DAVID SWEET
CLIFF SEVIER**

**CITY MANAGER
JULIE COUCH**

**DIR OF PUBLIC WORKS & CITY ENGINEER
CHUCK TODD, P.E.**

**PROJECT ENGINEER
PANN S. SRIBHEN, P.E.**




**OWNER
ARBOR HOUSE
2401 TEE CIRCLE, SUITE 103
NORMAN, OK 73069
(405) 801-2879**

**DEVELOPER
DONICA DEVELOPMENT AND
CONSTRUCTION COMPANY
112 SOUTH 12TH STREET
CORSICANA, TX 75110
(903) 654-1114**

AS BUILT

THIS IS TO CERTIFY THAT CHANGES AND CORRECTIONS HAVE BEEN MADE TO CONFORM TO THE CONTRACTOR'S RECORD OF THIS PROJECT.

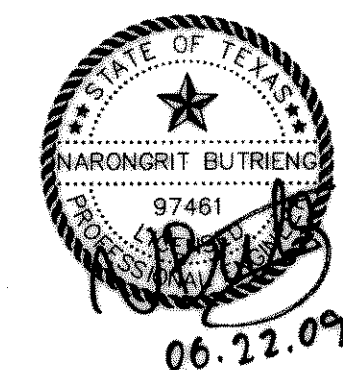

SHEET
G-1

JUNE 15, 2009

AS BUILT

Y:\2007\2485\ARHOR\SITE CIVIL\AS BUILT\G-1.dwg