


SITE IMPROVEMENT PLANS
for
BACON PLUMBING OFFICE
2055 Kristy Lane
Lot 1-M, 3.54 ACRES
City of Rockwall
Rockwall County, Texas

INDEX

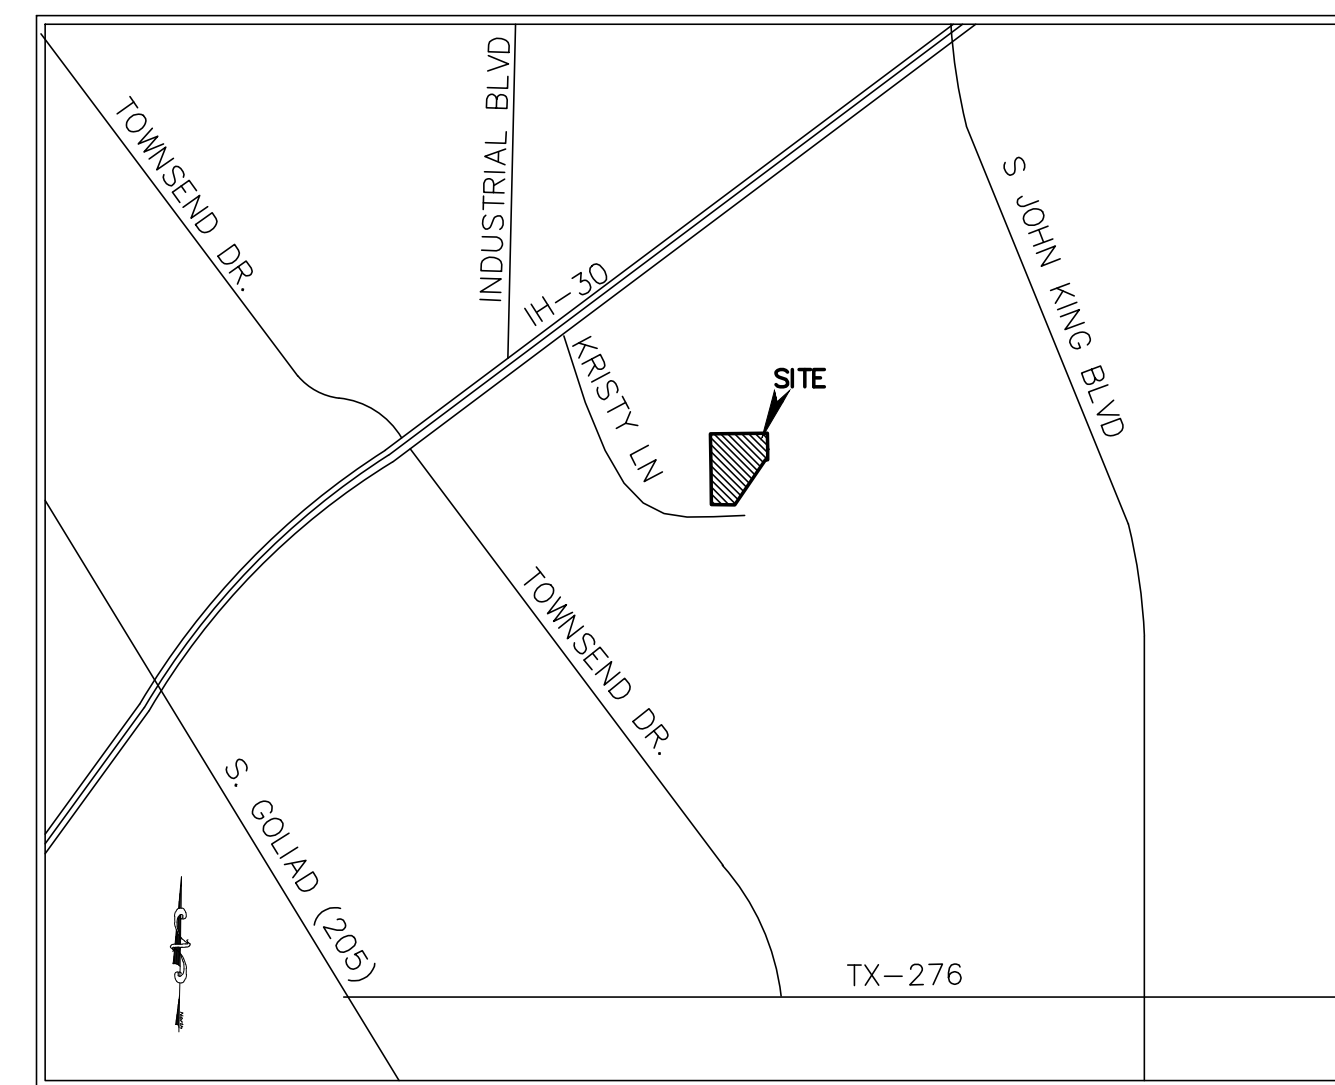

Location Map

| SHEET NO. | DESCRIPTION |
|------------|--|
| C100 | Cover Sheet |
| | Plat |
| C101 | Site & Dimension Control Plan |
| C101A | Paving Plan |
| C102 | Site Utility Plan |
| C103 | Pre Drainage Area Plan |
| C103A | Post Drainage Area Plan |
| C104 | Grading & Drainage Plan |
| C105-C105A | Pond A Layout & Calculations |
| C106-C106A | Pond B Layout & Calculations |
| C107 | Erosion Control Plan |
| A100 | Architectural Site Plan/Landscape Plan |
| D101 | Site Details |
| | General Notes |

OWNER:
BACON PROPERTY, LLC
295 Ranch Trail, Rockwall, Texas 75032
Contact: Brad Bacon (972)236-5794

ENGINEER:
MONK CONSULTING ENGINEERS, INC.
GERALD E. MONK, P.E.
1200 W. State Street ~ Garland Texas 75040 972) 272-1763 Fax 972) 272-8761
jerry@monkconsulting.com
REG. NO.: F-2567

AS-BUILT
May 12, 2021
Gerald Monk
GERALD E. MONK, P.E.

TO THE BEST OF OUR KNOWLEDGE MONK CONSULTING ENGINEERS, INC. HEREBY STATES THAT THIS PLAN IS AS-BUILT. THE INFORMATION PROVIDED IS BASED ON SURVEYING AT THE SITE AND INFORMATION PROVIDED BY THE CONTRACTOR.

CASE #

SUBMITTAL DATE:

| | |
|-----------------|---------|
| 1 st | 5/19/20 |
| 2 nd | 8/13/20 |
| 3 rd | 8/31/20 |



| NO. | REVISIONS/CORRECTIONS DESCRIPTION | REVISE(R) ADD(A) SHT. #'S | DATED |
|-----|-----------------------------------|---------------------------|---------|
| 1 | city plan review comments | (R) ALL | 8/12/20 |
| 2 | city plan review comments | (R) ALL | 8/31/20 |
| | | | |
| | | | |

OWNER'S CERTIFICATE
(Public Dedication)

STATE OF TEXAS
COUNTY OF ROCKWALL

WHEREAS BACON PROPERTY, LLC, BEING THE OWNER OF A TRACT OF land in the County of Rockwall, State of Texas, said tract being described as follows:

BEING a part of Lot 1, BODIN INDUSTRIAL TRACT, an Addition to the City of Rockwall, Texas, according to the Plat thereof recorded in Cabinet A, Slide 347, of the Plat Records of Rockwall County, Texas, together with a Certificate of Correction of Error, as recorded in Volume 211, Page 632 of the Real Estate Records of Rockwall County, Texas, and being all of a 3.543 acres tract of land as described in a Deed to D. Armstrong Partners, LP, as recorded in Volume 3925, Page 148 of the Real Property Records of Rockwall County, Texas, and being more particularly described as follows:

BEGINNING at a 1/2" iron rod found for corner at the most easterly northeast corner of said Lot 1 and said Armstrong tract;

THENCE S. 00 deg. 32 min. 28 sec. E. along the east line of said Lot 1, a distance of 112.09 feet to a 1/2" iron rod found for corner at the southwest corner of a 2.16 acres tract of land as described in a Warranty deed to Rockwall Credit Services, LC as recorded in Volume 4314, Page 34 of the Real Property Records of Rockwall County, Texas;

THENCE S. 00 deg. 26 min. 55 sec. E. along the East line of said Armstrong tract, a distance of 72.04 feet to a 3/8" iron rod found for corner at the east most southeast corner of said Armstrong tract;

THENCE N. 89 deg. 08 min. 06 sec. W. a distance of 14.80 feet to a 3/8" iron rod found for corner;

THENCE S. 34 deg. 26 min. 18 sec. W. a distance of 361.61 feet to a 1/2" iron rod found for corner in the north right-of-way line of Kristy Lane (60' R.O.W.);

THENCE in a southwesterly direction along a curve to the left having a central angle of 84 deg. 24 min. 44 sec., a radius of 50.00 feet, a tangent of 45.35 feet, a chord of S. 77 deg. 45 min. 05 sec. W., 67.18 feet, along said right-of-way line an arc distance of 73.66 feet to a 1/2" iron rod found for corner;

THENCE N. 89 deg. 15 min. 21 sec. W. along said right-of-way line, a distance of 105.27 feet to a 1/2" iron rod found for corner at the southeast corner of a 1.01 acres tract of land as described in a Warranty deed to Michael Moore as recorded in Volume 4733, Page 269 of the Real Property Records of Rockwall County, Texas;

THENCE N. 00 deg. 49 min. 43 sec. W. a distance of 490.72 feet to a 1/2" iron rod found for corner at the northwest corner of said Armstrong tract and at the northeast corner of a 1.215 acres tract as described in a Warranty deed to Forrest B. Davis Jr. and Lisa Davis, as recorded in Volume 2293, Page 55 of the Real Property Records of Rockwall County, Texas;

THENCE N. 89 deg. 22 min. 19 sec. E. along the north boundary line of said Armstrong tract, a distance of 395.71 feet to the POINT OF BEGINNING and containing 155,294 square feet or 3.57 acres of land.

NOW, THEREFORE, KNOW ALL MEN BY THESE PRESENTS:

STATE OF TEXAS
COUNTY OF ROCKWALL

I the undersigned owner of the land shown on this plat, and designated herein as BACON ADDITION, LOT 1, BLOCK A, an Addition to the City of Rockwall, Texas, and whose name is subscribed hereto, hereby dedicate to the use of the public forever all streets, alleys, parks, water courses, drains, easements and public places thereon shown on the purpose and consideration therein expressed. I further certify that all other parties who have a mortgage or lien interest in BACON ADDITION, LOT 1, BLOCK A, have been notified and signed this plat.

I understand and do hereby reserve the easement strips shown on this plat for the purposes stated and for the mutual use and accommodation of all utilities desiring to use or using same.

I also understand the following:

- No buildings shall be constructed or placed upon, over, or across the utility easements as described herein.
- Any public utility shall have the right to remove and keep removed all or part of any buildings, fences, trees, shrubs, or other growths or improvements which in any way endanger or interfere with construction, maintenance or efficiency of their respective system on any of these easement strips; and any public utility shall at all times have the right of ingress or egress to, from and upon the said easement strips for purpose of construction, reconstruction, inspecting, patrolling, maintaining, and either adding to or removing all or part of their respective system without the necessity of, at any time, procuring the permission of anyone.
- The City of Rockwall will not be responsible for any claims of any nature resulting from or occasioned by the establishment of grade of streets in the subdivision.
- The developer and subdivision engineer shall bear total responsibility for storm drain improvements.
- The developer shall be responsible for the necessary facilities to provide drainage patterns and drainage controls such that properties within the drainage area are not adversely affected by storm drainage from the development.
- No house dwelling unit, or other structure shall be constructed on any lot in this addition by the owner or any other person until the developer and/or owner has complied with all requirements of the Subdivision Regulations of the City of Rockwall regarding improvements with respect to the entire block on the street or streets on which property abuts, including the actual installation of streets with the required base and paving, curb and gutter, water and sewer, drainage structures, storm structures, storm sewers, and alleys, all according to the specifications of the City of Rockwall; or

Until an escrow deposit, sufficient to pay for the cost of such improvements, as determined by the city's engineer and/or city administrator, computed on a private commercial rate basis, has been made with the city secretary, accompanied by an agreement signed by the developer and/or owner, authorizing the city to make such improvements at prevailing private commercial rates, or have the same made by a contractor and pay for the same out of the escrow deposit, should the developer and/or owner fail or refuse to install the required improvements within the time stated in such written agreement, but in no case shall the City be obligated to make such improvements itself. Such deposit may be used by the owner and/or developer as payments as the work progresses in making such improvements by making certified requisitions to the city secretary, supported by evidence of work done; or

Until the developer and/or owner files a corporate surety bond with the city secretary in a sum equal to the cost of such improvements for the designated area, guaranteeing the installation thereof within the time stated in the bond, which time shall be fixed by the city council of the City of Rockwall.

I further acknowledge that the dedications and/or exaction's made herein are proportional to the impact of the subdivision upon the public services required in order that the development will comport with the present and future growth needs of the City; I, my successors and assigns hereby waive any claim, damage, or cause of action that I may have as a result of the dedication of exaction's made herein.

BRAD BACON
for Bacon Property, LLC

STATE OF TEXAS
COUNTY OF ROCKWALL

Before me, the undersigned authority, on this day personally appeared BRAD BACON known to me to be the person whose name is subscribed to the foregoing instrument, and acknowledged to me that he executed the same for the purpose and consideration therein stated.

Given upon my hand and seal of office this _____ day of _____, _____.

Notary Public in and for the State of Texas

My Commission Expires: _____

SURVEYOR'S CERTIFICATE

NOW, THEREFORE KNOW ALL MEN BY THESE PRESENTS:

THAT I, Harold D. Fetty, III, R.P.L.S. No. 5034, do hereby certify that I prepared this plat from an actual and accurate survey of the land, and that the corner monuments shown thereon were properly placed under my personal supervision.

Harold D. Fetty, III
Registered Professional Land Surveyor No. 5034



RECOMMENDED FOR FINAL APPROVAL

Planning and Zoning Commission Date _____

APPROVED

I hereby certify that the above and foregoing plat of BACON ADDITION, LOT 1, BLOCK A, an addition to the City of Rockwall, Texas, an addition to the City of Rockwall, Texas, was approved by the City Council of the City of Rockwall on the ____ day of _____, _____.

This approval shall be invalid unless the approved plat for such addition is recorded in the office of the County Clerk of Rockwall, County, Texas, within one hundred eighty (180) days from said date of final approval.

Said addition shall be subject to all the requirements of the Subdivision Regulations of the City of Rockwall.

WITNESS OUR HANDS, this _____ day of _____, _____.

Mayor, City of Rockwall

City Secretary City of Rockwall

City Engineer

Date

FINAL PLAT

BACON ADDITION
LOT 1, BLOCK A

BEING A REPLAT OF
PART OF LOT 1, BLOCK A
BODIN INDUSTRIAL TRACT

3.57 ACRES/155,294 S.F.
(1 LOT)

N.M. BALLARD SURVEY, A-24
CITY OF ROCKWALL, ROCKWALL COUNTY, TEXAS

SHEET 2 OF 2

OWNER:
BACON PROPERTY, LLC
295 RANCH TRAIL
ROCKWALL, TEXAS 75032

| SYMBOL LEGEND | |
|---------------------------------------|--------------------------------|
| TV TELEVISION CABLE WIRE | TEL TEL |
| GAS METER | PHASE RISE |
| ELEC ELEC BOX SUBSTATION JUNCTION BOX | WATER METER |
| ELEC ELEC METER | WATER METER |
| LP LIGHT POLE | 1/2" IRON ROD FOUND (1 CORNER) |
| PROPERTY LINES | AP CORNER UNIT |
| FENCE | WATER TANK |


NOTE: It shall be the policy of the City of Rockwall to withhold issuing building permits until all streets, water, sewer and storm drainage systems have been accepted by the City. The approval of a plat by the City does not constitute any representation, assurance or guarantee that any building within such plat shall be approved, authorized or permit therefore issued, as required under Ordinance 83-54.

H.D. Fetty Land Surveyor, LLC

Firm Registration no. 101509-00
6770 FM 1565 ROYSE CITY, TX 75189 972-635-2255 PHONE tracy@hdfetty.com

SURVEY DATE OCTOBER 8, 2019
SCALE 1" = 40' FILE # 20090752-RP
CLIENT BACON

CITY CASE NO. P2020-

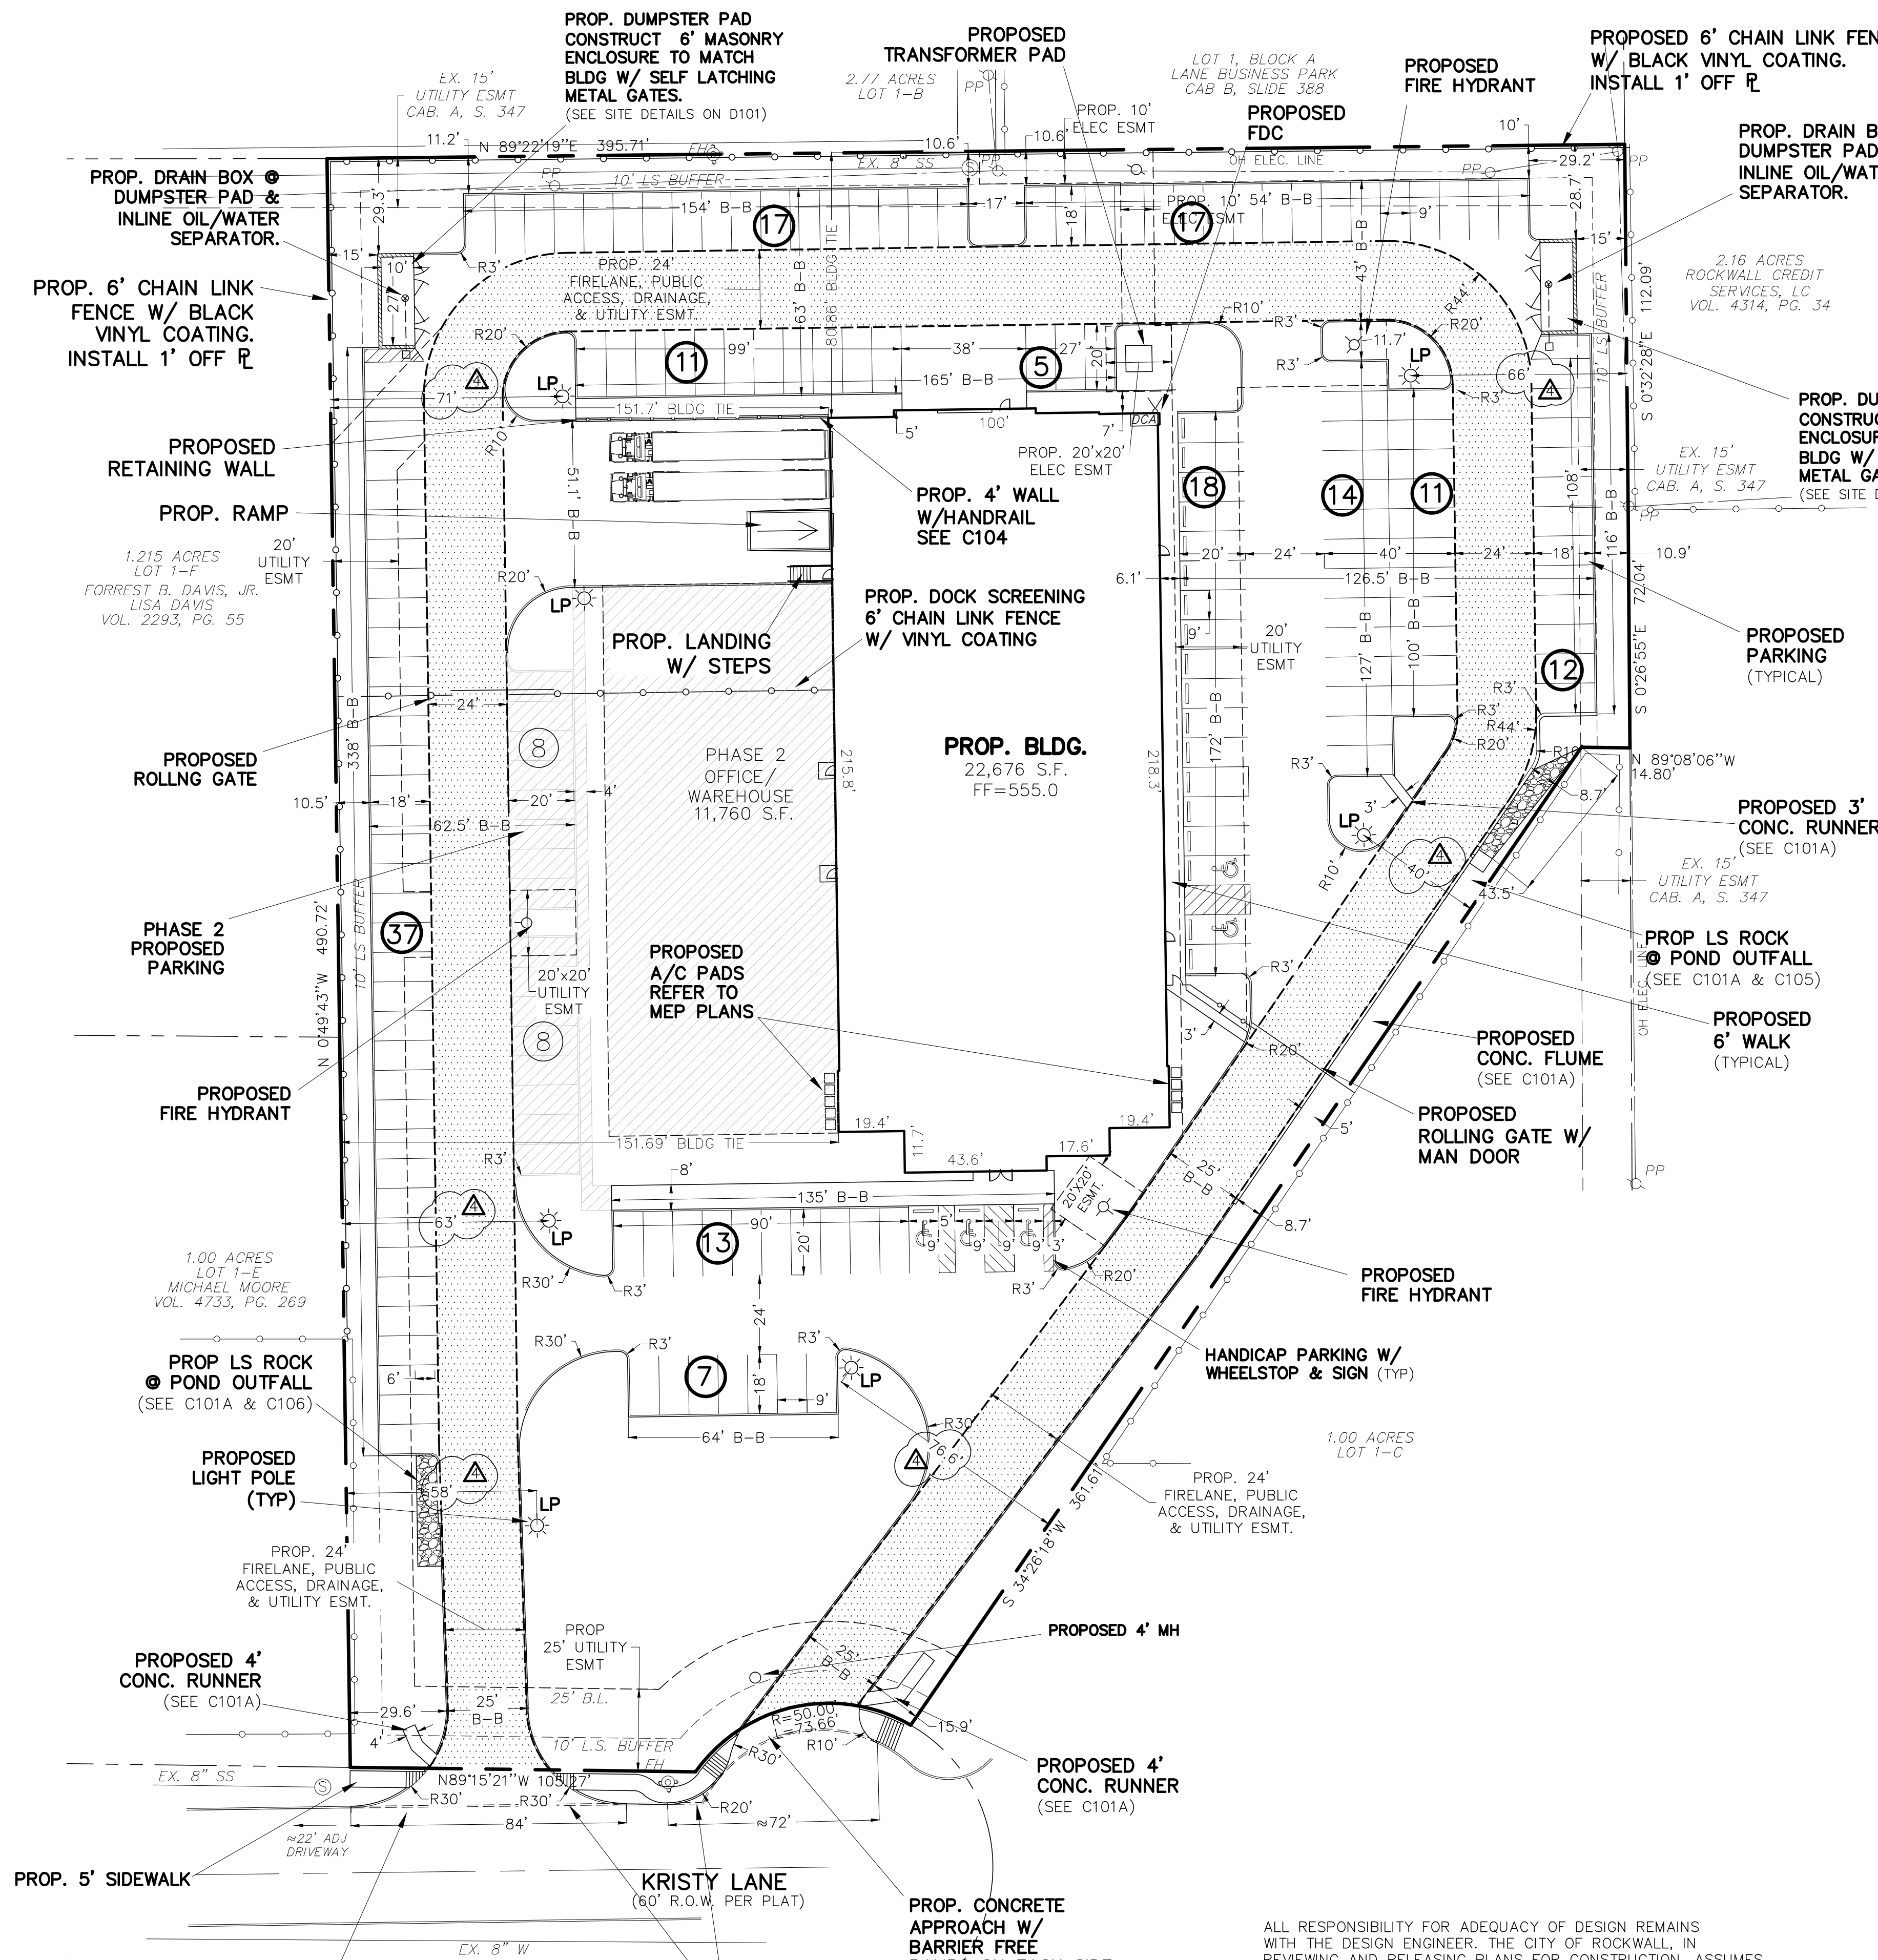



- NOTES:**
- 1) ALL WORK MUST CONFORM TO CITY OF ROCKWALL & NCTCOG STANDARDS AND DETAILS 5th EDITION.
 - 2) ALL WORK IN PUBLIC RIGHT-OF-WAY SHALL CONFORM TO CITY OF ROCKWALL STANDARDS AND DETAILS
 - 3) SEE PLAT FOR ALL INFORMATION REGARDING EASEMENTS, PROPERTY LINES, ETC.
 - 4) ALL DIMENSIONS ARE FACE OF CURB TO FACE OF CURB UNLESS OTHERWISE NOTED.

**** NOTICE TO CONTRACTORS ****

TOPOGRAPHIC INFORMATION TAKEN FROM A TOPOGRAPHIC SURVEY PERFORMED BY H.D. FETTY OF ROYSE CITY, TEXAS. THE CONTRACTOR SHALL NOTIFY THE ENGINEER IMMEDIATELY, IN WRITING, OF ANY DISCREPANCIES OR OMISSIONS TO THE TOPOGRAPHIC INFORMATION. THE CONTRACTOR(S) SHALL BE RESPONSIBLE FOR CONFIRMING THE LOCATION (HORIZONTAL/VERTICAL) OF ANY BURIED CABLES, CONDUITS, PIPES, AND STRUCTURES (STORM SEWER, SANITARY SEWER, WATER, GAS, TELEVISION, TELEPHONE, ETC.) WHICH IMPACT THE CONSTRUCTION SITE. THE CONTRACTOR(S) SHALL NOTIFY THE OWNER AND ENGINEER IF ANY DISCREPANCIES ARE FOUND BETWEEN THE ACTUAL CONDITIONS VERSUS THE DATA CONTAINED IN THE CONSTRUCTION PLANS. ANY COSTS INCURRED AS THE RESULT OF NOT CONFIRMING THE ACTUAL LOCATION (HORIZONTAL/VERTICAL) OF SAID CABLES, CONDUITS, PIPES, AND STRUCTURES SHALL BE BORNE BY THE CONTRACTOR. ADDITIONALLY, THE CONTRACTOR(S) SHALL NOTIFY THE OWNER AND ENGINEER IF ANY ERRORS OR DISCREPANCIES ARE FOUND ON THE CONSTRUCTION DOCUMENTS (PS&E), WHICH NEGATIVELY IMPACT THE PROJECT. ENGINEER AND OWNER SHALL BE INDEMNIFIED OF PROBLEMS AND/OR COST WHICH MAY RESULT FROM CONTRACTOR'S FAILURE TO NOTIFY ENGINEER AND OWNER.

SITE DATA:

LOT AREA:
3.57 Acres, 155,294 sq.ft.
LOT COVERAGE:
14.6%
FLOOR TO AREA RATIO:
6.85:1
BUILDING AREA:
Warehouse: 10,331 sq.ft.
General Office: 12,345 sq.ft.
Phase 1 TOTAL: 22,676 sq.ft.
Phase 2: 12,920 sq.ft.
BUILDING HEIGHT:
1 STORY (7')
PROPOSED FUTURE USE:
Office/Warehouse
IMPERVIOUS AREA (including buildings):
106,733 sq.ft.
ZONING:
I1
PARKING:
Required:
Office (1/300sf) = 42
Warehouse (1/1000sf) = 11
TOTAL = 53
Handicap = 3
Provided:
Standard = 120
Handicap = 5
Total Provided = 125
LANDSCAPE AREA:
Required: (15%) 23,294 sq.ft.
Provided: 48,561
FIRESPRINKLER:
YES
* THERE ARE NO EXIST. BUILDINGS ON THIS SITE
* NO TREES ON THIS SITE

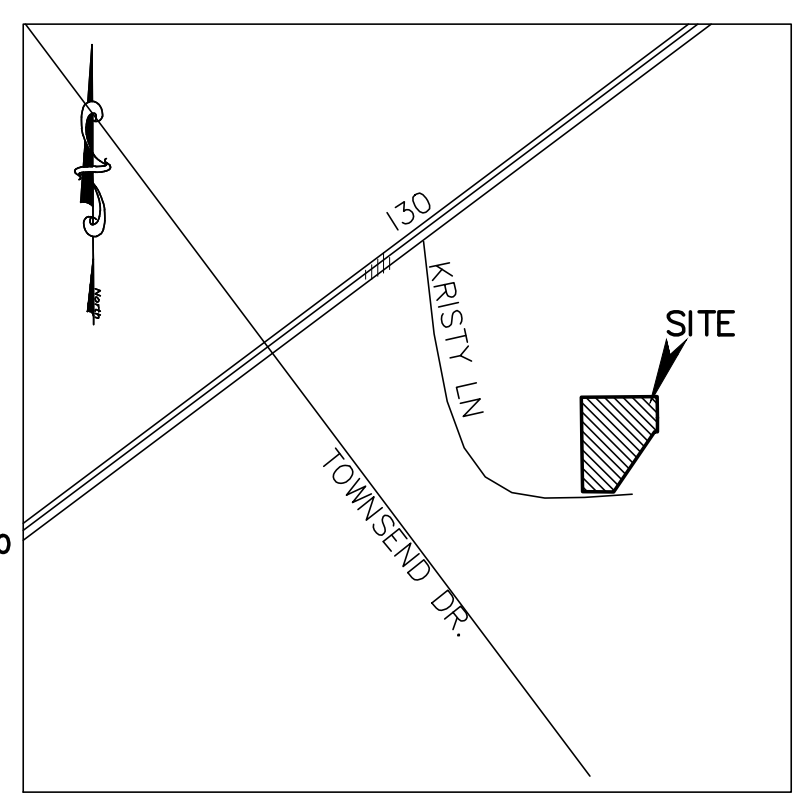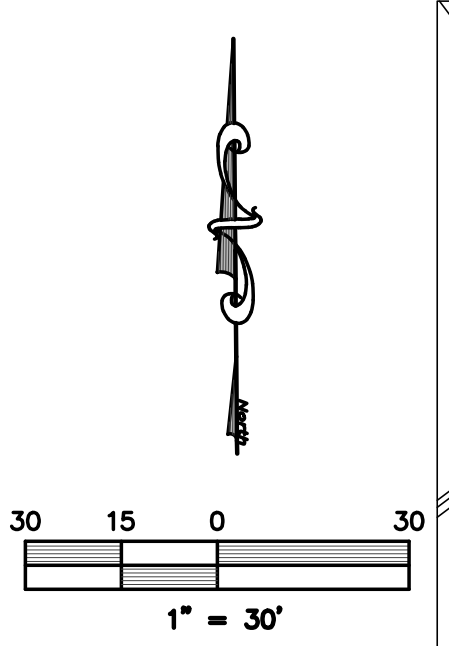

LOCATION MAP (NOT TO SCALE)

LEGEND

- = PROPERTY LINE
- EX. SS = EXISTING SANITARY SEWER LINE
- EX. W = EXISTING WATER LINE
- FH = EXISTING FIRE HYDRANT
- WM = EXISTING WATER METER
- PP = EXISTING POWER POLE
- LP = EXISTING LIGHT POLE
- T = EX. WATER VALVE
- S = EXISTING SEWER MANHOLE
- G = EXISTING GAS METER
- B-B = BACK OF CURB TO BACK OF CURB
- EXIST. or EX. = EXISTING
- PROP. = PROPOSED
- LS = LANDSCAPE
- RCP = REINFORCED CONCRETE PIPE
- min = MINIMUM
- max = MAXIMUM
- FH = PROPOSED FIRE HYDRANT
- = PROPOSED FIRELANE
- = PHASE 2

ONLY DRAWINGS STAMPED "RELEASED FOR CONSTRUCTION" BY THE CITY OF ROCKWALL TO BE USED FOR CONSTRUCTION.



CASE # SP2019-047

SITE & DIMENSION CONTROL PLAN

BACON PLUMBING OFFICE

2055 KRISTY LANE
LOT 1-M, BODIN INDUSTRIAL TRACT, 3.54 ACRES
City of Rockwall, Rockwall County, Texas

owner
BACON PROPERTY, LLC
295 RANCH TRAIL
ROCKWALL, TEXAS 75032
CONTACT: BRAD BACON (972)236-5794

prepared by
MONK CONSULTING ENGINEERS, INC.
1200 W. State Street, Garland Texas 75040
972 272-1763 Fax 972 272-8761

BENCHMARK:
PK NAIL IN CONCRETE.
NORTHING=7,021,752.890
EASTING=2,601,063.913
ELEVATION = 549.01'

WARNING:
PRIOR TO THE BEGINNING OF ANY CONSTRUCTION OR CONSTRUCTION STAKING, IT SHALL BE THE CONTRACTOR'S RESPONSIBILITY TO CONTACT THE CIVIL ENGINEER TO ENSURE THAT ALL PARTIES ARE IN POSSESSION OF THE MOST CURRENT SET OF CONSTRUCTION DOCUMENTS.

ALL RESPONSIBILITY FOR ADEQUACY OF DESIGN REMAINS WITH THE DESIGN ENGINEER. THE CITY OF ROCKWALL, IN REVIEWING AND RELEASING PLANS FOR CONSTRUCTION, ASSUMES NO RESPONSIBILITY FOR ADEQUACY OF ACCURACY OF DESIGN.

NOTE:
THE CONTRACTOR SHALL BE RESPONSIBLE FOR FIELD VERIFYING THE LOCATION OF ALL EXISTING UTILITIES AND EASEMENTS PRIOR TO START OF OPERATIONS. CONTRACTOR WILL NOTIFY THE OWNER'S REPRESENTATIVE OF ANY DISCREPANCIES PRIOR TO STARTING THE WORK. EXISTING UTILITIES AND UNDERGROUND FACILITIES INDICATED ON THESE PLANS HAVE BEEN LOCATED FROM REFERENCE INFORMATION. IT SHALL BE THE RESPONSIBILITY OF THE CONTRACTOR TO VERIFY BOTH THE HORIZONTAL AND VERTICAL LOCATION OF ALL EXISTING UTILITIES AND UNDERGROUND FACILITIES PRIOR TO START OF CONSTRUCTION. TAKE THE NECESSARY PRECAUTIONS IN ORDER TO PROTECT ALL FACILITIES ENCOUNTERED. THE CONTRACTOR SHALL PRESERVE AND PROTECT ALL EXISTING UTILITIES FROM DAMAGE DURING CONSTRUCTION.

SAWCUT & REMOVE EX. CURB PER CITY STDS. INSTALL APPROACHES PER CITY DETAIL. SEE C101A FOR LIMITS OF SAWCUT.


PROP. CONCRETE APPROACH W/ BARRIER FREE RAMPS ON EACH SIDE

PROP. 4' CONC. RUNNER (SEE C101A)

PROP. 4' CONC. RUNNER (SEE C101A)

revised date: 12/2/20 note: Added dimension to light pole locations



AS-BUILT
May 12, 2021
Gerald Monk
GERALD E. MONK, P.E.

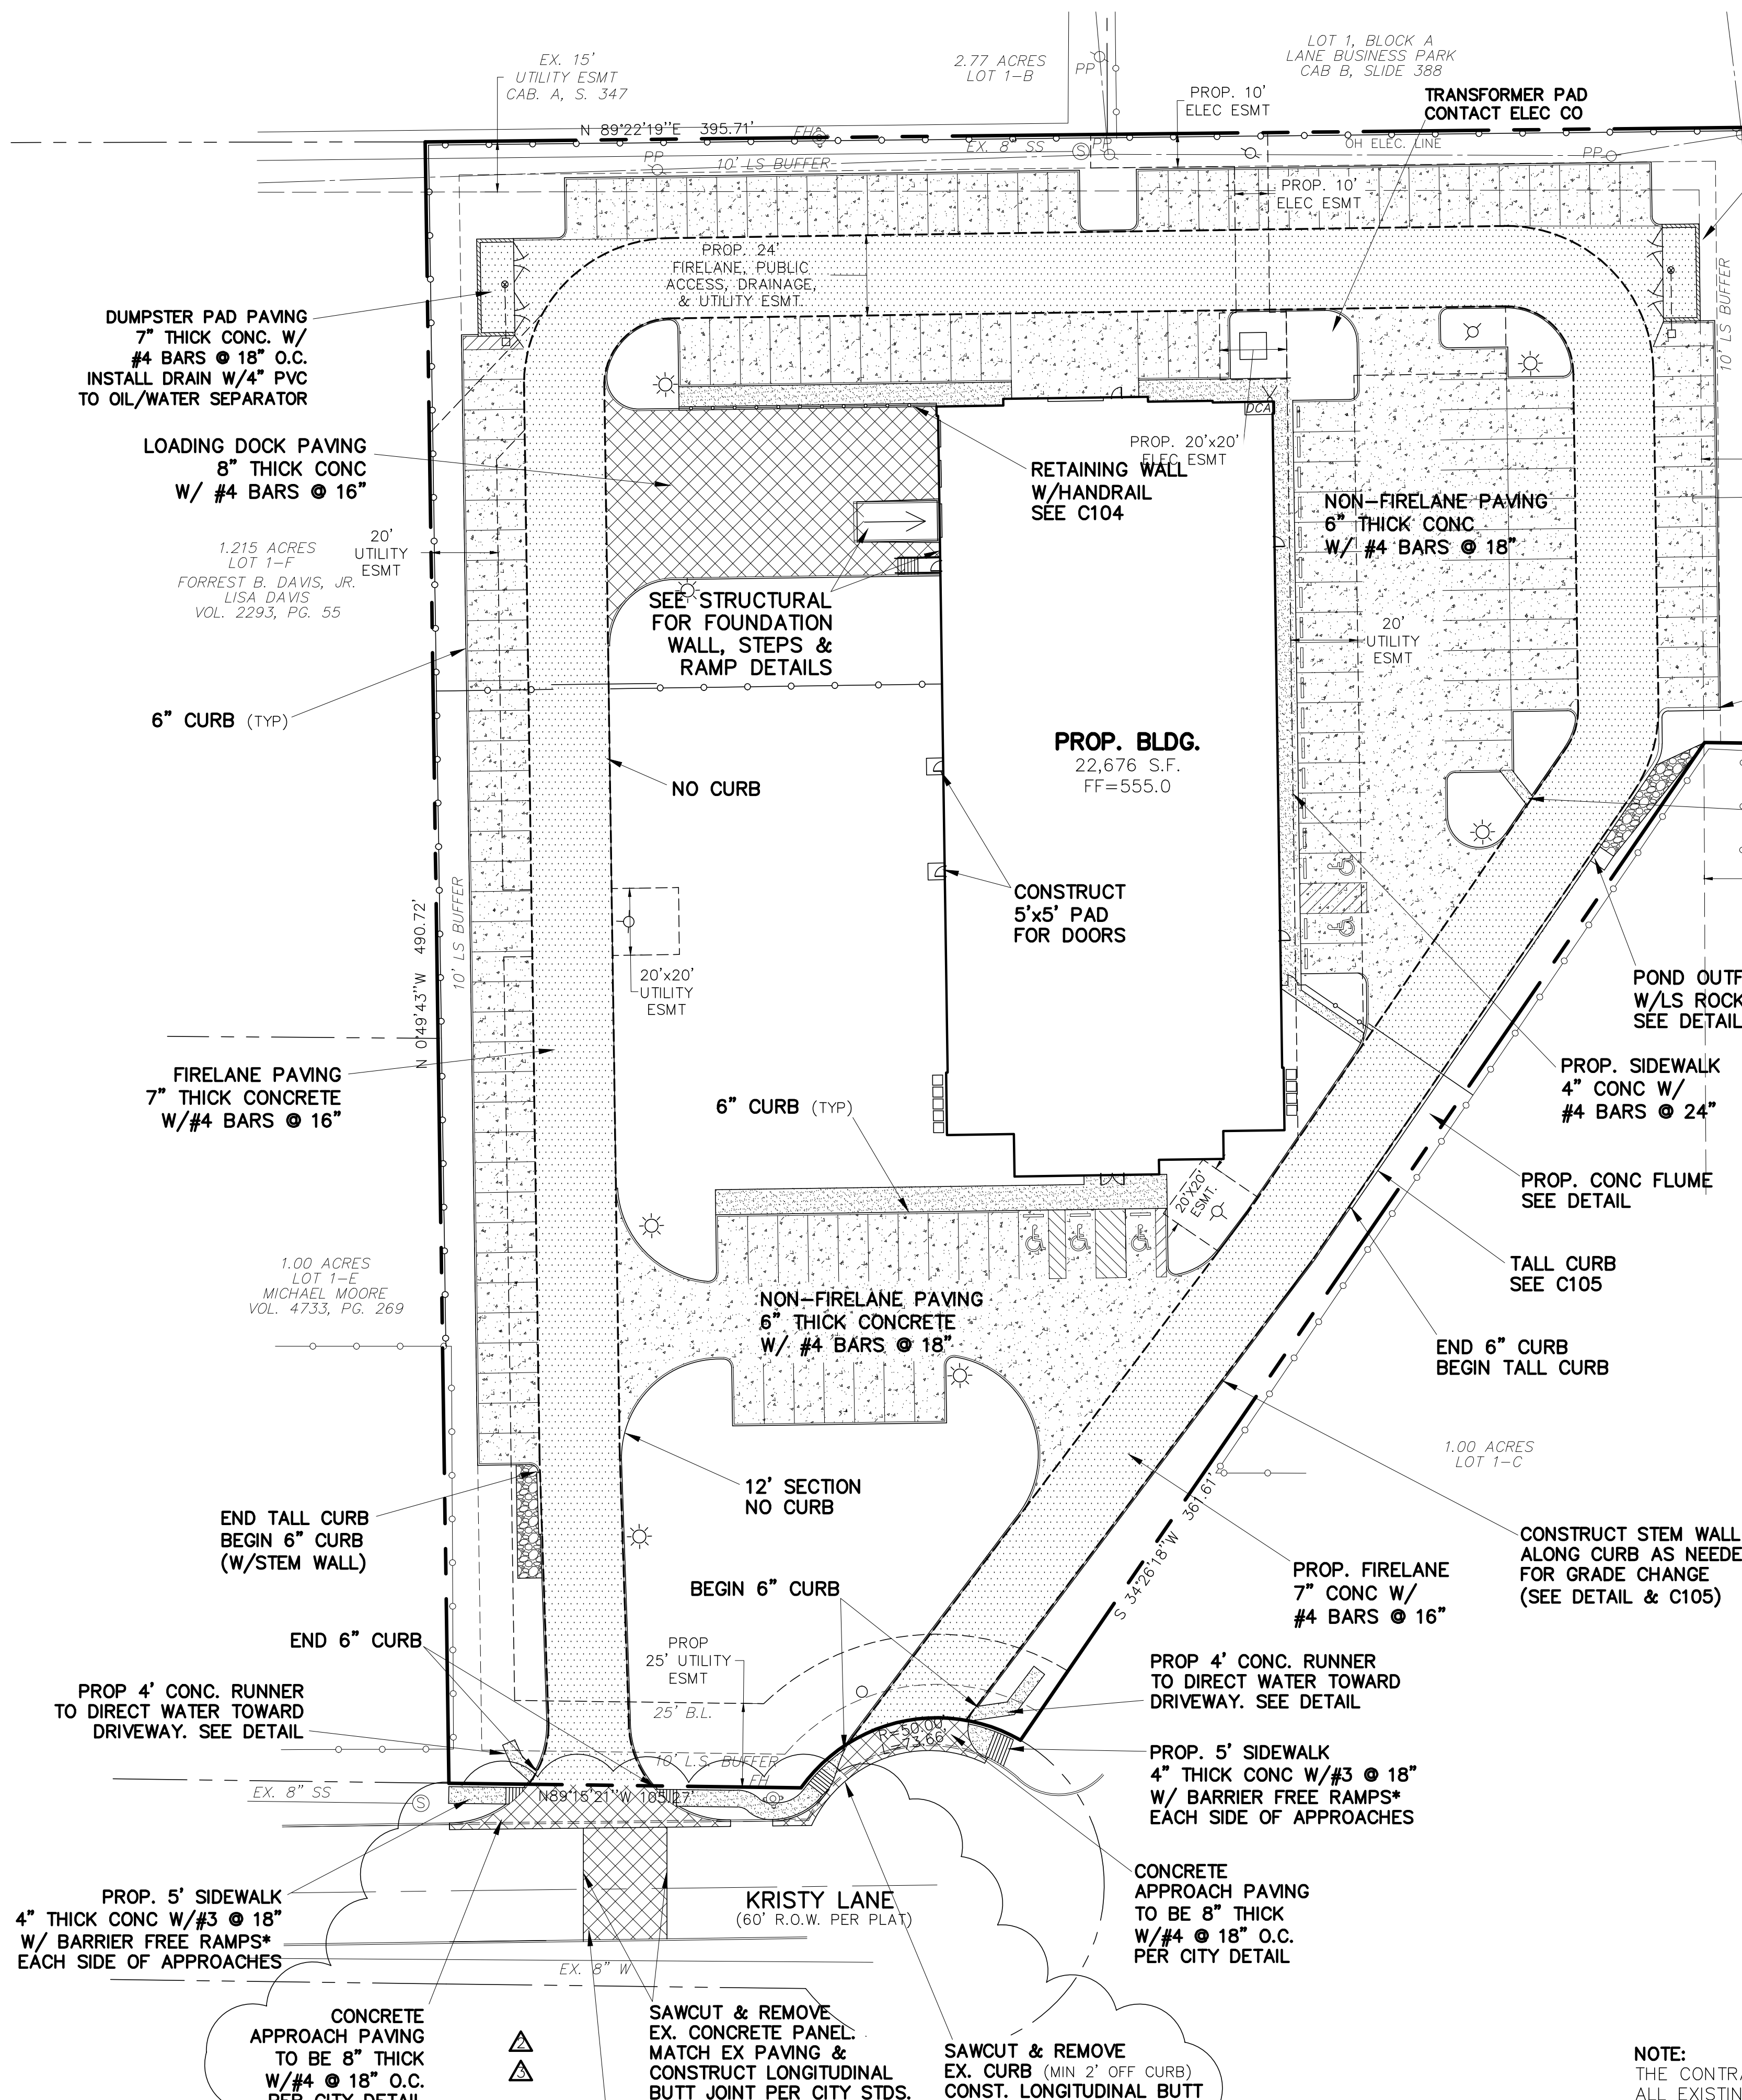

DUMPSTER PAD
7" THICK CONC. W/
#4 BARS @ 18" O.C.
INSTALL DRAIN W/4" PVC
TO OIL/WATER SEPARATOR

- NOTES:
- 1) ALL WORK MUST CONFORM TO CITY OF ROCKWALL & NCTCOG STANDARDS AND DETAILS 5TH EDITION.
 - 2) ALL WORK IN PUBLIC RIGHT-OF-WAY SHALL CONFORM TO CITY OF ROCKWALL STANDARDS AND DETAILS
 - 3) SEE PLAT FOR ALL INFORMATION REGARDING EASEMENTS, PROPERTY LINES, ETC.
 - 4) NO SAND UNDER SIDEWALKS.
 - 5) SEE D101 FOR MORE DETAILS

- PAVING NOTES:
- 1) APPROACHES & LOADING DOCK TO BE 8" THICK, 4200 PSI, 7.5 SACK MIX, REINFORCED WITH #3 BARS @ 16" ON CENTER. (O.C.)
 - 2) FIRELANE TO BE 7" THICK, 3600 PSI, 6.5 SACK MIX, REINFORCED WITH #4 BARS @ 16" ON CENTER. (O.C.)
 - 3) DUMPSTER PAD TO BE 7" THICK, 3600 PSI, 6.5 SACK MIX, REINFORCED WITH #4 BARS @ 18" ON CENTER. (O.C.)
 - 4) ALL OTHER (NON-FIRELANE) PAVING CAN BE 6" THICK, 3000 PSI, 6 SACK MIX, REINFORCED WITH #4 BARS @ 18" O.C.
 - 5) ALL FILL (IF REQUIRED) SHALL BE PLACED ON 8" LIFTS AND COMPACTED TO 95% OF STD. PROCTOR @ MOISTURE RANGE OF 0% TO +4% OF OPTIMUM MOISTURE. (UNLESS OTHERWISE NOTED) USING A SHEEPS-FOOT ROLLER.
 - 6) SIDEWALK TO BE 4" THICK CONCRETE, 3000 PSI, 6 SACK MIX IN R.O.W. W/ #4 BARS @ 24" O.C.
 - 7) NO SAND UNDER PAVING.
 - 8) NO PAVING, INCLUDING SLAB, TO BE INSTALLED UNTIL THE DETENTION SYSTEM(S) ARE FULLY INSTALLED FUNCTIONALLY, PER PLAN, & HAVE ANCHORED SEEDED CURLEX OR SOD ON THE SIDES & BOTTOM OF POND

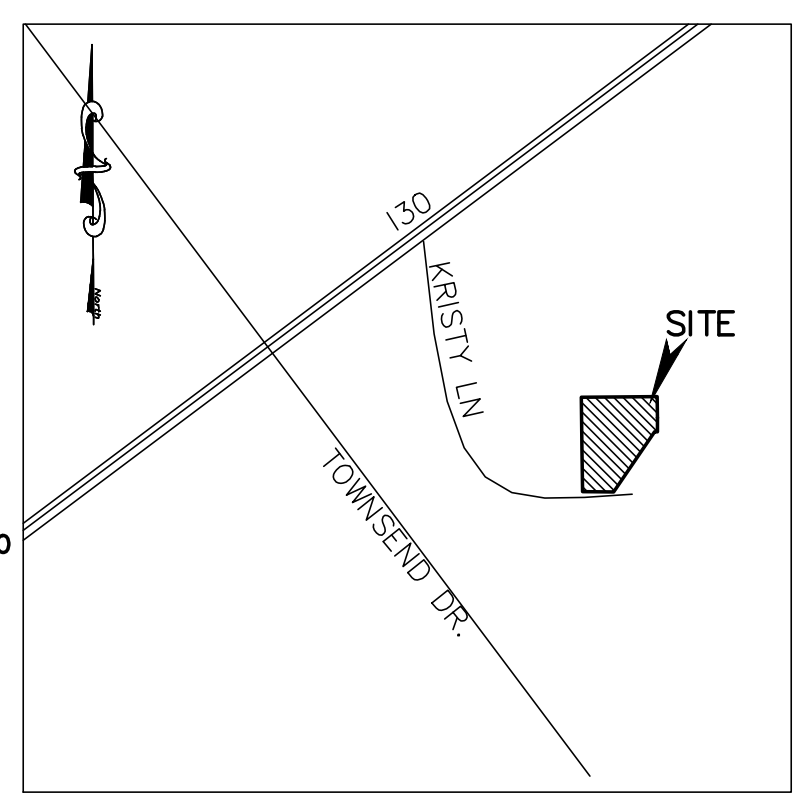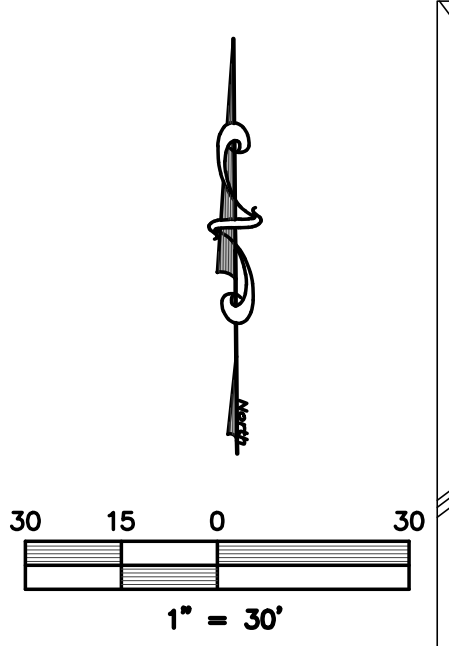


LOCATION MAP
(NOT TO SCALE)

LEGEND

- = PROPERTY LINE
- EX. SS — = EXISTING SANITARY SEWER LINE
- EX. W — = EXISTING WATER LINE
- ⊙ FH ⊙ = EXISTING FIRE HYDRANT
- ∞ WM ∞ = EXISTING WATER METER
- ⊙ PP ⊙ = EXISTING POWER POLE
- ⊙ LP ⊙ = EXISTING LIGHT POLE
- T = EX. WATER VALVE
- ⊙ S ⊙ = EXISTING SEWER MANHOLE
- ⊙ G ⊙ = EXISTING GAS METER
- B-B = BACK OF CURB TO BACK OF CURB
- EXIST. or EX. = EXISTING
- PROP. = PROPOSED
- LS = LANDSCAPE
- min = MINIMUM
- max = MAXIMUM
- ⊙ ⊙ = PROPOSED LIGHT POLE
- ⊙ ⊙ = PROPOSED FIRE HYDRANT
- [Pattern] = PROPOSED FIRELANE
- [Pattern] = PROPOSED 7" PAVING
- [Pattern] = PROPOSED 8" PAVING
- [Pattern] = PROPOSED 6" PAVING
- [Pattern] = PROPOSED 4" PAVING

ONLY DRAWINGS STAMPED "RELEASED FOR CONSTRUCTION" BY THE CITY OF ROCKWALL TO BE USED FOR CONSTRUCTION.

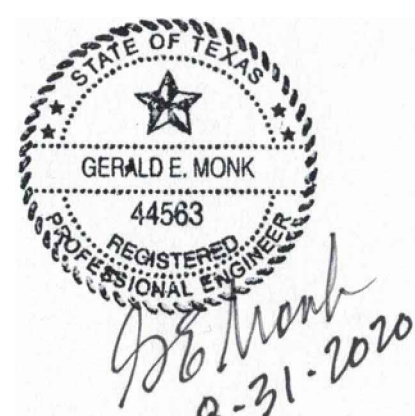

CASE # SP2019-047

PAVING PLAN

BACON PLUMBING OFFICE


2055 KRISTY LANE
LOT 1-M, BODIN INDUSTRIAL TRACT, 3.54 ACRES
City of Rockwall, Rockwall County, Texas

owner
BACON PROPERTY, LLC
295 RANCH TRAIL
ROCKWALL, TEXAS 75032
CONTACT: BRAD BACON (972)236-5794


prepared by
MONK CONSULTING ENGINEERS, INC.
1200 W. State Street, Garland Texas 75040
972 272-1763 Fax 972 272-8761

REG NO.: F-2567
©2020 by Monk Consulting Engineers, Inc. All Rights Reserved.


date: 8/31/20 scale: 1" = 30' sheet: C101A

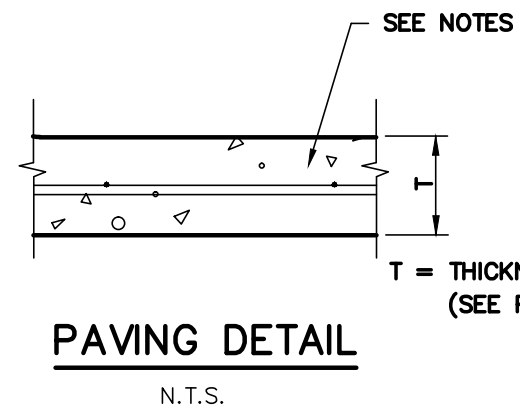


PAVING DETAIL
N.T.S.

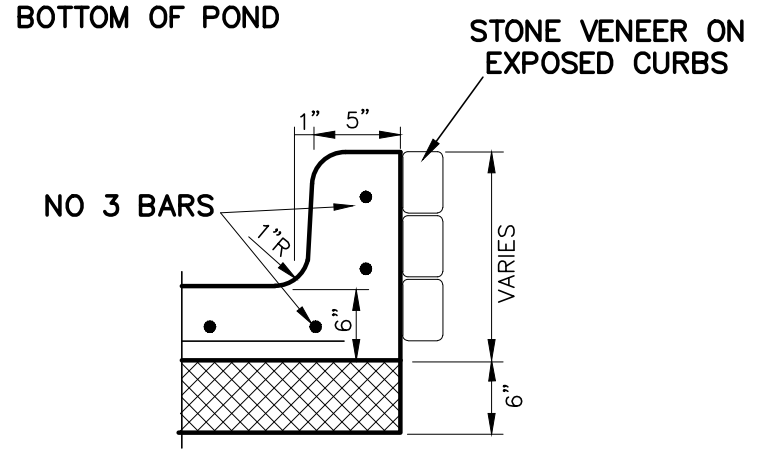


TALL CURB
NOT TO SCALE

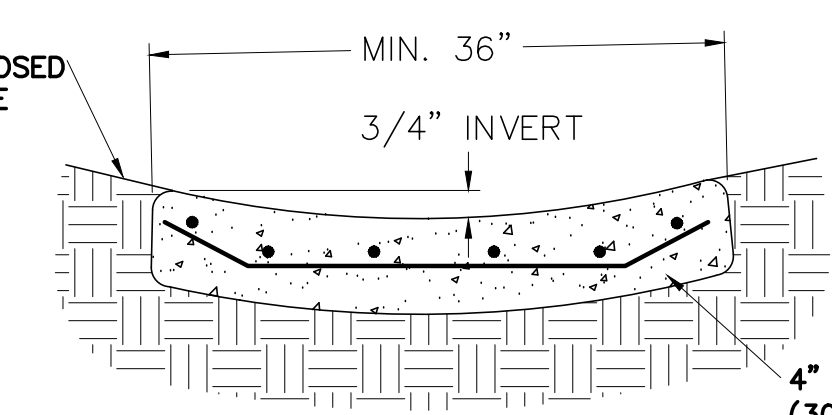


CONCRETE RUNNER DETAIL
NOT TO SCALE

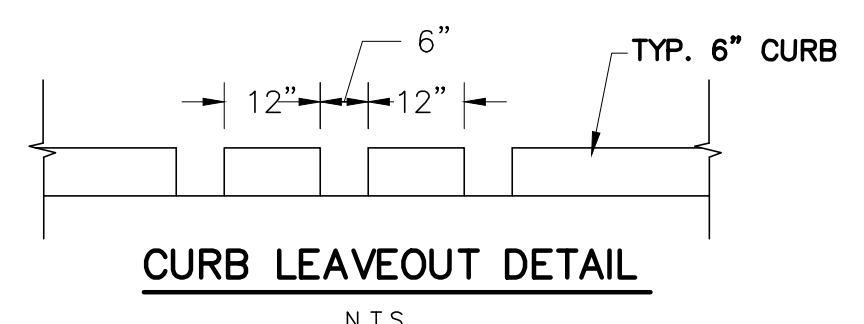

CURB LEAVEOUT DETAIL
N.T.S.

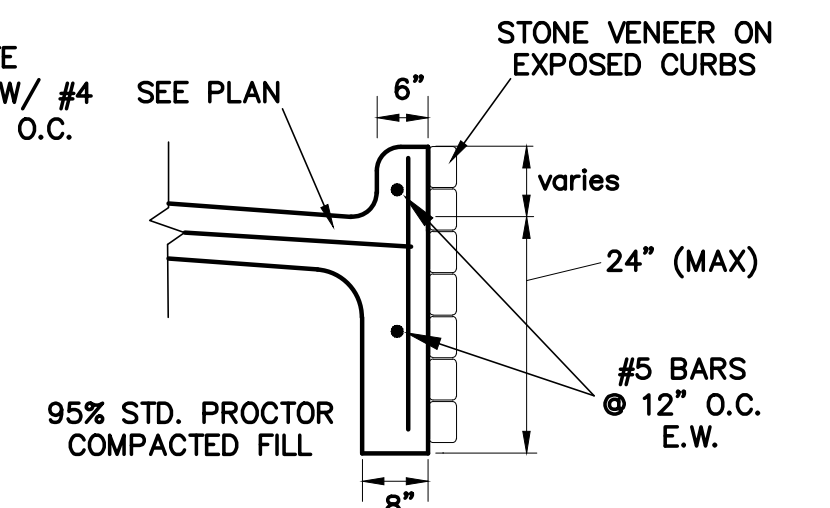

STEM WALL @ CURB
NOT TO SCALE

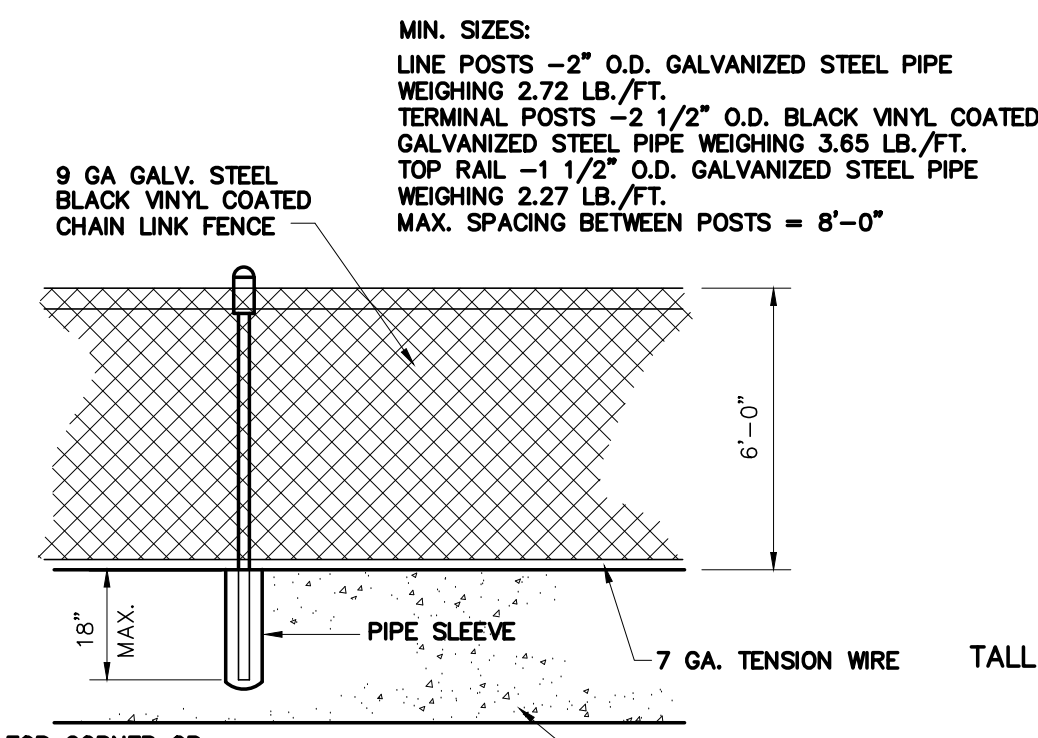

CHAIN LINK FENCE DETAIL
N.T.S.

*FENCE TO BE BY SEPARATE PERMIT



TO THE BEST OF OUR KNOWLEDGE MONK CONSULTING ENGINEERS, INC. HEREBY STATES THAT THIS PLAN IS AS-BUILT. THE INFORMATION PROVIDED IS BASED ON SURVEYING AT THE SITE AND INFORMATION PROVIDED BY THE CONTRACTOR.

NOTE:
THE CONTRACTOR SHALL BE RESPONSIBLE FOR FIELD VERIFYING THE LOCATION OF ALL EXISTING UTILITIES AND EASEMENTS PRIOR TO START OF OPERATIONS. CONTRACTOR WILL NOTIFY THE OWNER'S REPRESENTATIVE OF ANY DISCREPANCIES PRIOR TO STARTING THE WORK. EXISTING UTILITIES AND UNDERGROUND FACILITIES INDICATED ON THESE PLANS HAVE BEEN LOCATED FROM REFERENCE INFORMATION. IT SHALL BE THE RESPONSIBILITY OF THE CONTRACTOR TO VERIFY BOTH THE HORIZONTAL AND VERTICAL LOCATION OF ALL EXISTING UTILITIES AND UNDERGROUND FACILITIES PRIOR TO START OF CONSTRUCTION. TAKE THE NECESSARY PRECAUTIONS IN ORDER TO PROTECT ALL FACILITIES ENCOUNTERED. THE CONTRACTOR SHALL PRESERVE AND PROTECT ALL EXISTING UTILITIES FROM DAMAGE DURING CONSTRUCTION.

WARNING:
PRIOR TO THE BEGINNING OF ANY CONSTRUCTION OR CONSTRUCTION STAKING, IT SHALL BE THE CONTRACTOR'S RESPONSIBILITY TO CONTACT THE CIVIL ENGINEER TO ENSURE THAT ALL PARTIES ARE IN POSSESSION OF THE MOST CURRENT SET OF CONSTRUCTION DOCUMENTS.

DUMPSTER PAD PAVING
7" THICK CONC. W/
#4 BARS @ 18" O.C.
INSTALL DRAIN W/4" PVC
TO OIL/WATER SEPARATOR

LOADING DOCK PAVING
8" THICK CONC
W/ #4 BARS @ 16"

1.215 ACRES
LOT 1-F
FORREST B. DAVIS, JR.
LISA DAVIS
VOL. 2293, PG. 55

6" CURB (TYP)

FIRELANE PAVING
7" THICK CONCRETE
W/#4 BARS @ 16"

1.00 ACRES
LOT 1-E
MICHAEL MOORE
VOL. 4733, PG. 269

END TALL CURB
BEGIN 6" CURB
(W/STEM WALL)

PROP. 4" CONC. RUNNER
TO DIRECT WATER TOWARD
DRIVEWAY. SEE DETAIL

PROP. 5' SIDEWALK
4" THICK CONC W/#3 @ 18"
W/ BARRIER FREE RAMPS*
EACH SIDE OF APPROACHES

CONCRETE
APPROACH PAVING
TO BE 8" THICK
W/#4 @ 18" O.C.
PER CITY DETAIL

*PLEASE NOTE:
ALL ACCESS RAMPS (BFR)
LOCATED WITHIN PUBLIC
RIGHT OF WAY ARE REQUIRED
TO HAVE TRUNCATED DOME
BUMP PLATES.

FULL PANEL REPLACEMENT
REQ'D FOR WATER LINE TAPS

SAWCUT & REMOVE
EX. CONCRETE PANEL.
MATCH EX PAVING &
CONSTRUCT LONGITUDINAL
BUTT JOINT PER CITY STDS.

SAWCUT & REMOVE
EX. CURB (MIN 2' OFF CURB)
CONST. LONGITUDINAL
BUTT JOINT PER CITY STDS.

PROP. BLDG.
22,676 S.F.
FF=555.0

CONSTRUCT
5'x5' PAD
FOR DOORS

NON-FIRELANE PAVING
6" THICK CONCRETE
W/ #4 BARS @ 18"

12' SECTION
NO CURB

BEGIN 6" CURB

PROP. 4' CONC. RUNNER
TO DIRECT WATER TOWARD
DRIVEWAY. SEE DETAIL

PROP. 5' SIDEWALK
4" THICK CONC W/#3 @ 18"
W/ BARRIER FREE RAMPS*
EACH SIDE OF APPROACHES

CONCRETE
APPROACH PAVING
TO BE 8" THICK
W/#4 @ 18" O.C.
PER CITY DETAIL

1.00 ACRES
LOT 1-C

CONSTRUCT STEM WALL
ALONG CURB AS NEEDED
FOR GRADE CHANGE
(SEE DETAIL & C105)

CONCRETE
APPROACH PAVING
TO BE 8" THICK
W/#4 @ 18" O.C.
PER CITY DETAIL

END TALL CURB
BEGIN 6" CURB

PROP. 3" RUNNER
SEE DETAIL

PROP. SIDEWALK
4" CONC W/
#4 BARS @ 24"

PROP. CONC FLUME
SEE DETAIL

TALL CURB
SEE C105

END 6" CURB
BEGIN TALL CURB

PROP. FIRELANE
7" CONC W/
#4 BARS @ 16"

END 6" CURB

PROP. 5' SIDEWALK
4" THICK CONC W/#3 @ 18"
W/ BARRIER FREE RAMPS*
EACH SIDE OF APPROACHES

CONCRETE
APPROACH PAVING
TO BE 8" THICK
W/#4 @ 18" O.C.
PER CITY DETAIL




PROP. 5' SIDEWALK
4" THICK CONC W/#3 @ 18"
W/ BARRIER FREE RAMPS*
EACH SIDE OF APPROACHES

CONCRETE
APPROACH PAVING
TO BE 8" THICK
W/#4 @ 18" O.C.
PER CITY DETAIL

PROP. 5' SIDEWALK
4" THICK CONC W/#3 @ 18"
W/ BARRIER FREE RAMPS*
EACH SIDE OF APPROACHES

CONCRETE
APPROACH PAVING
TO BE 8" THICK
W/#4 @ 18" O.C.
PER CITY DETAIL

PROP. 5' SIDEWALK
4" THICK CONC W/#3 @ 18"
W/ BARRIER FREE RAMPS*
EACH SIDE OF APPROACHES

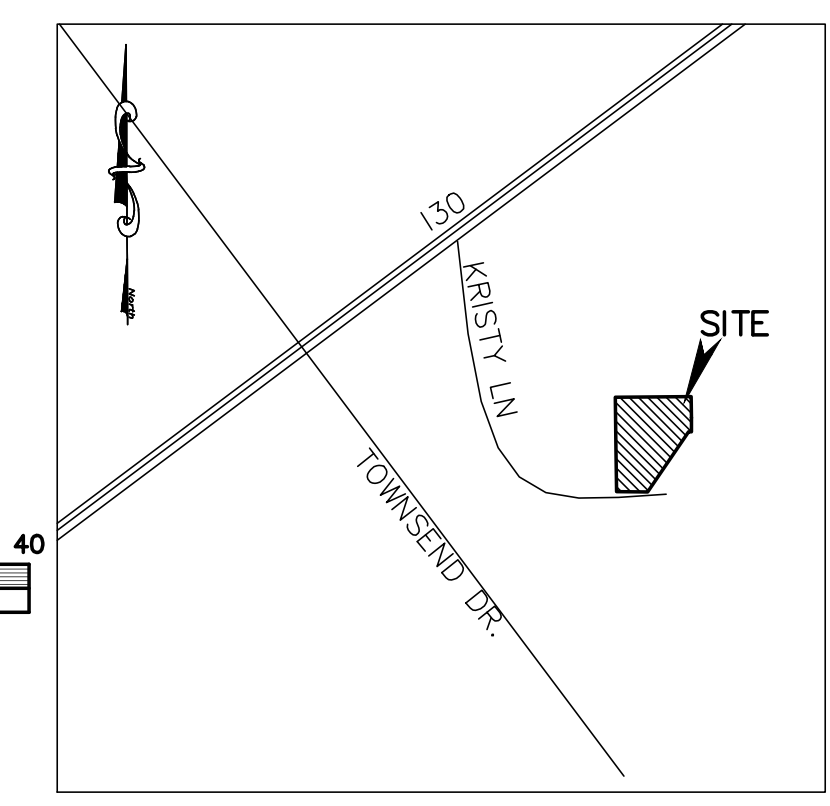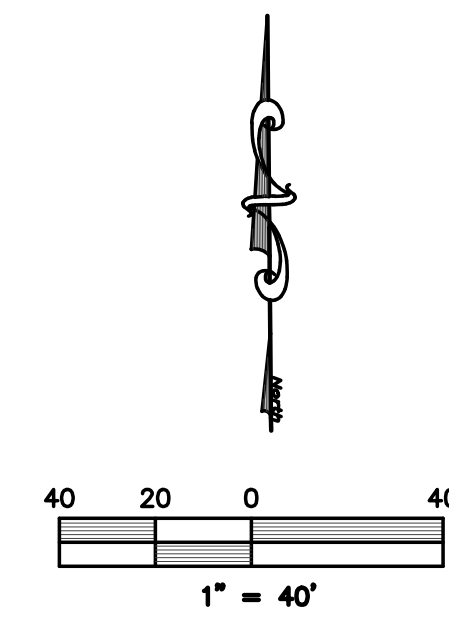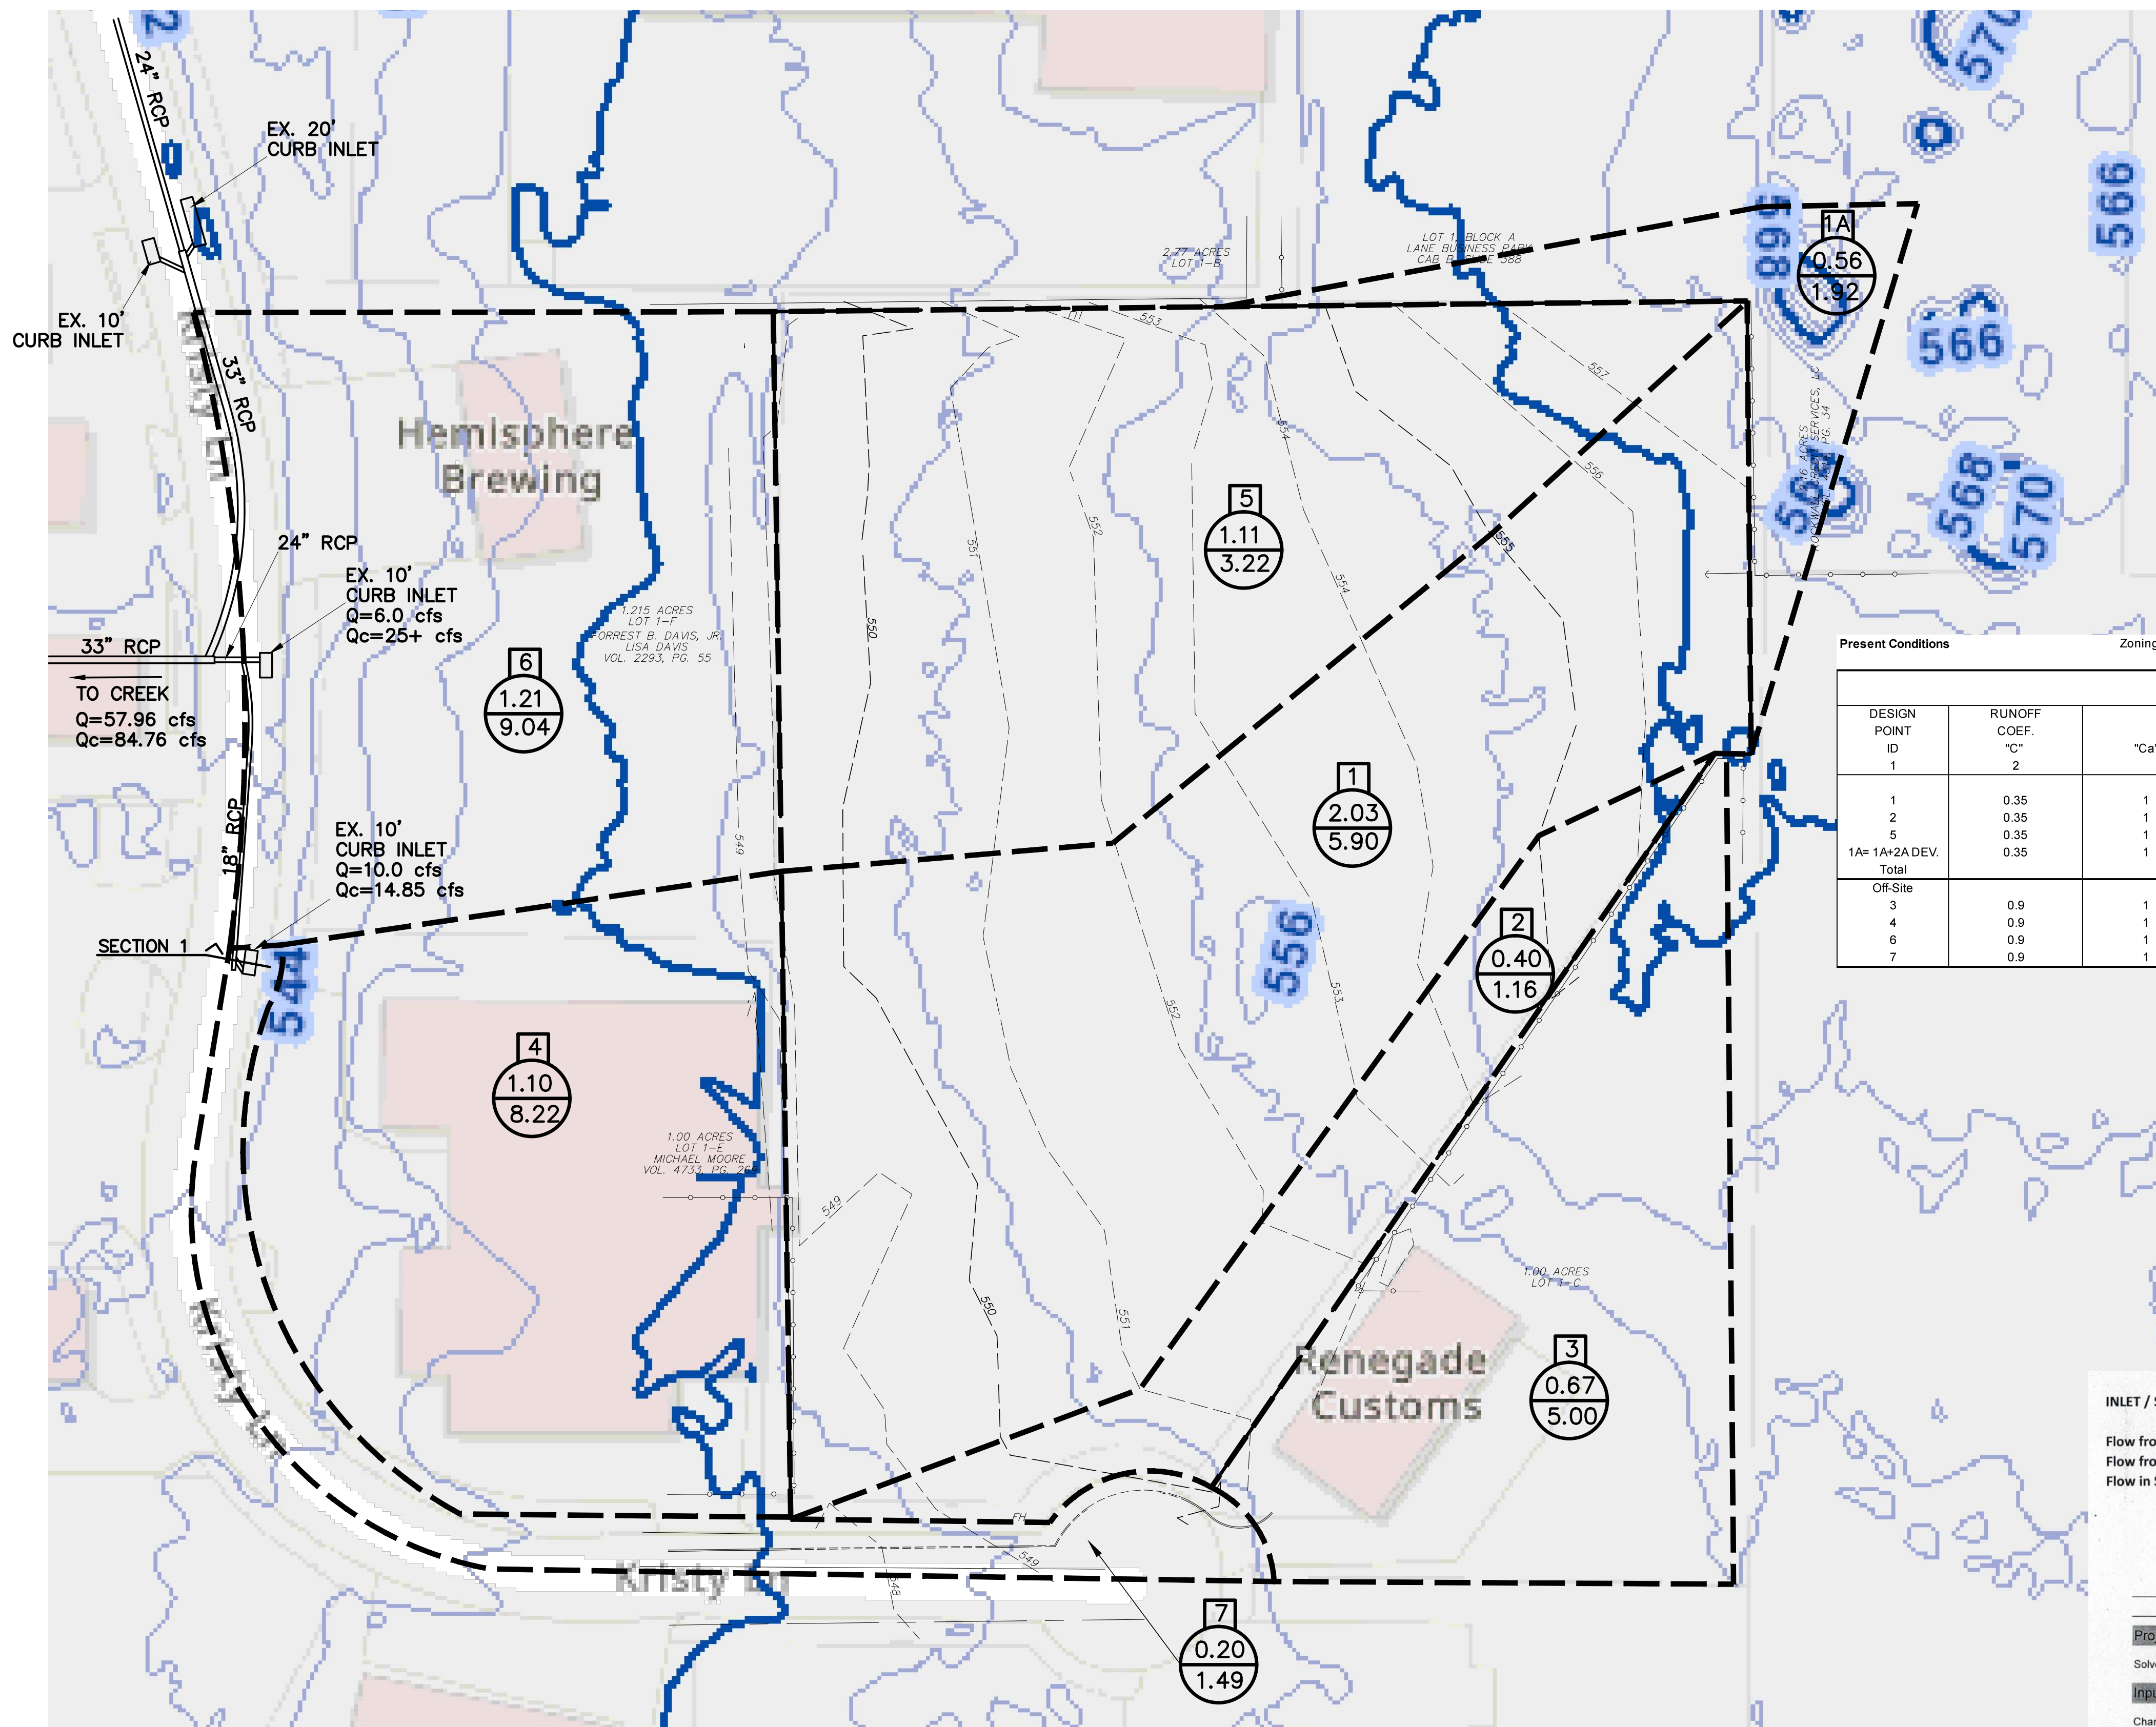

LOCATION MAP
(NOT TO SCALE)


LEGEND

- = PROPERTY LINE
- 460 --- = EXISTING CONTOURS
- 1 = AREA # (F= FUTURE)
- 0.00 = ACRES
- 0.00 = CFS

REF. OF EXIST. STORM:
1) EXISTING STORM INFO. IS REFERENCED
FROM CITY OF ROCKWALL, BODIN
INDUSTRIAL TRACT, PLAN #78166

Present Conditions Zoning LI

| DRAINAGE AREA CALCULATIONS | | | | | | | | | | | |
|----------------------------|------------------|------|----------------|------------|------------------------------|-----------------------|---------------------|-----------------------|---------------------|----------------|--|
| DESIGN POINT ID | RUNOFF COEF. "C" | "Ca" | AREA "A" Acres | TOTAL "CA" | Time of Concentration (Min.) | Intensity 110yr in/hr | Discharge 110yr cfs | Intensity 100yr in/hr | Discharge 100yr cfs | Comments | |
| 1 | 0.35 | 1 | 2.030 | 0.71 | 20.00 | 5.90 | 4.19 | 8.30 | 5.90 | To Kristy Lane | |
| 2 | 0.35 | 1 | 0.400 | 0.14 | 20.00 | 5.90 | 0.83 | 8.30 | 1.16 | To Kristy Lane | |
| 5 | 0.35 | 1 | 1.110 | 0.39 | 20.00 | 5.90 | 2.29 | 8.30 | 3.22 | To Kristy Lane | |
| 1A= 1A+2A DEV. | 0.35 | 1 | 0.560 | 0.20 | 10.00 | 7.10 | 1.39 | 9.80 | 1.92 | To Kristy Lane | |
| Total | | | 4.100 | | | | | | | | |
| Off-Site | | | | | | | | | | | |
| 3 | 0.9 | 1 | 0.670 | 0.60 | 10.00 | 7.10 | 4.28 | 9.80 | 5.91 | To Kristy Lane | |
| 4 | 0.9 | 1 | 1.100 | 0.99 | 10.00 | 7.10 | 7.03 | 9.80 | 9.70 | To Kristy Lane | |
| 6 | 0.9 | 1 | 1.210 | 1.09 | 10.00 | 7.10 | 7.73 | 9.80 | 10.67 | To Kristy Lane | |
| 7 | 0.9 | 1 | 0.200 | 0.18 | 10.00 | 7.10 | 1.28 | 9.80 | 1.76 | To Kristy Lane | |

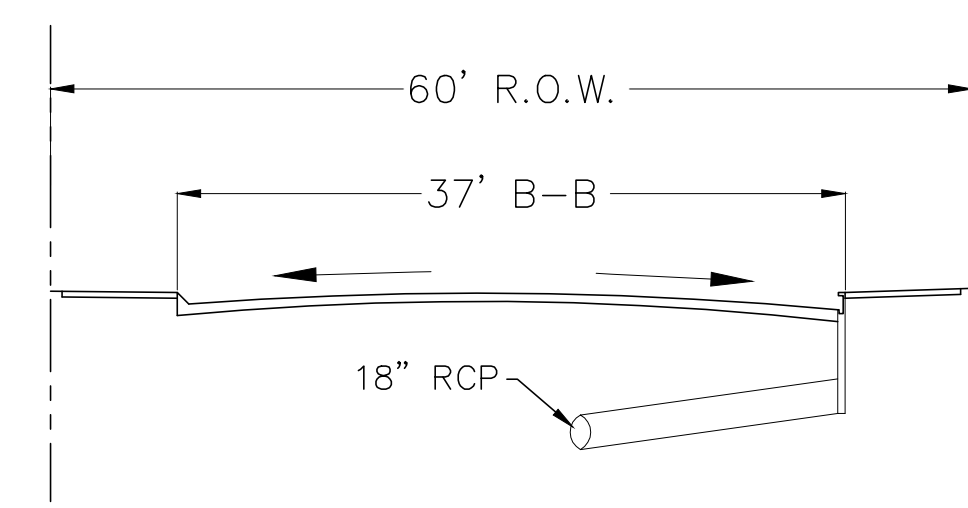

SECTION 1
KRISTY LANE STA: 5+75
6" CURB, 10' INLET

INLET / STREET CAPACITY

| | | | |
|--------------------------------------|---------------------|-----------|------|
| Flow from Site (Detained Flow) | 5.93 + 2.94 = | 8.87 cfs | |
| Flow from overall DA Map Areas 3,4,7 | 5.0 + 8.22 + 1.49 = | 14.71 cfs | C103 |
| Flow in Street prior to inlet | | 23.58 cfs | |

Street Flow Prior to Inlet in Kristy

| Project Description | |
|-----------------------|--------------------------|
| Solve For | Spread |
| Input Data | |
| Channel Slope | 0.06000 ft/ft |
| Discharge | 23.58 ft ³ /s |
| Gutter Width | 1.00 ft |
| Gutter Cross Slope | 0.03 ft/ft |
| Road Cross Slope | 0.03 ft/ft |
| Roughness Coefficient | 0.013 |
| Results | |
| Spread | 12.72 ft |
| Flow Area | 2.24 ft ² |
| Depth | 0.35 ft |
| Gutter Depression | 0.00 ft |
| Velocity | 10.53 ft/s |



CASE # SP2019-047

PRE DRAINAGE AREA PLAN
BACON PLUMBING OFFICE

2055 KRISTY LANE
LOT 1-M, BODIN INDUSTRIAL TRACT, 3.54 ACRES
City of Rockwall, Rockwall County, Texas

owner
BACON PROPERTY, LLC
295 RANCH TRAIL
ROCKWALL, TEXAS 75032
CONTACT: BRAD BACON (972)236-5794


prepared by
MONK CONSULTING ENGINEERS, INC.
1200 W. State Street, Garland Texas 75040
972 272-1763 Fax 972 272-8761

AS-BUILT
May 12, 2021
Gerald Monk
GERALD E. MONK, P.E.

TO THE BEST OF OUR KNOWLEDGE MONK CONSULTING ENGINEERS, INC. HEREBY STATES THAT THIS PLAN IS AS-BUILT. THE INFORMATION PROVIDED IS BASED ON SURVEYING AT THE SITE AND INFORMATION PROVIDED BY THE CONTRACTOR.

©2020 by Monk Consulting Engineers, Inc., All Rights Reserved. REG NO.: F-2567


date: 8/31/20 scale: 1" = 40' sheet: C103

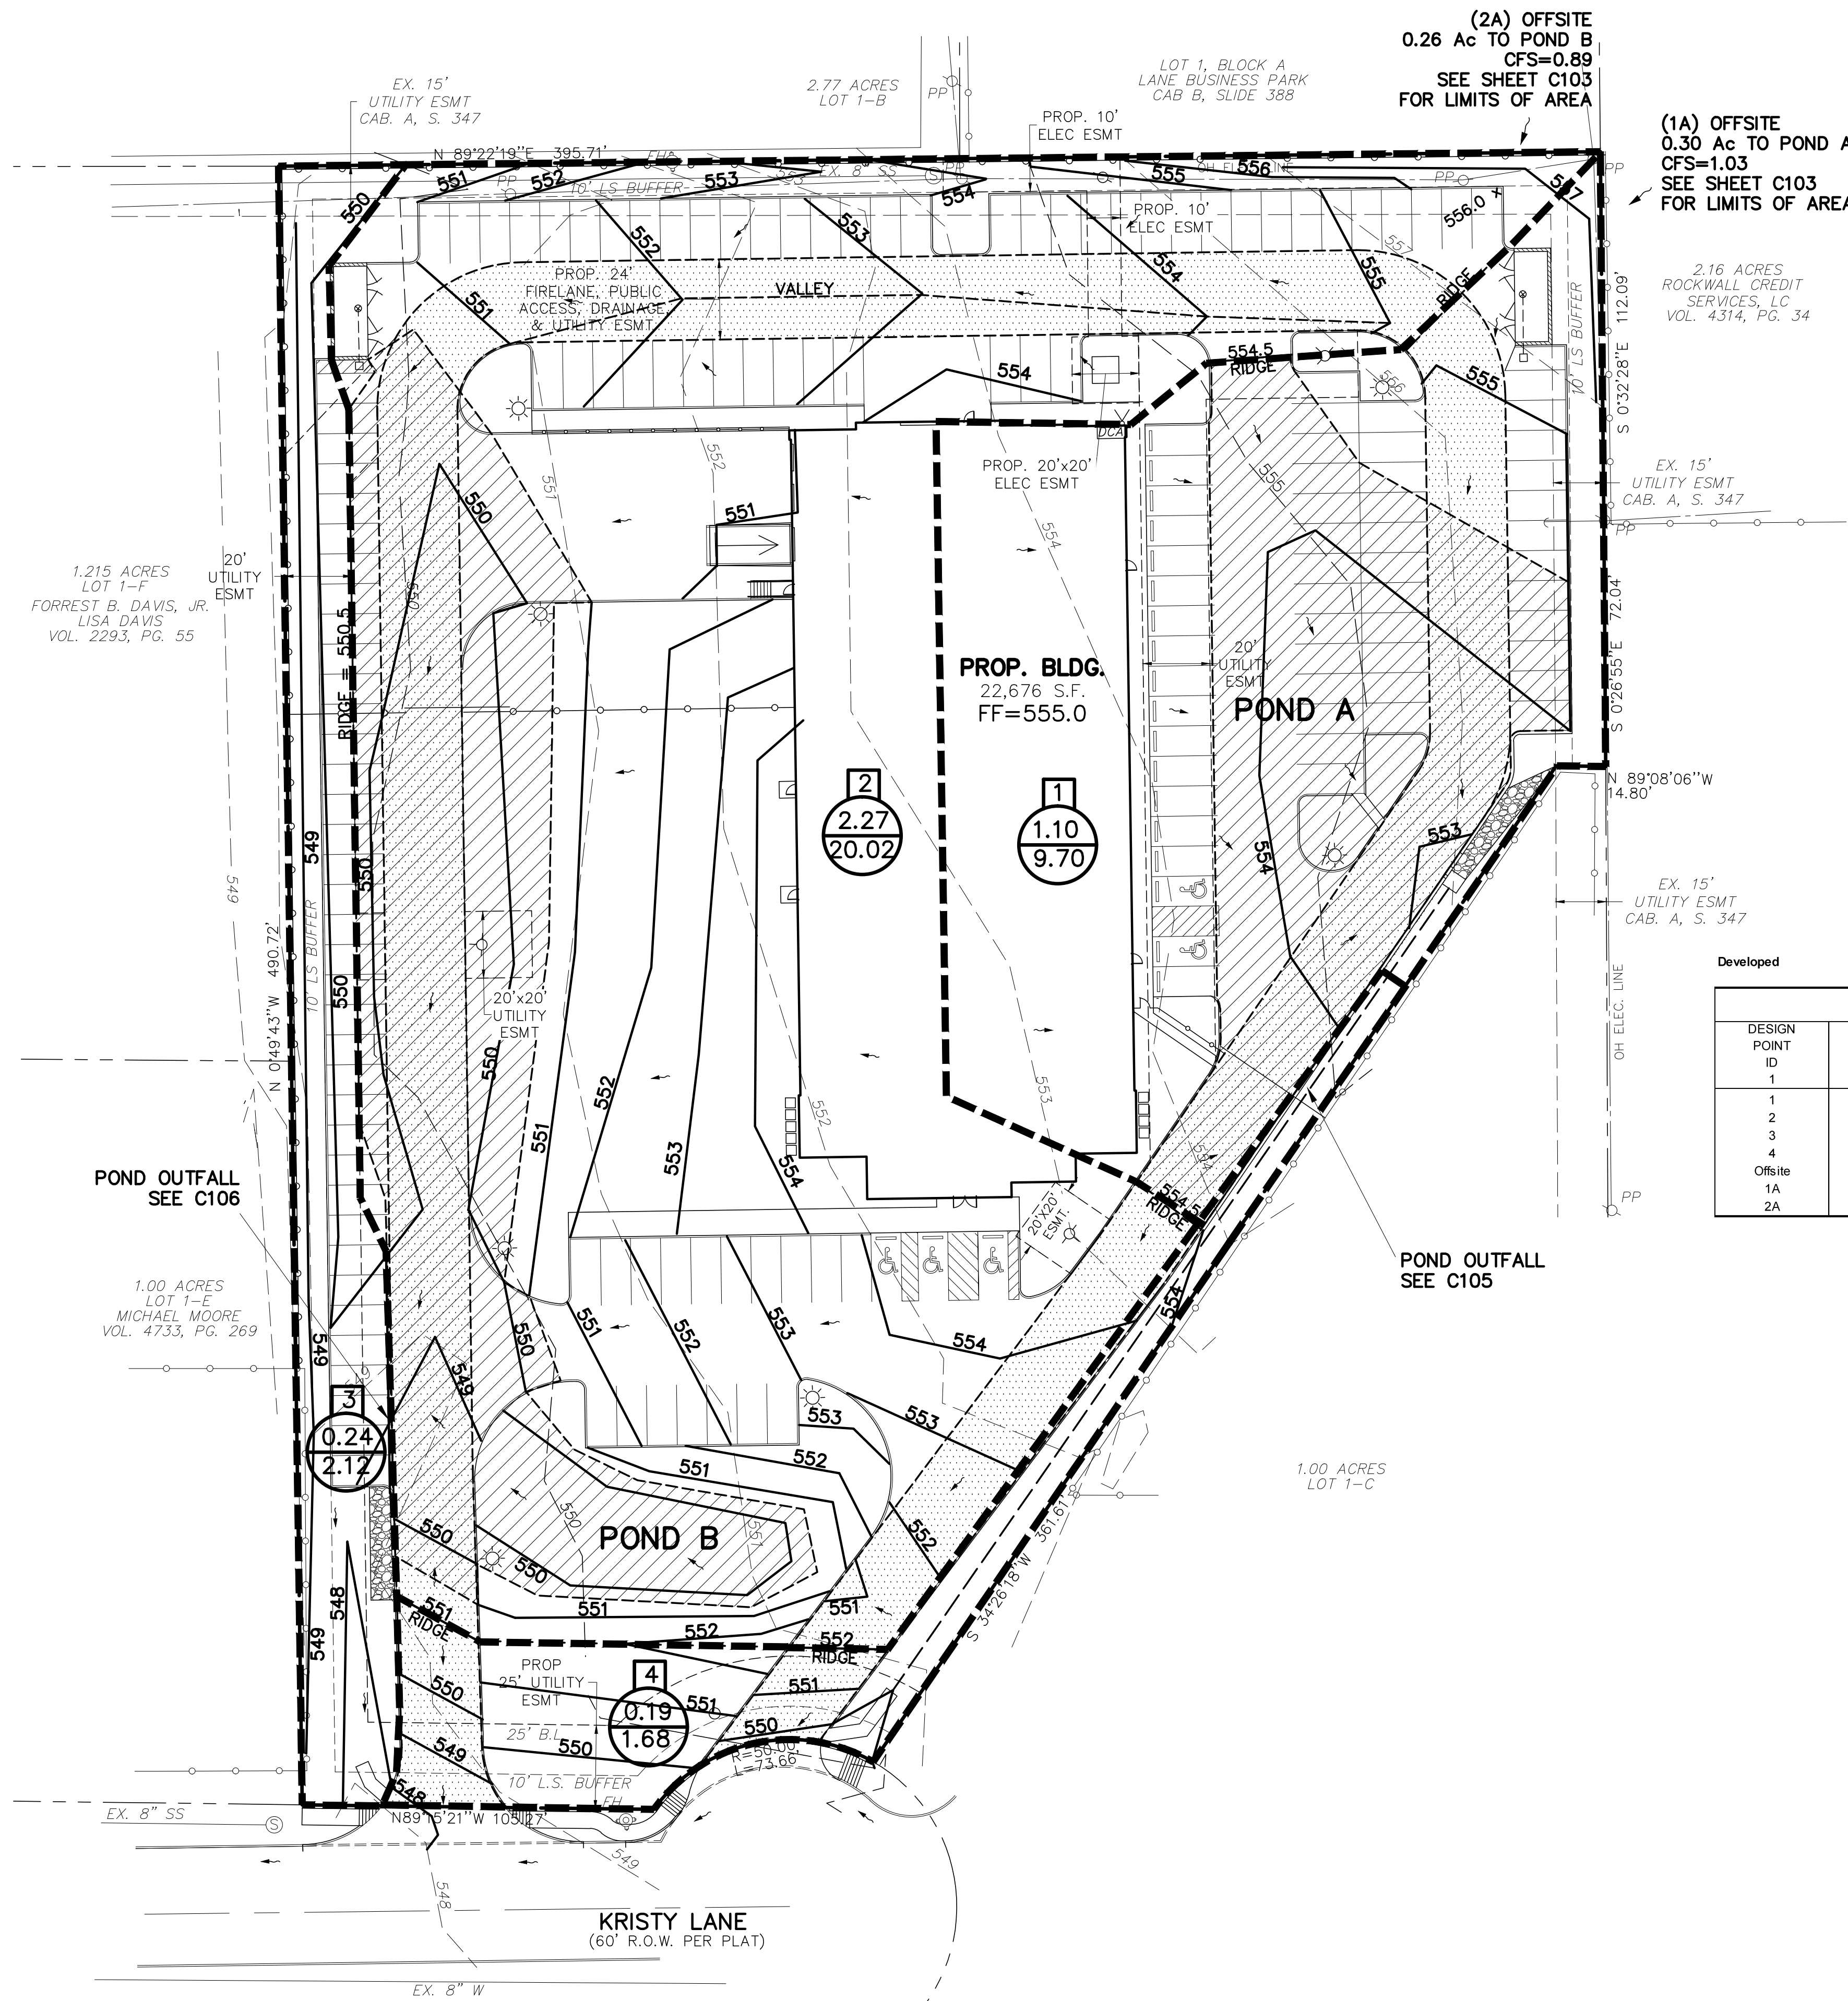

(2A) OFFSITE
0.26 Ac TO POND B
CFS=0.89
SEE SHEET C103
FOR LIMITS OF AREA

(1A) OFFSITE
0.30 Ac TO POND A
CFS=1.03
SEE SHEET C103
FOR LIMITS OF AREA

**** NOTICE TO CONTRACTORS ****
TOPOGRAPHIC INFORMATION TAKEN FROM A TOPOGRAPHIC SURVEY PERFORMED BY H.D. FEITY OF ROYSE CITY, TEXAS. THE CONTRACTOR SHALL NOTIFY THE ENGINEER IMMEDIATELY, IN WRITING, OF ANY DISCREPANCIES OR OMISSIONS TO THE TOPOGRAPHIC INFORMATION. THE CONTRACTOR(S) SHALL BE RESPONSIBLE FOR CONFIRMING THE LOCATION (HORIZONTAL/VERTICAL) OF ANY BURIED CABLES, CONDUITS, PIPES, AND STRUCTURES (STORM SEWER, SANITARY SEWER, WATER, GAS, TELEVISION, TELEPHONE, ETC.) WHICH IMPACT THE CONSTRUCTION SITE. THE CONTRACTOR(S) SHALL NOTIFY THE OWNER AND ENGINEER IF ANY DISCREPANCIES ARE FOUND BETWEEN THE ACTUAL CONDITIONS VERSUS THE DATA CONTAINED IN THE CONSTRUCTION PLANS. ANY COSTS INCURRED AS THE RESULT OF NOT CONFIRMING THE ACTUAL LOCATION (HORIZONTAL/VERTICAL) OF SAID CABLES, CONDUITS, PIPES, AND STRUCTURES SHALL BE BORNE BY THE CONTRACTOR. ADDITIONALLY, THE CONTRACTOR(S) SHALL NOTIFY THE OWNER AND ENGINEER IF ANY ERRORS OR DISCREPANCIES ARE FOUND ON THE CONSTRUCTION DOCUMENTS (P&E), WHICH NEGATIVELY IMPACT THE PROJECT. ENGINEER AND OWNER SHALL BE INDEMNIFIED OF PROBLEMS AND/OR COST WHICH MAY RESULT FROM CONTRACTOR'S FAILURE TO NOTIFY ENGINEER AND OWNER.

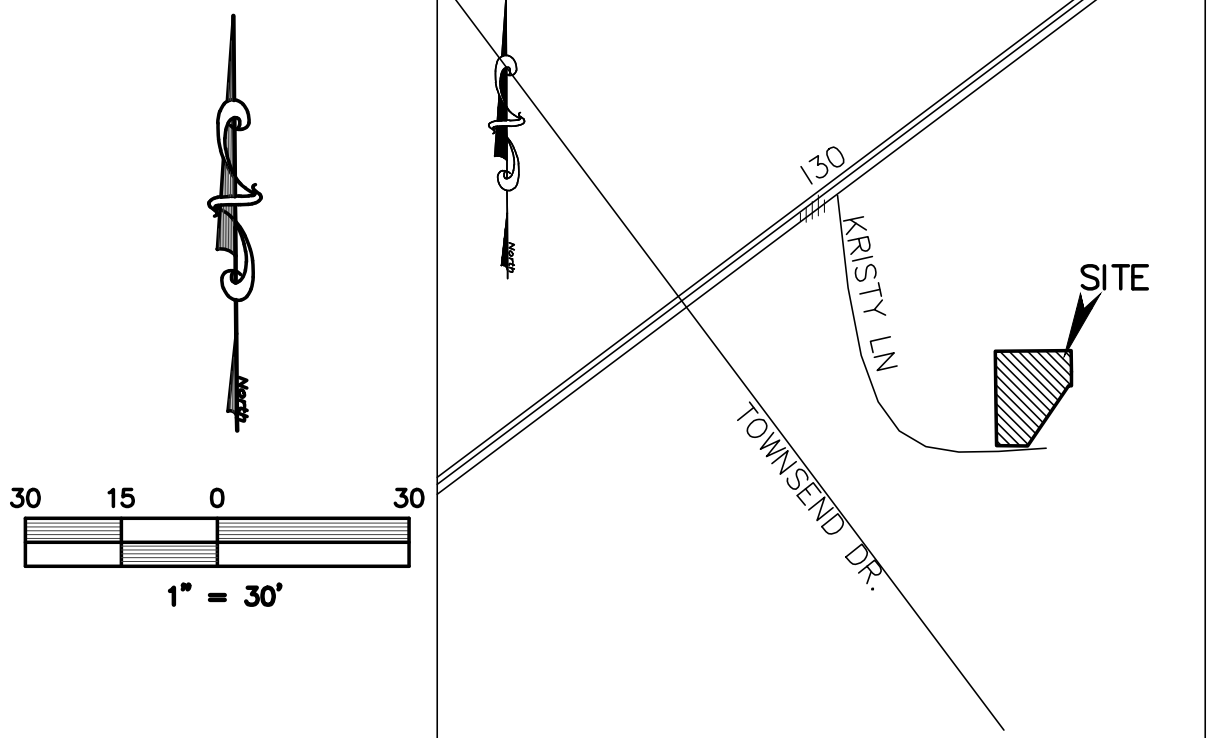

LOCATION MAP
(NOT TO SCALE)

LEGEND

- = PROPERTY LINE
- = PROP POND
- 460- = EXISTING CONTOURS
- 460— = PROPOSED CONTOURS
- 1 = AREA #
- 0.00 = ACRES
- 0.00 = CFS

Developed

DRAINAGE AREA CALCULATIONS

| DESIGN POINT ID | RUNOFF COEF. "C" | "Ca" | AREA "A" Acres | TOTAL "CA" | Time of Concentration (Min.) | Intensity 110yr in/hr | Discharge 110yr Q 10yr cfs | Intensity 1100yr in/hr | Discharge 1100yr Q 100yr cfs | Comments |
|-----------------|------------------|------|----------------|------------|------------------------------|-----------------------|----------------------------|------------------------|------------------------------|-------------------|
| 1 | 0.9 | 1 | 1.10 | 0.99 | 10.00 | 7.10 | 7.03 | 9.80 | 9.70 | Pond A |
| 2 | 0.9 | 1 | 2.27 | 2.04 | 10.00 | 7.10 | 14.51 | 9.80 | 20.02 | Pond B |
| 3 | 0.9 | 1 | 0.24 | 0.22 | 10.00 | 7.10 | 1.53 | 9.80 | 2.12 | By Pass to Kristy |
| 4 | 0.9 | 1 | 0.19 | 0.17 | 10.00 | 7.10 | 1.21 | 9.80 | 1.68 | By Pass to Kristy |
| Offsite | | | | | | | | | | |
| 1A | 0.35 | 1 | 0.30 | 0.11 | 10.00 | 7.10 | 0.75 | 9.80 | 1.03 | Thru Pond A |
| 2A | 0.35 | | 0.26 | 0.09 | 10.00 | 7.10 | 0.65 | 9.80 | 0.89 | Thru Pond B |
| | | | | 4.10 | | | | | | |

Pond A Acreage Area 1 + Area 4 1.29 acres
Pond B Acreage Area 2 + Area 3 2.51 acres

WARNING:
PRIOR TO THE BEGINNING OF ANY CONSTRUCTION OR CONSTRUCTION STAKING, IT SHALL BE THE CONTRACTOR'S RESPONSIBILITY TO CONTACT THE CIVIL ENGINEER TO ENSURE THAT ALL PARTIES ARE IN POSSESSION OF THE MOST CURRENT SET OF CONSTRUCTION DOCUMENTS.

NOTE:
THE CONTRACTOR SHALL BE RESPONSIBLE FOR FIELD VERIFYING THE LOCATION OF ALL EXISTING UTILITIES AND EASEMENTS PRIOR TO START OF OPERATIONS. CONTRACTOR WILL NOTIFY THE OWNER'S REPRESENTATIVE OF ANY DISCREPANCIES PRIOR TO STARTING THE WORK. EXISTING UTILITIES AND UNDERGROUND FACILITIES INDICATED ON THESE PLANS HAVE BEEN LOCATED FROM REFERENCE INFORMATION. IT SHALL BE THE RESPONSIBILITY OF THE CONTRACTOR TO VERIFY BOTH THE HORIZONTAL AND VERTICAL LOCATION OF ALL EXISTING UTILITIES AND UNDERGROUND FACILITIES PRIOR TO START OF CONSTRUCTION. TAKE THE NECESSARY PRECAUTIONS IN ORDER TO PROTECT ALL FACILITIES ENCOUNTERED. THE CONTRACTOR SHALL PRESERVE AND PROTECT ALL EXISTING UTILITIES FROM DAMAGE DURING CONSTRUCTION.

BENCHMARK:
PK NAIL IN CONCRETE.
NORTHING=7,021,752.890
EASTING=2,601,063.913
ELEVATION = 549.01'

AS-BUILT
May 12, 2021
Gerald Monk
GERALD E. MONK, P.E.

ONLY DRAWINGS STAMPED "RELEASED FOR CONSTRUCTION" BY THE CITY OF ROCKWALL TO BE USED FOR CONSTRUCTION.



CASE # SP2019-047
POST DRAINAGE AREA PLAN

BACON PLUMBING OFFICE


2055 KRISTY LANE
LOT 1-M, BODIN INDUSTRIAL TRACT, 3.54 ACRES
City of Rockwall, Rockwall County, Texas

owner
BACON PROPERTY, LLC
295 RANCH TRAIL
ROCKWALL, TEXAS 75032
CONTACT: BRAD BACON (972)236-5794

prepared by
MONK CONSULTING ENGINEERS, INC.
1200 W. State Street, Garland Texas 75040
972 272-1763 Fax 972 272-8761


REG NO.: F-2567
©2020 by Monk Consulting Engineers, Inc., All Rights Reserved.

date: 8/31/20 scale: 1" = 30' sheet: **C103A**

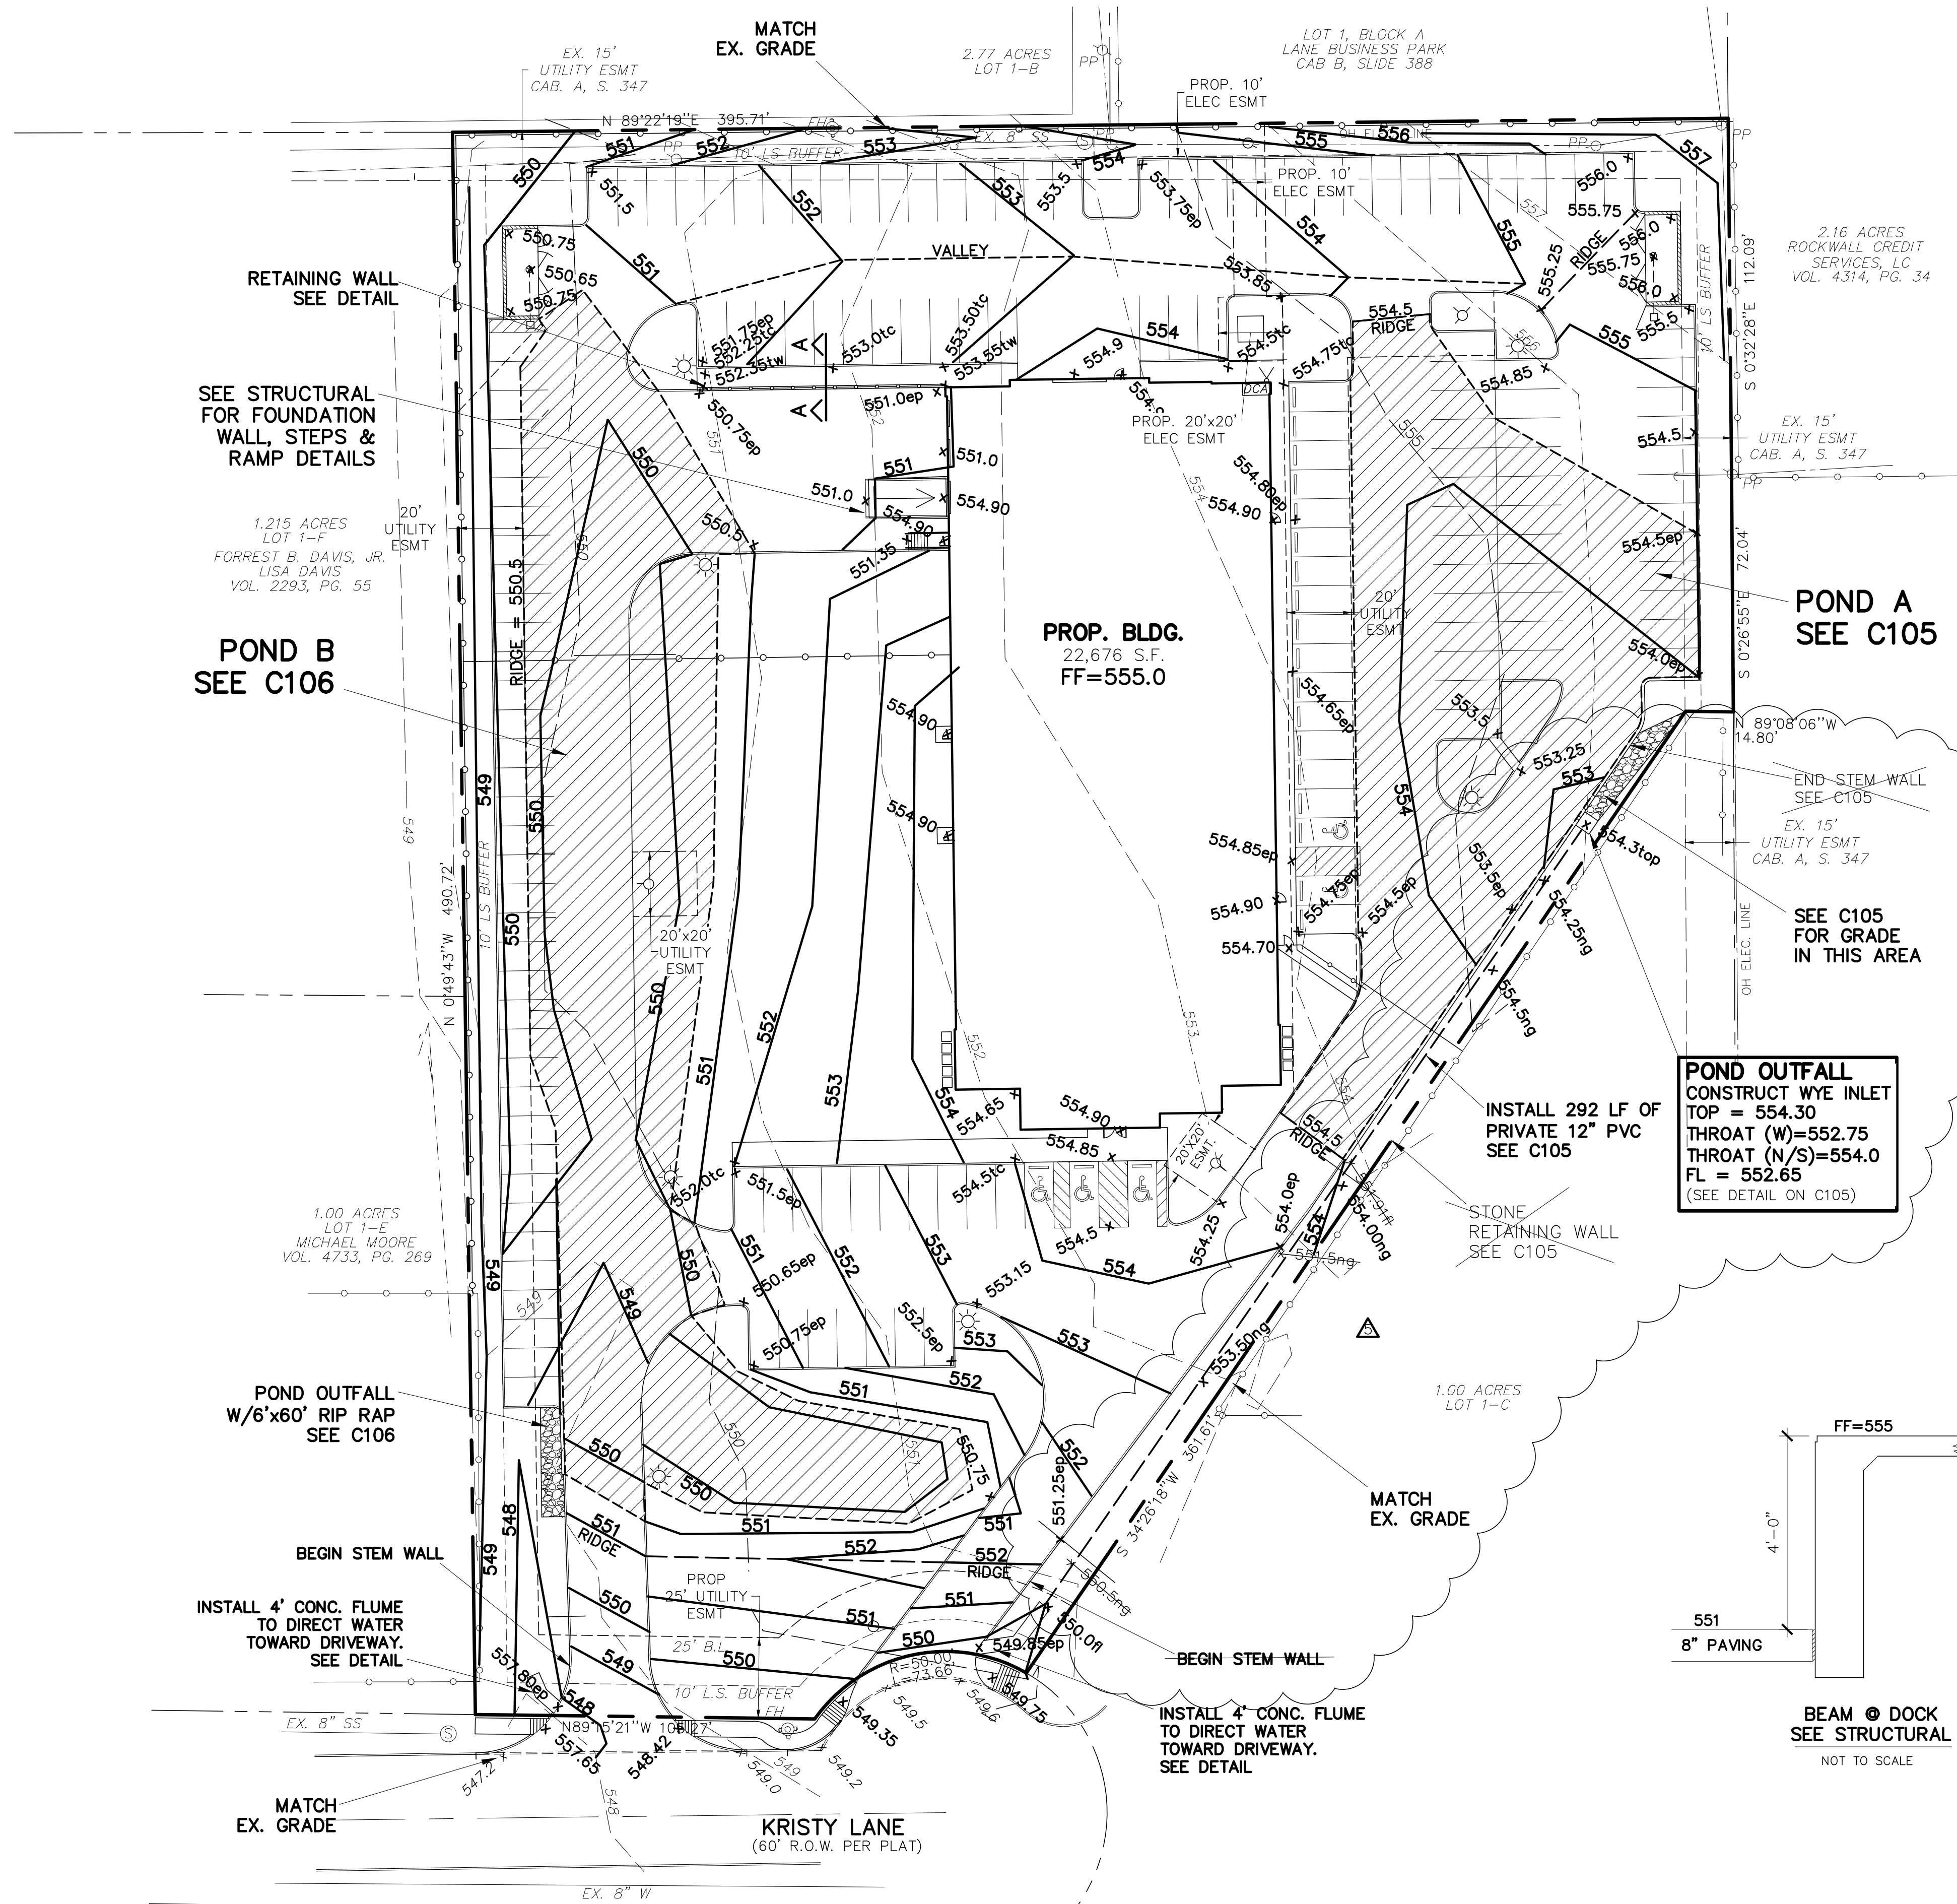

**** NOTICE TO CONTRACTORS ****
 TOPOGRAPHIC INFORMATION TAKEN FROM A TOPOGRAPHIC SURVEY PERFORMED BY H.D. FETTY OF ROYSE CITY, TEXAS. THE CONTRACTOR SHALL NOTIFY THE ENGINEER IMMEDIATELY, IN WRITING, OF ANY DISCREPANCIES OR OMISSIONS TO THE TOPOGRAPHIC INFORMATION. THE CONTRACTOR(S) SHALL BE RESPONSIBLE FOR CONFIRMING THE LOCATION (HORIZONTAL/VERTICAL) OF ANY BURIED CABLES, CONDUITS, PIPES, AND STRUCTURES (STORM SEWER, SANITARY SEWER, WATER, GAS, TELEVISION, TELEPHONE, ETC.) WHICH IMPACT THE CONSTRUCTION SITE. THE CONTRACTOR(S) SHALL NOTIFY THE OWNER AND ENGINEER IF ANY DISCREPANCIES ARE FOUND BETWEEN THE ACTUAL CONDITIONS VERSUS THE DATA CONTAINED IN THE CONSTRUCTION PLANS. ANY COSTS INCURRED AS THE RESULT OF NOT CONFIRMING THE ACTUAL LOCATION (HORIZONTAL/VERTICAL) OF SAID CABLES, CONDUITS, PIPES, AND STRUCTURES SHALL BE BORNE BY THE CONTRACTOR. ADDITIONALLY, THE CONTRACTOR(S) SHALL NOTIFY THE OWNER AND ENGINEER IF ANY ERRORS OR DISCREPANCIES ARE FOUND ON THE CONSTRUCTION DOCUMENTS (PS&E), WHICH NEGATIVELY IMPACT THE PROJECT. ENGINEER AND OWNER SHALL BE INDEMNIFIED OF PROBLEMS AND/OR COST WHICH MAY RESULT FROM CONTRACTOR'S FAILURE TO NOTIFY ENGINEER AND OWNER.


- NOTES:**
- 1) ALL WORK MUST CONFORM TO CITY OF ROCKWALL & NCTCOG STANDARDS AND DETAILS 5th EDITION.
 - 2) ALL WORK IN PUBLIC RIGHT-OF-WAY SHALL CONFORM TO CITY OF ROCKWALL STANDARDS AND DETAILS.
 - 3) SEE PLAT FOR ALL INFORMATION REGARDING EASEMENTS, PROPERTY LINES, ETC.
 - 4) ALL SPOT GRADE ARE EDGE OF PAVEMENT UNLESS OTHERWISE NOTED.
 - 5) ALL LINES UNDER BUILDING MUST BE TESTED WITH AIR OR WATER TO ENSURE THAT SOIL WILL NOT SEEP INTO PIPE AND RODE THE SOIL UNDER THE FOUNDATION.
 - 6) ANY STORM PIPE INSTALLED IN CITY R.O.W. MUST BE RCP.
 - 7) NO PERMANENT STRUCTURES (INCLUDING LIGHT POLES AND INLETS) MAY BE PLACED WITHIN A PUBLIC UTILITY EASEMENT.
 - 8) NO PART OF THE WALL (FOOTINGS, TIE BACKS, ETC) CAN BE OFF-SITE IN EASEMENTS, OR IN RIGHT OF WAY.
 - 9) ALL FILL TO BE COMPACTED TO A MINIMUM OF 95% STD DENSITY USING A SHEEP'S FOOT ROLLER.

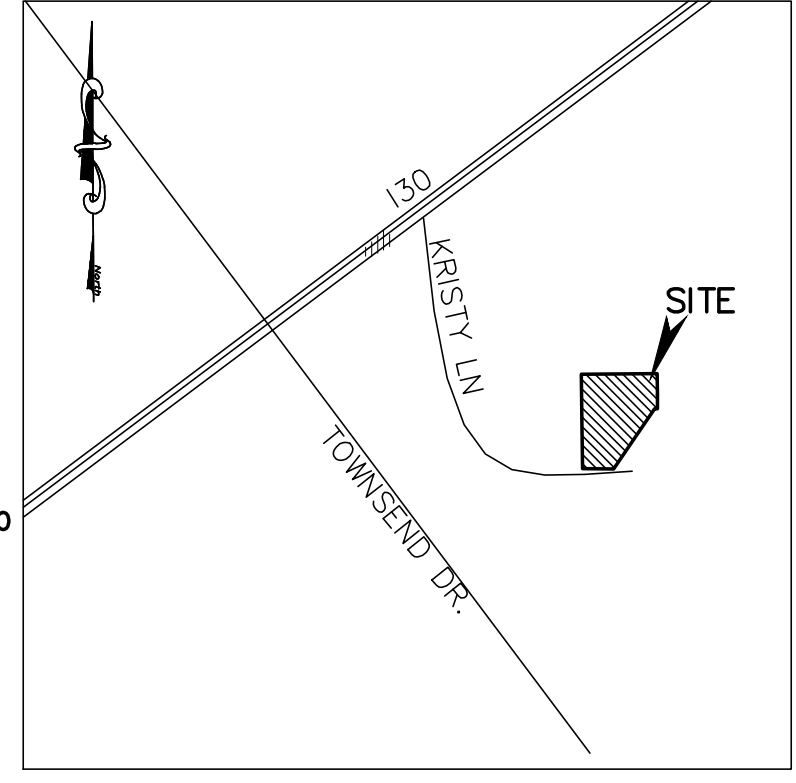

LOCATION MAP (NOT TO SCALE)

LEGEND


- = PROPERTY LINE
 - 460 = EXISTING CONTOURS
 - 460 = PROPOSED CONTOURS
 - 463.00 TC or 462.50 = PROPOSED SPOT GRADES
tc = TOP OF CURB
ep = EDGE OF PAVEMENT
tw = TOP OF WALL
bw = BOTTOM OF WALL
(ALL SPOT GRADES ARE EDGE OF PAVEMENT UNLESS OTHERWISE NOTED)
 - EX. SS = EXISTING SANITARY SEWER LINE
 - EX. W = EXISTING WATER LINE
 - FH = EXISTING FIRE HYDRANT
 - WM = EXISTING WATER METER
 - PP = EXISTING POWER POLE
 - LP = EXISTING LIGHT POLE
 - T = EX. WATER VALVE
 - S = EXISTING SEWER MANHOLE
 - G = EXISTING GAS METER
 - B-B = BACK OF CURB TO BACK OF CURB
 - EXIST. or EX. = EXISTING
 - RCP = REINFORCED CONCRETE PIPE
 - min = MINIMUM
 - max = MAXIMUM
 - FH = PROPOSED FIRE HYDRANT
 - [Hatched Area] = PROPOSED PONDING AREA
- revised date: 3/10/21 note: Added wye inlet & 12" PVC pipe behind curb

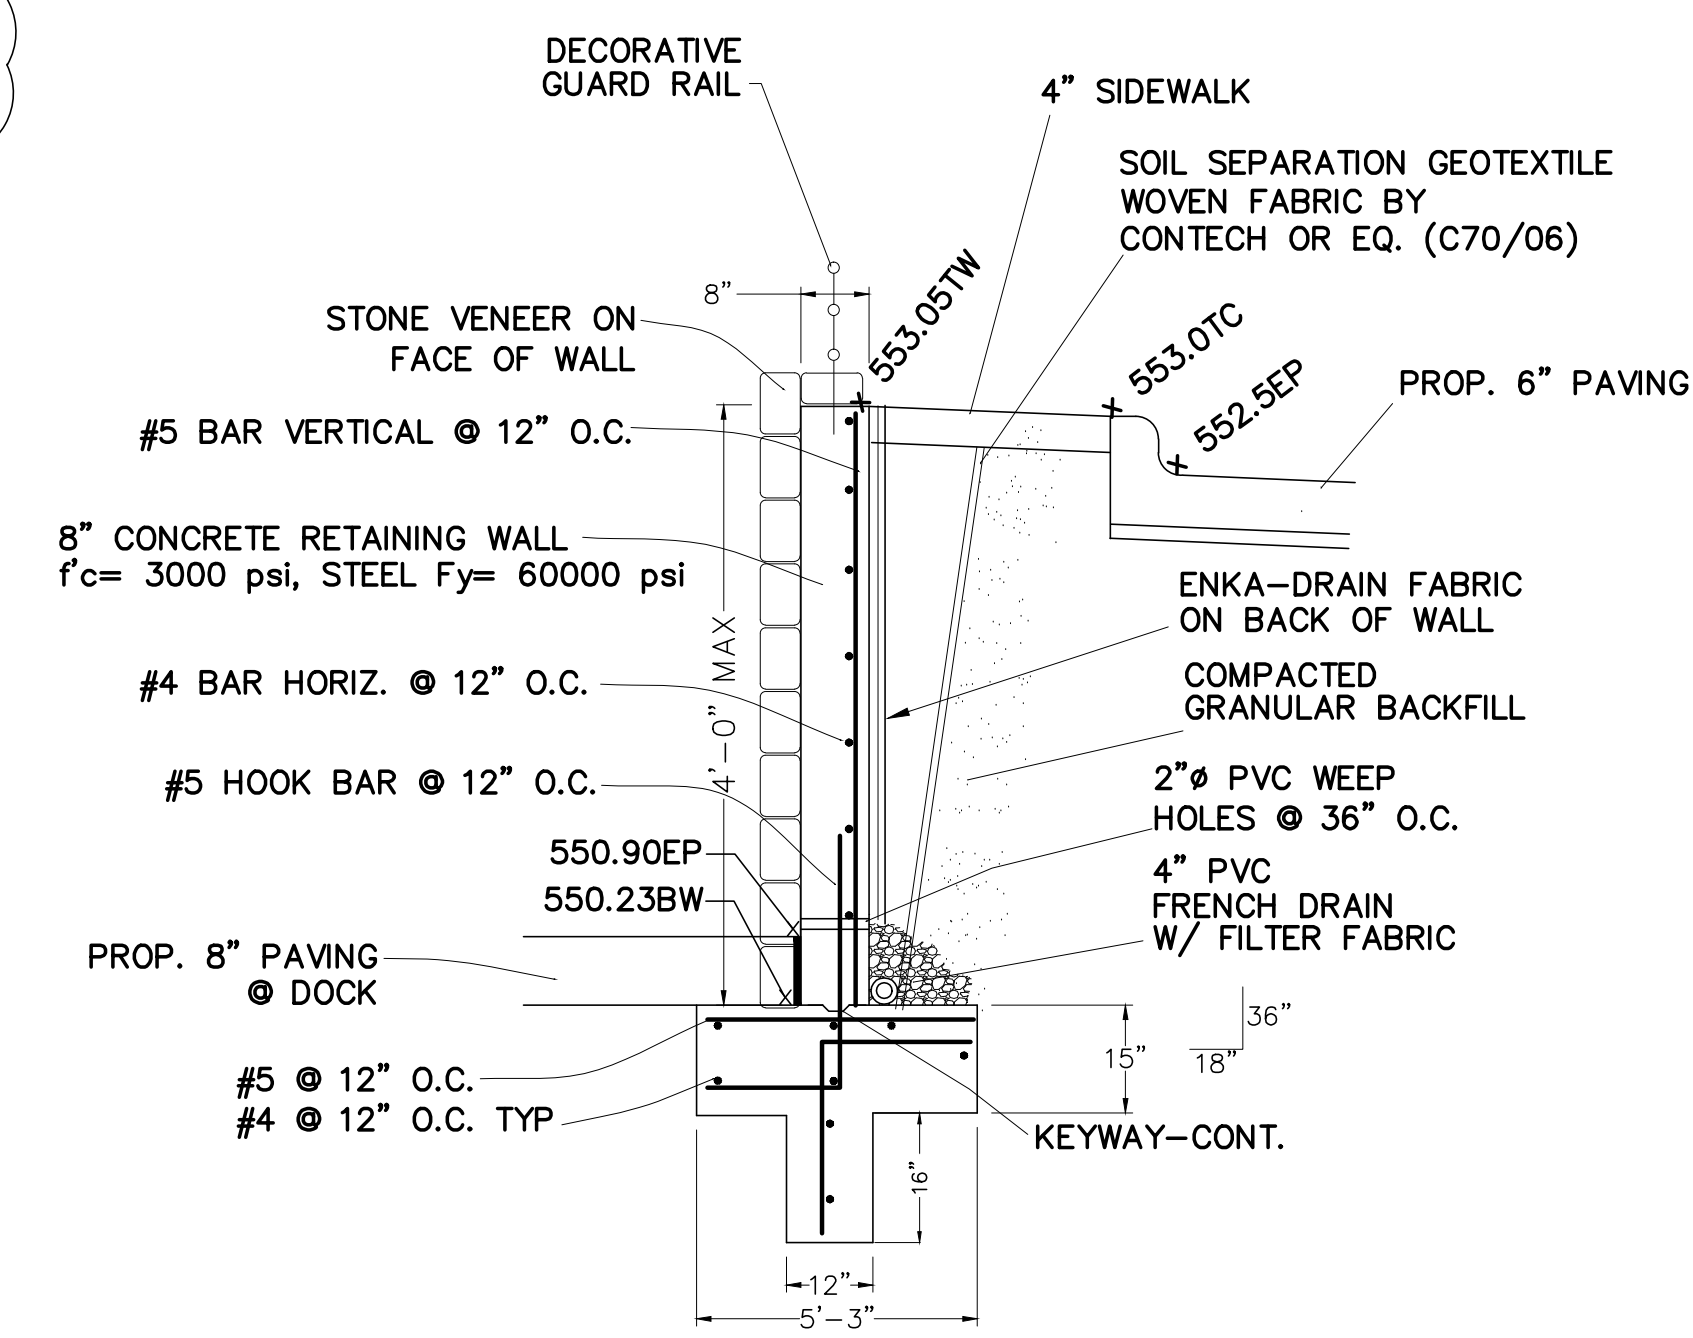


SECTION A-A RETAINING WALL (NOT TO SCALE)

NOTE: WALL ENGINEER OR DESIGNATED REPRESENTATIVE WILL NEED TO INSPECT WALL AS IT IS BEING INSTALLED. AN ACCEPTANCE LETTER FROM SAID PERSON STATING THAT WALL IS PER DESIGN WILL NEED TO BE SIGNED AND SEALED PRIOR TO ACCEPTANCE.


POND OUTFALL
 CONSTRUCT WYE INLET
 TOP = 554.30
 THROAT (W)=552.75
 THROAT (N/S)=554.0
 FL = 552.65
 (SEE DETAIL ON C105)

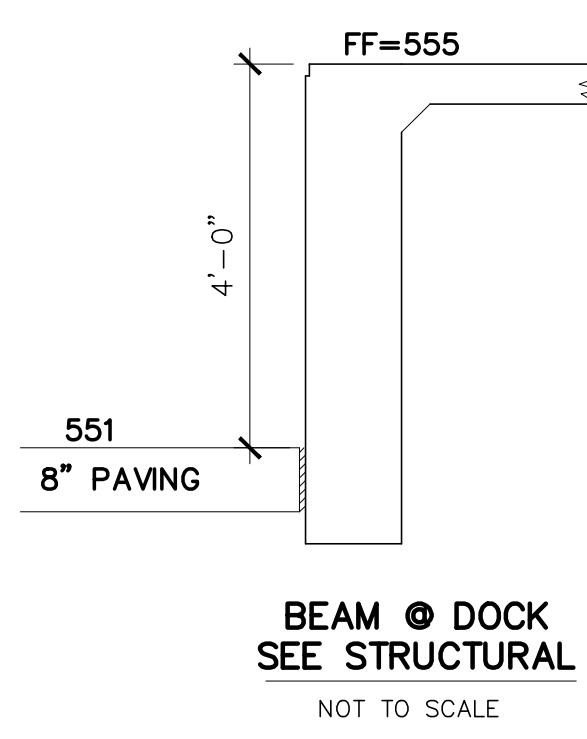

BEAM @ DOCK SEE STRUCTURAL (NOT TO SCALE)

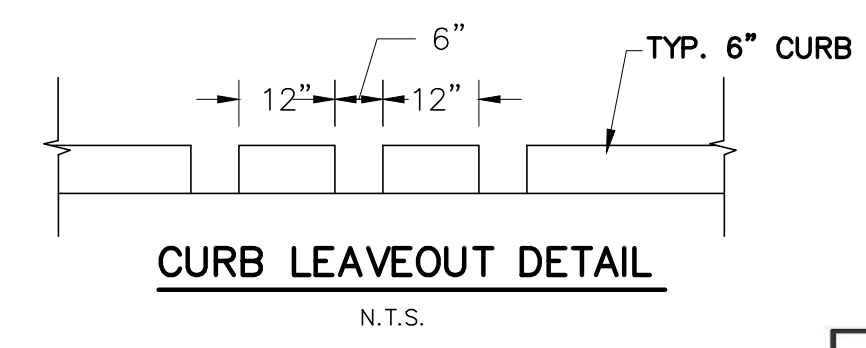

CURB LEAVEOUT DETAIL (N.T.S.)

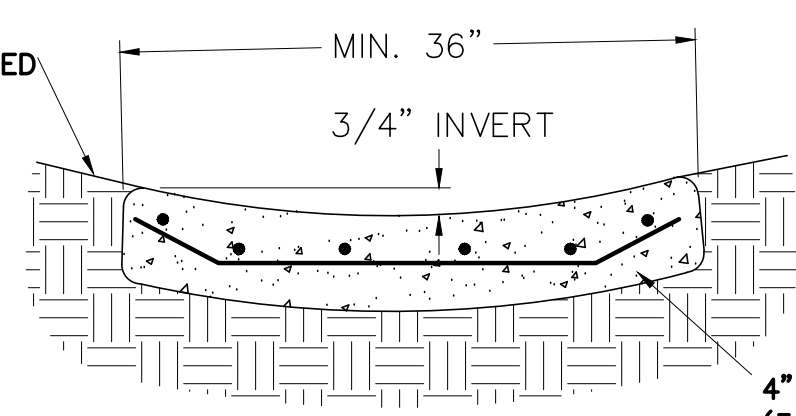

CONCRETE FLUME DETAIL (NOT TO SCALE)

AS-BUILT
 May 12, 2021
 Gerald Monk
 GERALD E. MONK, P.E.

TO THE BEST OF OUR KNOWLEDGE MONK CONSULTING ENGINEERS, INC. HEREBY STATES THAT THIS PLAN IS AS-BUILT. THE INFORMATION PROVIDED IS BASED ON SURVEYING AT THE SITE AND INFORMATION PROVIDED BY THE CONTRACTOR.

BENCHMARK:
 PK NAIL IN CONCRETE
 NORTHING=7,021,752.890
 EASTING=2,601,063.913
 ELEVATION = 549.01'

CASE # SP2019-047
GRADING & DRAINAGE PLAN
BACON PLUMBING OFFICE

2055 KRISTY LANE
 LOT 1-M, BODIN INDUSTRIAL TRACT, 3.54 ACRES
 City of Rockwall, Rockwall County, Texas

owner
BACON PROPERTY, LLC
 295 RANCH TRAIL
 ROCKWALL, TEXAS 75032
 CONTACT: BRAD BACON (972)236-5794











prepared by
MONK CONSULTING ENGINEERS, INC.
 1200 W. State Street, Garland Texas 75040
 972 272-1763 Fax 972 272-8761

REG NO.: F-2567
 ©2020 by Monk Consulting Engineers, Inc. All Rights Reserved.

date: 8/31/20 scale: 1" = 30' sheet: **C104**

WARNING:
 PRIOR TO THE BEGINNING OF ANY CONSTRUCTION OR CONSTRUCTION STAKING, IT SHALL BE THE CONTRACTORS RESPONSIBILITY TO CONTACT THE CIVIL ENGINEER TO ENSURE THAT ALL PARTIES ARE IN POSSESSION OF THE MOST CURRENT SET OF CONSTRUCTION DOCUMENTS.

NOTE:
 THE CONTRACTOR SHALL BE RESPONSIBLE FOR FIELD VERIFYING THE LOCATION OF ALL EXISTING UTILITIES AND EASEMENTS PRIOR TO START OF OPERATIONS. CONTRACTOR WILL NOTIFY THE OWNER'S REPRESENTATIVE OF ANY DISCREPANCIES PRIOR TO STARTING THE WORK. EXISTING UTILITIES AND UNDERGROUND FACILITIES INDICATED ON THESE PLANS HAVE BEEN LOCATED FROM REFERENCE INFORMATION. IT SHALL BE THE RESPONSIBILITY OF THE CONTRACTOR TO VERIFY BOTH THE HORIZONTAL AND VERTICAL LOCATION OF ALL EXISTING UTILITIES AND UNDERGROUND FACILITIES PRIOR TO START OF CONSTRUCTION. TAKE THE NECESSARY PRECAUTIONS IN ORDER TO PROTECT ALL FACILITIES ENCOUNTERED. THE CONTRACTOR SHALL PRESERVE AND PROTECT ALL EXISTING UTILITIES FROM DAMAGE DURING CONSTRUCTION.

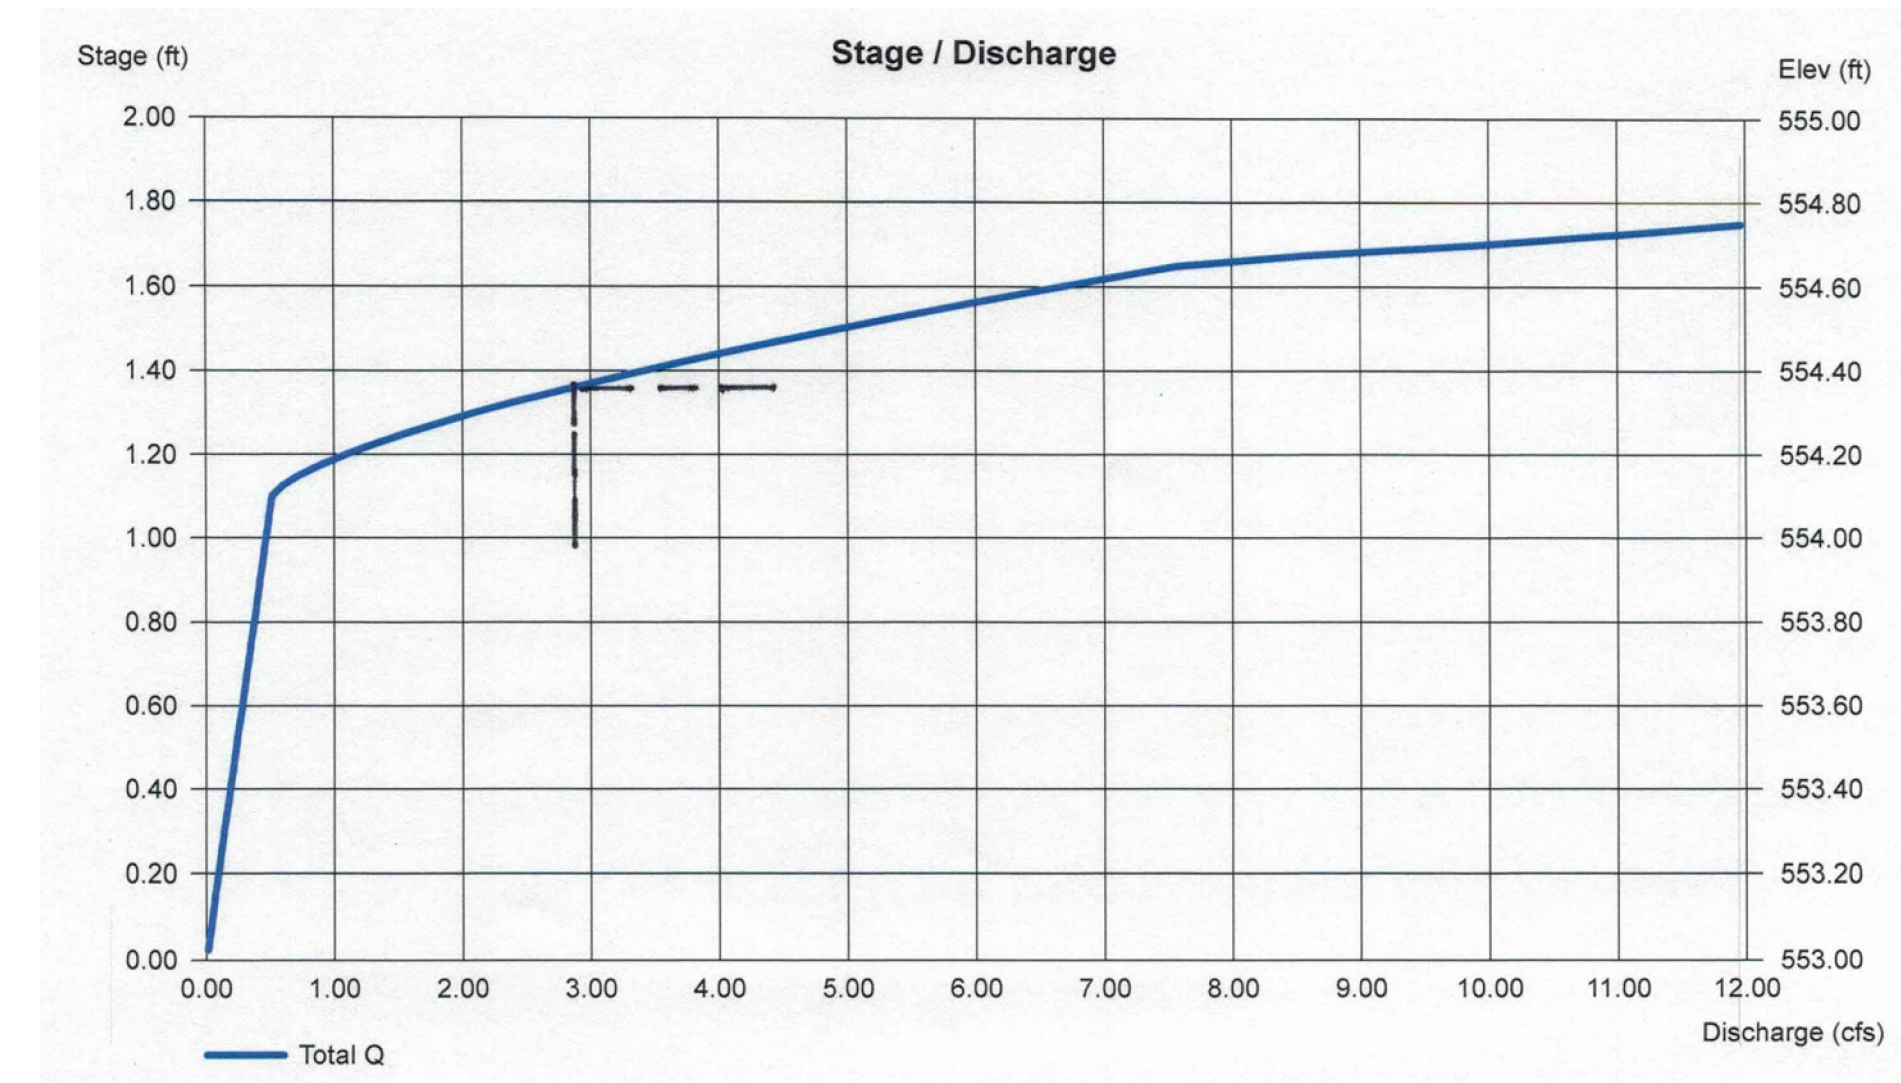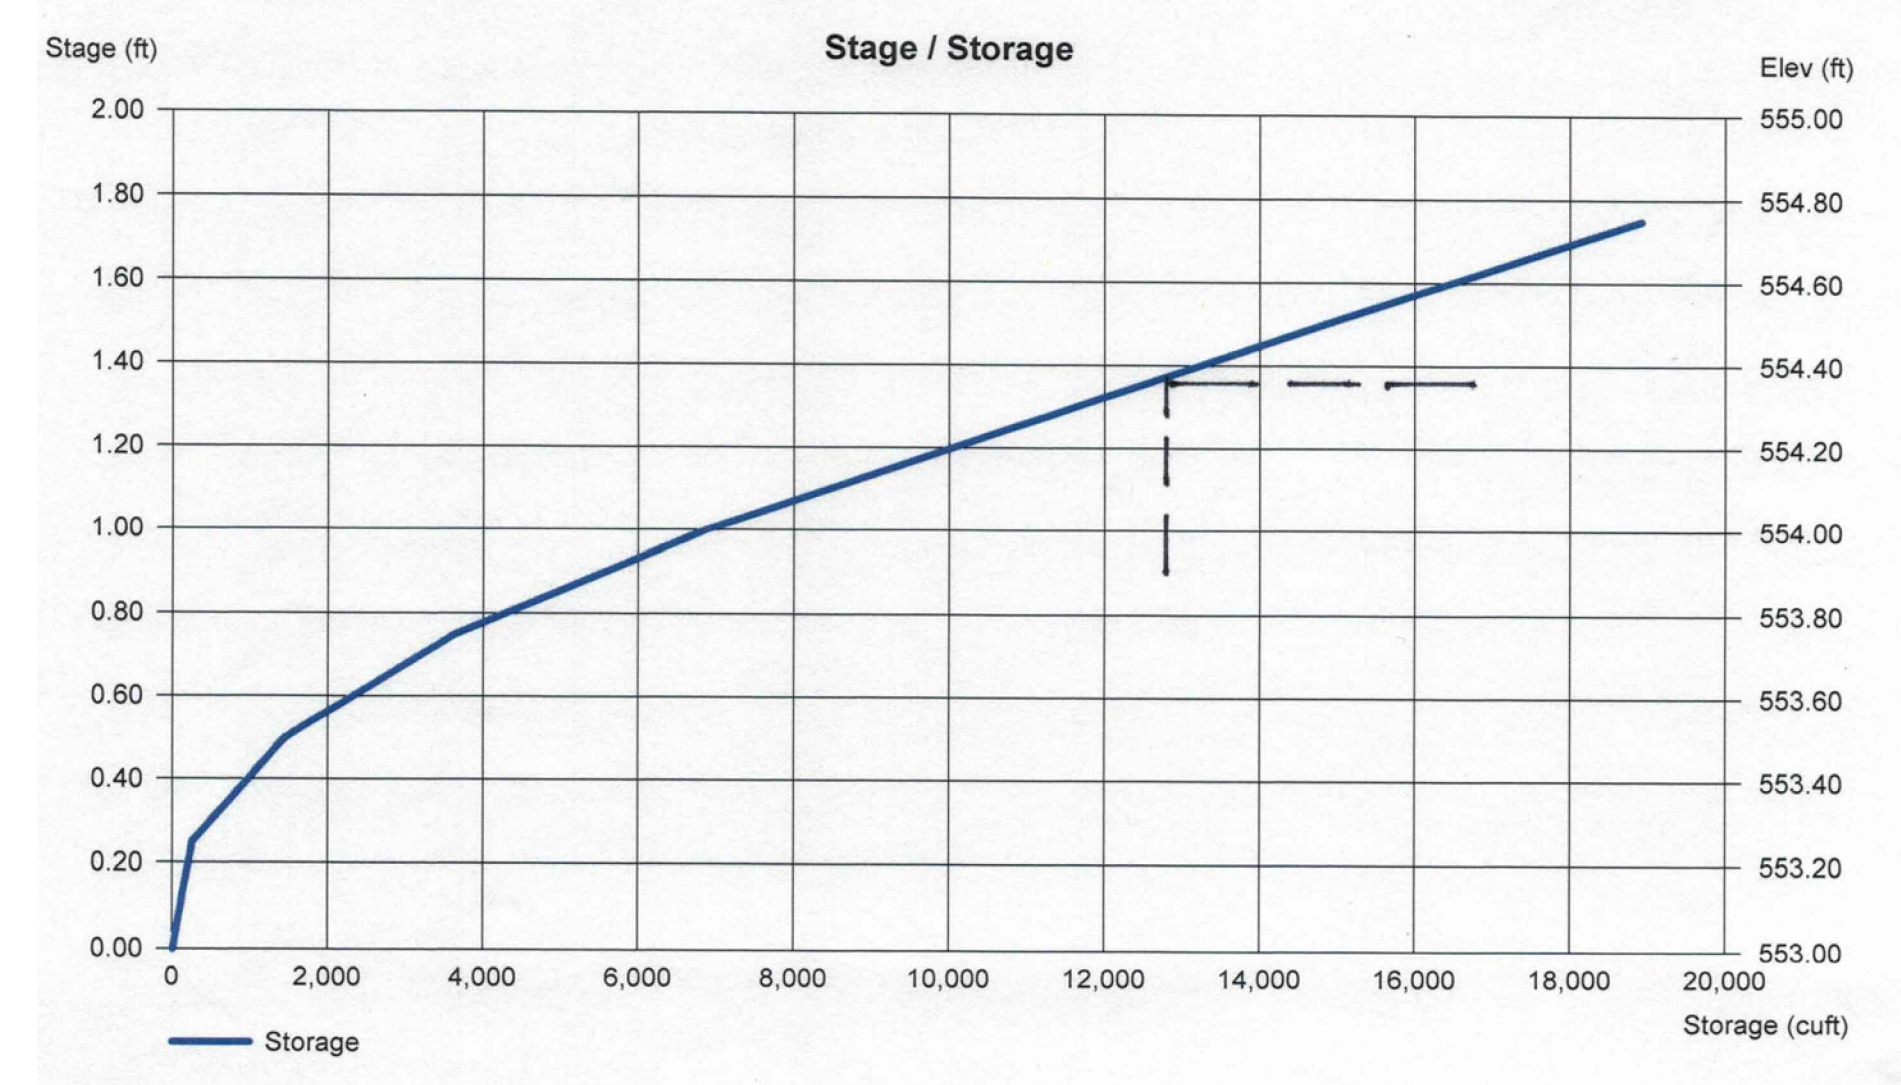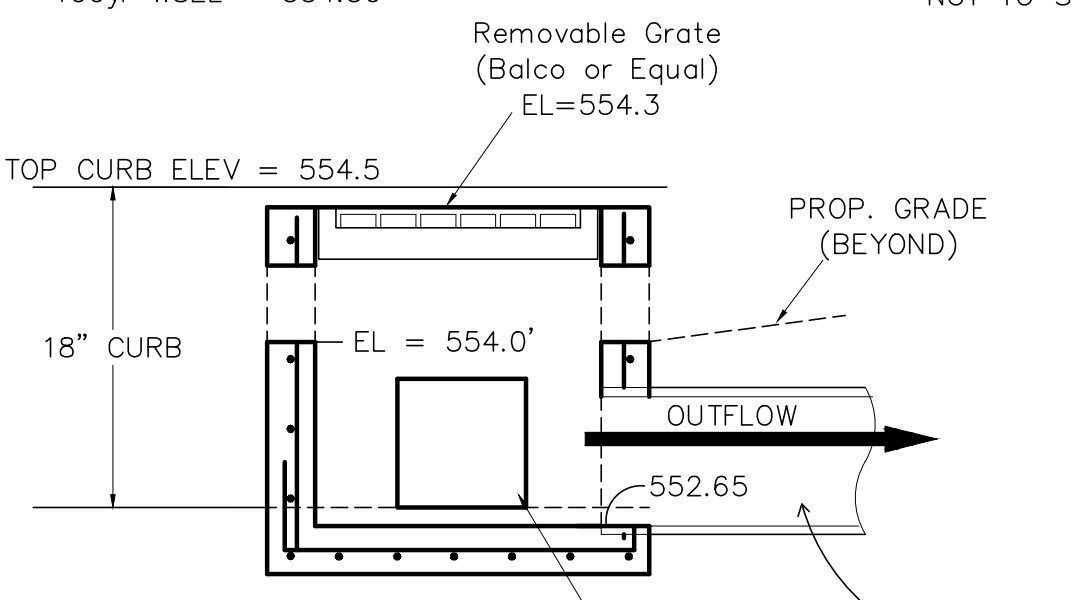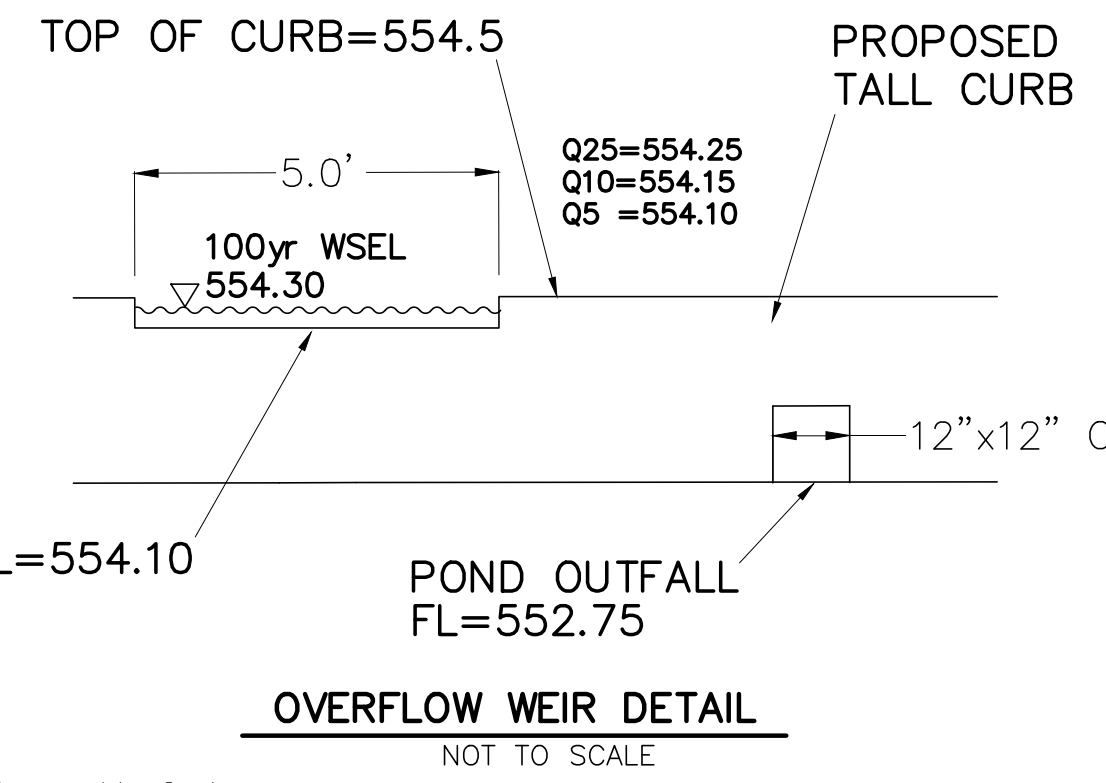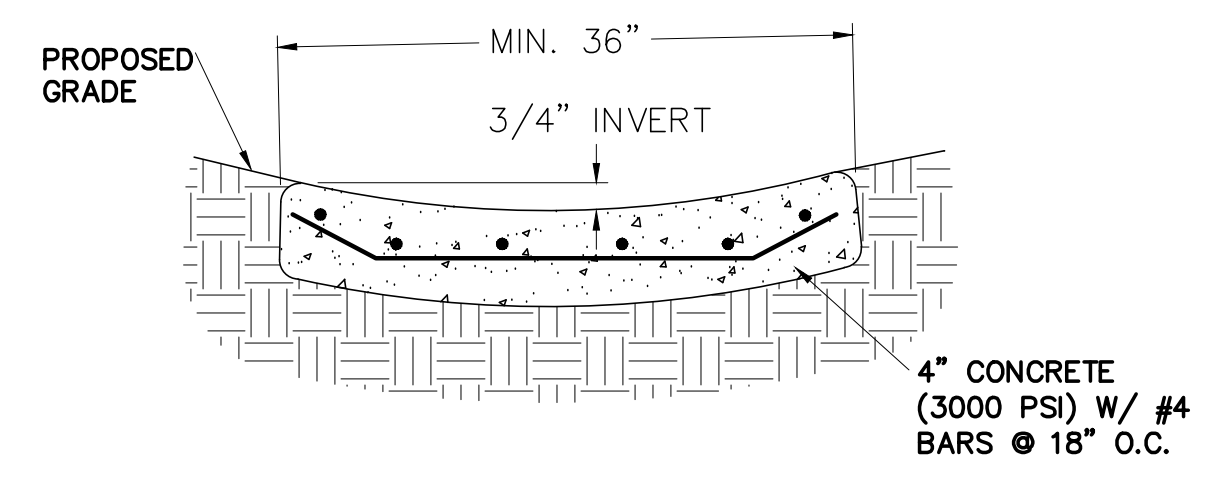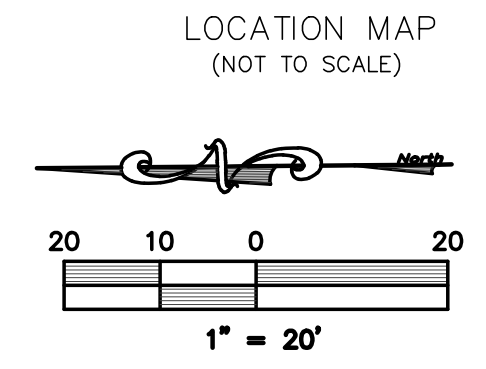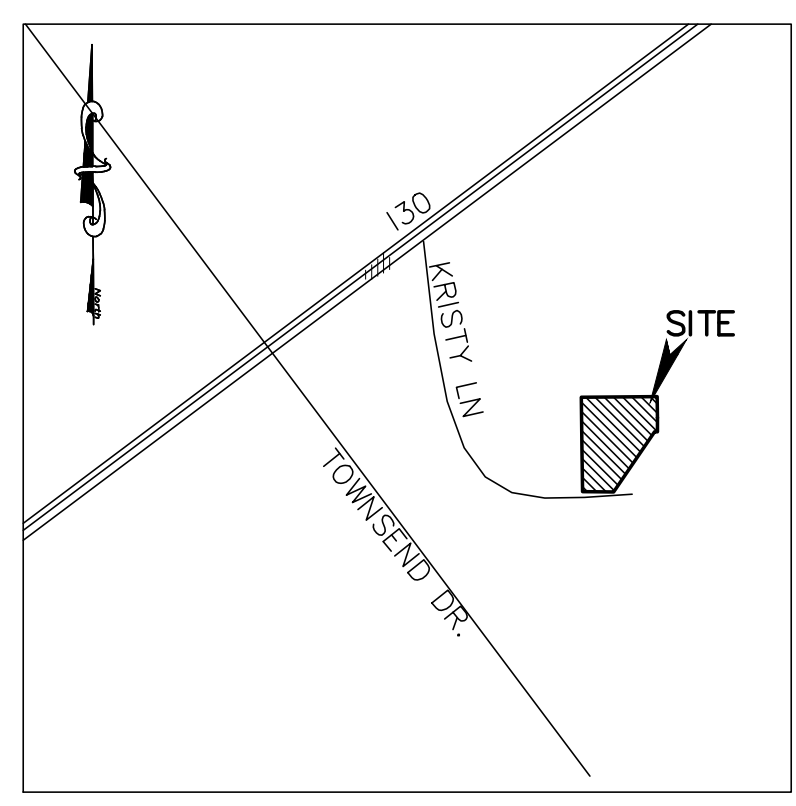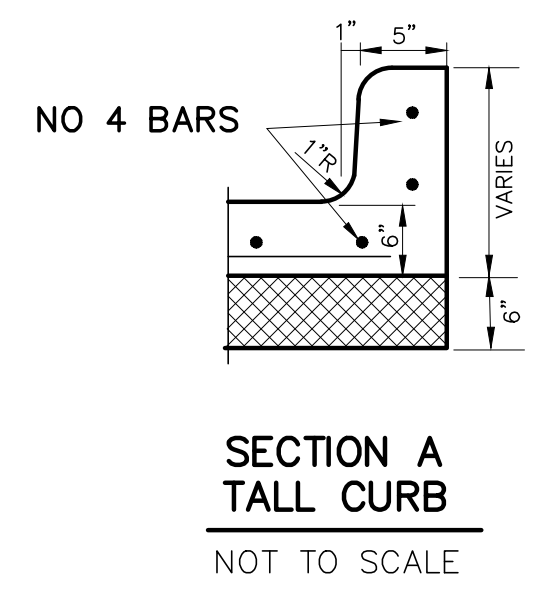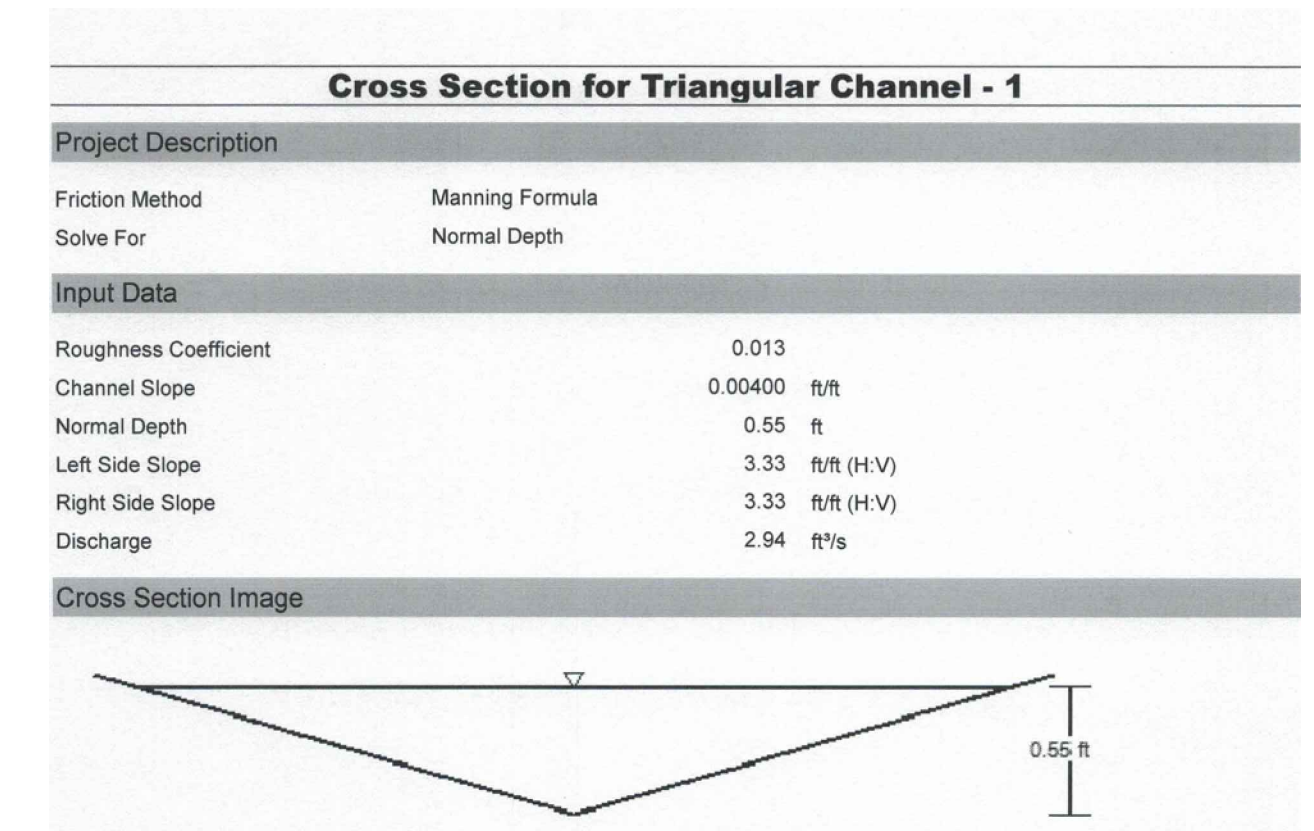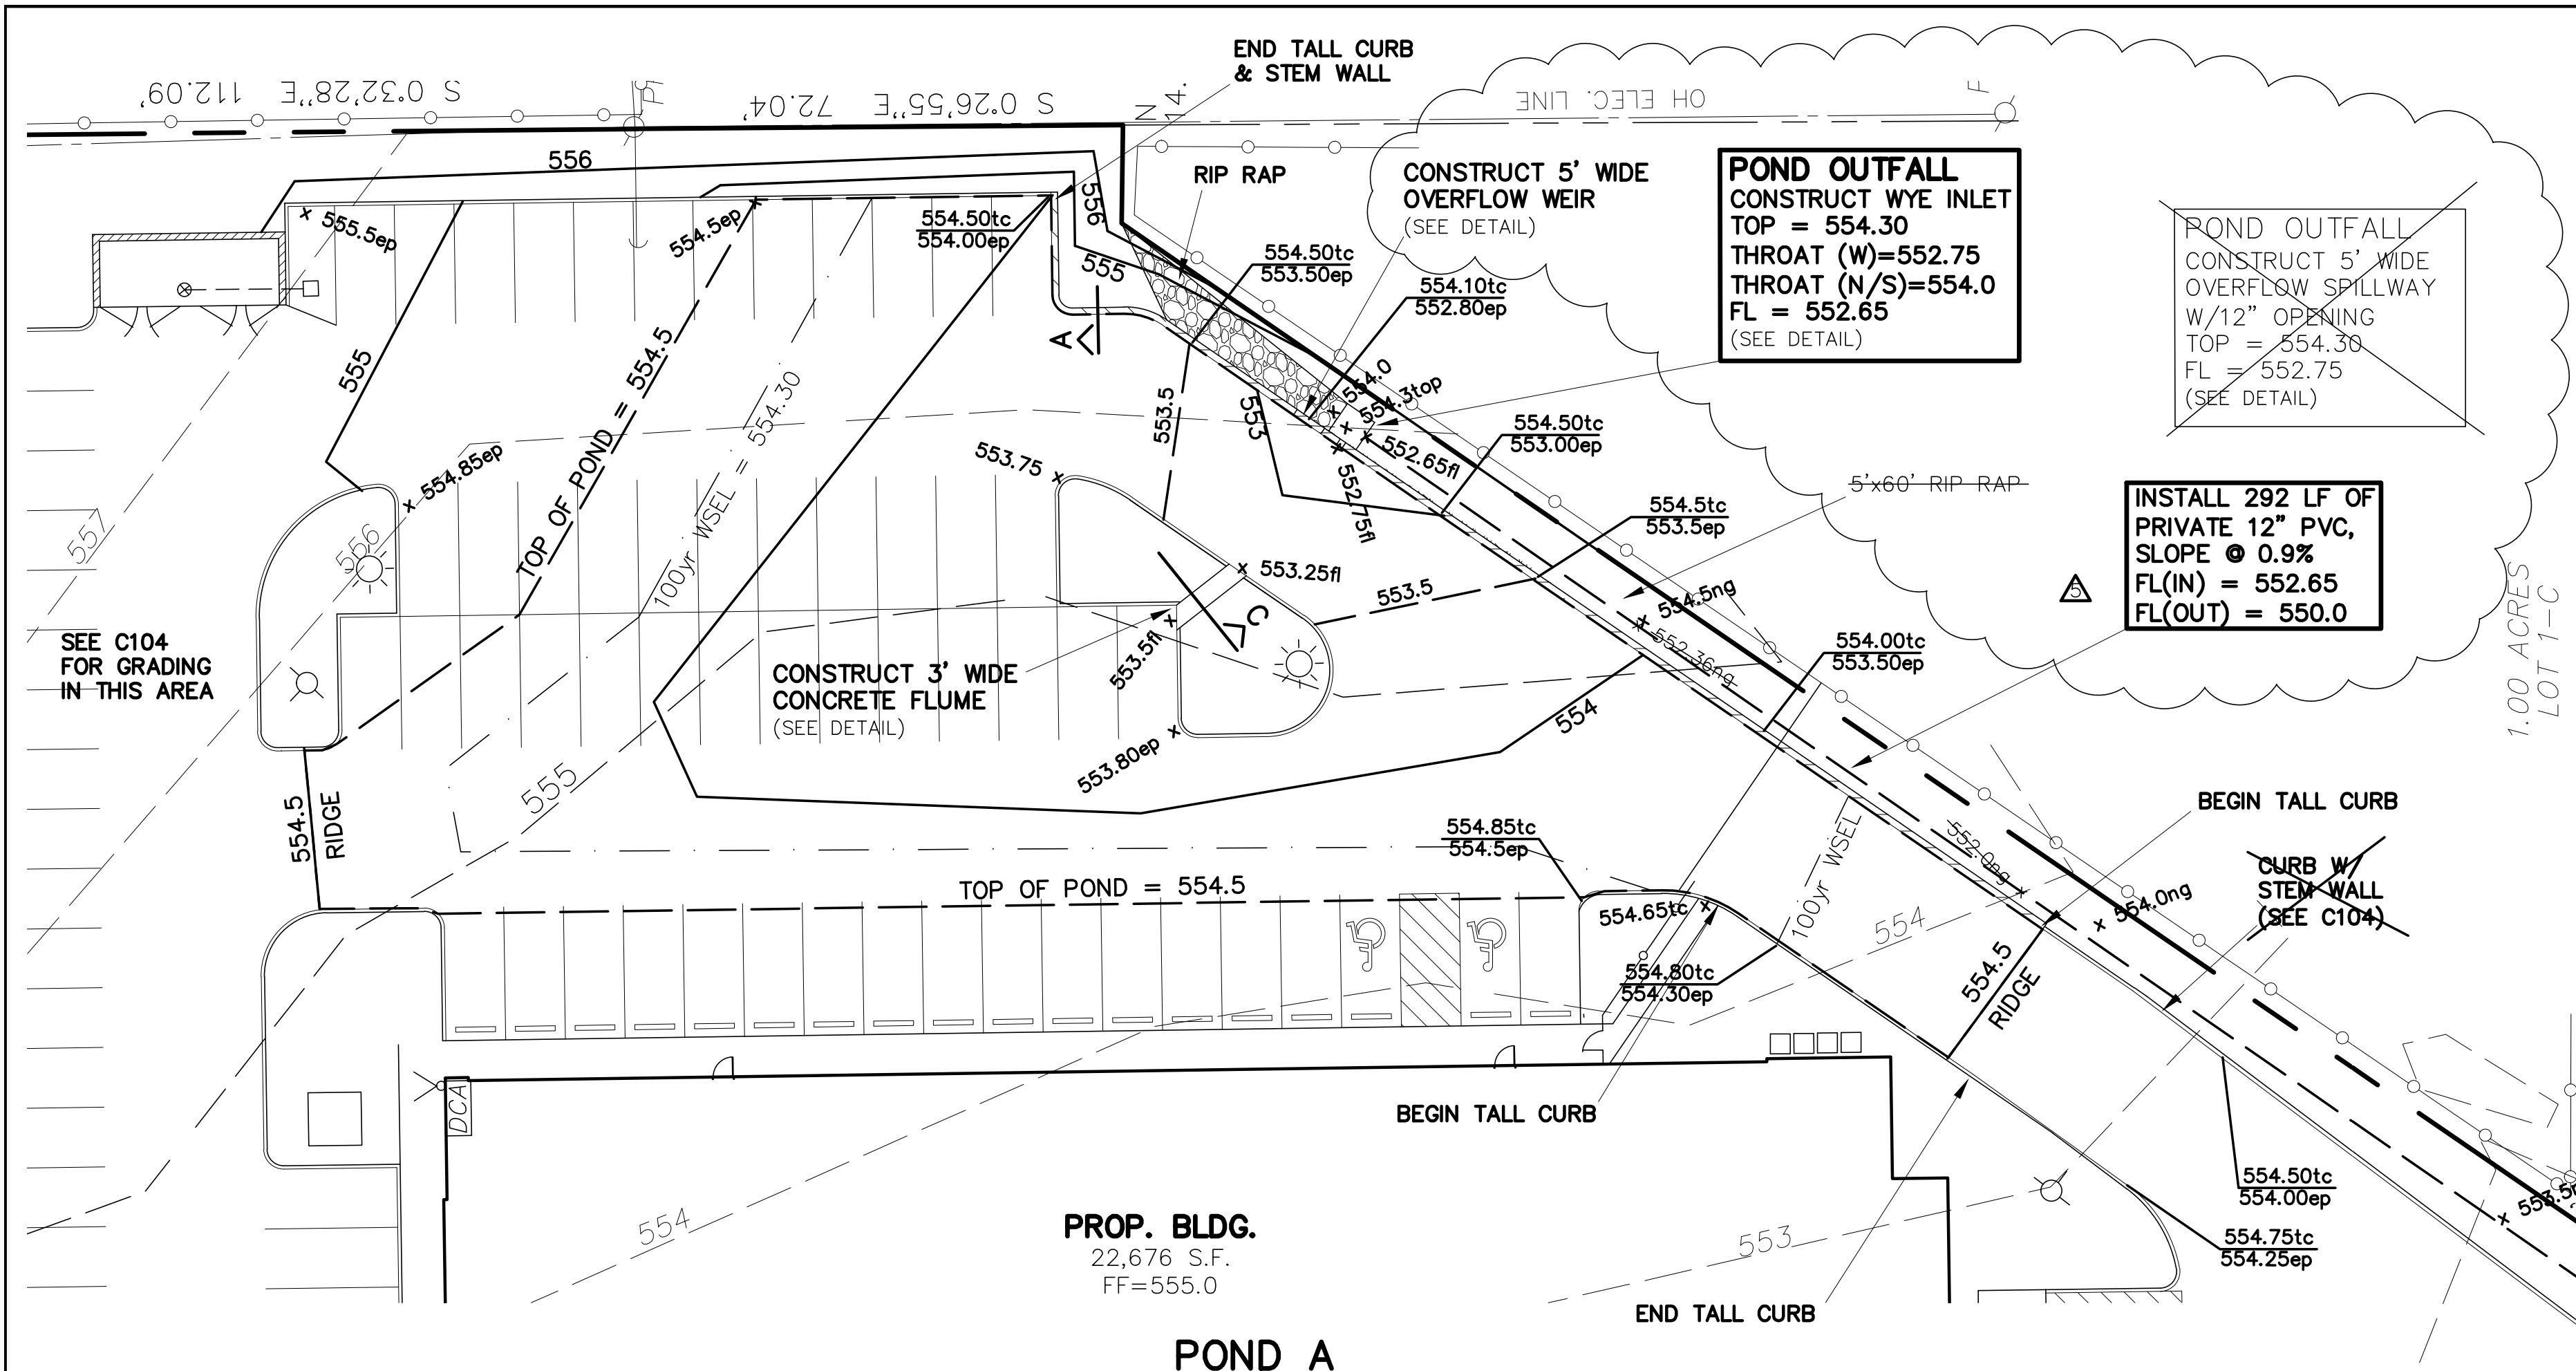

- LEGEND**
- = PROPERTY LINE
 - 460- = EXISTING CONTOURS
 - 460- = PROPOSED CONTOURS
 - x 463.00 TC or x 462.50 = PROPOSED SPOT GRADES (tc = TOP OF CURB, ep = EDGE OF PAVEMENT, bw = BOTTOM OF WALL) (ALL SPOT GRADES ARE EDGE OF PAVEMENT UNLESS OTHERWISE NOTED)
 - EX. SS --- = EXISTING SANITARY SEWER LINE
 - EX. W --- = EXISTING WATER LINE
 - ⊙ FHH = EXISTING FIRE HYDRANT
 - ∞ WM = EXISTING WATER METER
 - ⊙ PP = EXISTING POWER POLE
 - ⊙ LP = EXISTING LIGHT POLE
 - T = EX. WATER VALVE
 - ⊙ = EXISTING SEWER MANHOLE
 - ⊙ = EXISTING GAS METER
 - ⊙ = PROPOSED FIRE HYDRANT
- revised date: 3/10/21 note: Added wye inlet & 12\"/>

Pond Report

Hydraflow Hydrographs by Intellisolve v9.01 Monday, Apr 12, 2021
Pond No. 1 - Pond A
Pond Data
 Contours - User-defined contour areas. Average end area method used for volume calculation. Beginning Elevation = 552.75 ft

Stage / Storage Table

| Stage (ft) | Elevation (ft) | Contour area (sqft) | Incr. Storage (cuft) | Total storage (cuft) |
|------------|----------------|---------------------|----------------------|----------------------|
| 0.00 | 552.75 | 00 | 0 | 0 |
| 0.25 | 553.25 | 2,000 | 250 | 250 |
| 0.50 | 553.50 | 7,500 | 1,188 | 1,438 |
| 0.75 | 553.75 | 10,000 | 2,188 | 3,625 |
| 1.00 | 554.00 | 15,861 | 3,233 | 6,858 |
| 1.25 | 554.25 | 19,900 | 3,970 | 10,828 |
| 1.50 | 554.50 | 18,000 | 3,988 | 14,815 |
| 1.75 | 554.75 | 16,800 | 4,100 | 18,915 |

Culvert / Orifice Structures

| | [A] | [B] | [C] | [PrRsr] | | [A] | [B] | [C] | [D] |
|-----------------|----------|--------|------|----------|----------------|----------------------|--------|------|------|
| Rise (in) | = 12.00 | 12.00 | 0.00 | Inactive | Crest Len (ft) | = 12.00 | 3.50 | 0.00 | 0.00 |
| Span (in) | = 12.00 | 12.00 | 0.00 | 0.00 | Crest El. (ft) | = 554.50 | 554.00 | 0.00 | 0.00 |
| No. Barrels | = 1 | 1 | 0 | 1 | Weir Coeff. | = 3.33 | 3.33 | 3.33 | 3.33 |
| Invert El. (ft) | = 552.65 | 552.75 | 0.00 | 0.00 | Weir Type | = Riser | Rect | -- | -- |
| Length (ft) | = 222.00 | 0.50 | 0.00 | 0.00 | Multi-Stage | = Yes | Yes | No | No |
| Slope (%) | = 1.00 | 1.00 | 0.00 | n/a | | | | | |
| N-Value | = .013 | .013 | .013 | n/a | Exfil. (in/hr) | = 0.000 (by Contour) | | | |
| Orifice Coeff. | = 0.60 | 0.60 | 0.60 | 0.60 | TW Elev. (ft) | = 0.00 | | | |
| Multi-Stage | = n/a | Yes | No | No | | | | | |

Stage / Storage / Discharge Table

| Stage ft | Storage cuft | Elevation ft | Civ A cfs | Civ B cfs | Civ C cfs | PrRsr cfs | Wr A cfs | Wr B cfs | Wr C cfs | Wr D cfs | Exfil cfs | User cfs | Total cfs |
|----------|--------------|--------------|-----------|-----------|-----------|-----------|----------|----------|----------|----------|-----------|----------|-----------|
| 0.00 | 0 | 552.75 | 0.00 | 0.00 | -- | -- | 0.00 | 0.00 | -- | -- | -- | -- | 0.00 |
| 0.25 | 250 | 553.25 | 0.76 | 0.76 | -- | -- | 0.00 | 0.00 | -- | -- | -- | -- | 0.76 |
| 0.50 | 1,438 | 553.50 | 1.44 | 1.43 | -- | -- | 0.00 | 0.00 | -- | -- | -- | -- | 1.43 |
| 0.75 | 3,625 | 553.75 | 2.07 | 2.07 | -- | -- | 0.00 | 0.00 | -- | -- | -- | -- | 2.07 |
| 1.00 | 6,858 | 554.00 | 2.47 | 2.47 | -- | -- | 0.00 | 0.00 | -- | -- | -- | -- | 2.47 |
| 1.25 | 10,828 | 554.25 | 3.44 | 1.98 | -- | -- | 0.00 | 1.46 | -- | -- | -- | -- | 3.44 |
| 1.50 | 14,815 | 554.50 | 3.75 | 1.20 | -- | -- | 0.00 | 2.55 | -- | -- | -- | -- | 3.75 |
| 1.75 | 18,915 | 554.75 | 3.96 | 0.41 | -- | -- | 1.78 | 1.77 | -- | -- | -- | -- | 3.95 |

AS-BUILT
 May 12, 2021
 Gerald Monk
 GERALD E. MONK, P.E.



TO THE BEST OF OUR KNOWLEDGE MONK CONSULTING ENGINEERS, INC. HEREBY STATES THAT THIS PLAN IS AS-BUILT. THE INFORMATION PROVIDED IS BASED ON SURVEYING AT THE SITE AND INFORMATION PROVIDED BY THE CONTRACTOR.

CASE # SP2019-047

**POND LAYOUT PLAN
 POND A
 BACON PLUMBING OFFICE**

2055 KRISTY LANE
 LOT 1-M, BODIN INDUSTRIAL TRACT, 3.54 ACRES
 City of Rockwall, Rockwall County, Texas

owner
BACON PROPERTY, LLC
 295 RANCH TRAIL
 ROCKWALL, TEXAS 75032
 CONTACT: BRAD BACON (972)236-5794

prepared by
MONK CONSULTING ENGINEERS, INC.
 1200 W. State Street, Garland Texas 75040
 972 272-1763 Fax 972 272-8761

REG NO.: F-2567
 ©2020 by Monk Consulting Engineers, Inc., All Rights Reserved.

date: 8/31/20 scale: 1\"/>


BENCHMARK:
 PK NAIL IN CONCRETE.
 NORTHING=7,021,752.890
 EASTING=2,601,063.913
 ELEVATION = 549.01'

| Overall Detention Pond Modified Rational | | POND A | | | |
|--|--------|------------------------|------------------------------------|---------|------|
| Present Conditions | | Area 1 - Bypass Area 4 | | | |
| Q=CIA | | By-Pass Acreage | New Acreage | | |
| A= | 1.290 | 0.190 | 1.10 | | |
| C= | 0.35 | | | | |
| Tc= | 20.00 | | | | |
| I100= | 8.30 | | | | |
| Q100= | 3.75 | | | | |
| Future Conditions | | Offsite Condition | ByPass | Q Allow | |
| A= | 1.29 | 0.300 | 0.19 | | |
| A (adj) | 1.10 | | | | |
| C= | 0.90 | 0.350 | 0.90 | | |
| Tc= | 10.00 | 20 | 10.00 | | |
| I100= | 9.80 | 8.30 | 9.80 | | |
| Q100= | 11.38 | 0.872 | 1.68 | 2.94 | |
| Flow for Storm Duration | | (Developed) | Flow for Storm Durations (Offsite) | | |
| Time | I | C | Q (cfs) | Time | I |
| 10 min | 9.80 | 0.90 | 9.702 | 10 min | 9.80 |
| 15 min | 9.00 | 0.90 | 8.910 | 15 min | 9.00 |
| 20 min | 8.30 | 0.90 | 8.217 | 20 min | 8.30 |
| 30 min | 6.90 | 0.90 | 6.831 | 30 min | 6.90 |
| 40 min | 5.80 | 0.90 | 5.742 | 40 min | 5.80 |
| 50 min | 5.00 | 0.90 | 4.950 | 50 min | 5.00 |
| 60 min | 4.50 | 0.90 | 4.455 | 60 min | 4.50 |
| 70 min | 4.00 | 0.90 | 3.960 | 70 min | 4.00 |
| 80 min | 3.70 | 0.90 | 3.663 | 80 min | 3.70 |
| 90 min | 3.50 | 0.90 | 3.465 | 90 min | 3.50 |
| 100 min | 3.40 | 0.90 | 3.366 | 100 min | 3.40 |
| 110 min | 3.20 | 0.90 | 3.168 | 110 min | 3.20 |
| Storage Calculations | | | | | |
| 10 min | | | CF | | |
| Inflow | 6,439 | Storage | 4,673 | | |
| Outflow | 1,766 | | | | |
| 15 min | | | | | |
| Inflow | 8,870 | Storage | 6,662 | | |
| Outflow | 2,207 | | | | |
| 20 min | | | | | |
| Inflow | 10,906 | Storage | 8,257 | | |
| Outflow | 2,649 | | | | |
| 30 min | | | | | |
| Inflow | 13,600 | Storage | 10,068 | | |
| Outflow | 3,532 | | | | |
| 40 min | | | | | |
| Inflow | 15,242 | Storage | 10,828 | | |
| Outflow | 4,415 | | | | |
| 50 min | | | | | |
| Inflow | 16,425 | Storage | 11,127 | | |
| Outflow | 5,298 | | | | |
| 60 min | | | | | |
| Inflow | 17,739 | Storage | 11,558 | | |
| Outflow | 6,181 | | | | |
| 70 min | | | | | |
| Inflow | 18,396 | Storage | 11,332 | | |
| Outflow | 7,064 | | | | |
| 80 min | | | | | |
| Inflow | 19,447 | Storage | 11,501 | | |
| Outflow | 7,947 | | | | |
| 90 min | | | | | |
| Inflow | 20,696 | Storage | 11,866 | | |
| Outflow | 8,829 | | | | |
| 100 min | | | | | |
| Inflow | 22,338 | Storage | 12,626 | | |
| Outflow | 9,712 | | | | |
| 110 min | | | | | |
| Inflow | 21,024 | Storage | 10,429 | | |
| Outflow | 10,595 | | | | |


| Overall Detention Pond Modified Rational | | POND A | | | |
|--|--------|------------------------|------------------------------------|---------|------|
| Present Conditions | | Area 1 - Bypass Area 4 | | | |
| Q=CIA | | By-Pass Acreage | New Acreage | | |
| A= | 1.290 | 0.190 | 1.10 | | |
| C= | 0.35 | | | | |
| Tc= | 20.00 | | | | |
| I25 | 6.30 | | | | |
| Q100= | 2.84 | | | | |
| Future Conditions | | Offsite Condition | ByPass | Q Allow | |
| A= | 1.29 | 0.300 | 0.19 | | |
| A (adj) | 1.10 | | | | |
| C= | 0.90 | 0.350 | 0.90 | | |
| Tc= | 10.00 | 20 | 10.00 | | |
| I25 | 8.30 | 8.30 | 9.80 | | |
| Q100= | 9.64 | 0.872 | 1.68 | 2.04 | |
| Flow for Storm Duration | | (Developed) | Flow for Storm Durations (Offsite) | | |
| Time | I | C | Q (cfs) | Time | I |
| 10 min | 8.30 | 0.90 | 8.217 | 10 min | 8.30 |
| 15 min | 7.50 | 0.90 | 7.425 | 15 min | 7.50 |
| 20 min | 6.60 | 0.90 | 6.534 | 20 min | 6.60 |
| 30 min | 5.50 | 0.90 | 5.445 | 30 min | 5.50 |
| 40 min | 4.60 | 0.90 | 4.554 | 40 min | 4.60 |
| 50 min | 4.00 | 0.90 | 3.960 | 50 min | 4.00 |
| 60 min | 3.50 | 0.90 | 3.465 | 60 min | 3.50 |
| 70 min | 3.30 | 0.90 | 3.267 | 70 min | 3.30 |
| 80 min | 3.10 | 0.90 | 3.069 | 80 min | 3.10 |
| 90 min | 2.90 | 0.90 | 2.871 | 90 min | 2.90 |
| 100 min | 2.70 | 0.90 | 2.673 | 100 min | 2.70 |
| 110 min | 2.50 | 0.90 | 2.475 | 110 min | 2.50 |
| Storage Calculations | | | | | |
| 10 min | | | CF | | |
| Inflow | 5,453 | Storage | 4,229 | | |
| Outflow | 1,224 | | | | |
| 15 min | | | | | |
| Inflow | 7,391 | Storage | 5,861 | | |
| Outflow | 1,530 | | | | |
| 20 min | | | | | |
| Inflow | 8,672 | Storage | 6,836 | | |
| Outflow | 1,836 | | | | |
| 30 min | | | | | |
| Inflow | 10,841 | Storage | 8,392 | | |
| Outflow | 2,448 | | | | |
| 40 min | | | | | |
| Inflow | 12,089 | Storage | 9,029 | | |
| Outflow | 3,060 | | | | |
| 50 min | | | | | |
| Inflow | 13,140 | Storage | 9,468 | | |
| Outflow | 3,672 | | | | |
| 60 min | | | | | |
| Inflow | 13,797 | Storage | 9,513 | | |
| Outflow | 4,284 | | | | |
| 70 min | | | | | |
| Inflow | 15,177 | Storage | 10,280 | | |
| Outflow | 4,896 | | | | |
| 80 min | | | | | |
| Inflow | 16,294 | Storage | 10,785 | | |
| Outflow | 5,508 | | | | |
| 90 min | | | | | |
| Inflow | 17,148 | Storage | 11,027 | | |
| Outflow | 6,120 | | | | |
| 100 min | | | | | |
| Inflow | 17,739 | Storage | 11,007 | | |
| Outflow | 6,732 | | | | |
| 110 min | | | | | |
| Inflow | 16,425 | Storage | 9,080 | | |
| Outflow | 7,345 | | | | |

| Overall Detention Pond Modified Rational | | POND A | | | |
|--|--------|------------------------|------------------------------------|---------|------|
| Present Conditions | | Area 1 - Bypass Area 4 | | | |
| Q=CIA | | By-Pass Acreage | New Acreage | | |
| A= | 1.290 | 0.190 | 1.10 | | |
| C= | 0.35 | | | | |
| Tc= | 20.00 | | | | |
| I10 | 5.90 | | | | |
| Q100= | 2.66 | | | | |
| Future Conditions | | Offsite Condition | ByPass | Q Allow | |
| A= | 1.29 | 0.300 | 0.19 | | |
| A (adj) | 1.10 | | | | |
| C= | 0.90 | 0.350 | 0.90 | | |
| Tc= | 10.00 | 20 | 10.00 | | |
| I10 | 7.10 | 8.30 | 9.80 | | |
| Q100= | 8.24 | 0.872 | 1.68 | 1.86 | |
| Flow for Storm Duration | | (Developed) | Flow for Storm Durations (Offsite) | | |
| Time | I | C | Q (cfs) | Time | I |
| 10 min | 7.10 | 0.90 | 7.029 | 10 min | 7.10 |
| 15 min | 6.50 | 0.90 | 6.435 | 15 min | 6.50 |
| 20 min | 5.90 | 0.90 | 5.841 | 20 min | 5.90 |
| 30 min | 4.80 | 0.90 | 4.752 | 30 min | 4.80 |
| 40 min | 4.00 | 0.90 | 3.960 | 40 min | 4.00 |
| 50 min | 3.50 | 0.90 | 3.465 | 50 min | 3.50 |
| 60 min | 3.00 | 0.90 | 2.970 | 60 min | 3.00 |
| 70 min | 2.80 | 0.90 | 2.772 | 70 min | 2.80 |
| 80 min | 2.60 | 0.90 | 2.574 | 80 min | 2.60 |
| 90 min | 2.50 | 0.90 | 2.475 | 90 min | 2.50 |
| 100 min | 2.40 | 0.90 | 2.376 | 100 min | 2.40 |
| 110 min | 2.30 | 0.90 | 2.277 | 110 min | 2.30 |
| Storage Calculations | | | | | |
| 10 min | | | CF | | |
| Inflow | 4,665 | Storage | 3,549 | | |
| Outflow | 1,116 | | | | |
| 15 min | | | | | |
| Inflow | 6,406 | Storage | 5,011 | | |
| Outflow | 1,395 | | | | |
| 20 min | | | | | |
| Inflow | 7,753 | Storage | 6,079 | | |
| Outflow | 1,674 | | | | |
| 30 min | | | | | |
| Inflow | 9,461 | Storage | 7,229 | | |
| Outflow | 2,231 | | | | |
| 40 min | | | | | |
| Inflow | 10,512 | Storage | 7,723 | | |
| Outflow | 2,789 | | | | |
| 50 min | | | | | |
| Inflow | 11,498 | Storage | 8,150 | | |
| Outflow | 3,347 | | | | |
| 60 min | | | | | |
| Inflow | 11,826 | Storage | 7,921 | | |
| Outflow | 3,905 | | | | |
| 70 min | | | | | |
| Inflow | 12,877 | Storage | 8,414 | | |
| Outflow | 4,463 | | | | |
| 80 min | | | | | |
| Inflow | 13,666 | Storage | 8,645 | | |
| Outflow | 5,021 | | | | |
| 90 min | | | | | |
| Inflow | 14,783 | Storage | 9,204 | | |
| Outflow | 5,579 | | | | |
| 100 min | | | | | |
| Inflow | 15,768 | Storage | 9,631 | | |
| Outflow | 6,137 | | | | |
| 110 min | | | | | |
| Inflow | 15,111 | Storage | 8,417 | | |
| Outflow | 6,694 | | | | |


| Overall Detention Pond Modified Rational | | POND A | | | |
|--|-------|------------------------|------------------------------------|---------|------|
| Present Conditions | | Area 1 - Bypass Area 4 | | | |
| Q=CIA | | By-Pass Acreage | New Acreage | | |
| A= | 1.290 | 0.190 | 1.10 | | |
| C= | 0.35 | | | | |
| Tc= | 20.00 | | | | |
| I5 | 4.90 | | | | |
| Q100= | 2.21 | | | | |
| Future Conditions | | Offsite Condition | ByPass | Q Allow | |
| A= | 1.29 | 0.300 | 0.19 | | |
| A (adj) | 1.10 | | | | |
| C= | 0.90 | 0.350 | 0.90 | | |
| Tc= | 10.00 | 20 | 10.00 | | |
| I5 | 6.10 | 8.30 | 9.80 | | |
| Q100= | 7.08 | 0.872 | 1.68 | 1.41 | |
| Flow for Storm Duration | | (Developed) | Flow for Storm Durations (Offsite) | | |
| Time | I | C | Q (cfs) | Time | I |
| 10 min | 6.10 | 0.90 | 6.039 | 10 min | 6.10 |
| 15 min | 5.50 | 0.90 | 5.445 | 15 min | 5.50 |
| 20 min | 4.90 | 0.90 | 4.851 | 20 min | 4.90 |
| 30 min | 4.10 | 0.90 | 4.059 | 30 min | 4.10 |
| 40 min | 3.40 | 0.90 | 3.366 | 40 min | 3.40 |
| 50 min | 2.80 | 0.90 | 2.772 | 50 min | 2.80 |
| 60 min | 2.60 | 0.90 | 2.574 | 60 min | 2.60 |
| 70 min | 2.40 | 0.90 | 2.376 | 70 min | 2.40 |
| 80 min | 2.30 | 0.90 | 2.277 | 80 min | 2.30 |
| 90 min | 2.10 | 0.90 | 2.079 | 90 min | 2.10 |
| 100 min | 1.90 | 0.90 | 1.881 | 100 min | 1.90 |
| 110 min | 1.80 | 0.90 | 1.782 | 110 min | 1.80 |
| Storage Calculations | | | | | |
| 10 min | | | CF | | |
| Inflow | 4,241 | Storage | 3,396 | | |
| Outflow | 845 | | | | |
| 15 min | | | | | |
| Inflow | 5,751 | Storage | 4,695 | | |
| Outflow | 1,056 | | | | |
| 20 min | | | | | |
| Inflow | 6,867 | Storage | 5,600 | | |
| Outflow | 1,267 | | | | |
| 30 min | | | | | |
| Inflow | 8,610 | Storage | 6,921 | | |
| Outflow | 1,690 | | | | |
| 40 min | | | | | |
| Inflow | 9,540 | Storage | 7,428 | | |
| Outflow | 2,112 | | | | |
| 50 min | | | | | |
| Inflow | 9,891 | Storage | 7,357 | | |
| Outflow | 2,534 | | | | |
| 60 min | | | | | |

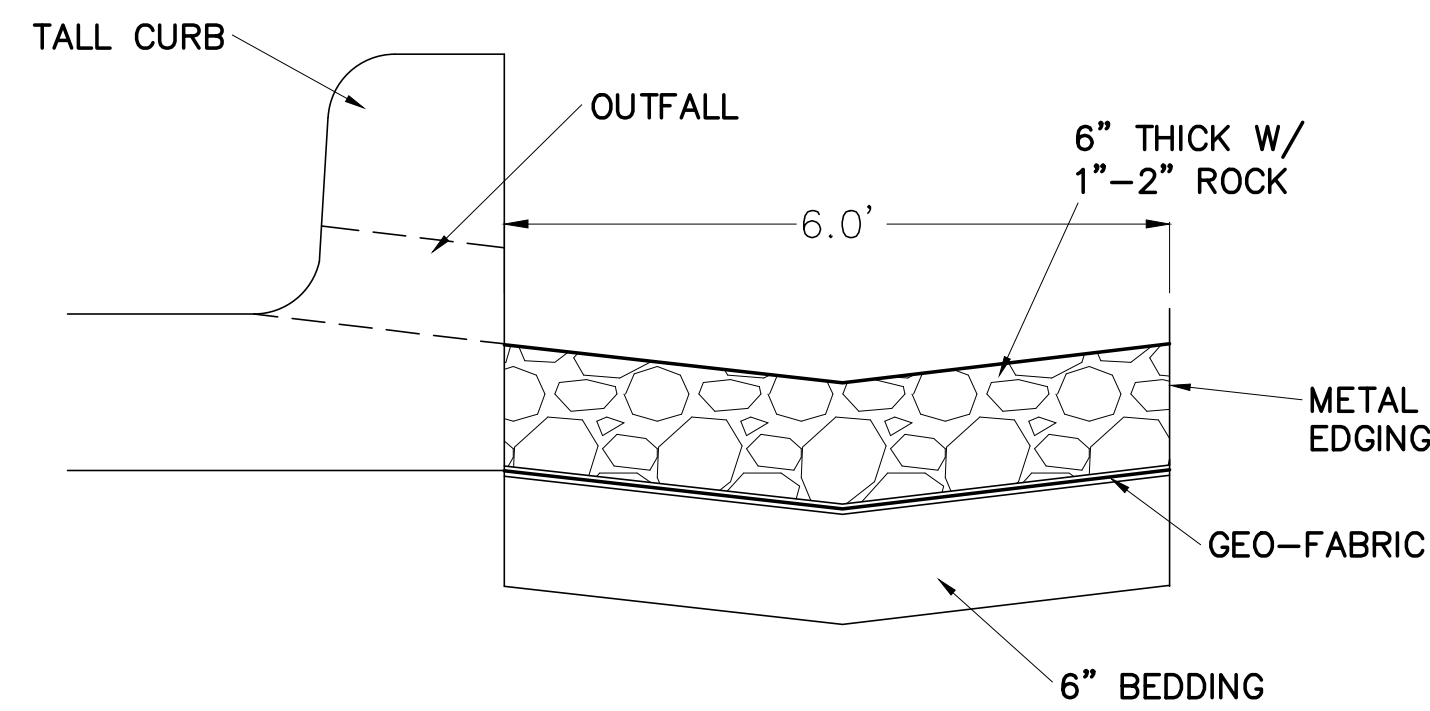

RIP RAP DETAIL
NOT TO SCALE

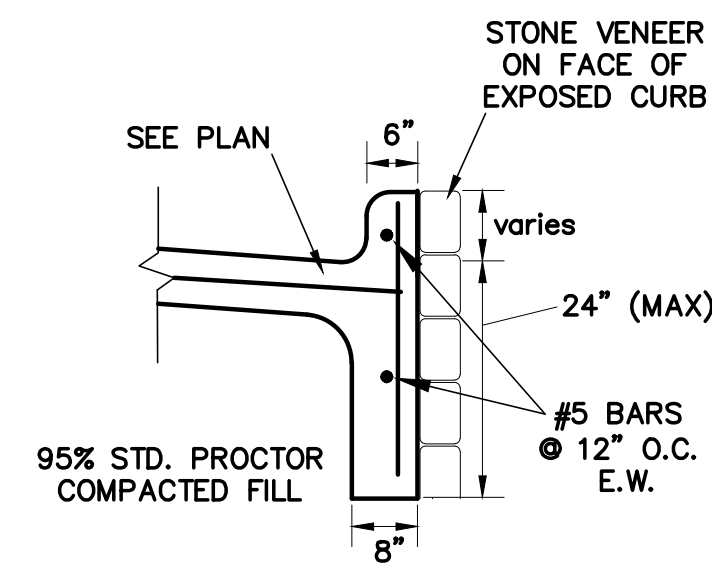


**SECTION B
STEM WALL**
NOT TO SCALE

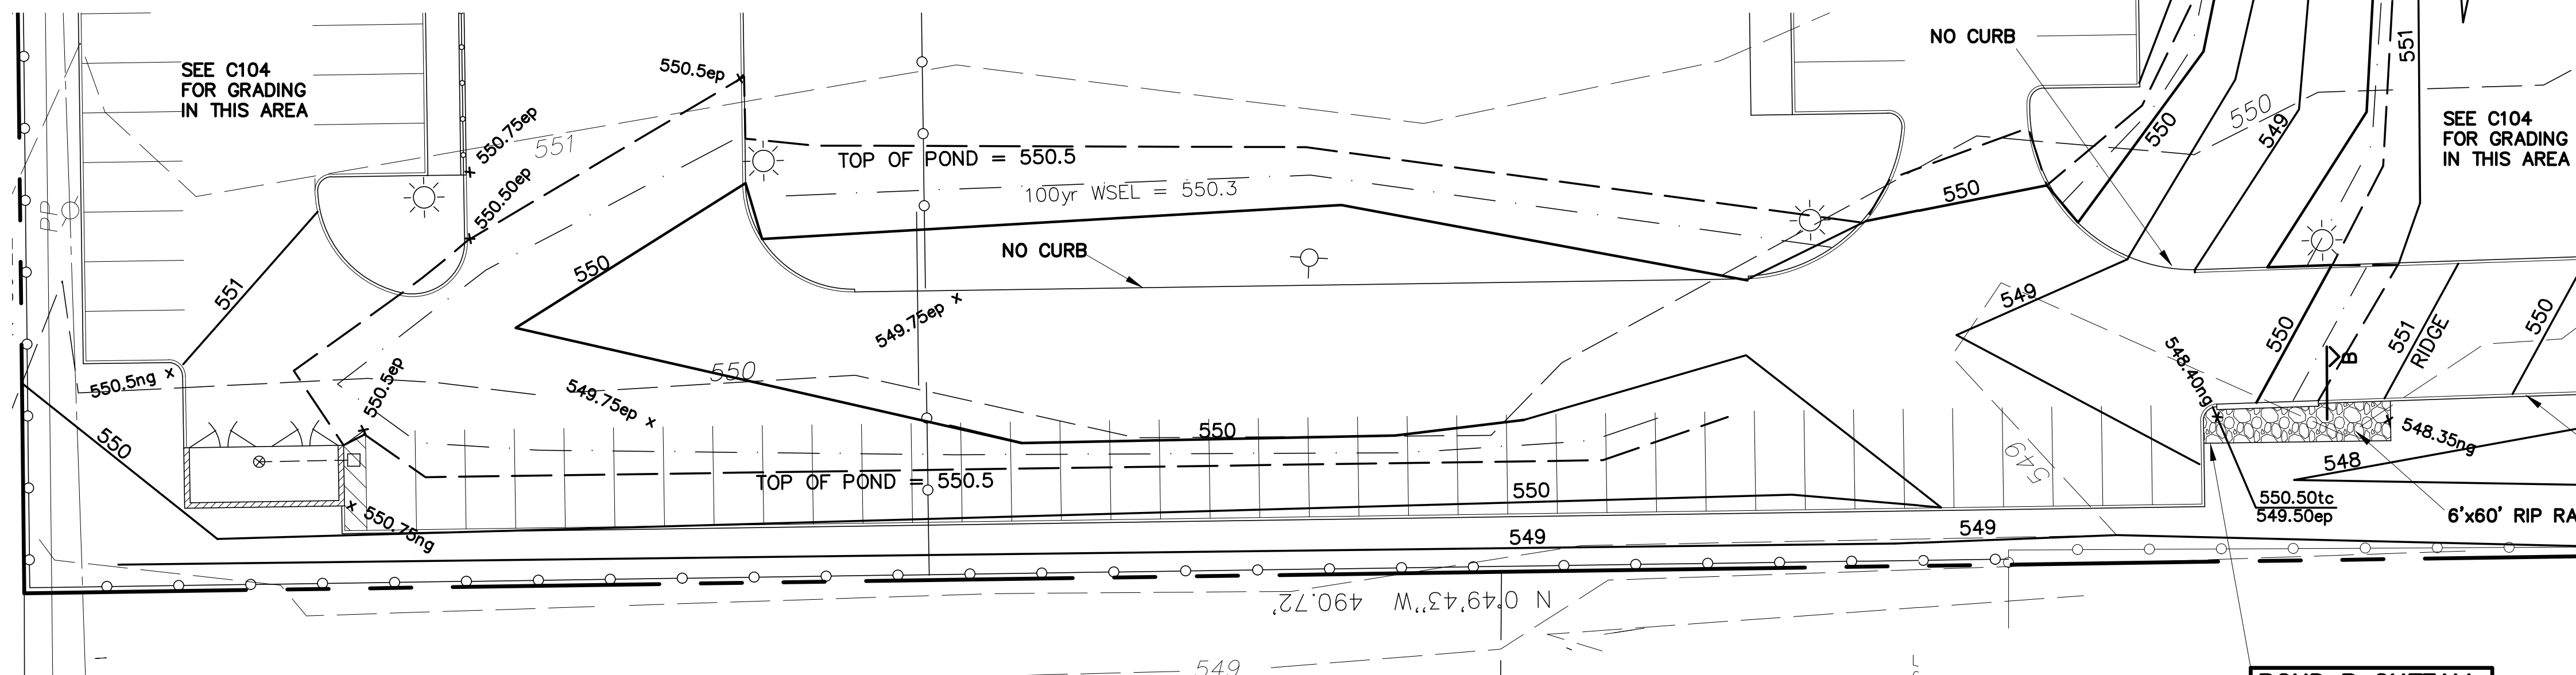


POND B


**POND B OUTFALL
CONSTRUCT 6' WIDE
OVERFLOW SPILLWAY
W/11" OPENING
TOP = 550.3
FL = 548.50
(SEE DETAIL)**

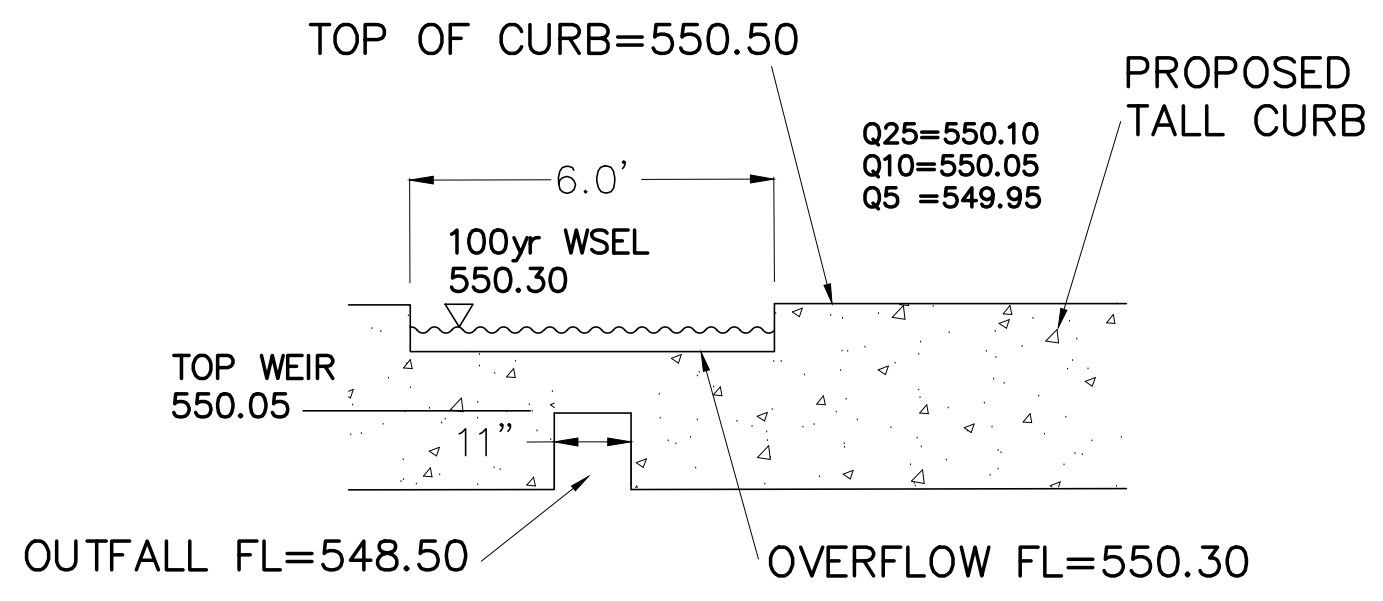

POND B OUTFALL DETAIL
NOT TO SCALE

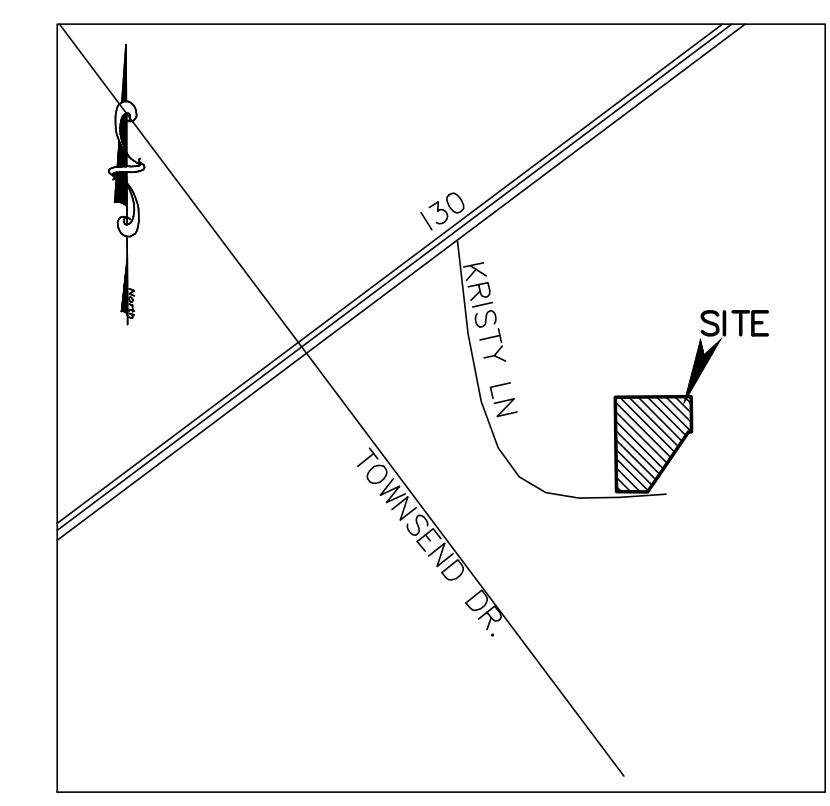

LOCATION MAP
(NOT TO SCALE)

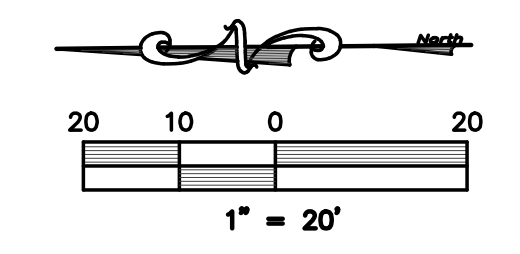

LEGEND

- = PROPERTY LINE
- - - - - = EXISTING CONTOURS
- — — — — = PROPOSED CONTOURS
- tc = TOP OF CURB
- ep = EDGE OF PAVEMENT
- tw = TOP OF WALL
- bw = BOTTOM OF WALL
- (ALL SPOT GRADES ARE EDGE OF PAVEMENT UNLESS OTHERWISE NOTED)
- EX. SS — = EXISTING SANITARY SEWER LINE
- EX. W — = EXISTING WATER LINE
- ⊕ FH = EXISTING FIRE HYDRANT
- ∞ WM = EXISTING WATER METER
- ⊕ PP = EXISTING POWER POLE
- ⊕ LP = EXISTING LIGHT POLE
- T = EX. WATER VALVE
- ⊙ = EXISTING SEWER MANHOLE
- ⊙ = EXISTING GAS METER
- ⊕ = PROPOSED FIRE HYDRANT

Pond Report

Hydraflow Hydrographs by Intellisolve v9.01 Thursday, Aug 27, 2020

Pond No. 2 - Pond B

Pond Data
Contours - User-defined contour areas. Average end area method used for volume calculation. Beginning Elevation = 548.50 ft

Stage / Storage Table

| Stage (ft) | Elevation (ft) | Contour area (sqft) | Incr. Storage (cuft) | Total storage (cuft) |
|------------|----------------|---------------------|----------------------|----------------------|
| 0.00 | 548.50 | 00 | 0 | 0 |
| 0.25 | 548.75 | 250 | 31 | 31 |
| 0.50 | 549.00 | 8,815 | 1,133 | 1,164 |
| 0.75 | 549.25 | 12,000 | 2,602 | 3,766 |
| 1.00 | 549.50 | 15,000 | 3,375 | 7,141 |
| 1.25 | 549.75 | 17,500 | 4,063 | 11,204 |
| 1.50 | 550.00 | 23,802 | 5,163 | 16,367 |
| 1.75 | 550.25 | 26,500 | 6,288 | 22,654 |
| 2.00 | 550.50 | 26,500 | 6,625 | 29,279 |

Culvert / Orifice Structures



| | [A] | [B] | [C] | [PrfRsr] |
|-----------------|----------|------|------|----------|
| Rise (in) | = 20.00 | 0.00 | 0.00 | Inactive |
| Span (in) | = 11.00 | 0.00 | 0.00 | 0.00 |
| No. Barrels | = 1 | 0 | 0 | 1 |
| Invert El. (ft) | = 548.50 | 0.00 | 0.00 | 0.00 |
| Length (ft) | = 0.50 | 0.00 | 0.00 | 0.00 |
| Slope (%) | = 0.25 | 0.00 | 0.00 | n/a |
| N-Value | = .013 | .013 | .013 | n/a |
| Orifice Coeff. | = 0.60 | 0.60 | 0.60 | 0.60 |
| Multi-Stage | = n/a | No | No | No |

Weir Structures

| | [A] | [B] | [C] | [D] |
|----------------|---------------------|------|------|------|
| Crest Len (ft) | = 6.00 | 0.00 | 0.00 | 0.00 |
| Crest El. (ft) | = 550.05 | 0.00 | 0.00 | 0.00 |
| Weir Coeff. | = 3.33 | 3.33 | 3.33 | 3.33 |
| Weir Type | = Rect | --- | --- | --- |
| Multi-Stage | = No | No | No | No |
| Exfil. (in/hr) | = 0.00 (by Contour) | --- | --- | --- |
| TW Elev. (ft) | = 0.00 | --- | --- | --- |

Stage / Storage / Discharge Table

| Stage ft | Storage cuft | Elevation ft | Civ A cfs | Civ B cfs | Civ C cfs | PrfRsr cfs | Wr A cfs | Wr B cfs | Wr C cfs | Wr D cfs | Exfil cfs | User cfs | Total cfs |
|----------|--------------|--------------|-----------|-----------|-----------|------------|----------|----------|----------|----------|-----------|----------|-----------|
| 0.00 | 0 | 548.50 | 0.00 | --- | --- | --- | 0.00 | --- | --- | --- | --- | --- | 0.00 |
| 0.25 | 31 | 548.75 | 0.05 | --- | --- | --- | 0.00 | --- | --- | --- | --- | --- | 0.05 |
| 0.50 | 1,164 | 549.00 | 0.10 | --- | --- | --- | 0.00 | --- | --- | --- | --- | --- | 0.10 |
| 0.75 | 3,766 | 549.25 | 0.16 | --- | --- | --- | 0.00 | --- | --- | --- | --- | --- | 0.16 |
| 1.00 | 7,141 | 549.50 | 0.21 | --- | --- | --- | 0.00 | --- | --- | --- | --- | --- | 0.21 |
| 1.25 | 11,204 | 549.75 | 0.26 | --- | --- | --- | 0.00 | --- | --- | --- | --- | --- | 0.26 |
| 1.50 | 16,367 | 550.00 | 0.31 | --- | --- | --- | 0.00 | --- | --- | --- | --- | --- | 0.31 |
| 1.75 | 22,654 | 550.25 | 2.90 | --- | --- | --- | 1.79 | --- | --- | --- | --- | --- | 4.69 |
| 2.00 | 29,279 | 550.50 | 5.77 | --- | --- | --- | 6.03 | --- | --- | --- | --- | --- | 11.80 |

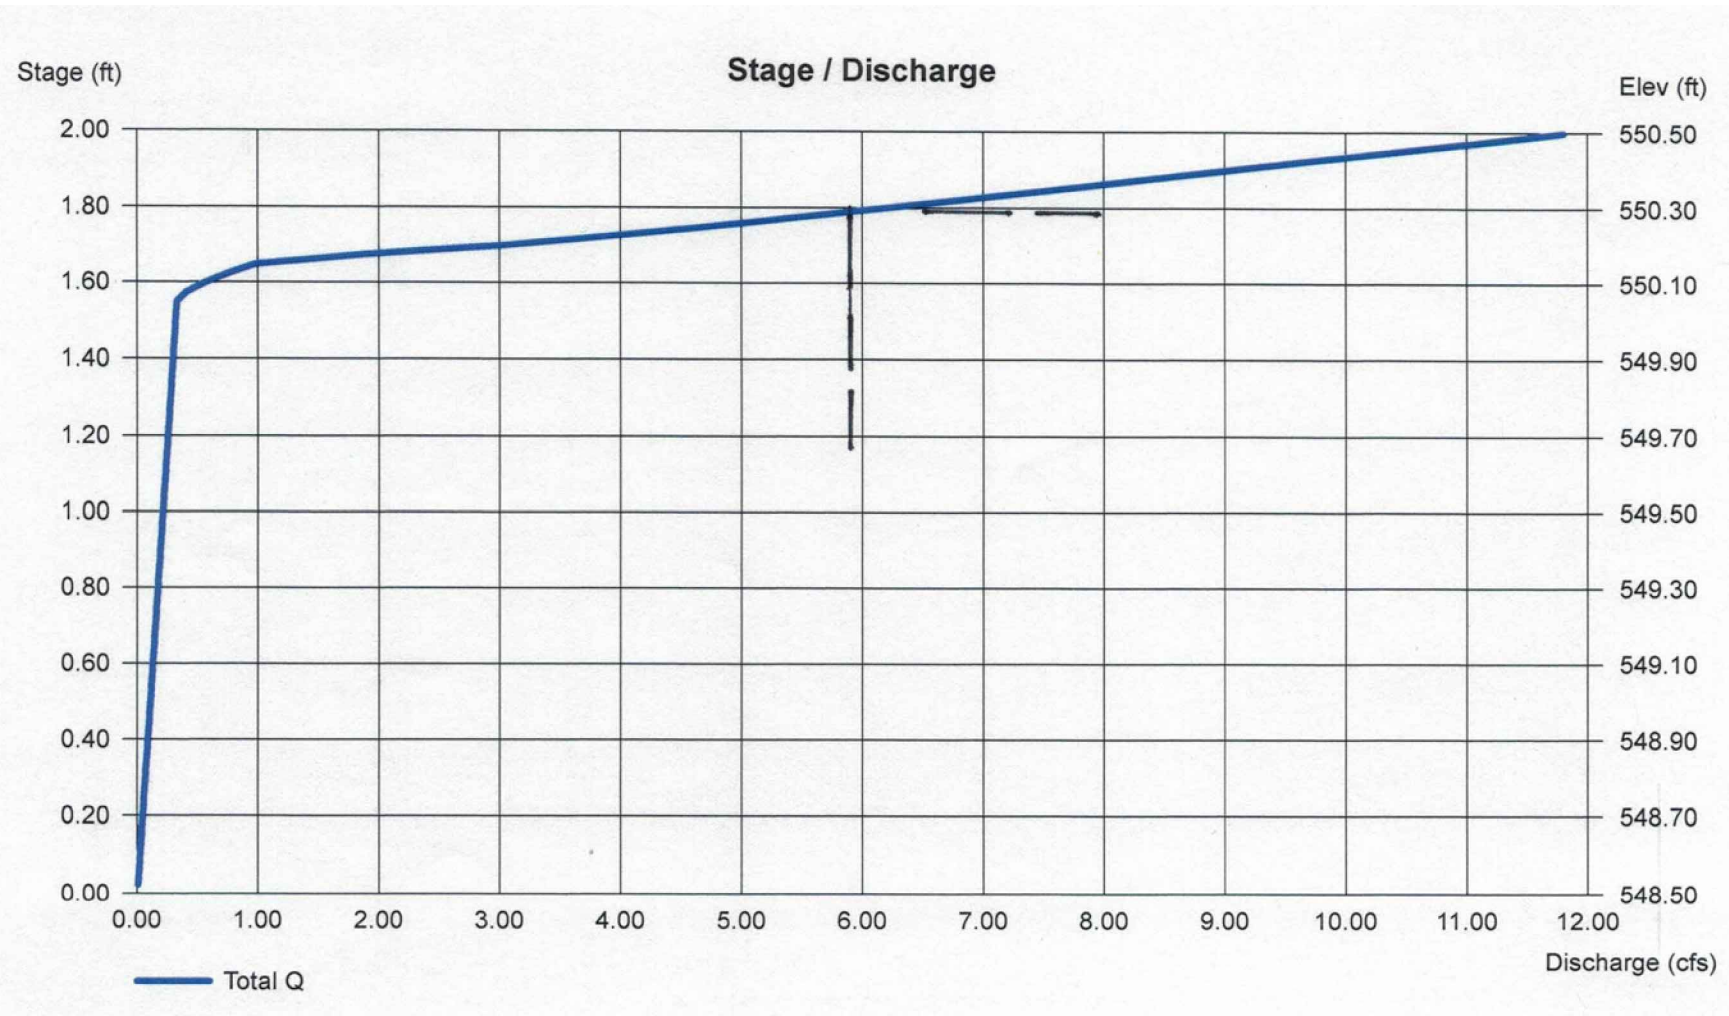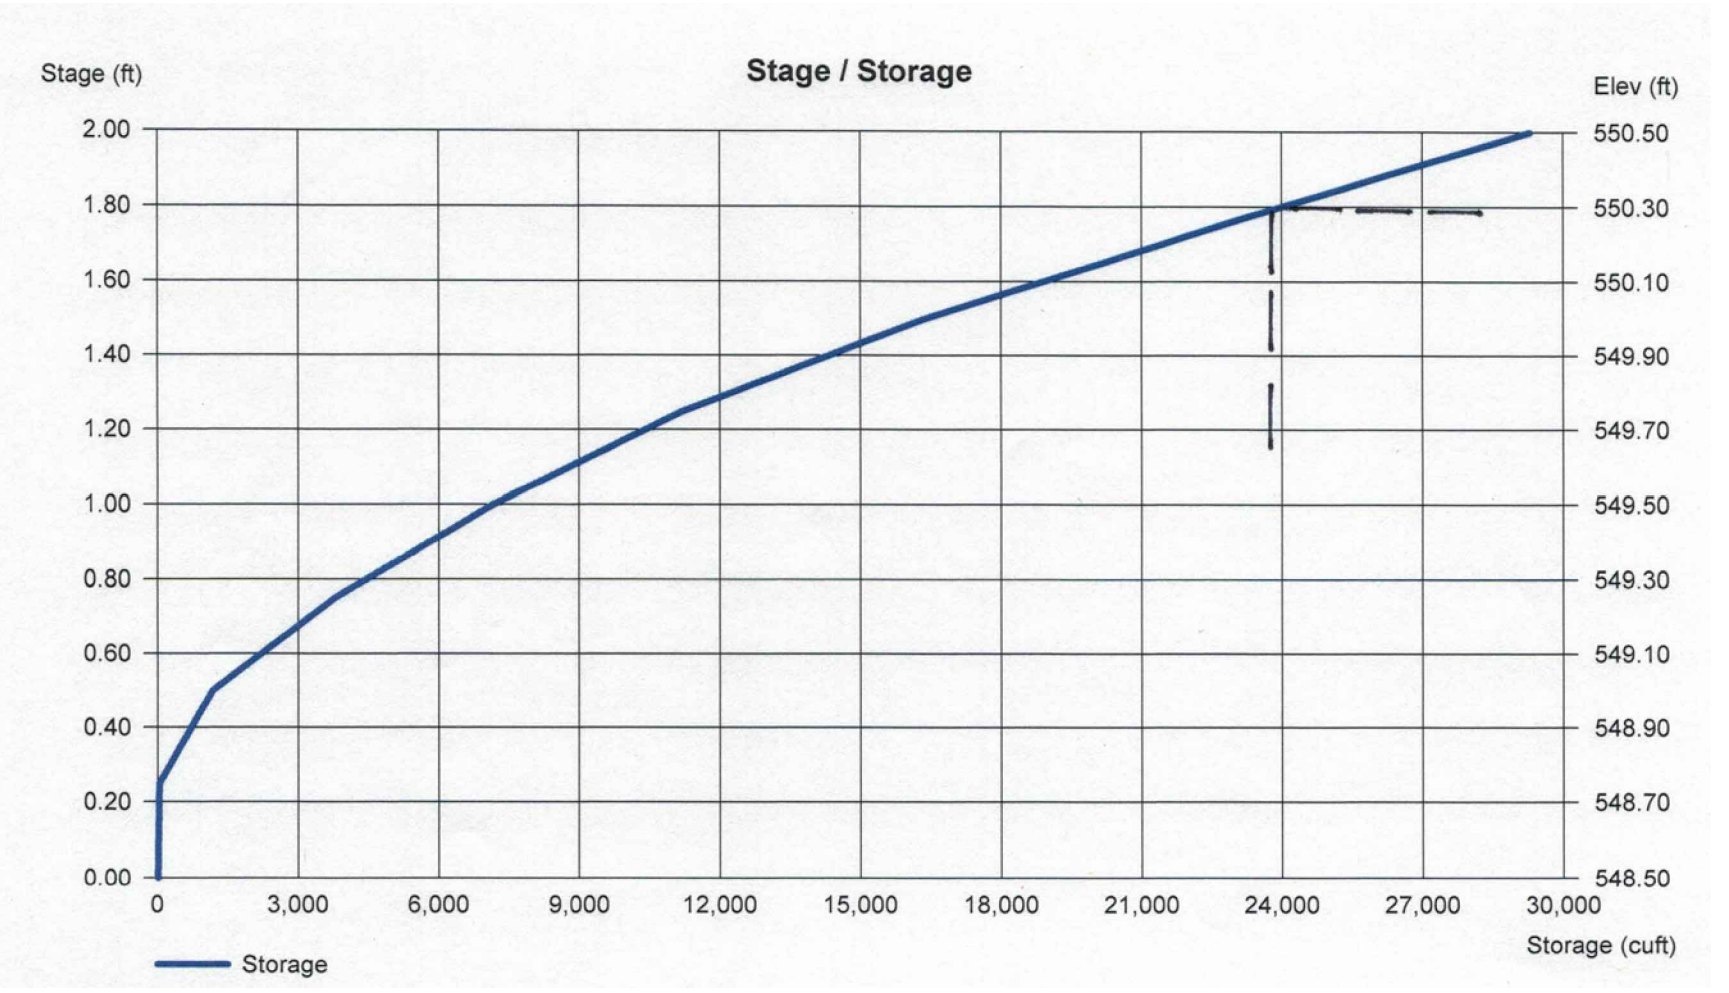

ONLY DRAWINGS STAMPED "RELEASED FOR CONSTRUCTION" BY THE CITY OF ROCKWALL TO BE USED FOR CONSTRUCTION.



CASE #: SP2019-047

**POND LAYOUT PLAN
POND B**

BACON PLUMBING OFFICE
2055 KRISTY LANE
LOT 1-M, BODIN INDUSTRIAL TRACT, 3.54 ACRES
City of Rockwall, Rockwall County, Texas
owner
BACON PROPERTY, LLC
295 RANCH TRAIL
ROCKWALL, TEXAS 75032
CONTACT: BRAD BACON (972)236-5794
prepared by

AS-BUILT
May 12, 2021
Gerald Monk
GERALD E. MONK, P.E.

TO THE BEST OF OUR KNOWLEDGE MONK CONSULTING ENGINEERS, INC HEREBY STATES THAT THIS PLAN IS AS-BUILT. THE INFORMATION PROVIDED IS BASED ON SURVEYING AT THE SITE AND INFORMATION PROVIDED BY THE CONTRACTOR.


BENCHMARK:
PK NAIL IN CONCRETE.
NORTHING=7,021,752.890
EASTING=2,601,063.913
ELEVATION = 549.01'

MONK CONSULTING ENGINEERS, INC.
1200 W. State Street, Garland Texas 75040
972 272-1763 Fax 972 272-8761
REG NO.: F-2567
©2020 by Monk Consulting Engineers, Inc., All Rights Reserved.
date: 8/31/20 scale: 1" = 20' sheet: C106

| Overall Detention Pond Modified Rational | | | | POND B | | | |
|--|--------|-----------------|-------------|---|--------|------|---------|
| Present Conditions | | | | Area 3 | | | |
| Q=CIA | | By-Pass Acreage | New Acreage | | | | |
| A= | 2.510 | 0.240 | 2.27 | | | | |
| C= | 0.35 | | | | | | |
| Tc= | 20.00 | | | | | | |
| I100= | 8.30 | | | | | | |
| Q100= | 7.29 | | | | | | |
| Future Conditions | | | | Offsite Condition | | | |
| A= | 2.51 | 0.260 | 0.24 | Q Allow | | | |
| A (adj) | 2.27 | | | | | | |
| C= | 0.90 | 0.350 | 0.90 | | | | |
| Tc | 10.00 | 20 | 10.00 | | | | |
| I100= | 9.80 | 8.30 | 9.80 | | | | |
| Q100= | 22.14 | 0.755 | 2.12 | 5.93 | | | |
| Flow for Storm Duration | | | | Flow for Storm Durations (Offsite) | | | |
| Time | I | C | Q (cfs) | Time | I | C | Q (cfs) |
| 10 min | 9.80 | 0.90 | 20.021 | 10 min | 9.80 | 0.35 | 0.892 |
| 15 min | 9.00 | 0.90 | 18.387 | 15 min | 9.00 | 0.35 | 0.819 |
| 20 min | 8.30 | 0.90 | 16.957 | 20 min | 8.30 | 0.35 | 0.755 |
| 30 min | 6.90 | 0.90 | 14.097 | 30 min | 6.90 | 0.35 | 0.628 |
| 40 min | 5.80 | 0.90 | 11.849 | 40 min | 5.80 | 0.35 | 0.528 |
| 50 min | 5.00 | 0.90 | 10.215 | 50 min | 5.00 | 0.35 | 0.455 |
| 60 min | 4.50 | 0.90 | 9.194 | 60 min | 4.50 | 0.35 | 0.410 |
| 70 min | 4.00 | 0.90 | 8.172 | 70 min | 4.00 | 0.35 | 0.364 |
| 80 min | 3.70 | 0.90 | 7.559 | 80 min | 3.70 | 0.35 | 0.337 |
| 90 min | 3.50 | 0.90 | 7.151 | 90 min | 3.50 | 0.35 | 0.319 |
| 100 min | 3.40 | 0.90 | 6.946 | 100 min | 3.40 | 0.35 | 0.309 |
| 110 min | 3.20 | 0.90 | 6.538 | 110 min | 3.20 | 0.35 | 0.291 |
| Storage Calculations | | | | Storage Calculations | | | |
| 10 min | | | CF | 10 min | | | CF |
| Inflow | 12,548 | | 8,990 | Inflow | 10,627 | | 8,123 |
| Outflow | 3,558 | | | Outflow | 2,504 | | |
| 15 min | | | Storage | 15 min | | | Storage |
| Inflow | 17,285 | | 12,838 | Inflow | 14,405 | | 11,275 |
| Outflow | 4,448 | | | Outflow | 3,130 | | |
| 20 min | | | Storage | 20 min | | | Storage |
| Inflow | 21,255 | | 15,918 | Inflow | 16,901 | | 13,146 |
| Outflow | 5,337 | | | Outflow | 3,756 | | |
| 30 min | | | Storage | 30 min | | | Storage |
| Inflow | 26,504 | | 19,388 | Inflow | 21,127 | | 16,119 |
| Outflow | 7,116 | | | Outflow | 5,008 | | |
| 40 min | | | Storage | 40 min | | | Storage |
| Inflow | 29,705 | | 20,810 | Inflow | 23,559 | | 17,300 |
| Outflow | 8,895 | | | Outflow | 6,260 | | |
| 50 min | | | Storage | 50 min | | | Storage |
| Inflow | 32,010 | | 21,336 | Inflow | 25,608 | | 18,097 |
| Outflow | 10,674 | | | Outflow | 7,511 | | |
| 60 min | | | Storage | 60 min | | | Storage |
| Inflow | 34,571 | | 22,118 | Inflow | 26,888 | | 18,125 |
| Outflow | 12,453 | | | Outflow | 8,763 | | |
| 70 min | | | Storage | 70 min | | | Storage |
| Inflow | 35,851 | | 21,619 | Inflow | 29,577 | | 19,562 |
| Outflow | 14,232 | | | Outflow | 10,015 | | |
| 80 min | | | Storage | 80 min | | | Storage |
| Inflow | 37,900 | | 21,889 | Inflow | 31,754 | | 20,487 |
| Outflow | 16,011 | | | Outflow | 11,267 | | |
| 90 min | | | Storage | 90 min | | | Storage |
| Inflow | 40,333 | | 22,542 | Inflow | 33,418 | | 20,899 |
| Outflow | 17,790 | | | Outflow | 12,519 | | |
| 100 min | | | Storage | 100 min | | | Storage |
| Inflow | 43,534 | | 23,964 | Inflow | 34,571 | | 20,800 |
| Outflow | 19,569 | | | Outflow | 13,771 | | |
| 110 min | | | Storage | 110 min | | | Storage |
| Inflow | 40,973 | | 19,625 | Inflow | 32,010 | | 16,987 |
| Outflow | 21,348 | | | Outflow | 15,023 | | |

| Overall Detention Pond Modified Rational | | | | POND B | | | |
|--|--------|-----------------|-------------|---|--------|------|---------|
| Present Conditions | | | | By-Pass Acreage | | | |
| Q=CIA | | By-Pass Acreage | New Acreage | | | | |
| A= | 2.510 | 0.240 | 2.27 | | | | |
| C= | 0.35 | | | | | | |
| Tc= | 20.00 | | | | | | |
| I100= | 8.30 | | | | | | |
| Q100= | 5.53 | | | | | | |
| Future Conditions | | | | Offsite Condition | | | |
| A= | 2.51 | 0.260 | 0.24 | Q Allow | | | |
| A (adj) | 2.27 | | | | | | |
| C= | 0.90 | 0.350 | 0.90 | | | | |
| Tc | 10.00 | 20 | 10.00 | | | | |
| I100= | 9.80 | 8.30 | 9.80 | | | | |
| Q100= | 18.75 | 0.755 | 2.12 | 4.17 | | | |
| Flow for Storm Duration | | | | Flow for Storm Durations (Offsite) | | | |
| Time | I | C | Q (cfs) | Time | I | C | Q (cfs) |
| 10 min | 8.30 | 0.90 | 16.957 | 10 min | 8.30 | 0.35 | 0.755 |
| 15 min | 7.50 | 0.90 | 15.323 | 15 min | 7.50 | 0.35 | 0.683 |
| 20 min | 6.60 | 0.90 | 13.484 | 20 min | 6.60 | 0.35 | 0.601 |
| 30 min | 5.50 | 0.90 | 11.237 | 30 min | 5.50 | 0.35 | 0.501 |
| 40 min | 4.60 | 0.90 | 9.398 | 40 min | 4.60 | 0.35 | 0.419 |
| 50 min | 4.00 | 0.90 | 8.172 | 50 min | 4.00 | 0.35 | 0.364 |
| 60 min | 3.50 | 0.90 | 7.151 | 60 min | 3.50 | 0.35 | 0.319 |
| 70 min | 3.30 | 0.90 | 6.742 | 70 min | 3.30 | 0.35 | 0.300 |
| 80 min | 3.10 | 0.90 | 6.333 | 80 min | 3.10 | 0.35 | 0.282 |
| 90 min | 2.90 | 0.90 | 5.925 | 90 min | 2.90 | 0.35 | 0.264 |
| 100 min | 2.70 | 0.90 | 5.516 | 100 min | 2.70 | 0.35 | 0.246 |
| 110 min | 2.50 | 0.90 | 5.108 | 110 min | 2.50 | 0.35 | 0.228 |
| Storage Calculations | | | | Storage Calculations | | | |
| 10 min | | | CF | 10 min | | | CF |
| Inflow | 10,627 | | 8,123 | Inflow | 9,091 | | 6,798 |
| Outflow | 2,504 | | | Outflow | 2,293 | | |
| 15 min | | | Storage | 15 min | | | Storage |
| Inflow | 14,405 | | 11,275 | Inflow | 12,484 | | 9,618 |
| Outflow | 3,130 | | | Outflow | 2,866 | | |
| 20 min | | | Storage | 20 min | | | Storage |
| Inflow | 16,901 | | 13,146 | Inflow | 15,109 | | 11,669 |
| Outflow | 3,756 | | | Outflow | 3,439 | | |
| 30 min | | | Storage | 30 min | | | Storage |
| Inflow | 21,127 | | 16,119 | Inflow | 18,438 | | 13,852 |
| Outflow | 5,008 | | | Outflow | 4,586 | | |
| 40 min | | | Storage | 40 min | | | Storage |
| Inflow | 23,559 | | 17,300 | Inflow | 20,486 | | 14,754 |
| Outflow | 6,260 | | | Outflow | 5,732 | | |
| 50 min | | | Storage | 50 min | | | Storage |
| Inflow | 25,608 | | 18,097 | Inflow | 22,407 | | 15,528 |
| Outflow | 7,511 | | | Outflow | 6,879 | | |
| 60 min | | | Storage | 60 min | | | Storage |
| Inflow | 26,888 | | 18,125 | Inflow | 23,047 | | 15,022 |
| Outflow | 8,763 | | | Outflow | 8,025 | | |
| 70 min | | | Storage | 70 min | | | Storage |
| Inflow | 29,577 | | 19,562 | Inflow | 25,096 | | 15,924 |
| Outflow | 10,015 | | | Outflow | 9,172 | | |
| 80 min | | | Storage | 80 min | | | Storage |
| Inflow | 31,754 | | 20,487 | Inflow | 26,632 | | 16,314 |
| Outflow | 11,267 | | | Outflow | 10,318 | | |
| 90 min | | | Storage | 90 min | | | Storage |
| Inflow | 33,418 | | 20,899 | Inflow | 28,809 | | 17,344 |
| Outflow | 12,519 | | | Outflow | 11,465 | | |
| 100 min | | | Storage | 100 min | | | Storage |
| Inflow | 34,571 | | 20,800 | Inflow | 30,730 | | 18,118 |
| Outflow | 13,771 | | | Outflow | 12,611 | | |
| 110 min | | | Storage | 110 min | | | Storage |
| Inflow | 32,010 | | 16,987 | Inflow | 29,449 | | 15,691 |
| Outflow | 15,023 | | | Outflow | 13,758 | | |




| Overall Detention Pond Modified Rational | | | | POND A | | | |
|--|--------|-----------------|-------------|---|--------|------|---------|
| Present Conditions | | | | By-Pass Acreage | | | |
| Q=CIA | | By-Pass Acreage | New Acreage | | | | |
| A= | 2.510 | 0.240 | 2.27 | | | | |
| C= | 0.35 | | | | | | |
| Tc= | 20.00 | | | | | | |
| I100= | 8.30 | | | | | | |
| Q100= | 5.18 | | | | | | |
| Future Conditions | | | | Offsite Condition | | | |
| A= | 2.51 | 0.260 | 0.24 | Q Allow | | | |
| A (adj) | 2.27 | | | | | | |
| C= | 0.90 | 0.350 | 0.90 | | | | |
| Tc | 10.00 | 20 | 10.00 | | | | |
| I100= | 9.80 | 8.30 | 9.80 | | | | |
| Q100= | 16.04 | 0.755 | 2.12 | 3.82 | | | |
| Flow for Storm Duration | | | | Flow for Storm Durations (Offsite) | | | |
| Time | I | C | Q (cfs) | Time | I | C | Q (cfs) |
| 10 min | 7.10 | 0.90 | 14.505 | 10 min | 7.10 | 0.35 | 0.646 |
| 15 min | 6.50 | 0.90 | 13.280 | 15 min | 6.50 | 0.35 | 0.592 |
| 20 min | 5.90 | 0.90 | 12.054 | 20 min | 5.90 | 0.35 | 0.537 |
| 30 min | 4.80 | 0.90 | 9.806 | 30 min | 4.80 | 0.35 | 0.437 |
| 40 min | 4.00 | 0.90 | 8.172 | 40 min | 4.00 | 0.35 | 0.364 |
| 50 min | 3.50 | 0.90 | 7.151 | 50 min | 3.50 | 0.35 | 0.319 |
| 60 min | 3.00 | 0.90 | 6.129 | 60 min | 3.00 | 0.35 | 0.273 |
| 70 min | 2.80 | 0.90 | 5.720 | 70 min | 2.80 | 0.35 | 0.255 |
| 80 min | 2.60 | 0.90 | 5.312 | 80 min | 2.60 | 0.35 | 0.237 |
| 90 min | 2.50 | 0.90 | 5.108 | 90 min | 2.50 | 0.35 | 0.228 |
| 100 min | 2.40 | 0.90 | 4.903 | 100 min | 2.40 | 0.35 | 0.218 |
| 110 min | 2.30 | 0.90 | 4.699 | 110 min | 2.30 | 0.35 | 0.209 |
| Storage Calculations | | | | Storage Calculations | | | |
| 10 min | | | CF | 10 min | | | CF |
| Inflow | 9,091 | | 6,798 | Inflow | 8,012 | | 6,247 |
| Outflow | 2,293 | | | Outflow | 1,766 | | |
| 15 min | | | Storage | 15 min | | | Storage |
| Inflow | 12,484 | | 9,618 | Inflow | 10,850 | | 8,643 |
| Outflow | 2,866 | | | Outflow | 2,207 | | |
| 20 min | | | Storage | 20 min | | | Storage |
| Inflow | 15,109 | | 11,669 | Inflow | 12,919 | | 10,270 |
| Outflow | 3,439 | | | Outflow | 2,649 | | |
| 30 min | | | Storage | 30 min | | | Storage |
| Inflow | 18,438 | | 13,852 | Inflow | 16,208 | | 12,676 |
| Outflow | 4,586 | | | Outflow | 3,532 | | |
| 40 min | | | Storage | 40 min | | | Storage |
| Inflow | 20,486 | | 14,754 | Inflow | 17,938 | | 13,523 |
| Outflow | 5,732 | | | Outflow | 4,415 | | |
| 50 min | | | Storage | 50 min | | | Storage |
| Inflow | 22,407 | | 15,528 | Inflow | 18,526 | | 13,229 |
| Outflow | 6,879 | | | Outflow | 5,298 | | |
| 60 min | | | Storage | 60 min | | | Storage |
| Inflow | 23,047 | | 15,022 | Inflow | 20,597 | | 14,416 |
| Outflow | 8,025 | | | Outflow | 6,181 | | |
| 70 min | | | Storage | 70 min | | | Storage |
| Inflow | 25,096 | | 15,924 | Inflow | 22,122 | | 15,059 |
| Outflow | 9,172 | | | | | | |

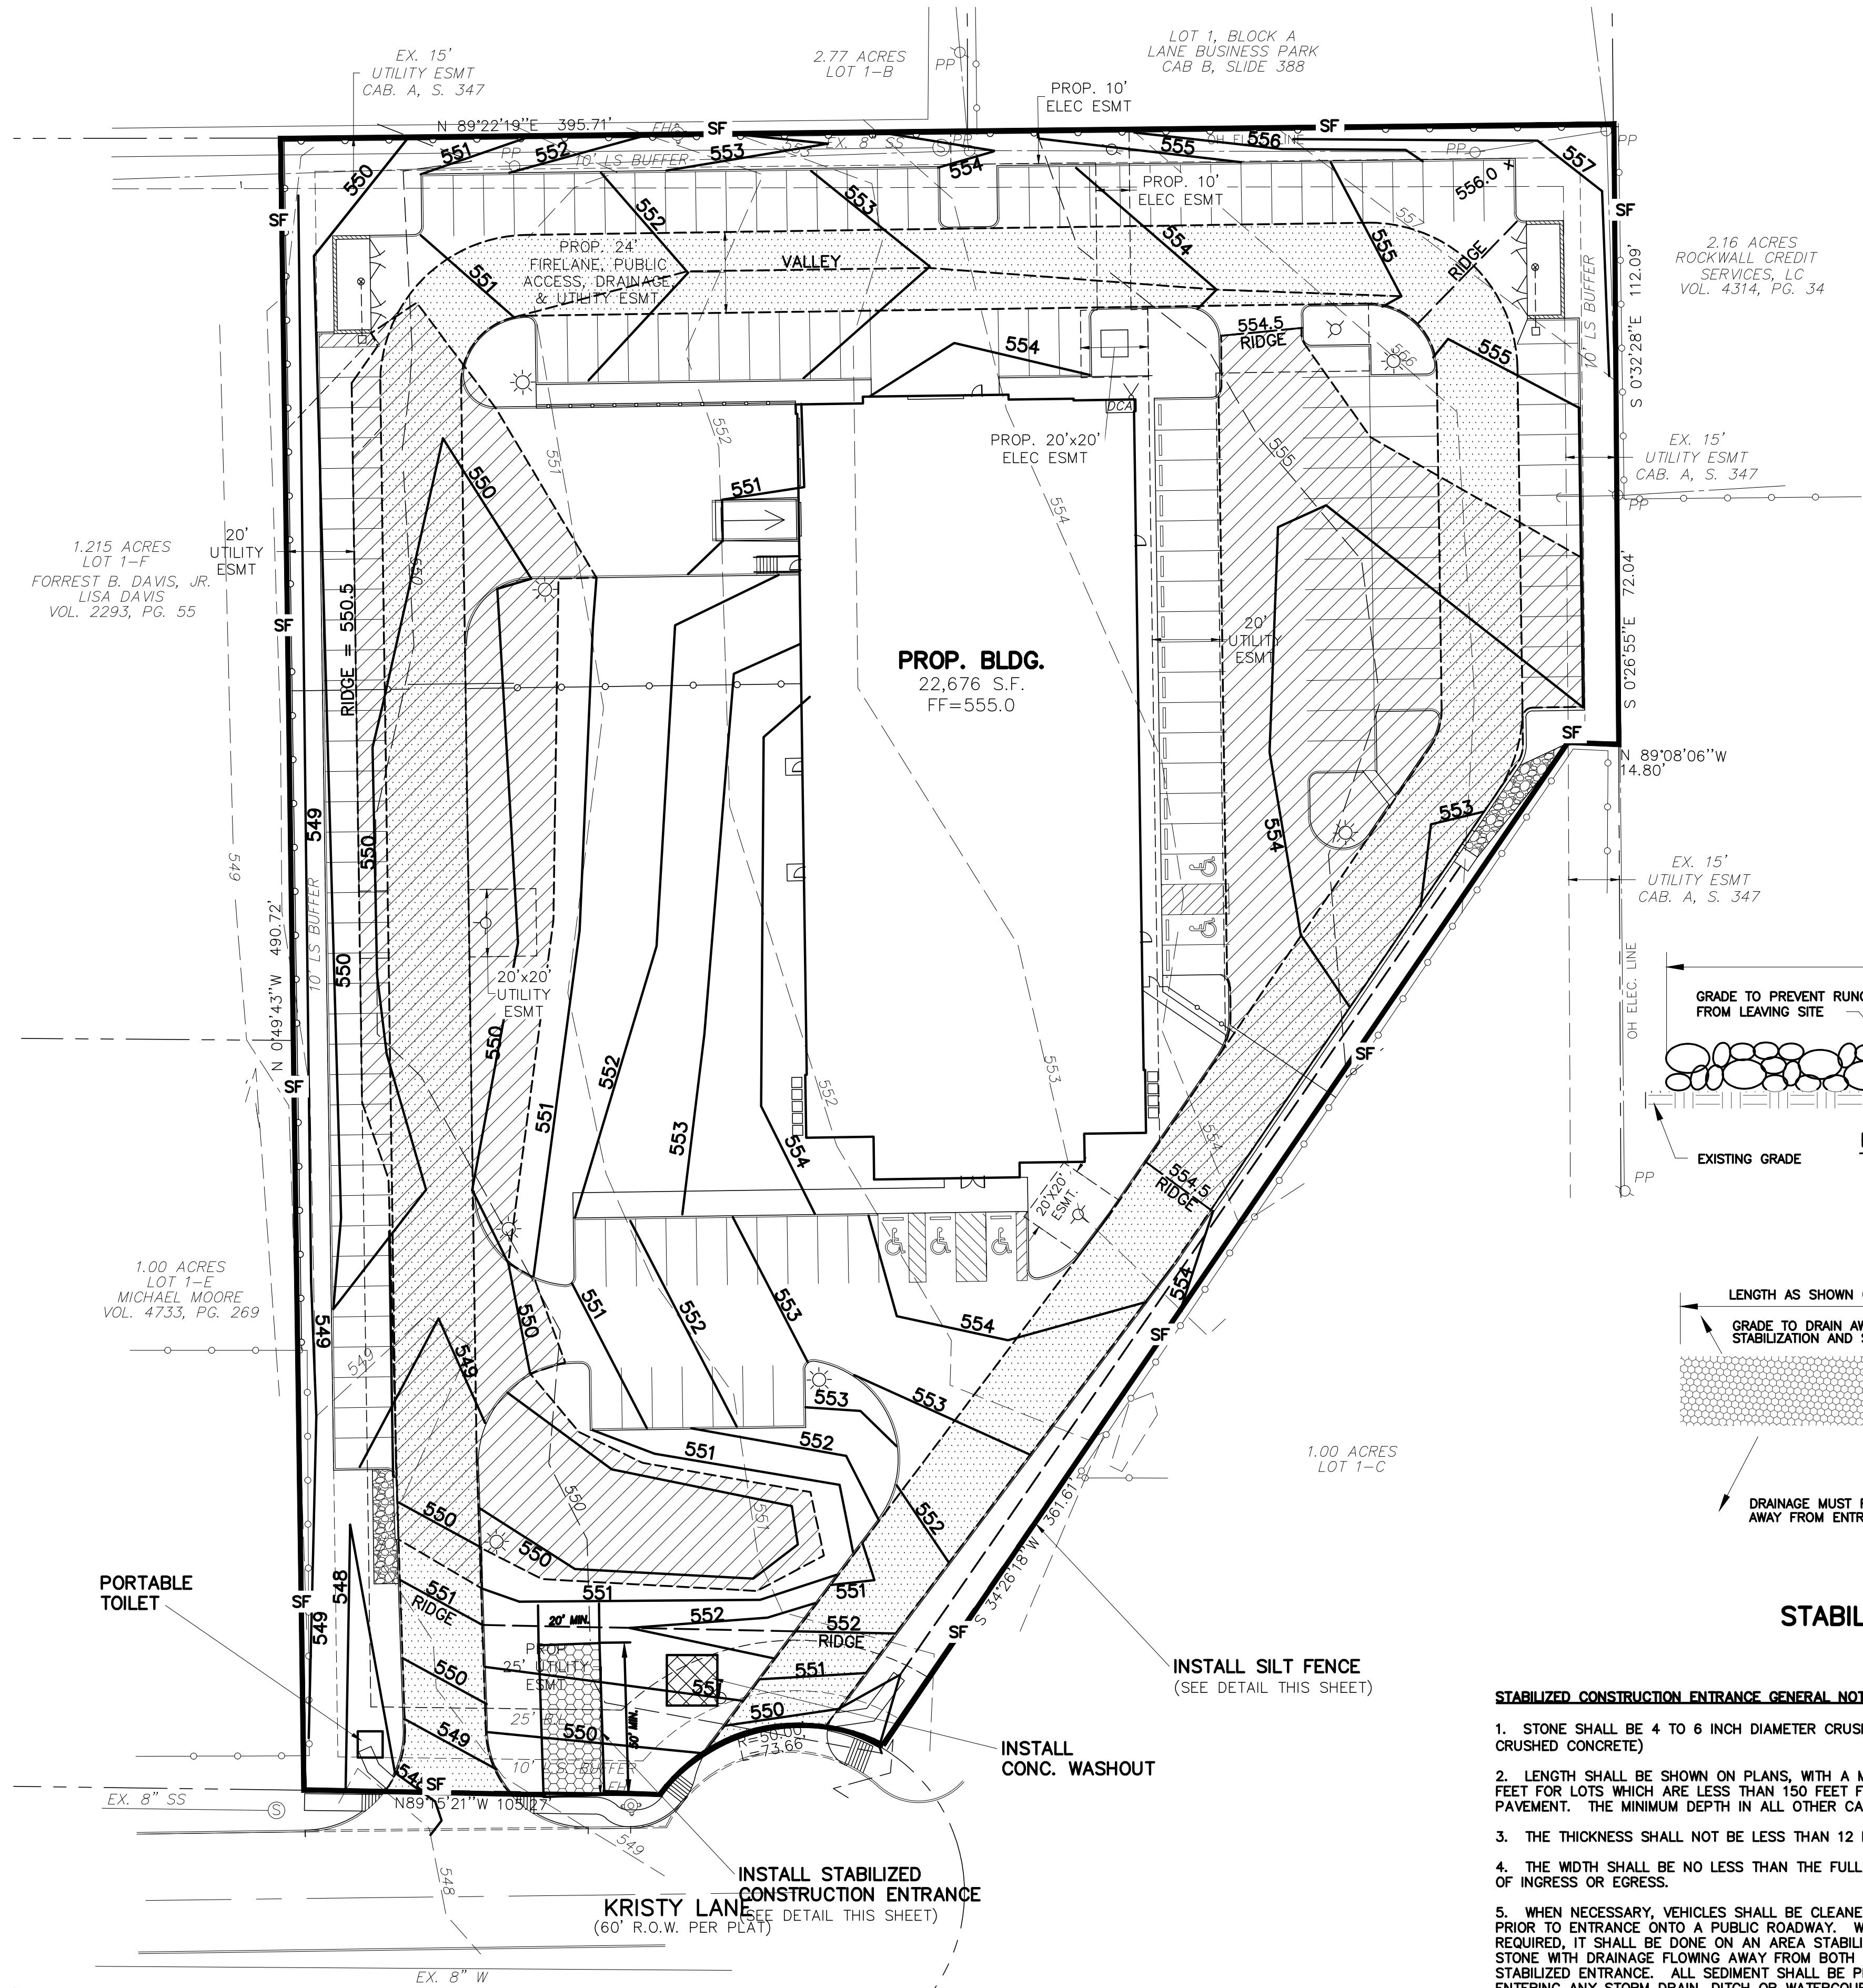

**** NOTICE TO CONTRACTORS ****
 TOPOGRAPHIC INFORMATION TAKEN FROM A TOPOGRAPHIC SURVEY PERFORMED BY H.D. FETTY OF ROYSE CITY, TEXAS. THE CONTRACTOR SHALL NOTIFY THE ENGINEER IMMEDIATELY, IN WRITING, OF ANY DISCREPANCIES OR OMISSIONS TO THE TOPOGRAPHIC INFORMATION. THE CONTRACTOR(S) SHALL BE RESPONSIBLE FOR CONFIRMING THE LOCATION (HORIZONTAL/VERTICAL) OF ANY BURIED CABLES, CONDUITS, PIPES, AND STRUCTURES (STORM SEWER, SANITARY SEWER, WATER, GAS, TELEVISION, TELEPHONE, ETC.) WHICH IMPACT THE CONSTRUCTION SITE. THE CONTRACTOR(S) SHALL NOTIFY THE OWNER AND ENGINEER IF ANY DISCREPANCIES ARE FOUND BETWEEN THE ACTUAL CONDITIONS VERSUS THE DATA CONTAINED IN THE CONSTRUCTION PLANS. ANY COSTS INCURRED AS THE RESULT OF NOT CONFIRMING THE ACTUAL LOCATION (HORIZONTAL/VERTICAL) OF SAID CABLES, CONDUITS, PIPES, AND STRUCTURES SHALL BE BORNE BY THE CONTRACTOR. ADDITIONALLY, THE CONTRACTOR(S) SHALL NOTIFY THE OWNER AND ENGINEER IF ANY ERRORS OR DISCREPANCIES ARE FOUND ON THE CONSTRUCTION DOCUMENTS (P&E), WHICH NEGATIVELY IMPACT THE PROJECT. ENGINEER AND OWNER SHALL BE INDEMNIFIED OF PROBLEMS AND/OR COST WHICH MAY RESULT FROM CONTRACTOR'S FAILURE TO NOTIFY ENGINEER AND OWNER.

- NOTES:**
- 1) ALL WORK MUST CONFORM TO CITY OF ROCKWALL & NCTCOG STANDARDS AND DETAILS 5th EDITION.
 - 2) ALL WORK IN PUBLIC RIGHT-OF-WAY SHALL CONFORM TO CITY OF ROCKWALL STANDARDS AND DETAILS.
 - 3) SEE PLAT FOR ALL INFORMATION REGARDING EASEMENTS, PROPERTY LINES, ETC.
 - 4) ALL SPOT GRADE ARE EDGE OF PAVEMENT UNLESS OTHERWISE NOTED.
 - 5) ALL CURB INLETS MUST BE PROTECTED TO PREVENT SEDIMENT FROM ENTERING STORM SYSTEM.
 - 6) ALL EROSION CONTROL MEASURES MUST BE INSTALLED PRIOR TO THE START OF ANY CONSTRUCTION.
 - 7) THERE ARE NO ONSITE OR ADJACENT SURFACE WATERS OR WETLANDS.
 - 8) 75-80% OF ALL DISTURBED AREA TO HAVE A MIN. 1" TALL GRASS ESTABLISHED PRIOR TO ENGINEERING ACCEPTANCE.
 - 9) ALL CITY R.O.W. MUST BE SODDED IF DISTURBED.

- GENERAL NOTES:**
- 1) ALL EROSION CONTROL MEASURES MUST BE INSTALLED PRIOR TO THE START OF ANY CONSTRUCTION.
 - 2) THE BOTTOM & SIDES OF DETENTION POND SHALL BE SODDED OR SEEDING MATTING ANCHORED BEFORE PAVING CAN BEGIN.
 - 3) 75-80% OF ALL DISTURBED AREAS SHALL BE ESTABLISHED W/MIN. OF 1" HIGH GRASS PRIOR TO CITY ACCEPTANCE.

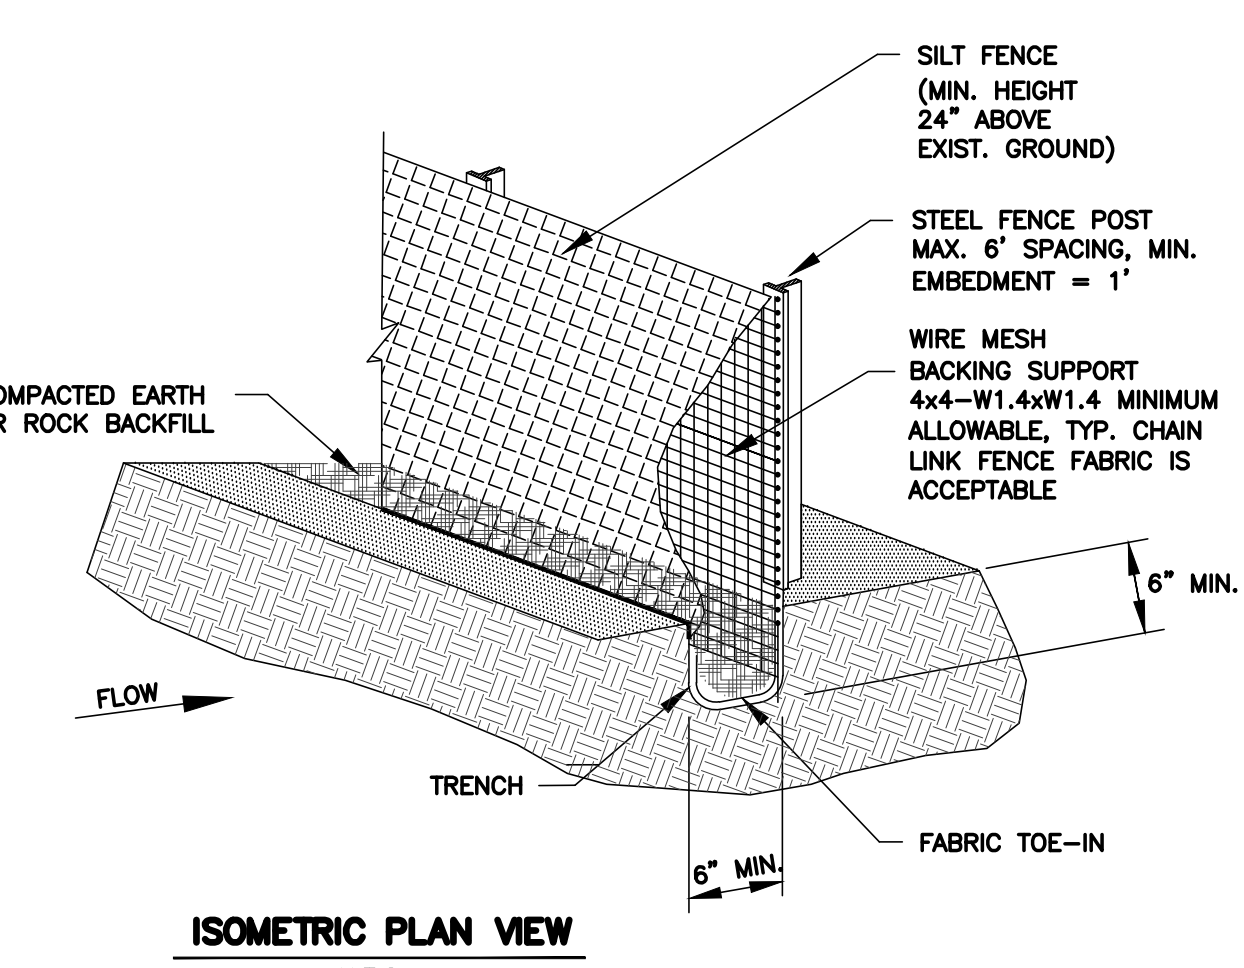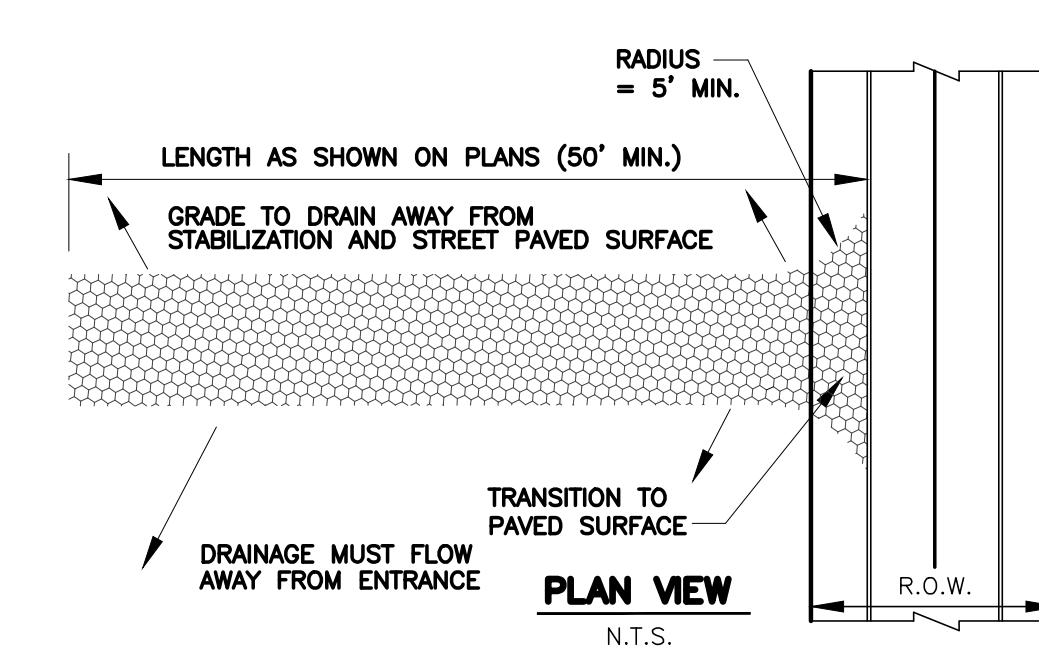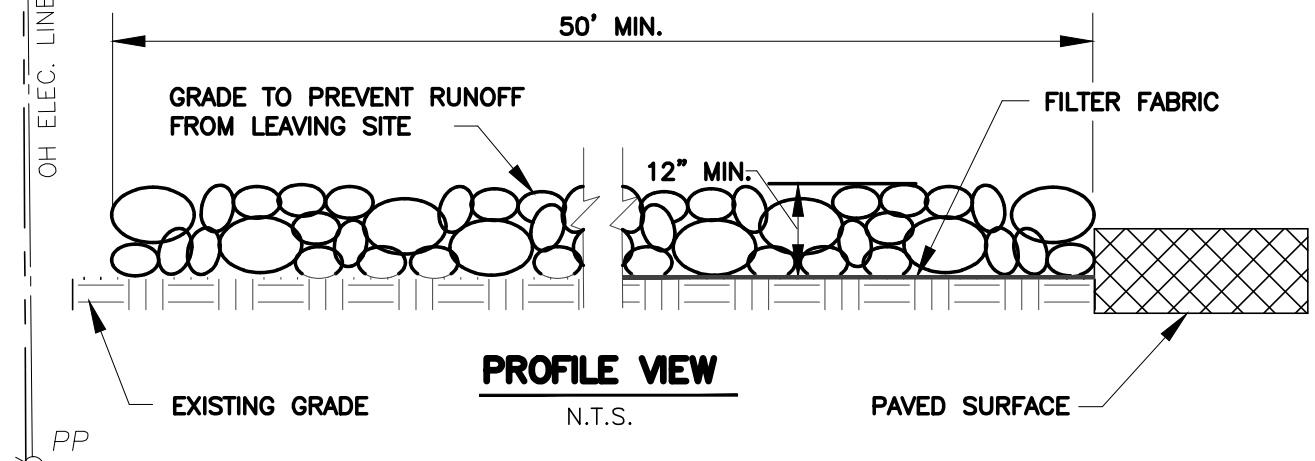

SILT FENCE


STABILIZED CONSTRUCTION ENTRANCE

STABILIZED CONSTRUCTION ENTRANCE GENERAL NOTES:

1. STONE SHALL BE 4 TO 6 INCH DIAMETER CRUSHED ROCK. (NOT CRUSHED CONCRETE)
2. LENGTH SHALL BE SHOWN ON PLANS, WITH A MINIMUM LENGTH OF 30 FEET FOR LOTS WHICH ARE LESS THAN 150 FEET FROM EDGE OF PAVEMENT. THE MINIMUM DEPTH IN ALL OTHER CASES SHALL BE 50 FEET.
3. THE THICKNESS SHALL NOT BE LESS THAN 12 INCHES.
4. THE WIDTH SHALL BE NO LESS THAN THE FULL WIDTH OF ALL POINTS OF INGRESS OR EGRESS.
5. WHEN NECESSARY, VEHICLES SHALL BE CLEANED TO REMOVE SEDIMENT PRIOR TO ENTRANCE ONTO A PUBLIC ROADWAY. WHEN WASHING IS REQUIRED, IT SHALL BE DONE ON AN AREA STABILIZED WITH CRUSHED STONE WITH DRAINAGE FLOWING AWAY FROM BOTH THE STREET AND THE STABILIZED ENTRANCE. ALL SEDIMENT SHALL BE PREVENTED FROM ENTERING ANY STORM DRAIN, DITCH OR WATERCOURSE USING APPROVED METHODS.
6. THE ENTRANCE SHALL BE MAINTAINED IN A CONDITION WHICH WILL PREVENT TRACKING OR FLOWING OF SEDIMENT ONTO PAVED SURFACES. THIS MAY REQUIRE PERIODIC TOP DRESSING WITH ADDITIONAL STONE AS CONDITIONS DEMAND. ALL SEDIMENT SPILLED, DROPPED, WASHED, OR TRACKED ONTO PAVED SURFACES MUST BE REMOVED IMMEDIATELY.
7. THE ENTRANCE MUST BE PROPERLY GRADED OR INCORPORATE A DRAINAGE SWALE TO PREVENT RUNOFF FROM LEAVING THE CONSTRUCTION SITE.

SILT FENCE GENERAL NOTES:

1. STEEL POSTS WHICH SUPPORT THE SILT FENCE SHALL BE INSTALLED ON A SLIGHT ANGLE TOWARD THE ANTICIPATED RUNOFF SOURCE. POST MUST BE EMBEDDED A MINIMUM OF ONE FOOT.
2. THE TOE OF THE SILT FENCE SHALL BE TRENCHED IN WITH A SPADE OR MECHANICAL TRENCHER, SO THAT THE DOWNSLOPE FACE OF THE TRENCH IS FLAT AND PERPENDICULAR TO THE LINE OF FLOW. WHERE FENCE CANNOT BE TRENCHED IN (E.G. PAVEMENT), WEIGHT FABRIC FLAP WITH ROCK ON UPHILL SIDE TO PREVENT FLOW FROM SEEPING UNDER FENCE.
3. THE TRENCH MUST BE A MINIMUM OF 6 INCHES DEEP AND 6 INCHES WIDE TO ALLOW FOR THE SILT FENCE FABRIC TO BE LAID IN THE GROUND AND BACKFILLED WITH COMPACTED MATERIAL.
4. SILT FENCE SHOULD BE SECURELY FASTENED TO EACH STEEL SUPPORT POST OR TO WOVEN WIRE, WHICH IN TURN IS ATTACHED TO THE STEEL FENCE POST. THERE SHALL BE A 3 FOOT OVERLAP, SECURELY FASTENED WHERE ENDS OF FABRIC MEET.
5. INSPECTION SHALL BE MADE EVERY TWO WEEKS AND AFTER EACH 1/2" RAINFALL. REPAIR OR REPLACEMENT SHALL BE MADE PROMPTLY AS NEEDED.
6. SILT FENCE SHALL BE REMOVED WHEN THE SITE IS COMPLETELY STABILIZED SO AS NOT TO BLOCK OR IMPEDE STORM FLOW OR DRAINAGE.
7. ACCUMULATED SILT SHALL BE REMOVED WHEN IT REACHES A DEPTH OF HALF THE HEIGHT OF THE FENCE. THE SILT SHALL BE DISPOSED OF AT AN APPROVED SITE, AND IN SUCH A MANNER AS TO NOT CONTRIBUTE TO ADDITIONAL SILTATION.

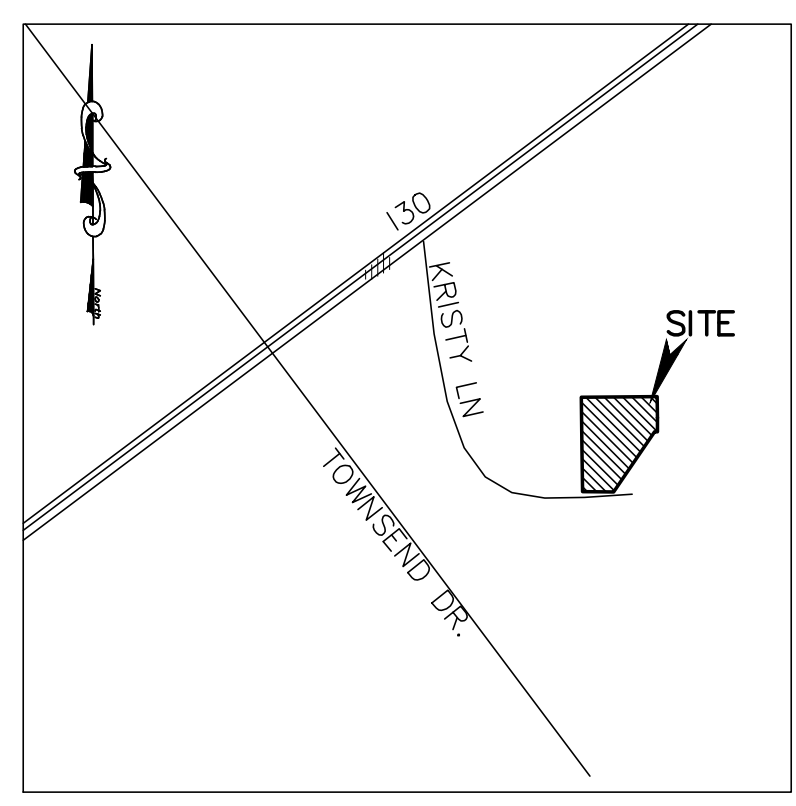

LOCATION MAP (NOT TO SCALE)

LEGEND

- = PROPERTY LINE
- SF — = PROPOSED SILT FENCE
- EX. W — = EX. WATER
- EX. SS — = EX. SANITARY SEWER
- 460 — = EXISTING CONTOURS
- 460 — = PROPOSED CONTOURS
- EX. SS — = EXISTING SANITARY SEWER LINE
- EX. W — = EXISTING WATER LINE
- ⊕ FH = EXISTING FIRE HYDRANT
- ⊕ WM = EXISTING WATER METER
- ⊕ PP = EXISTING POWER POLE
- ⊕ LP = EXISTING LIGHT POLE
- T = EX. WATER VALVE
- ⊙ = EXISTING SEWER MANHOLE
- ⊙ = EXISTING GAS METER
- B-B = BACK OF CURB TO BACK OF CURB
- EXIST. or EX. = EXISTING
- PROP. = PROPOSED
- LS = LANDSCAPE
- RCP = REINFORCED CONCRETE PIPE
- min = MINIMUM
- max = MAXIMUM
- ⊕ = PROPOSED FIRE HYDRANT
- ⊕ = PROPOSED FIRELINE
- ⊕ = PROPOSED PONDING AREA

ONLY DRAWINGS STAMPED "RELEASED FOR CONSTRUCTION" BY THE CITY OF ROCKWALL TO BE USED FOR CONSTRUCTION.

AS-BUILT
 May 12, 2021
 Gerald Monk
 GERALD E. MONK, P.E.



TO THE BEST OF OUR KNOWLEDGE MONK CONSULTING ENGINEERS, INC HEREBY STATES THAT THIS PLAN IS AS-BUILT. THE INFORMATION PROVIDED IS BASED ON SURVEYING AT THE SITE AND INFORMATION PROVIDED BY THE CONTRACTOR.

CASE # SP2019-047

EROSION CONTROL PLAN

BACON PLUMBING OFFICE

2055 KRISTY LANE
 LOT 1-M, BODIN INDUSTRIAL TRACT, 3.54 ACRES
 City of Rockwall, Rockwall County, Texas

owner
BACON PROPERTY, LLC
 295 RANCH TRAIL
 ROCKWALL, TEXAS 75032
 CONTACT: BRAD BACON (972)236-5794


























prepared by
MONK CONSULTING ENGINEERS, INC.
 1200 W. State Street, Garland Texas 75040
 972 272-1763 Fax 972 272-8761

REG NO.: F-2567
 ©2020 by Monk Consulting Engineers, Inc., All Rights Reserved.



date: 8/31/20 scale: 1" = 30' sheet: **C107**

WARNING:
 PRIOR TO THE BEGINNING OF ANY CONSTRUCTION OR CONSTRUCTION STAKING, IT SHALL BE THE CONTRACTORS RESPONSIBILITY TO CONTACT THE CIVIL ENGINEER TO ENSURE THAT ALL PARTIES ARE IN POSSESSION OF THE MOST CURRENT SET OF CONSTRUCTION DOCUMENTS.

NOTE:
 THE CONTRACTOR SHALL BE RESPONSIBLE FOR FIELD VERIFYING THE LOCATION OF ALL EXISTING UTILITIES AND EASEMENTS PRIOR TO START OF OPERATIONS. CONTRACTOR WILL NOTIFY THE OWNER'S REPRESENTATIVE OF ANY DISCREPANCIES PRIOR TO STARTING THE WORK. EXISTING UTILITIES AND UNDERGROUND FACILITIES INDICATED ON THESE PLANS HAVE BEEN LOCATED FROM REFERENCE INFORMATION. IT SHALL BE THE RESPONSIBILITY OF THE CONTRACTOR TO VERIFY BOTH THE HORIZONTAL AND VERTICAL LOCATION OF ALL EXISTING UTILITIES AND UNDERGROUND FACILITIES PRIOR TO START OF CONSTRUCTION. TAKE THE NECESSARY PRECAUTIONS IN ORDER TO PROTECT ALL FACILITIES ENCOUNTERED. THE CONTRACTOR SHALL PRESERVE AND PROTECT ALL EXISTING UTILITIES FROM DAMAGE DURING CONSTRUCTION.

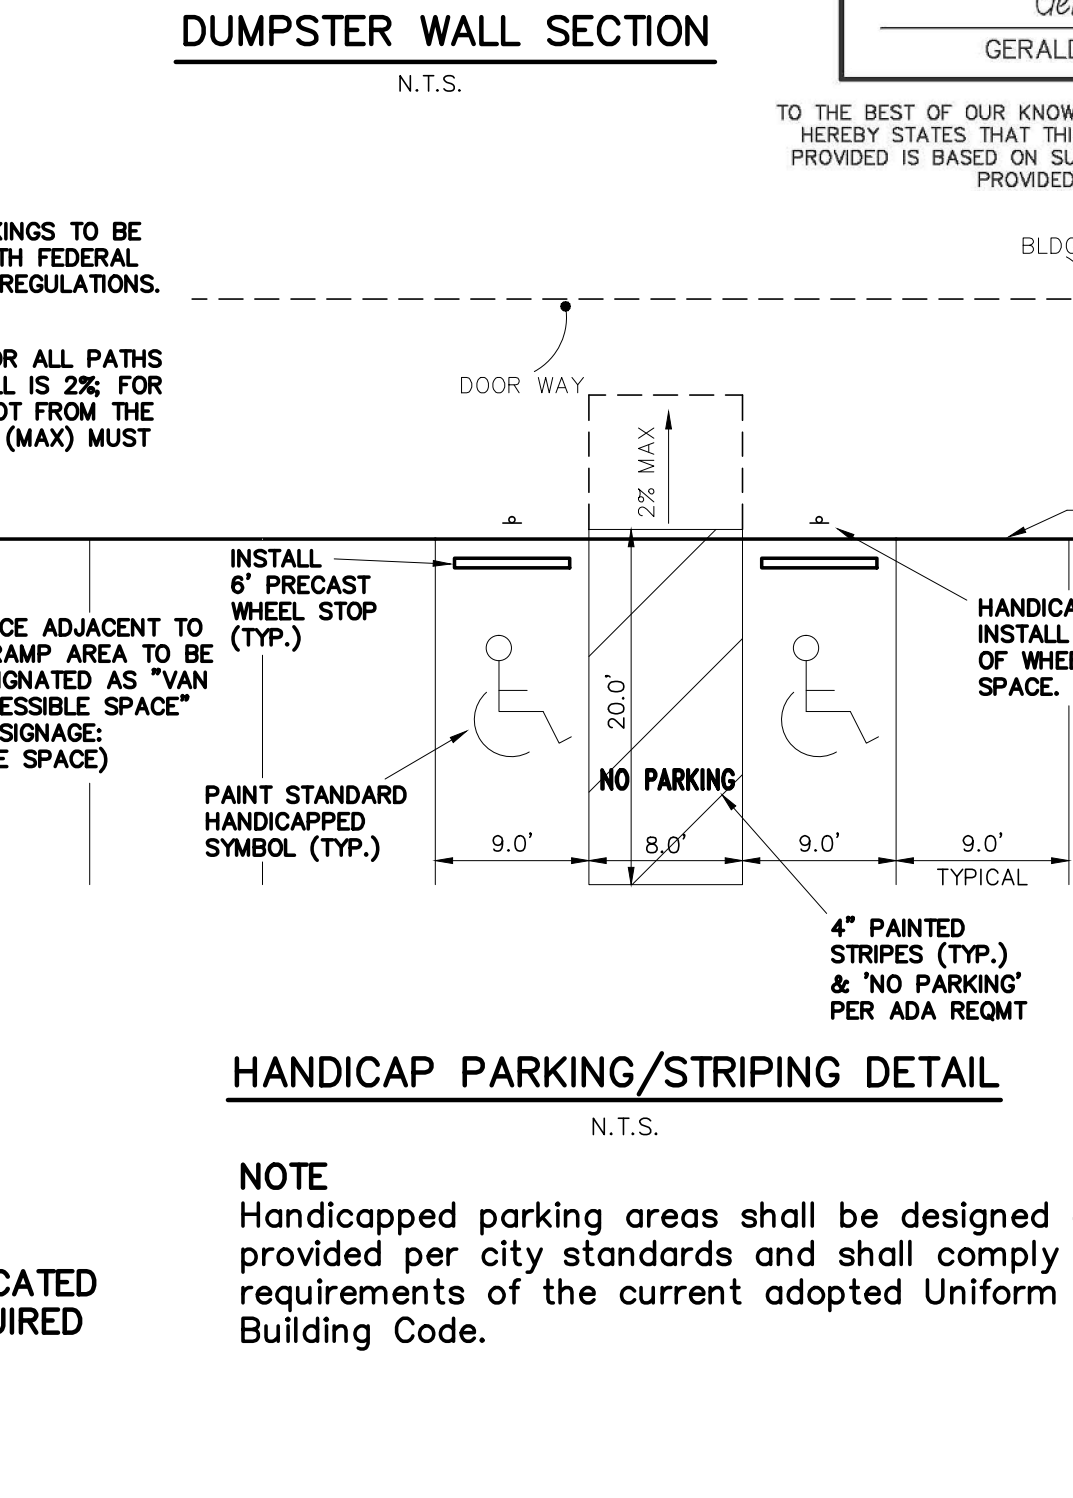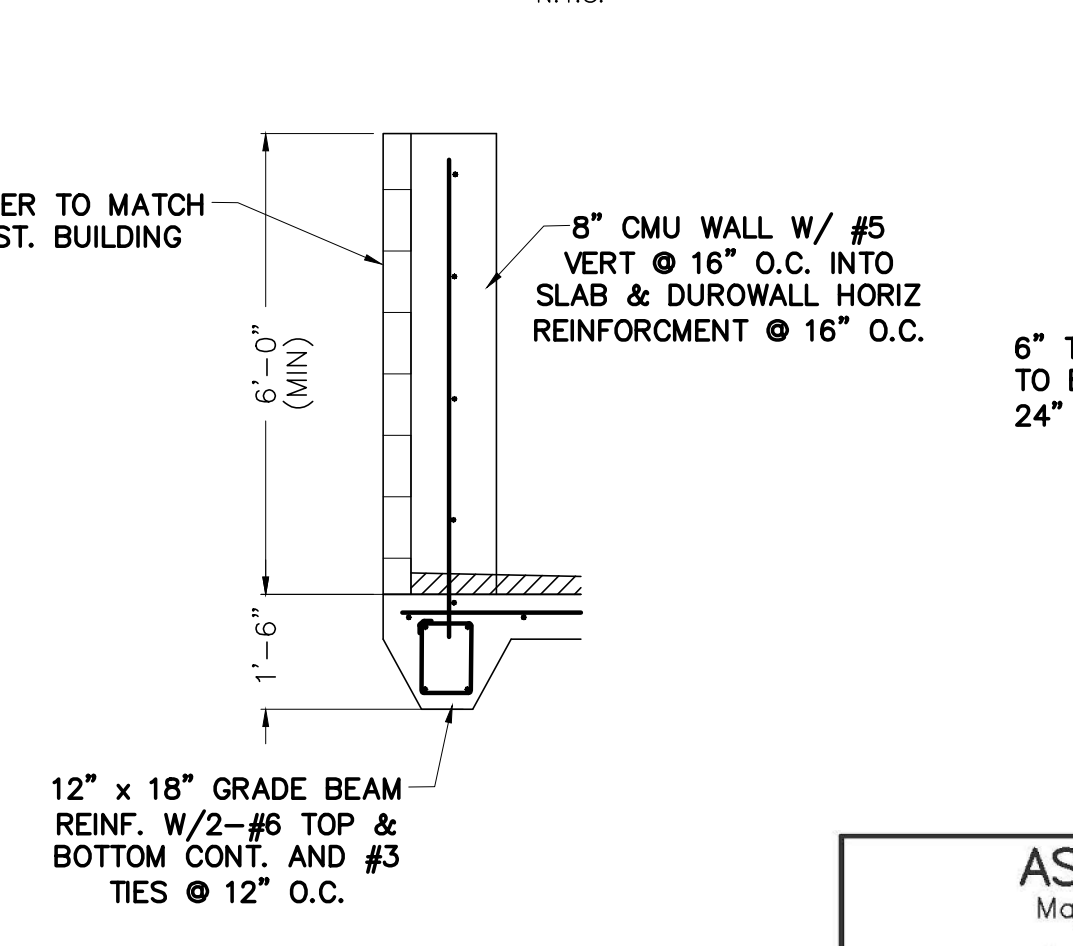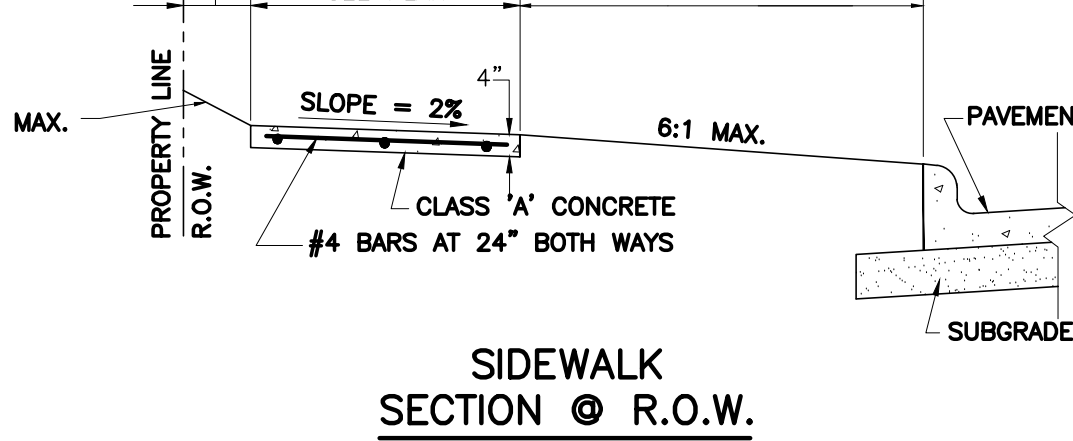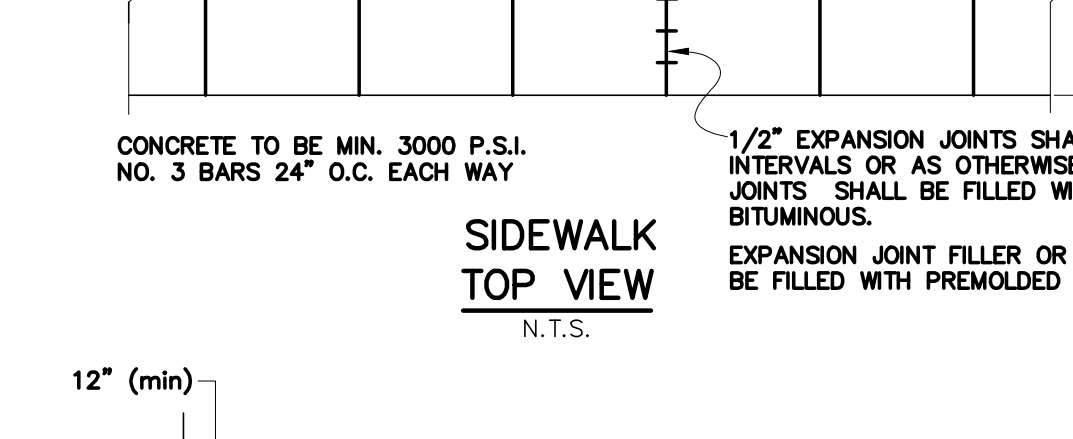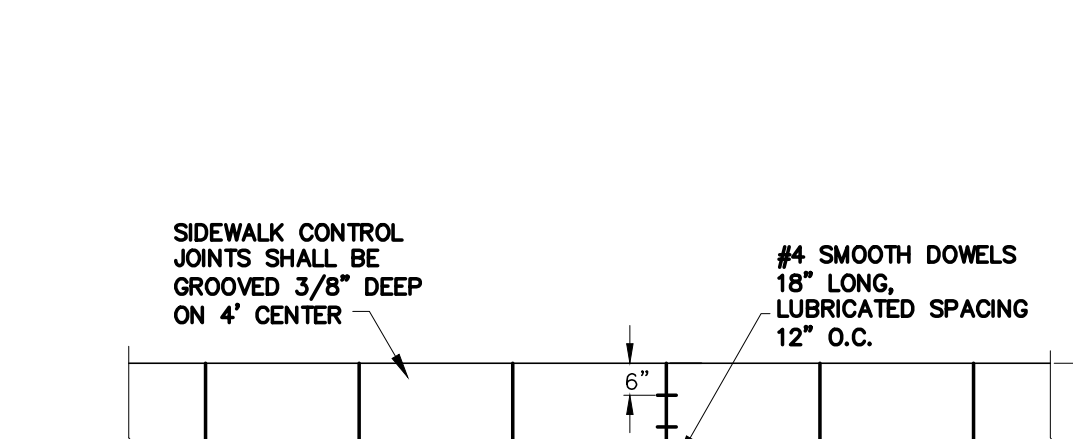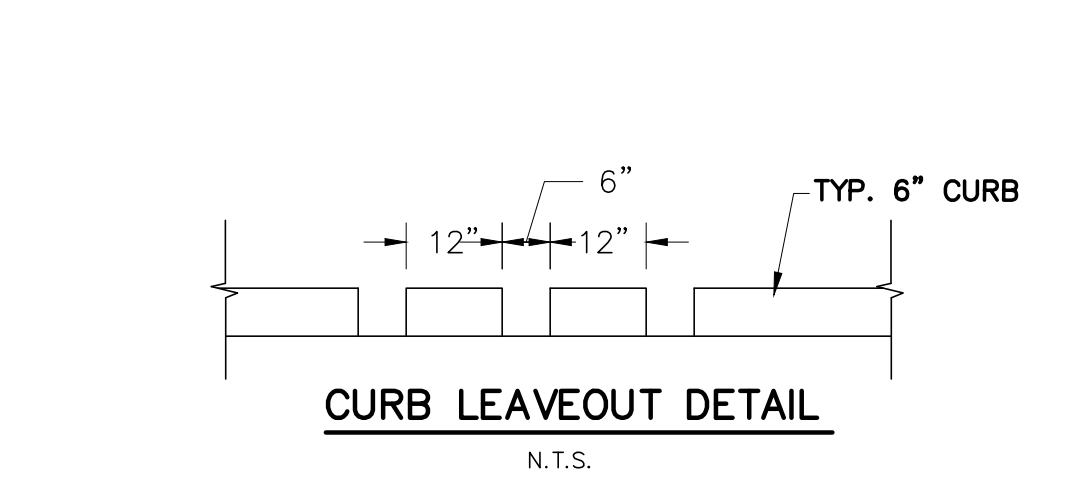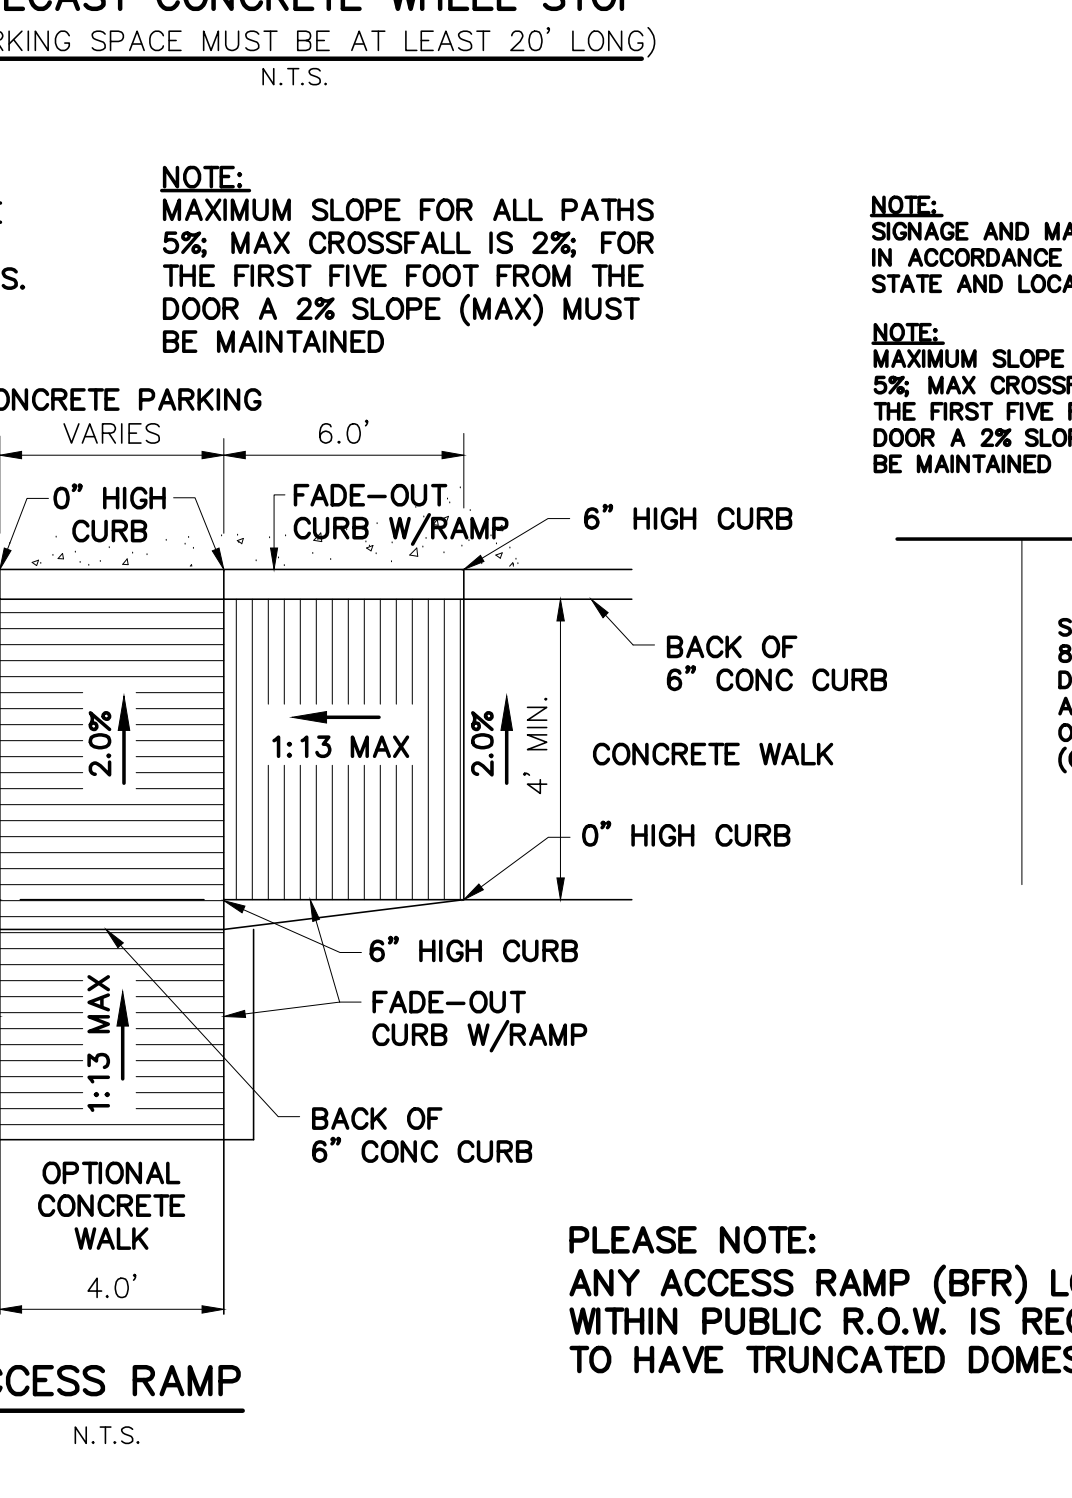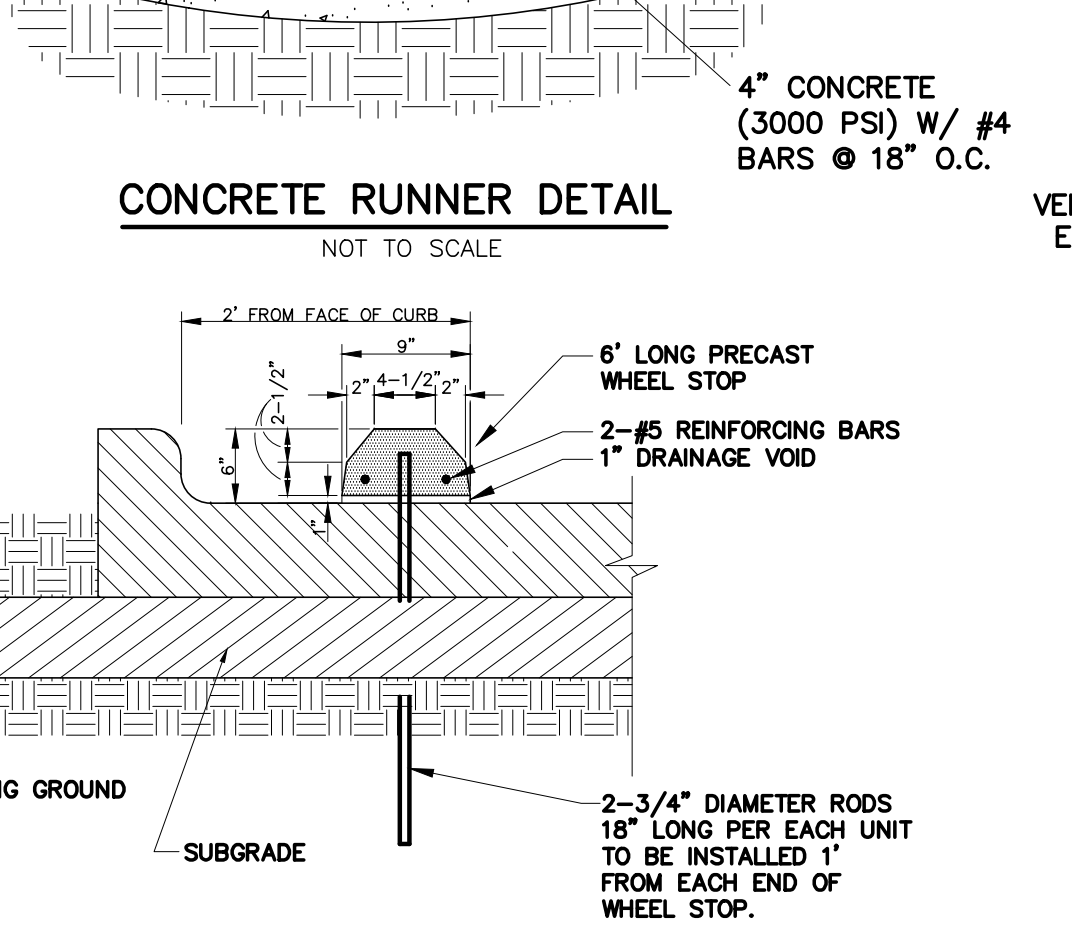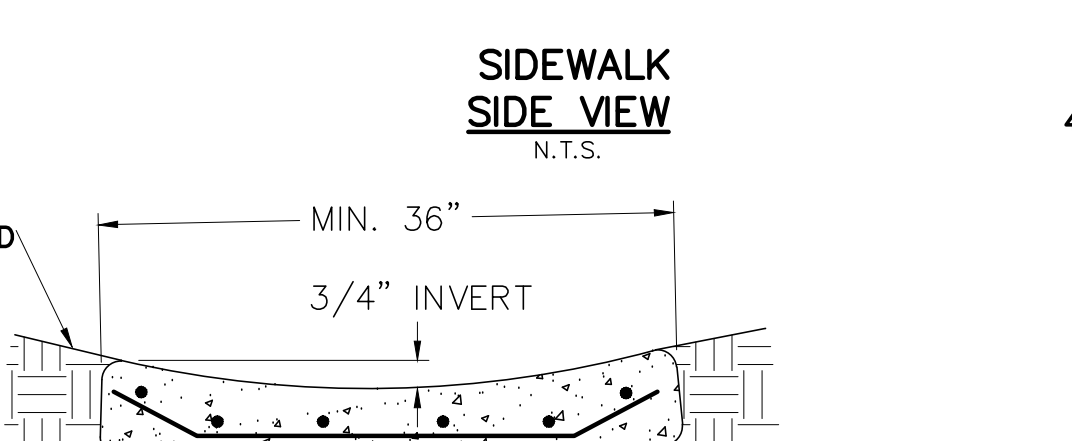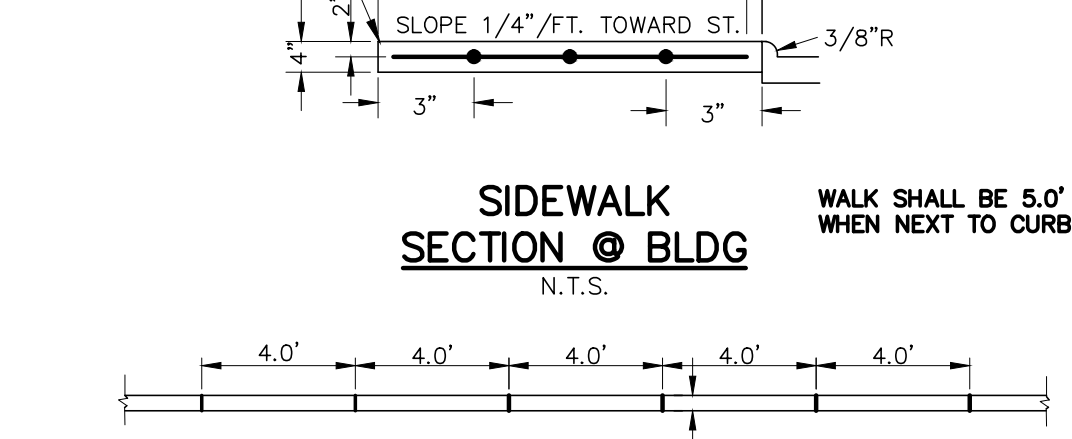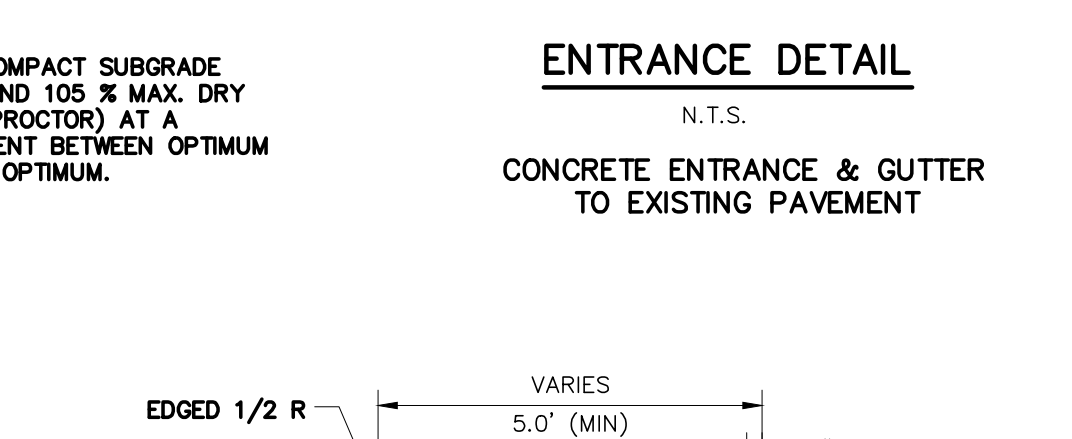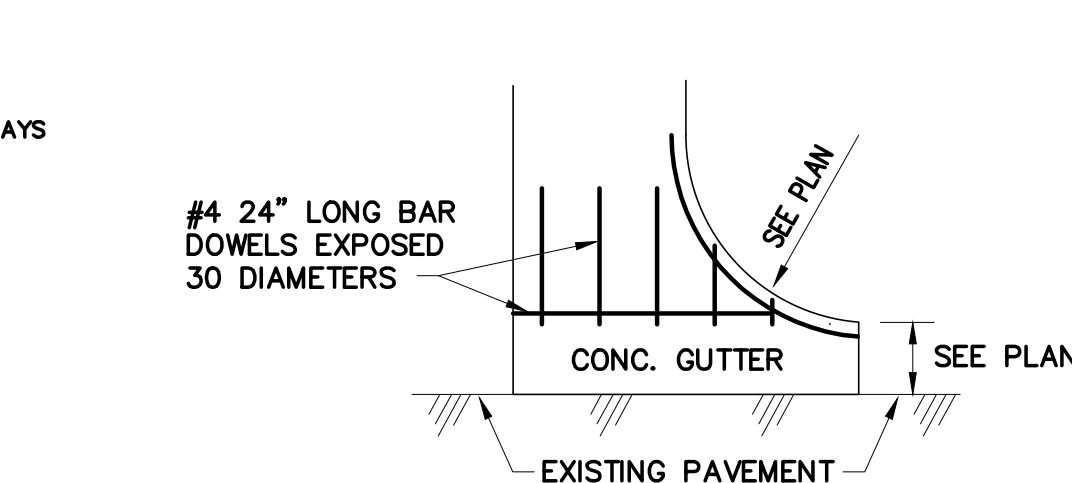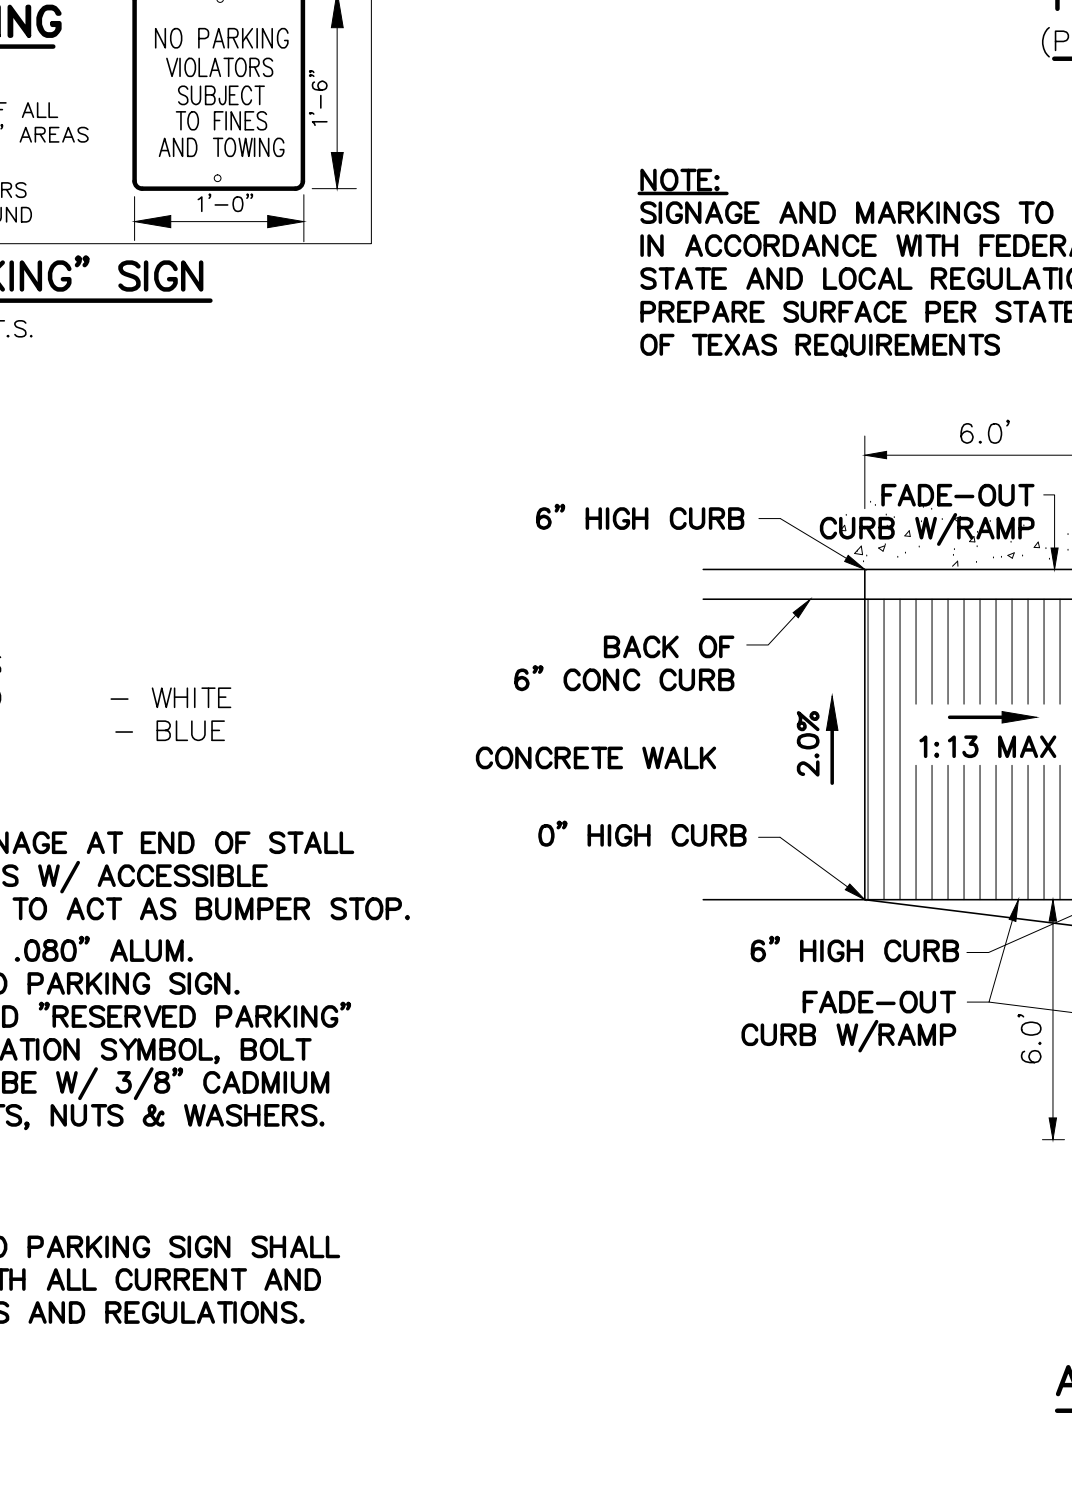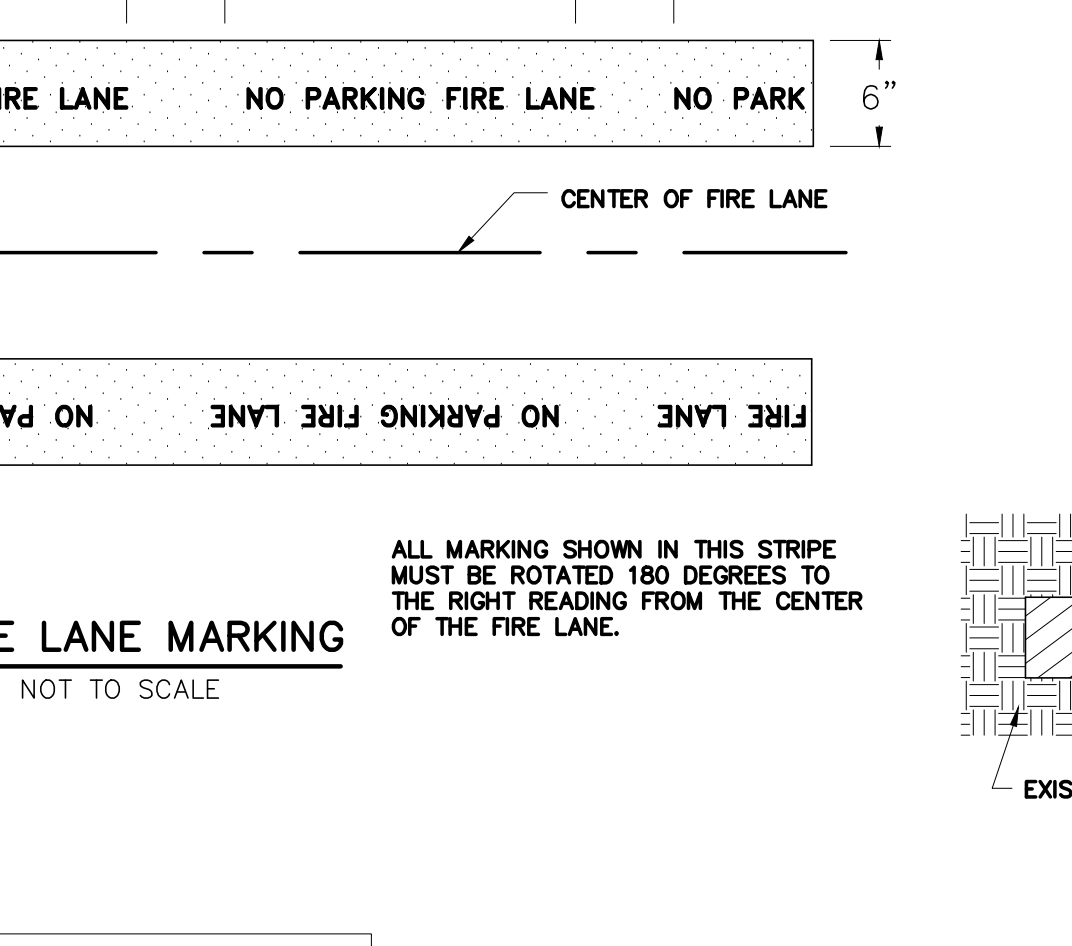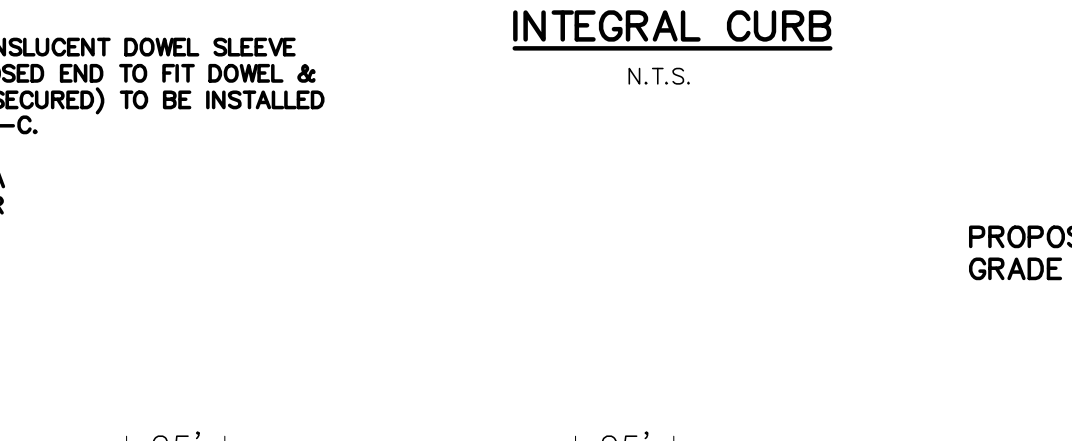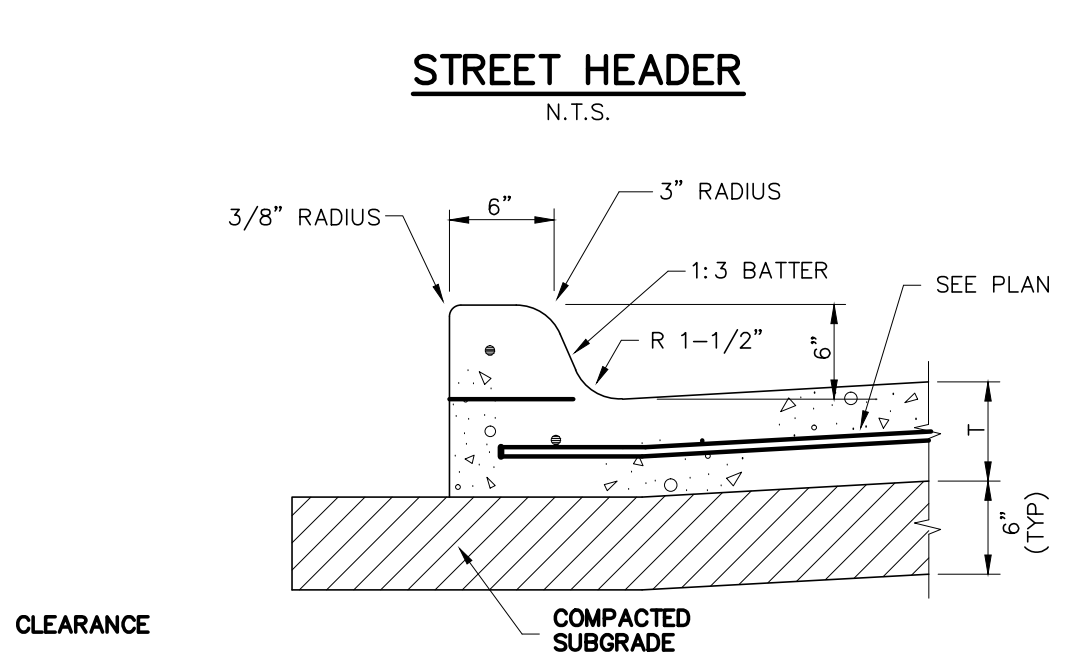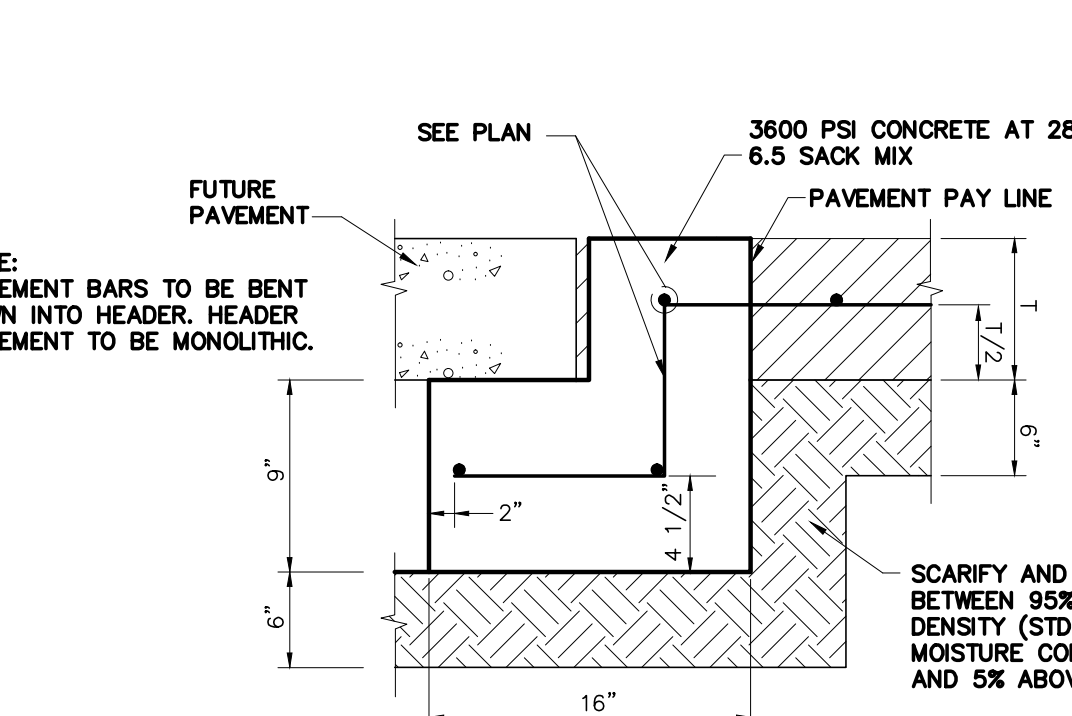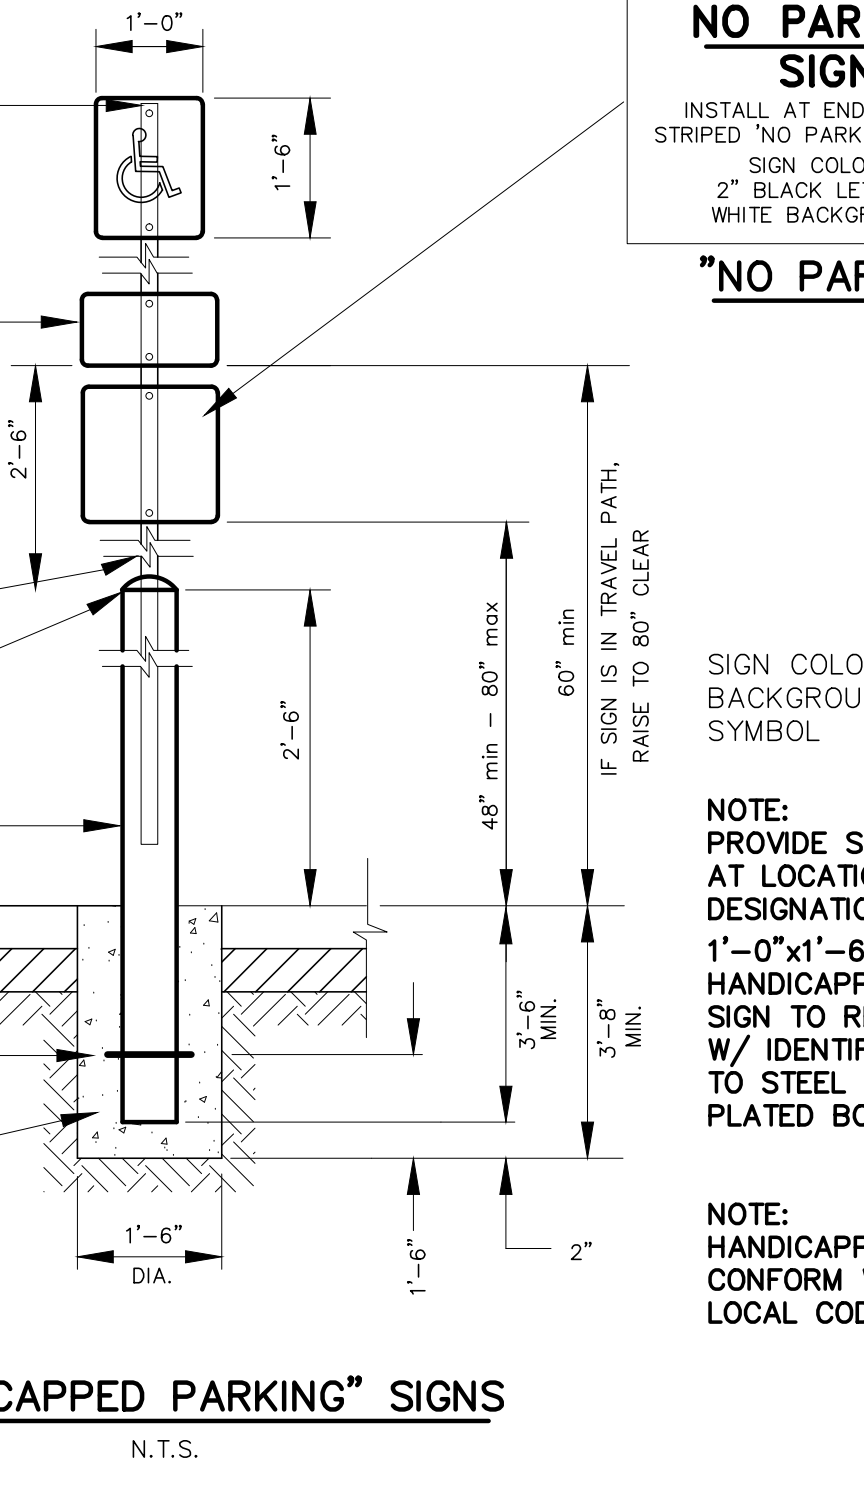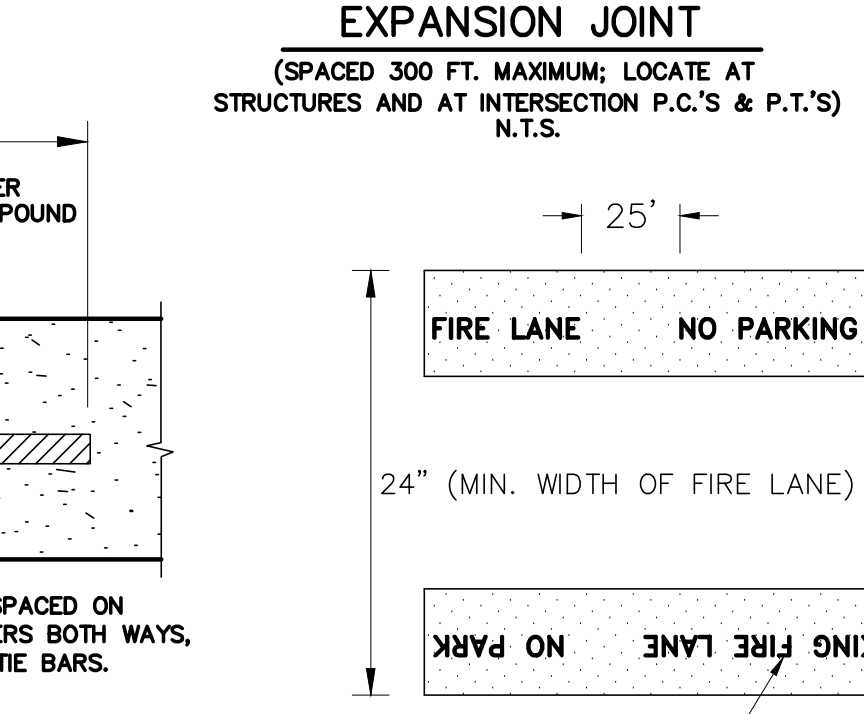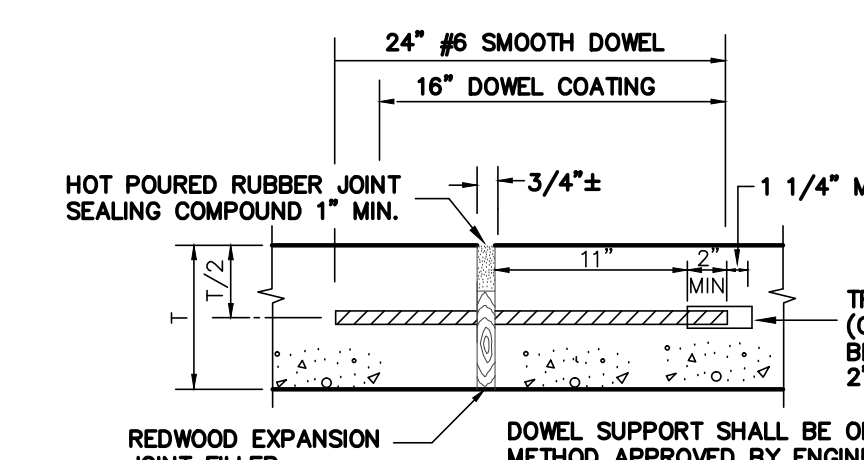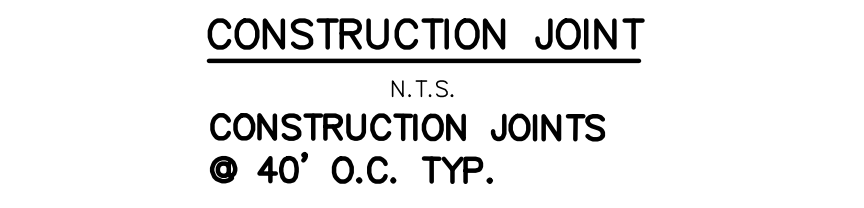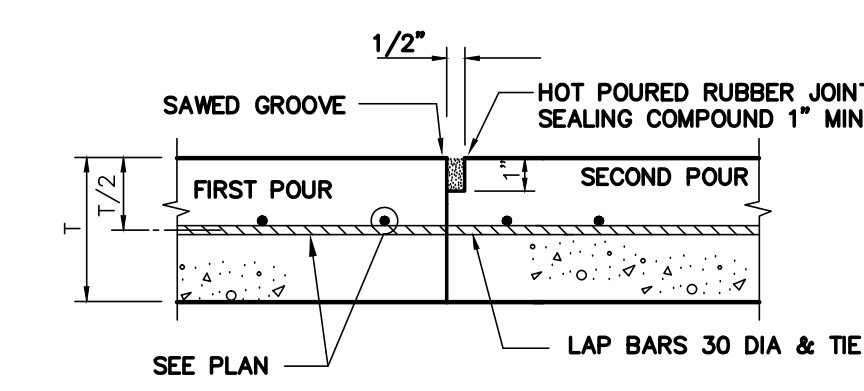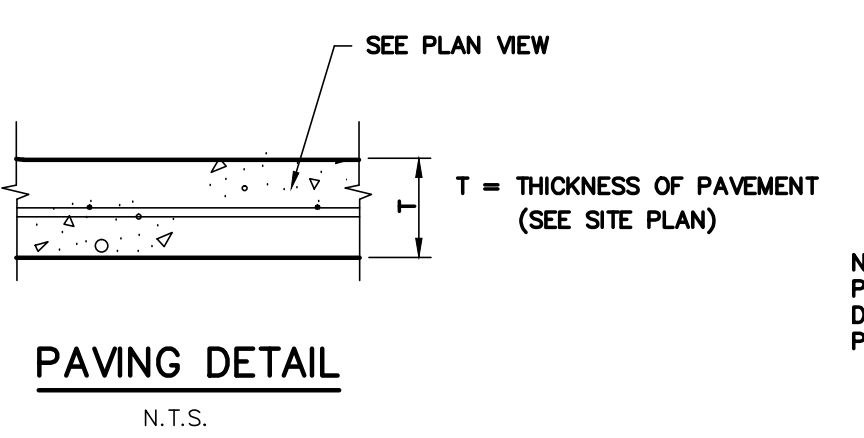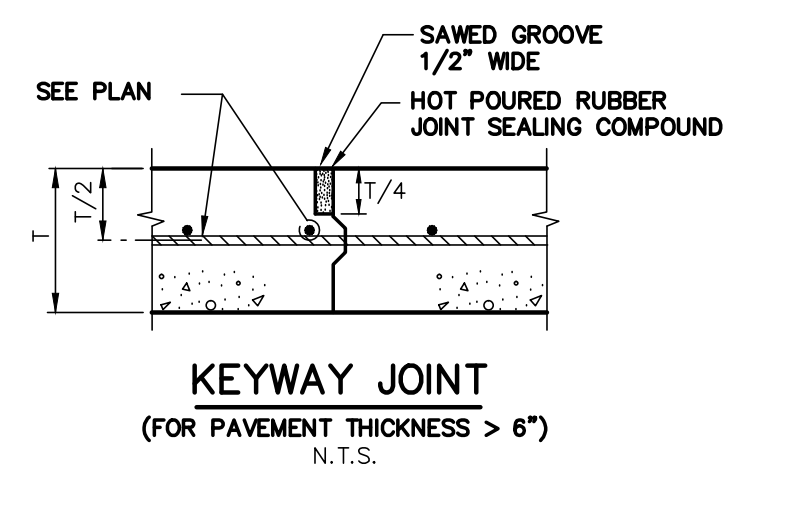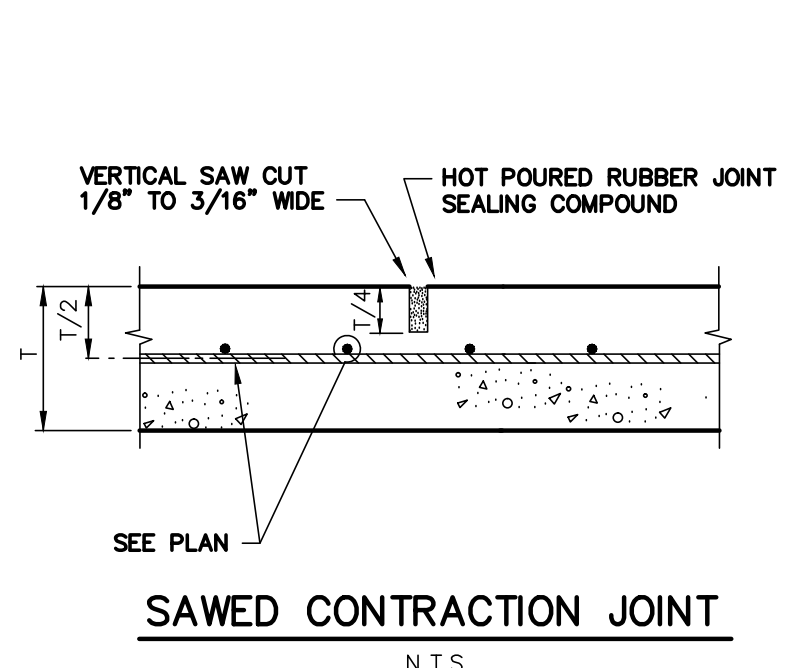

- GENERAL NOTES**
- Buildings 5,000 square feet or greater shall be sprinkled. (Unless otherwise noted) Alternative fire protective measures may be approved by the Building Inspector and Fire Dept.
 - Fire lanes shall be designed and constructed per city standards.
 - Handicapped parking areas shall be designed and provided per city standards and shall comply with requirements of the current adopted Uniform Building Code.
 - Mechanical units, dumpsters and trash compactors shall be screened in accordance with the Zoning Ordinance.
 - All signage contingent upon Building Inspection Department.
 - Approval of the site plan is not final until all engineering plans are approved.
 - Open storage, where permitted, shall be screened in accordance with the Zoning Ordinance.
 - Please contact the Building Inspection Department to determine the type of construction and occupancy group.
 - All electrical transmission, distribution and service lines must be underground.

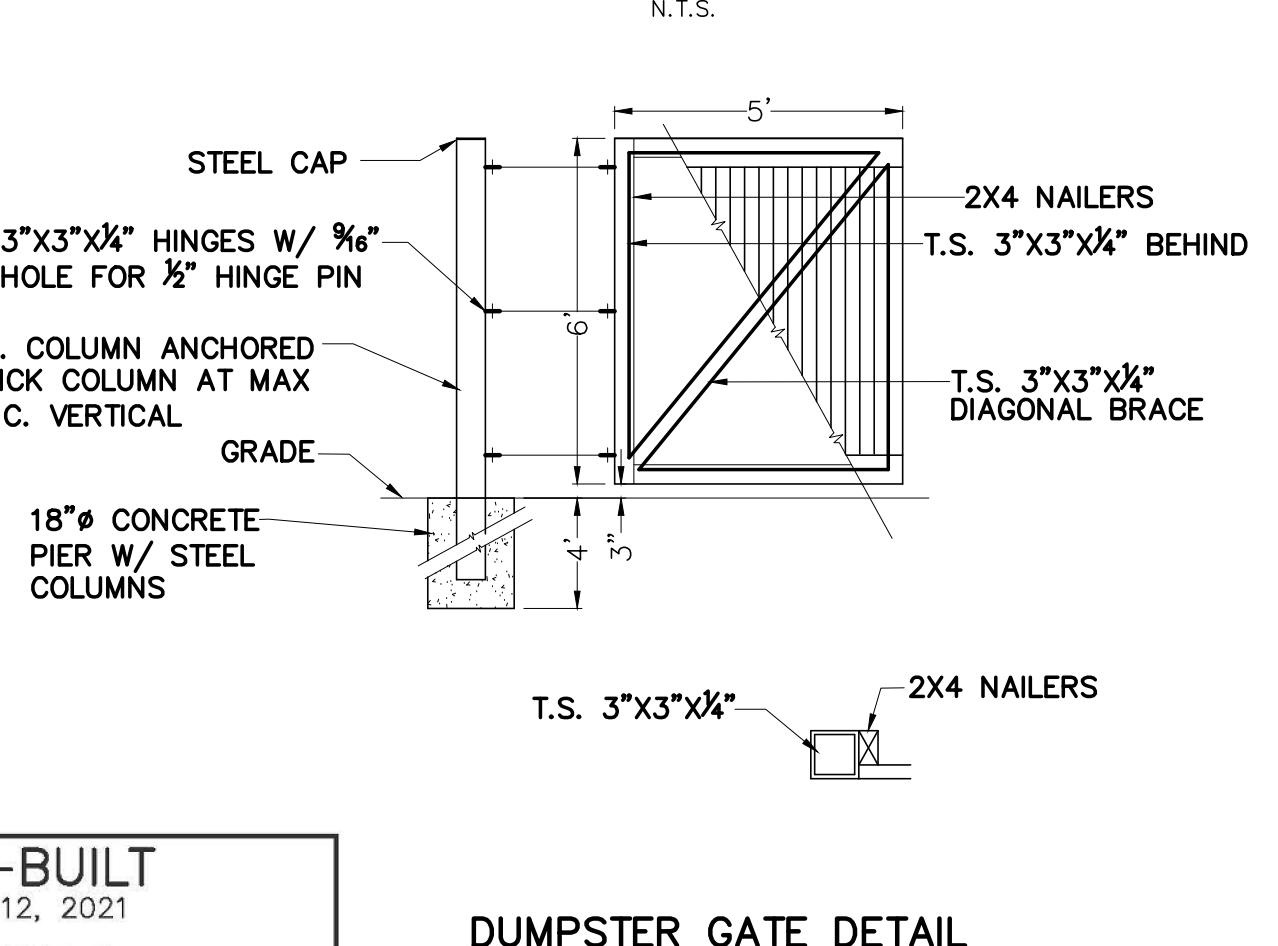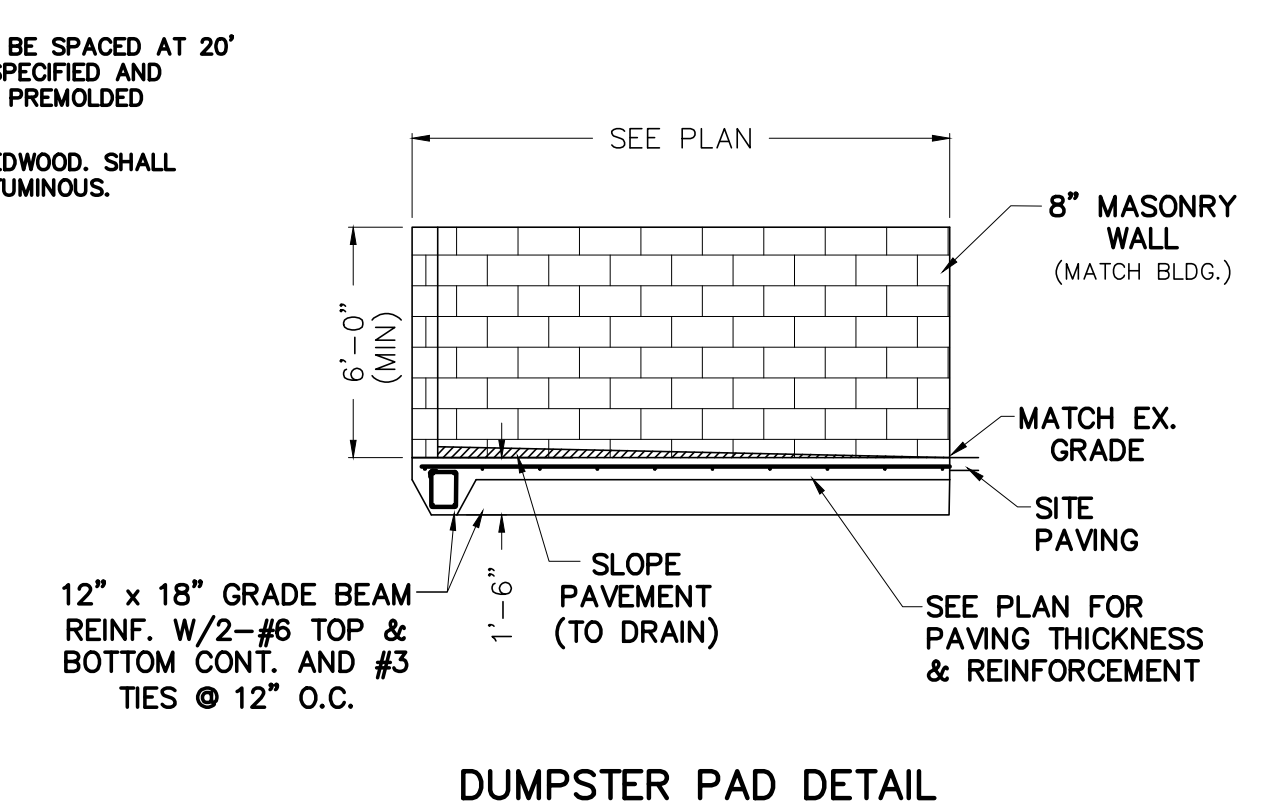

AS-BUILT
May 12, 2021
Gerald Monk
GERALD E. MONK, P.E.

TO THE BEST OF OUR KNOWLEDGE MONK CONSULTING ENGINEERS, INC. HEREBY STATES THAT THIS PLAN IS AS-BUILT. THE INFORMATION PROVIDED IS BASED ON SURVEYING AT THE SITE AND INFORMATION PROVIDED BY THE CONTRACTOR.

NOTES:

- ALL WORK MUST CONFORM TO CITY STANDARDS.
- ALL WORK IN PUBLIC RIGHT-OF-WAY & EASEMENTS SHALL CONFORM TO CITY STANDARDS AND DETAILS.
- ALL PRIVATE DETAILS ARE SUPERSEDED BY STANDARD CITY DETAILS.

CASE # SP2019-047

SITE DETAILS

DETAIL SHEETS

prepared by
MONK CONSULTING ENGINEERS
1200 W. State Street, Garland Texas 75040
972 272-1763 Fax 972 272-8761
© 2020 Monk Consulting Engineers, Inc., All Rights Reserved

date: 8/31/20 scale: N.T.S. sheet: D101