


CAUTION !!

CONTRACTOR IS TO CONTACT TEXAS ONE-CALL SYSTEM (1-800-245-4545) OR OTHER UTILITY LOCATING SERVICES AT LEAST 48 HOURS PRIOR TO CONSTRUCTION ACTIVITIES. BURY & PARTNERS IS NOT RESPONSIBLE FOR KNOWING ALL EXISTING UTILITIES IN THE PROJECT AREA NOR FOR DEPICTING THE EXACT LOCATIONS OF UTILITIES ON THESE DRAWINGS.

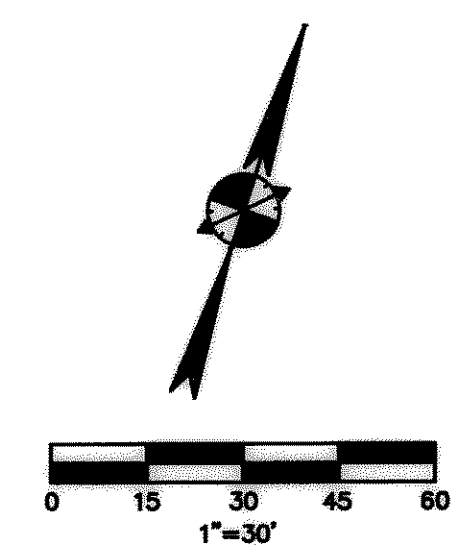

SEE SHEET C3.1 FOR GRADING AND TREE PROTECTION GENERAL NOTES

PMH	12/15/04	DATE
BAA	11/18/04	BY
REVISION		
3	CITY COMMENTS	
2	CITY COMMENTS	
NO.		

Bury + Partners
 ENGINEERING SOLUTIONS
 5310 Harvest Hill Road, Suite 100
 Dallas, Texas 75220
 Tel: (972)991-0011 Fax: (972)991-0276
 Bury+Partners-307, Inc. ©Copyright 2004

Professional Seal:
 STATE OF TEXAS
 ENGINEERING
 BILAL ALIZAI
 No. 92792
 EXPIRES 12/31/06

Bilal A. Alizai
7/09/2005

RECORD DRAWING

RECORD DRAWINGS:
 THE INTENT OF THE OWNER AND ENGINEER WAS TO CONSTRUCT THE FACILITIES ACCORDING TO THESE PLANS AS APPROVED BY THE CITY OF ROCKWALL. THE OWNER OR ENGINEER DID NOT VERIFY LINES OR GRADES AFTER CONSTRUCTION AND IS NOT AWARE OF ANY CHANGES OR REVISIONS TO THESE PLANS DURING CONSTRUCTION EXCEPT AS NOTED BASED ON INFORMATION PROVIDED BY: CENTEX CONSTRUCTION COMPANY
 3100 MCKINNON STREET, 7TH FLOOR
 DALLAS, TEXAS 75201
 PHONE: (214) 468-4700
 FAX: (214) 468-4257
 CONTACT: ROBERT BOE (PROJECT MANAGER)

REFERENCE BM = 518.32
 CITY OF ROCKWALL GEODETIC MONUMENT R011; IN MEDIAN STRIP OF NORTH LAKESHORE DR. BETWEEN STONEBROOK DR. & AMESBURY DR.

SITE BM = 467.38
 1" IN CENTER LINE OF INLET ON THE WEST SIDE OF SOUTH BOUND LAKESHORE DRIVE. ± 180' NORTH OF THE CENTERLINE INTERSECTION OF SH 66 & LAKESHORE DR.

Oculus Inc.

393 NORTH EUCLID
 SUITE 240
 ST. LOUIS, MO 63108
 USA

[T] 314.367.6100
 [F] 314.367.1489

WWW.OCULUSINC.COM

SERIAL NUMBER:
 NRSP VERSION: 2.5
 BULLETIN:

Project Name
 BANK OF AMERICA TX-0541 ROCKWALL, TX
 S.H. 66 & NORTH LAKESHORE DRIVE

PROTOTYPE LAYOUT
 MEDIUM - TX-0541 OCULUS #

Issue	Date & Issue Description	By

OFFSITE GRADING PLAN

**BANK OF AMERICA TX-0541
 LOT 2, BLOCK A, BOWLES ADDN.
 S.H. 66 & N. LAKESHORE DRIVE
 ROCKWALL, TX**

Scale: 1"=30'	Date: 7-8-05
Designed By: BAA	
Drawn By: DSM	
Checked By: PMH	
File: F:\3332-08\33208GRP.DWG	
Project No.: 30332-08	

SHEET
C3.2

