

DSM	12/15/04	BY	DATE
BAA	11/18/04	BY	DATE
NO.	REVISION	BY	DATE
3	CITY COMMENTS		
2	CITY COMMENTS		

**Bury+Partners**  
 ENGINEERING SOLUTIONS  
 5310 Harvest Hill Road, Suite 100  
 Dallas, Texas 75230  
 Tel. (972) 981-0011 Fax (972) 981-0278  
 Bury+Partners-IPW, Inc. © Copyright 2004

*Bilal A. Alizai*  
 7/25/2005

**STORM DRAIN PROFILES**

**BANK OF AMERICA TX-0541**  
**LOT 2, BLOCK A, BOWLES ADDN.**  
**S.H. 66 & N. LAKESHORE DRIVE**  
**ROCKWALL, TX**

**RECORD DRAWING**

RECORD DRAWINGS:  
 THE INTENT OF THE OWNER AND ENGINEER WAS TO CONSTRUCT THE FACILITIES ACCORDING TO THESE PLANS AS APPROVED BY THE CITY OF ROCKWALL. THE OWNER OR ENGINEER DID NOT VERIFY LINES OR GRADES AFTER CONSTRUCTION AND IS NOT AWARE OF ANY CHANGES OR REVISIONS TO THESE PLANS DURING CONSTRUCTION EXCEPT AS NOTED BASED ON INFORMATION PROVIDED BY:  
 CENTEX CONSTRUCTION COMPANY  
 3100 MCKINNON STREET, 7TH FLOOR  
 DALLAS, TEXAS 75201  
 PHONE: (214) 468-4700  
 FAX: (214) 468-4257  
 CONTACT: ROBERT BOE (PROJECT MANAGER)

*Bilal Alizai*  
 7/25/2005

**Oculus Inc.**


393 NORTH EUCLID  
 SUITE 240  
 ST. LOUIS, MO 63108  
 USA

(T) 314.367.6100  
 (F) 314.367.1489

WWW.OCULUSINC.COM

**REFERENCE BM = 518.32**  
 CITY OF ROCKWALL GEODETIC MONUMENT R011;  
 IN MEDIAN STRIP OF NORTH LAKESHORE DR.  
 BETWEEN STONEBROOK DR. & AMESBURY DR.

**SITE BM = 467.38**  
 "I" IN CENTER LINE OF INLET ON THE WEST  
 SIDE OF SOUTH BOUND LAKESHORE DRIVE. ±  
 180' NORTH OF THE CENTERLINE INTERSECTION  
 OF SH 66 & LAKESHORE DR.

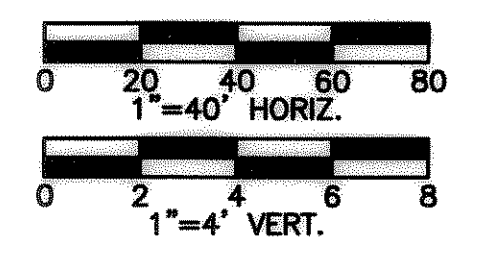

SERIAL NUMBER:  
 NRSP VERSION: 2.5  
 BULLETIN:

Project Name  
 BANK OF AMERICA TX-0541 ROCKWALL, TX  
 S.H. 66 & NORTH LAKESHORE DRIVE

PROTOTYPE LAYOUT  
 MEDIUM - TX-0541 OCULUS #

Issue Date & Issue Description By

Scale: AS SHOWN Date: 7-8-05

Designed By:	BAA
Drawn By:	DSM
Checked By:	PMH
File:	F:\3332-08\332085TM-PRO
Project No.:	30332-08

SHEET  
**C4.4**

F:\3332-08\332085TM-PRO.dwg modified by dmatherne at Jul 08, 2005 - 9:13am