


WILLIAMS 12/04/2003 11:37AM  
 S:\065\1100-119\1130-02-005\DWG\1130-02.DWG  
 © POGUE ENGINEERING & DEVELOPMENT COMPANY, INC. 2002. ALL RIGHTS RESERVED. THE ENGINEERING DESIGN, DETAIL AND ENGINEERING DRAWINGS FOR THIS PROJECT AND/OR OVERALL PROJECT ARE THE LEGAL PROPERTY OF POGUE ENGINEERING & DEVELOPMENT COMPANY, INC. THEIR USE FOR REPRODUCTION, CONSTRUCTION, OR DISTRIBUTION IS PROHIBITED UNLESS AUTHORIZED IN WRITING BY POGUE ENGINEERING & DEVELOPMENT COMPANY, INC.

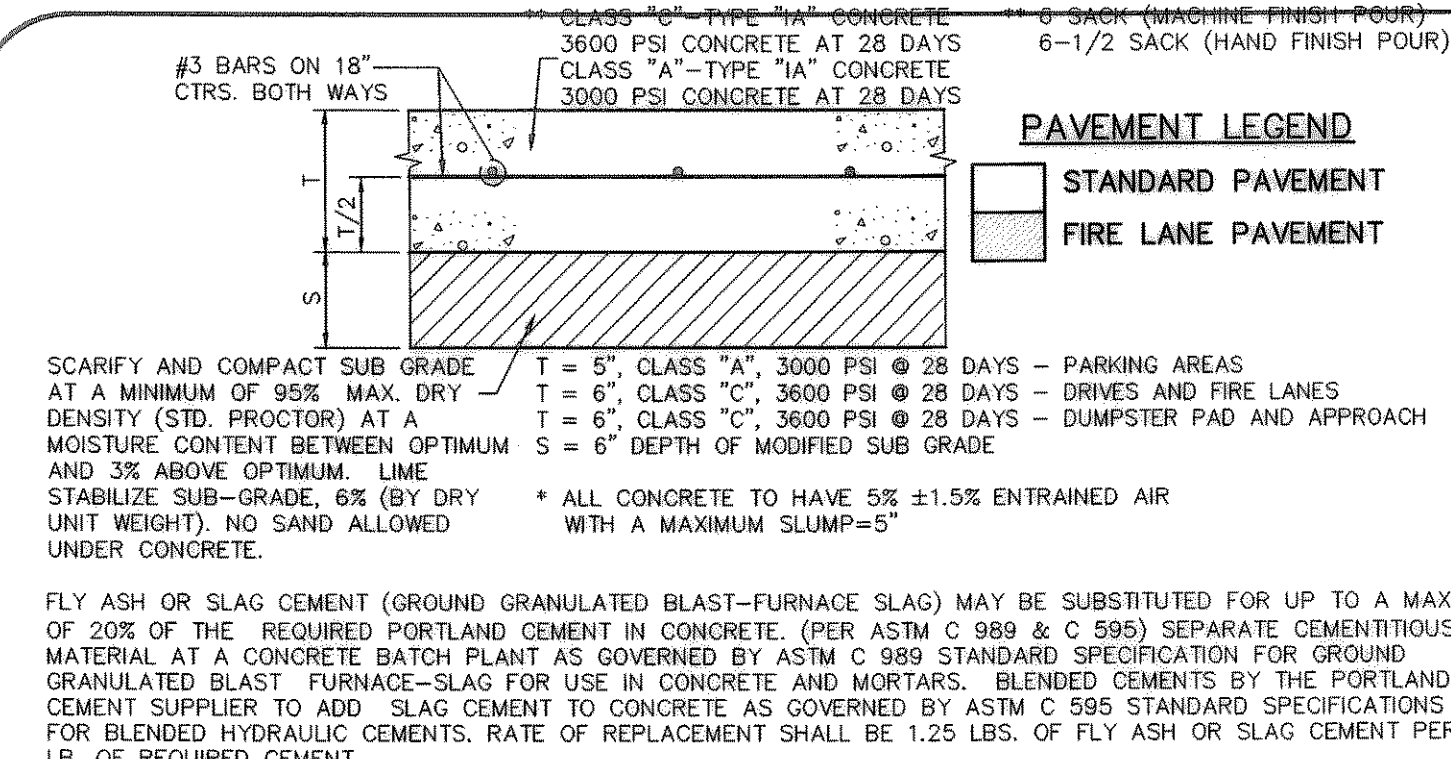















**01 PAVEMENT SECTION**  
 C1.02 NOT TO SCALE

**02 NOT USED**  
 C1.02 NOT TO SCALE

**03 CONCRETE CURB**  
 C1.02 NOT TO SCALE

**04 STREET HEADER**  
 C1.02 NOT TO SCALE

**05 LAY DOWN CURB**  
 C1.02 NOT TO SCALE

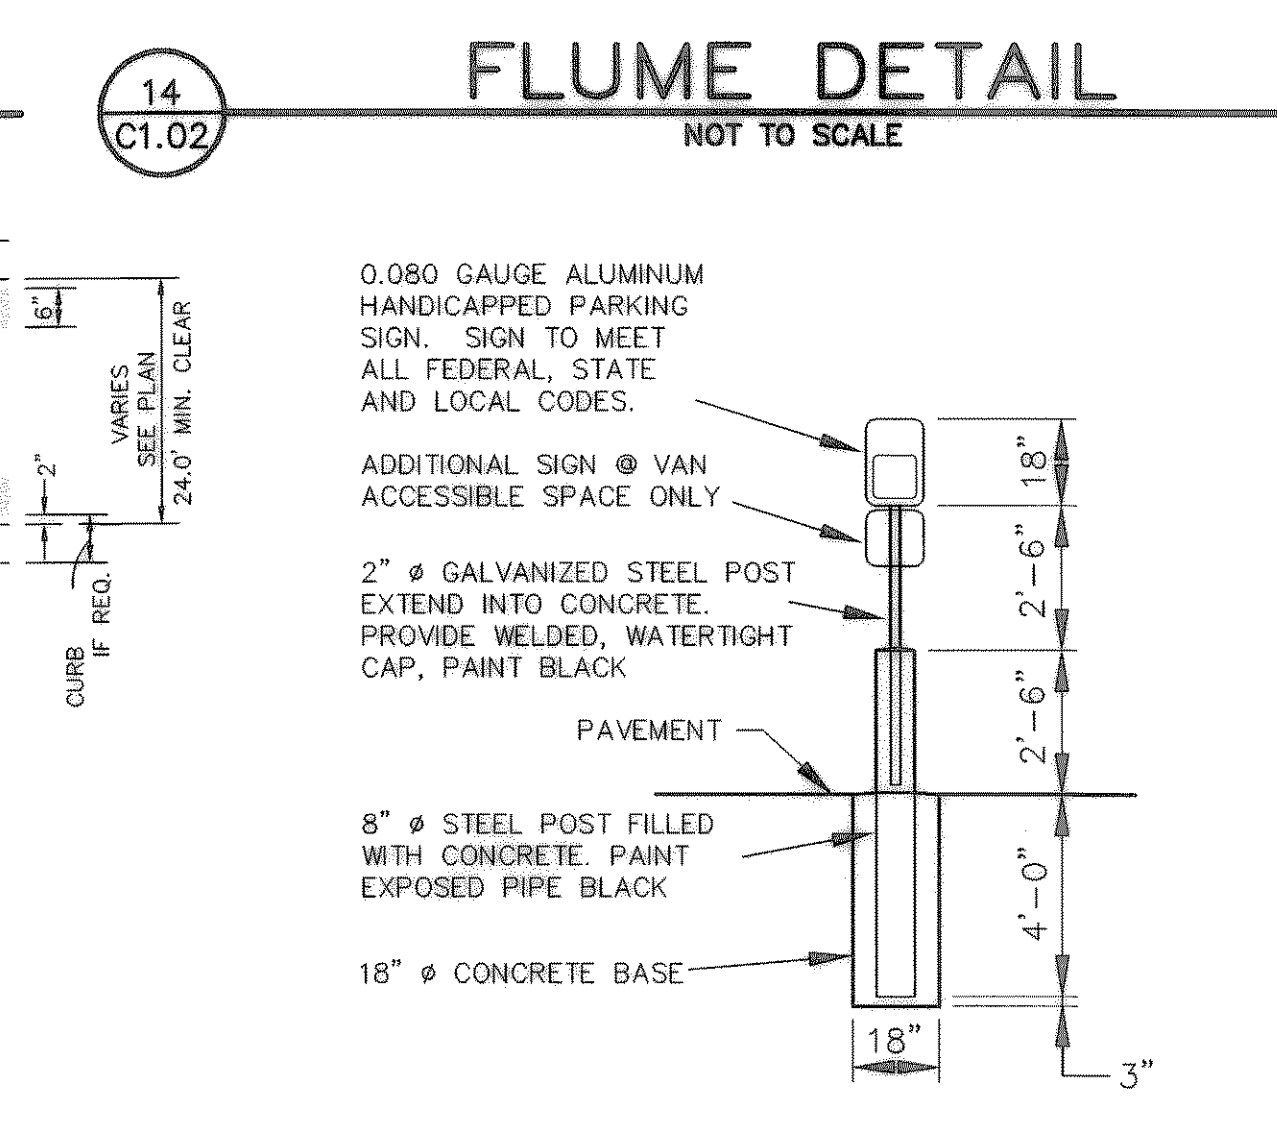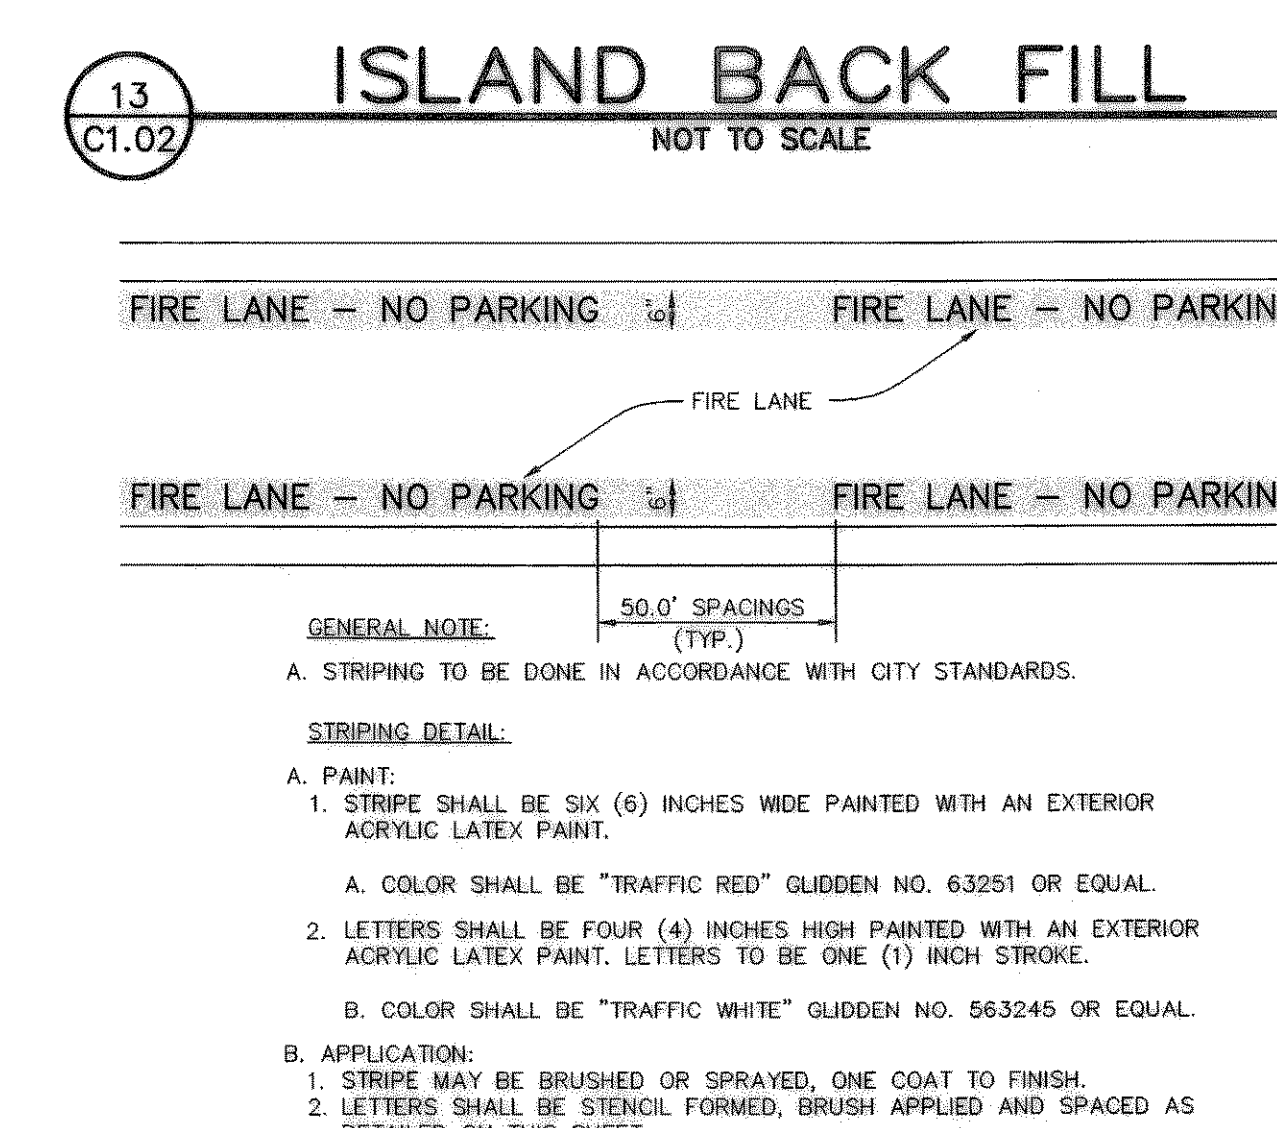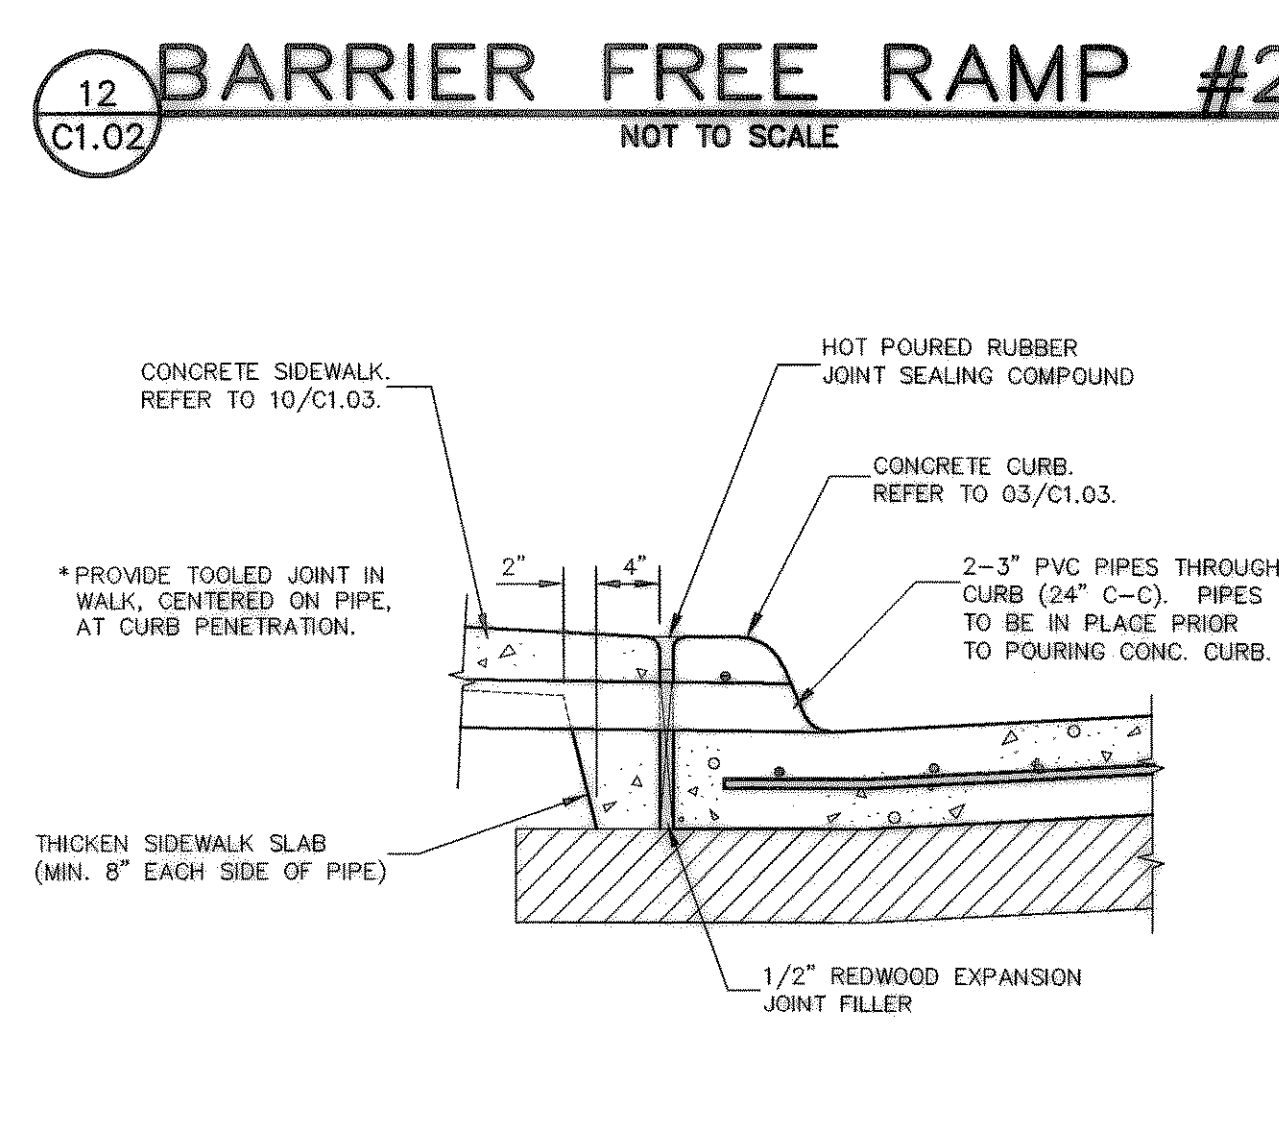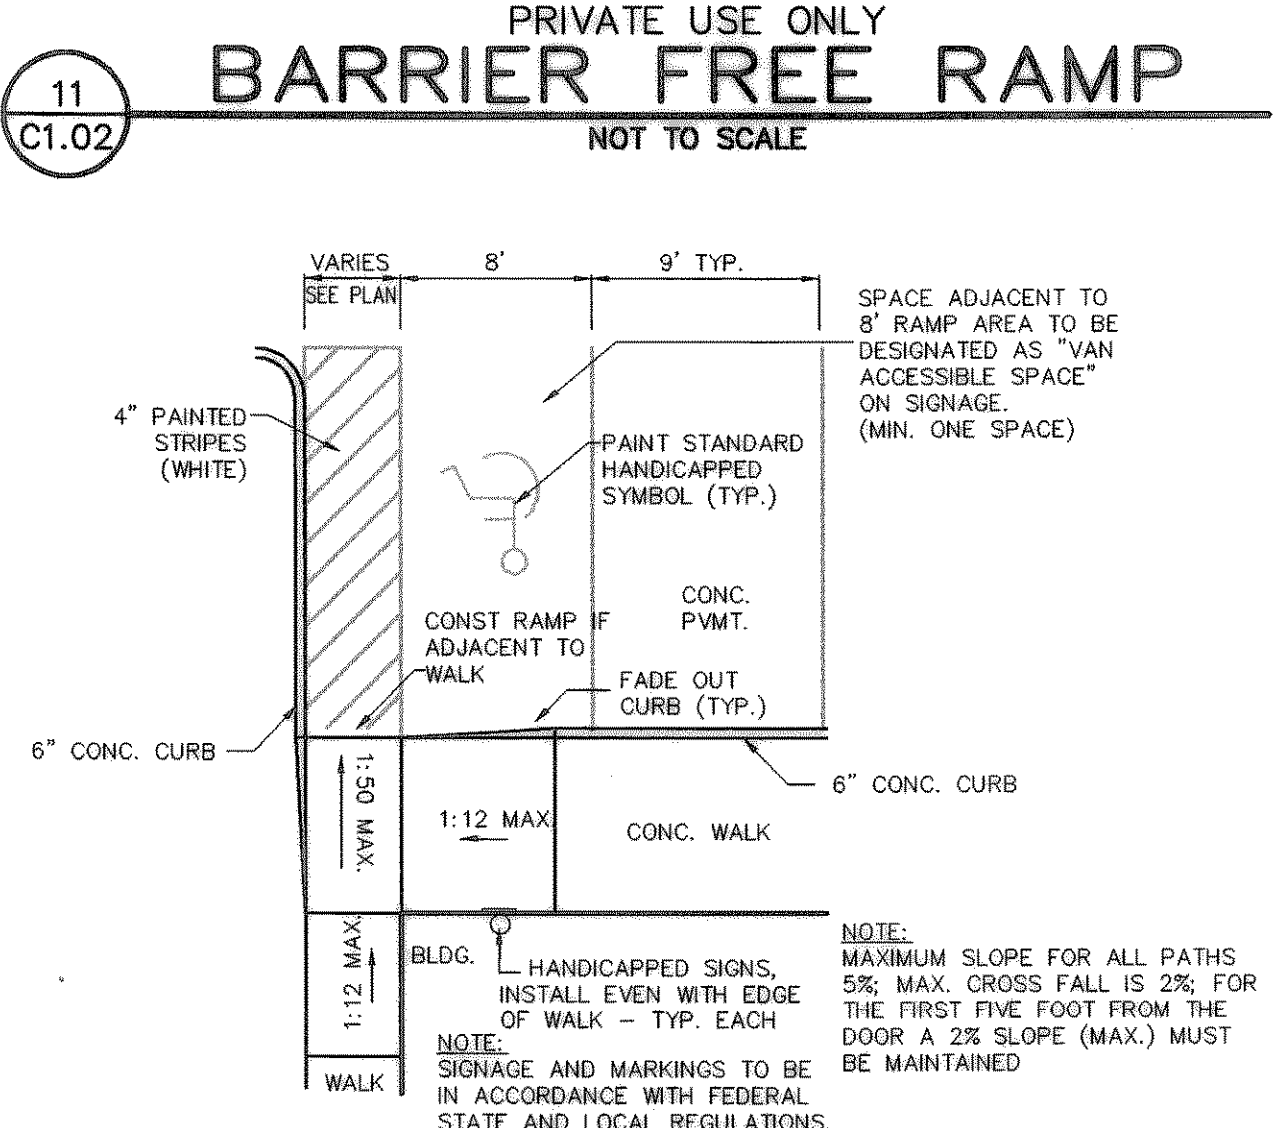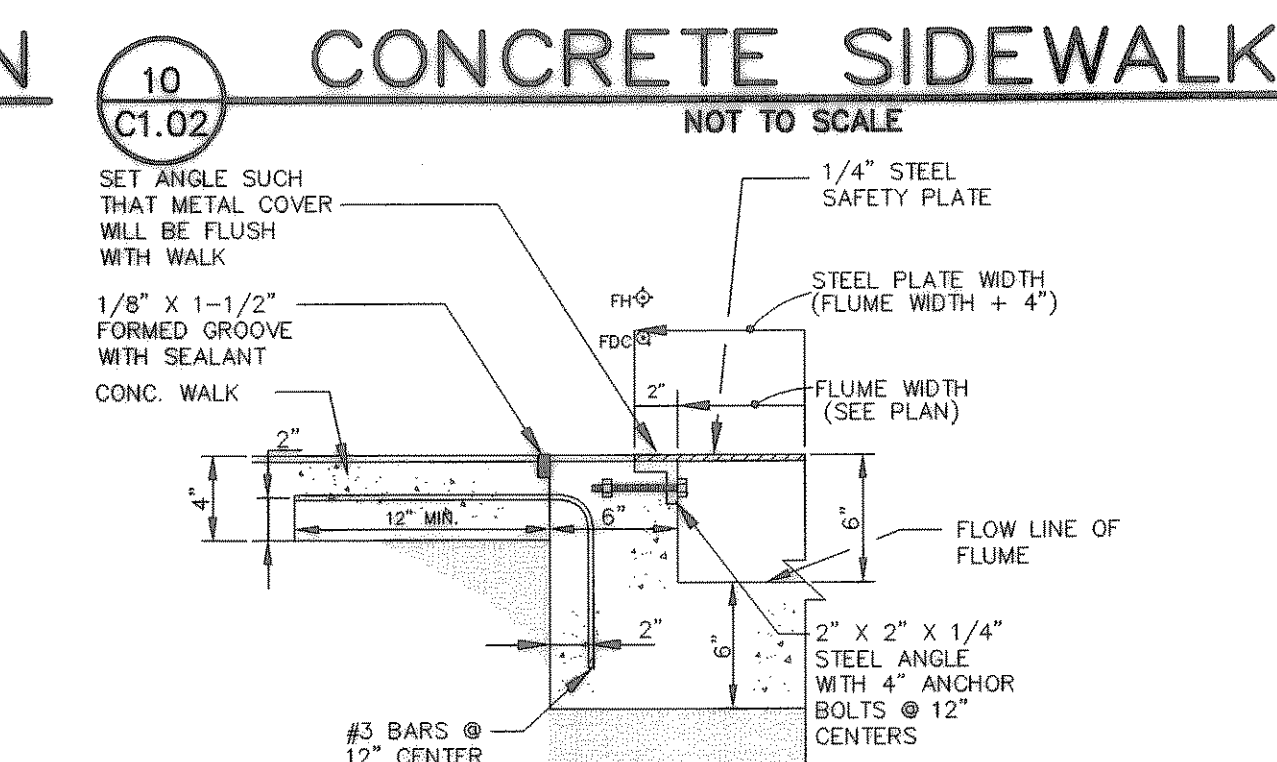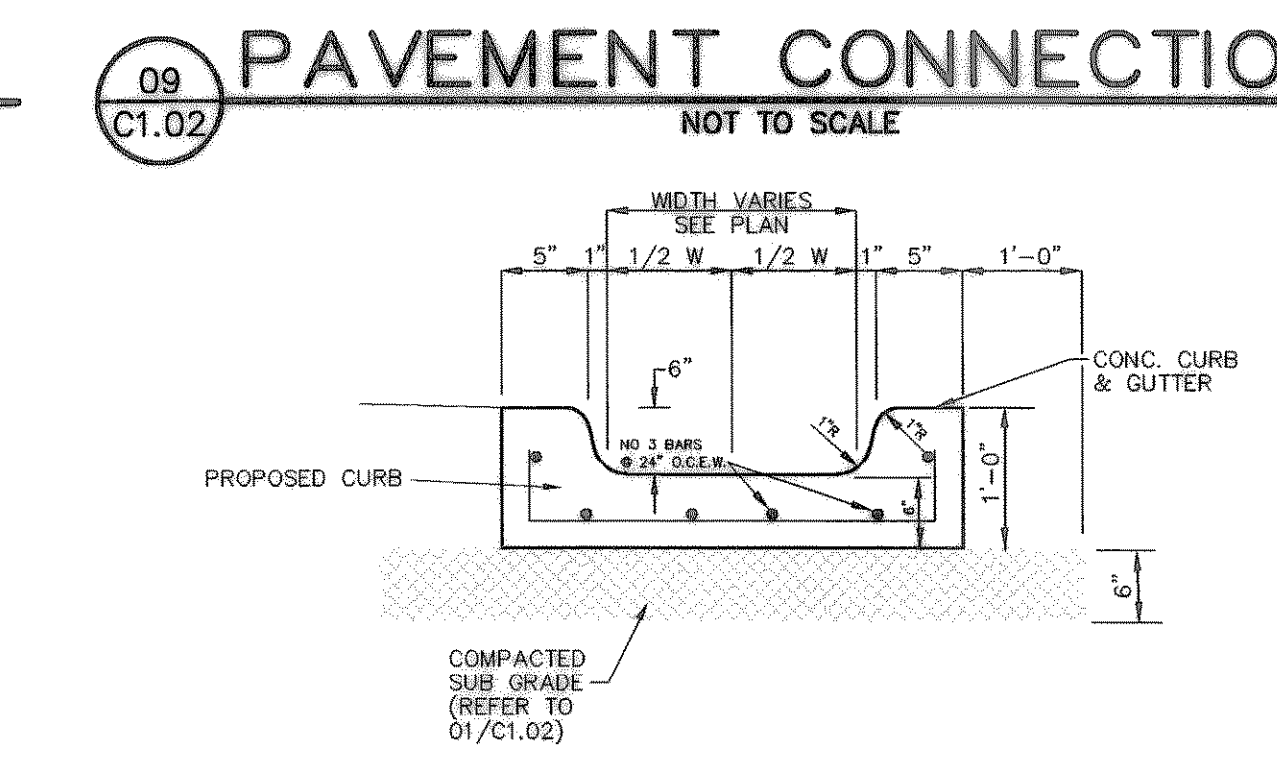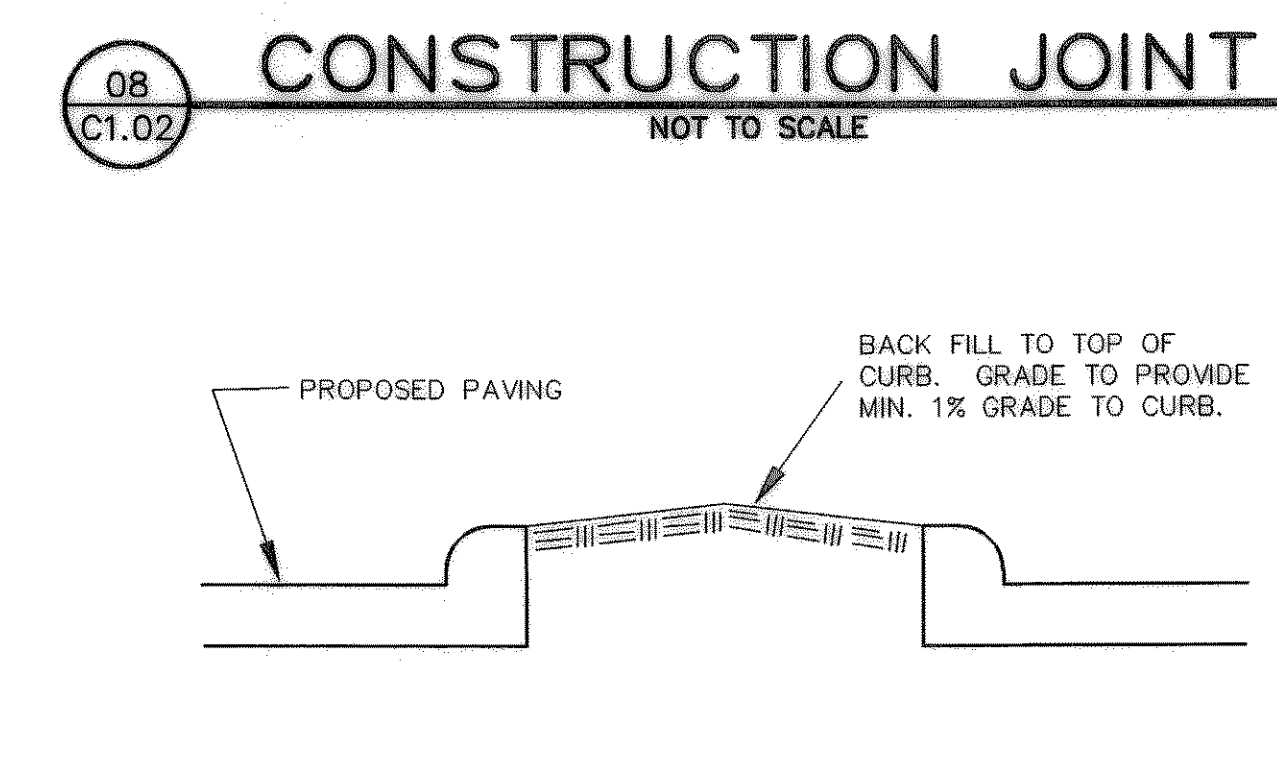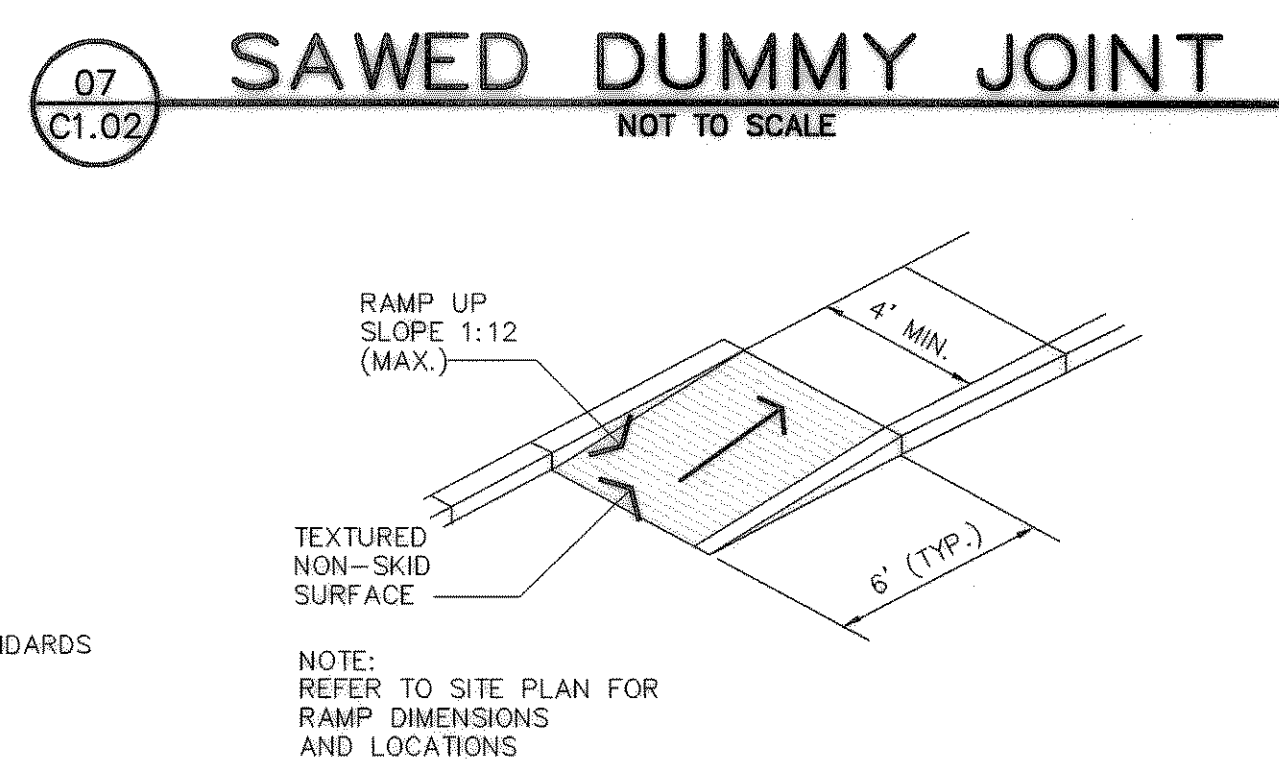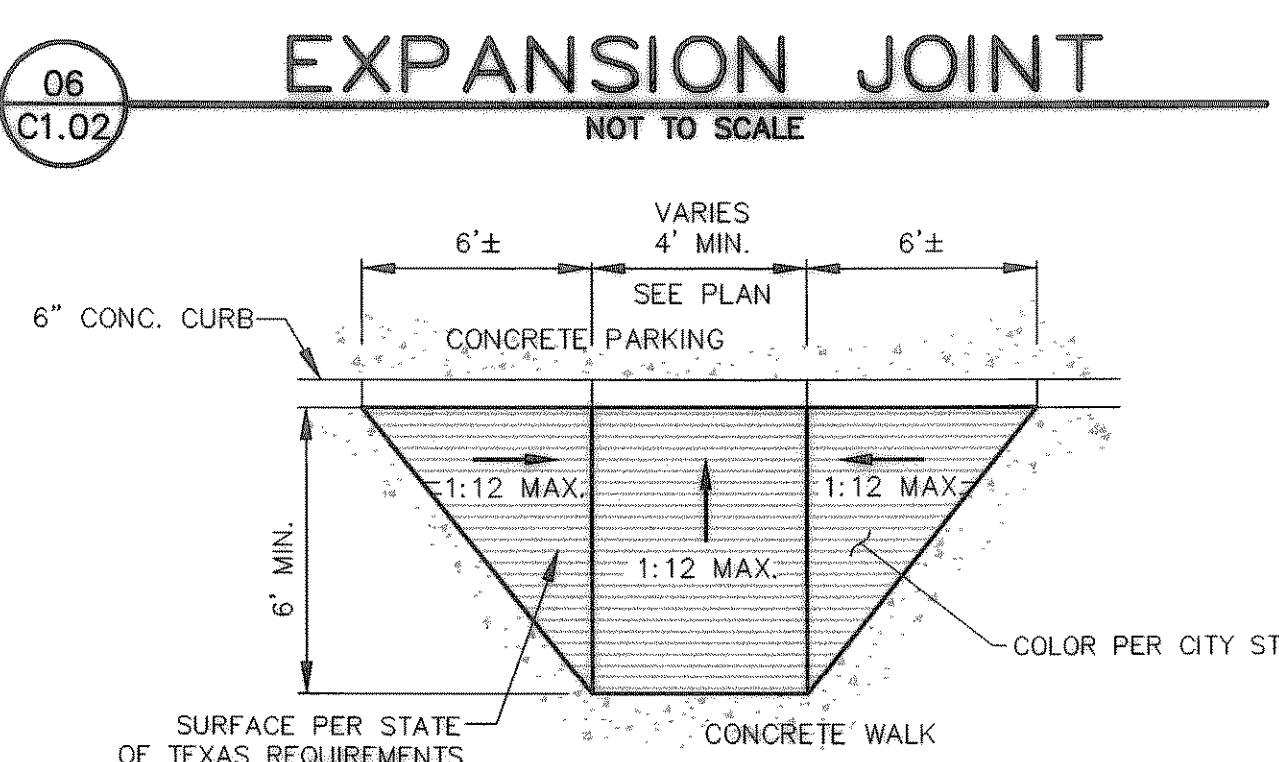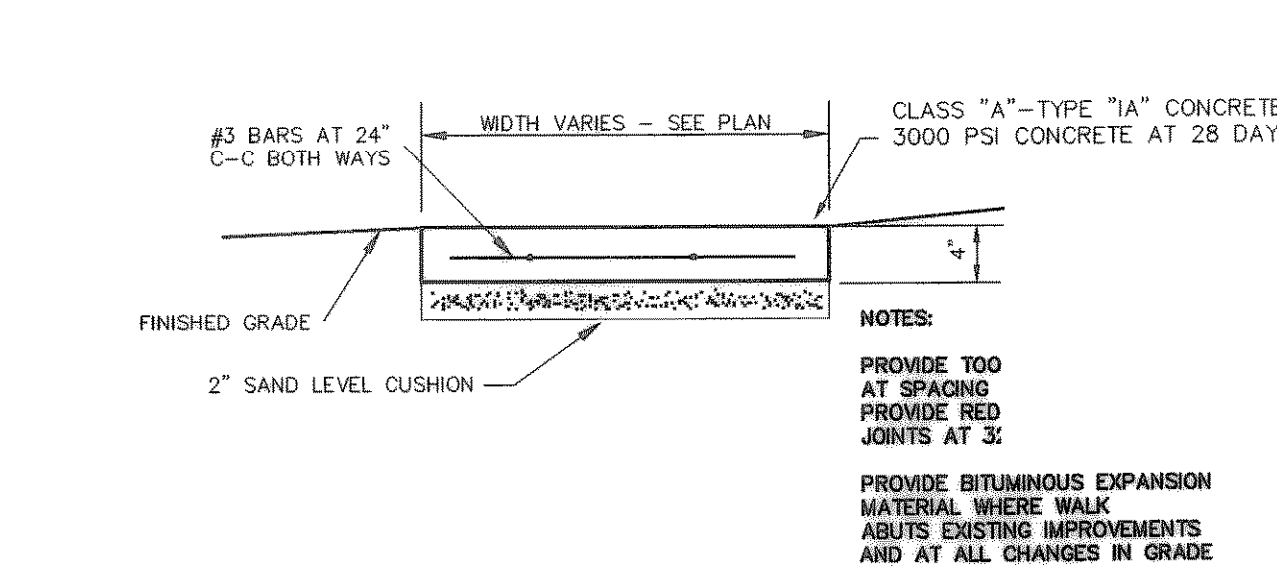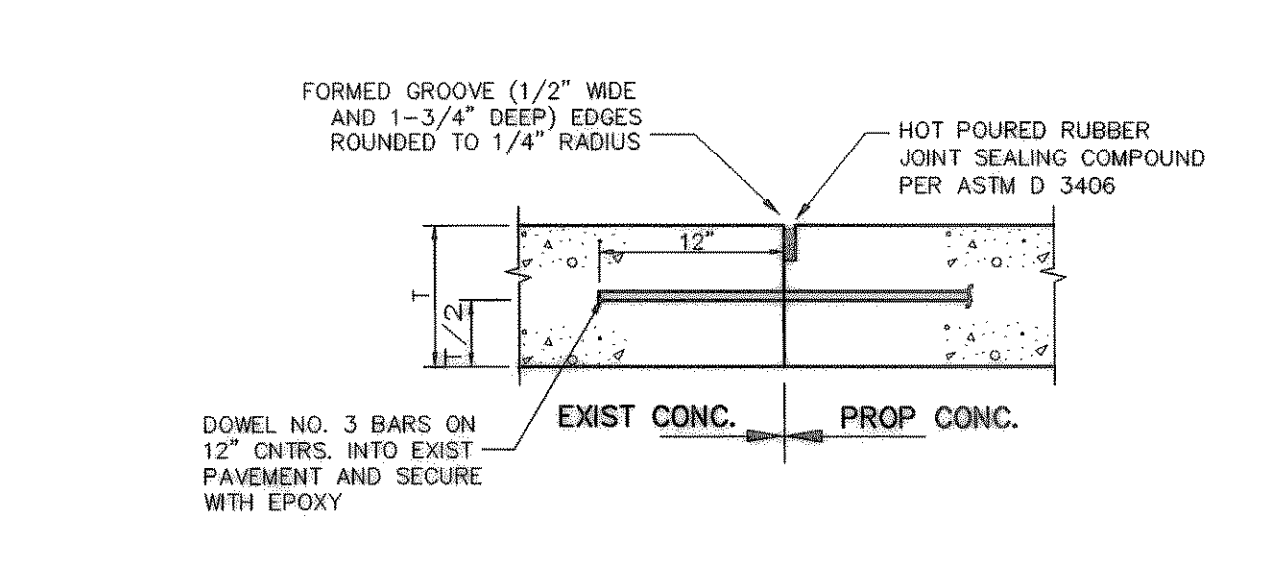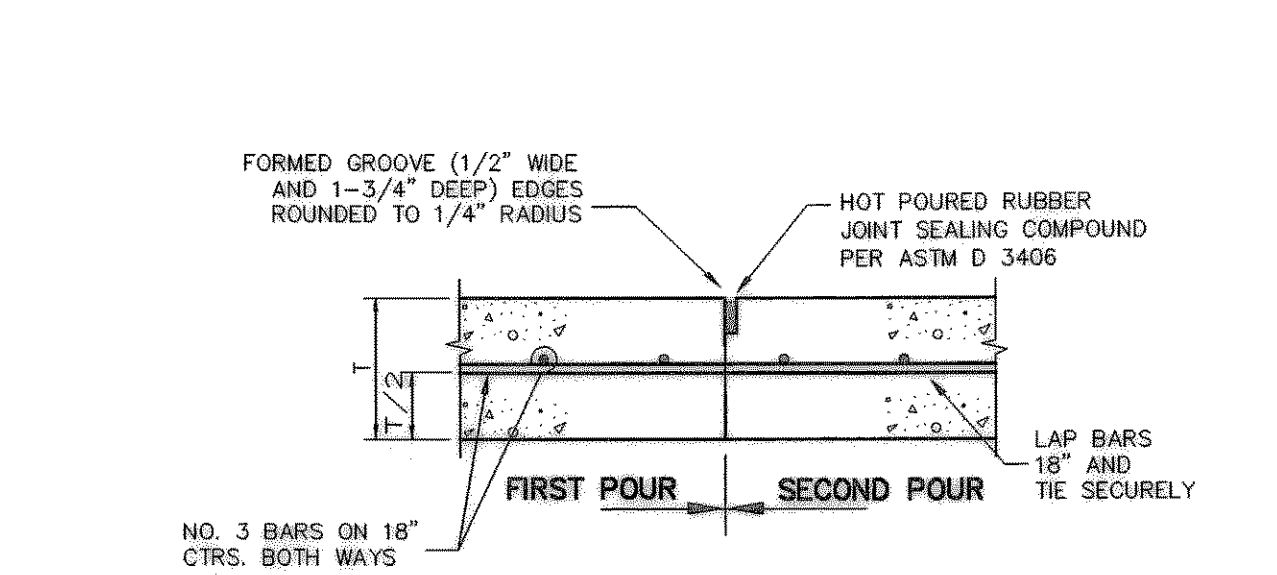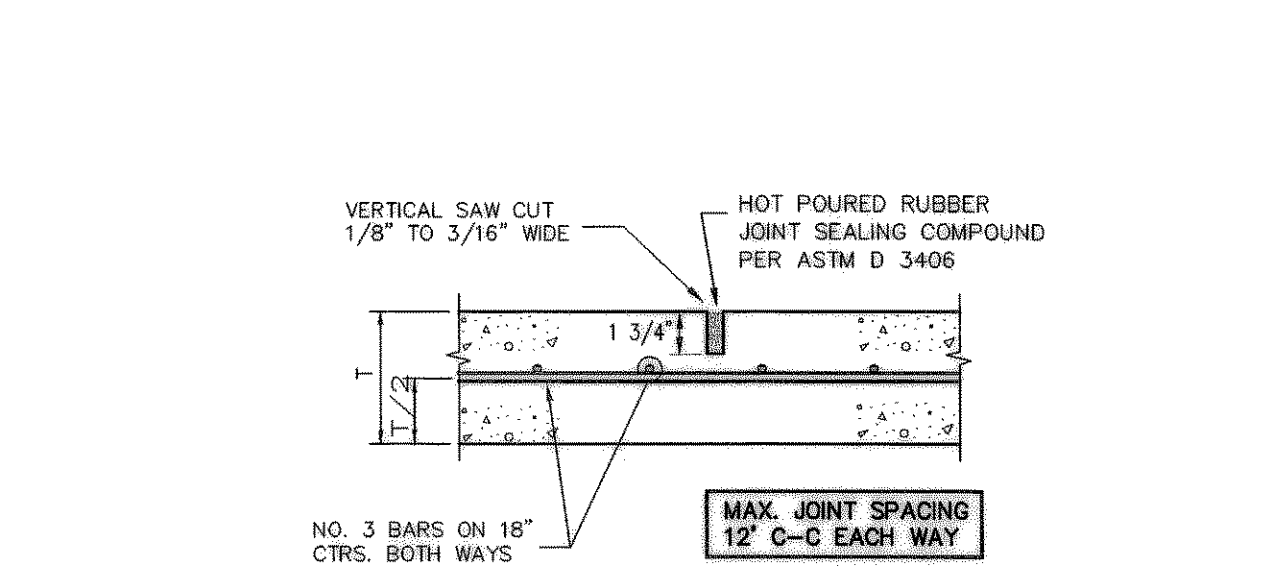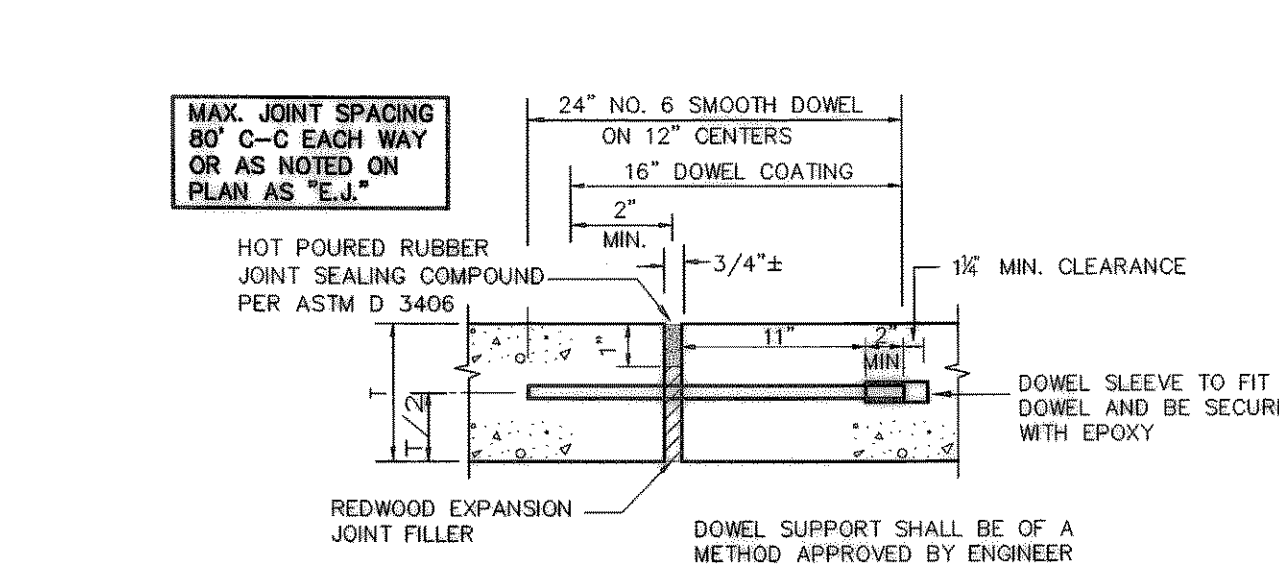

**20 NOT USED**  
 C1.02 NOT TO SCALE

**21 NOT USED**  
 C1.02 NOT TO SCALE

**RECORD DRAWINGS:**  
 IT WAS THE INTENT THAT THE IMPROVEMENTS SHOWN BE CONSTRUCTED ACCORDING TO THESE PLANS AS APPROVED BY THE CITY. THE LINES AND GRADES WERE SET ON THE GROUND FOR CONSTRUCTION ACCORDING TO SAID PLANS. THE CITY INSPECTED THE CONSTRUCTION. THE ENGINEER DID NOT VERIFY LINES OR GRADES AFTER CONSTRUCTION. WE ARE NOT AWARE OF ANY CHANGES OR REVISIONS TO THESE PLANS DURING CONSTRUCTION OTHER THAN THOSE SHOWN.

RANDALL P. POGUE, P.E. DATE: DECEMBER 4, 2003  
 TX LIC. NO. 84780


NO.	DATE	REVISION / DESCRIPTION
4	8-19-03	COORDINATION
1	5-21-03	REVISED PER CITY COMMENTS

DESIGN	DRAWN	DATE	SCALE	NOTES
RPP	EMS	4-24-03	AS SHOWN	-

**PROJECT INFORMATION**  
 BANK OF AMERICA  
 SEC HORIZON ROAD (FM 3097) @ RIDGE ROAD (FM 740)  
 CITY OF ROCKWALL, TEXAS  
 LOT 5R, BLOCK A  
 HORIZON RIDGE ADDITION  
 E. TEAL SURVEY, ABSTRACT No. 207

**ARCHITECT**  
 THE SAMUEL GROUP  
 2906 MAPLE AVENUE, SUITE 202  
 DALLAS, TEXAS 75201  
 MR. ELLIOTT BAIRD  
 (214) 922-8012 PHONE  
 (214) 922-9689 FAX

THE SEAL APPEARING ON THIS DOCUMENT WAS AUTHORIZED BY RANDALL P. POGUE, P.E. BASED ON 4-24-03 ALTERATION OF A SEALED DOCUMENT WITHOUT PROPER NOTIFICATION TO THE RESPONSIBLE ENGINEER IS AN OFFENSE UNDER THE TEXAS ENGINEERING PRACTICE ACT.

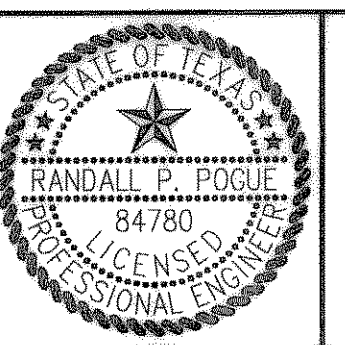

**POGUE**  
 ENGINEERING & DEVELOPMENT COMPANY, INC.

2111 ELDRADO PARKWAY  
 SUITE 101  
 MCKINNEY, TEXAS 75070

(214) 544-8880 PHONE  
 (214) 544-8882 FAX  
 randypogue@texoma.net

**STANDARD DETAILS SHEET**  
 BANK OF AMERICA  
 1.0775 ACRES  
 LOT 5R, BLOCK A, HORIZON RIDGE ADDITION  
 CITY OF ROCKWALL, TEXAS

SHEET NO. C1.02