

BRENT L. MURPHREE  
97318  
PROFESSIONAL ENGINEER  
1-20-14

MEP Engineering  
Telios Corporation  
12946 Dairy Ashford, Suite 130 Sugar Land,  
Texas 77478

Structural Engineering  
ASA Global Structural Engineers  
9800 Richmond Ave., Suite 460 Houston,  
Texas 77042

Landscape Architect  
Studio 13 Design Group  
519 Bennett Lane, Suite 203 Lewisville, TX  
75057

Civil Engineering  
DOWDEY, ANDERSON & ASSOCIATES, INC.  
5225 Village Creek Drive, Suite 200 Plano, Texas 75093  
Phone 972.931.0694 Fax 972.919.5358  
STATE REGISTRATION NUMBER: F-399



| No. | Date       | Description       |
|-----|------------|-------------------|
| 1   | 9/29/2012  | ISSUED FOR REVIEW |
| 2   | 10/1/2012  | ISSUED FOR REVIEW |
| 3   | 10/1/2012  | ISSUED FOR REVIEW |
| 4   | 11/19/2012 | ISSUED FOR REVIEW |
| A   | 01/30/2013 | PR 01             |
| A   | 01/20/2014 | RECORD DRAWINGS   |

## Emerus Emergency Hospital - Rockwall

**EMERUS**  
ADVANCED EMERGENCY CARE

Interstate Highway 30 and T.L. Townsend Drive  
Rockwall, TX 75087

## Pond Plan & Calculations

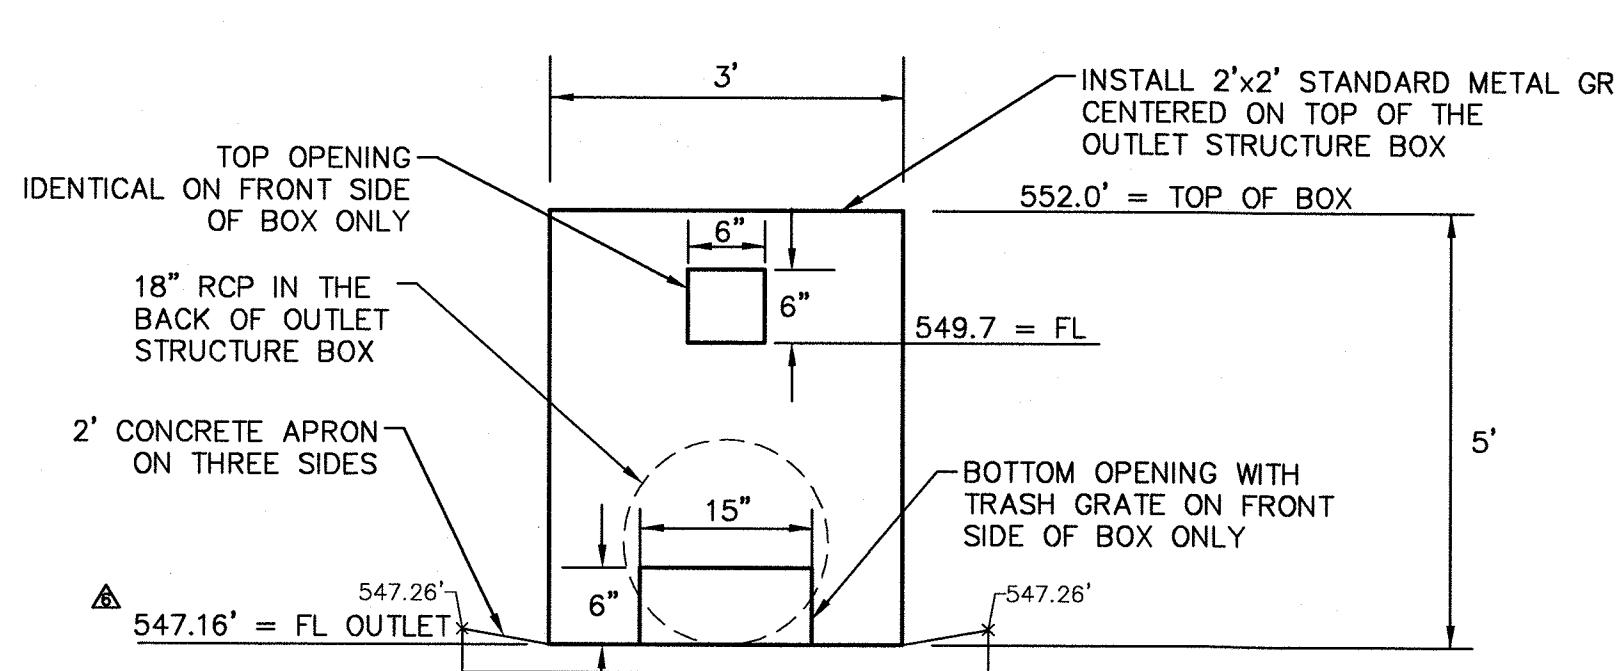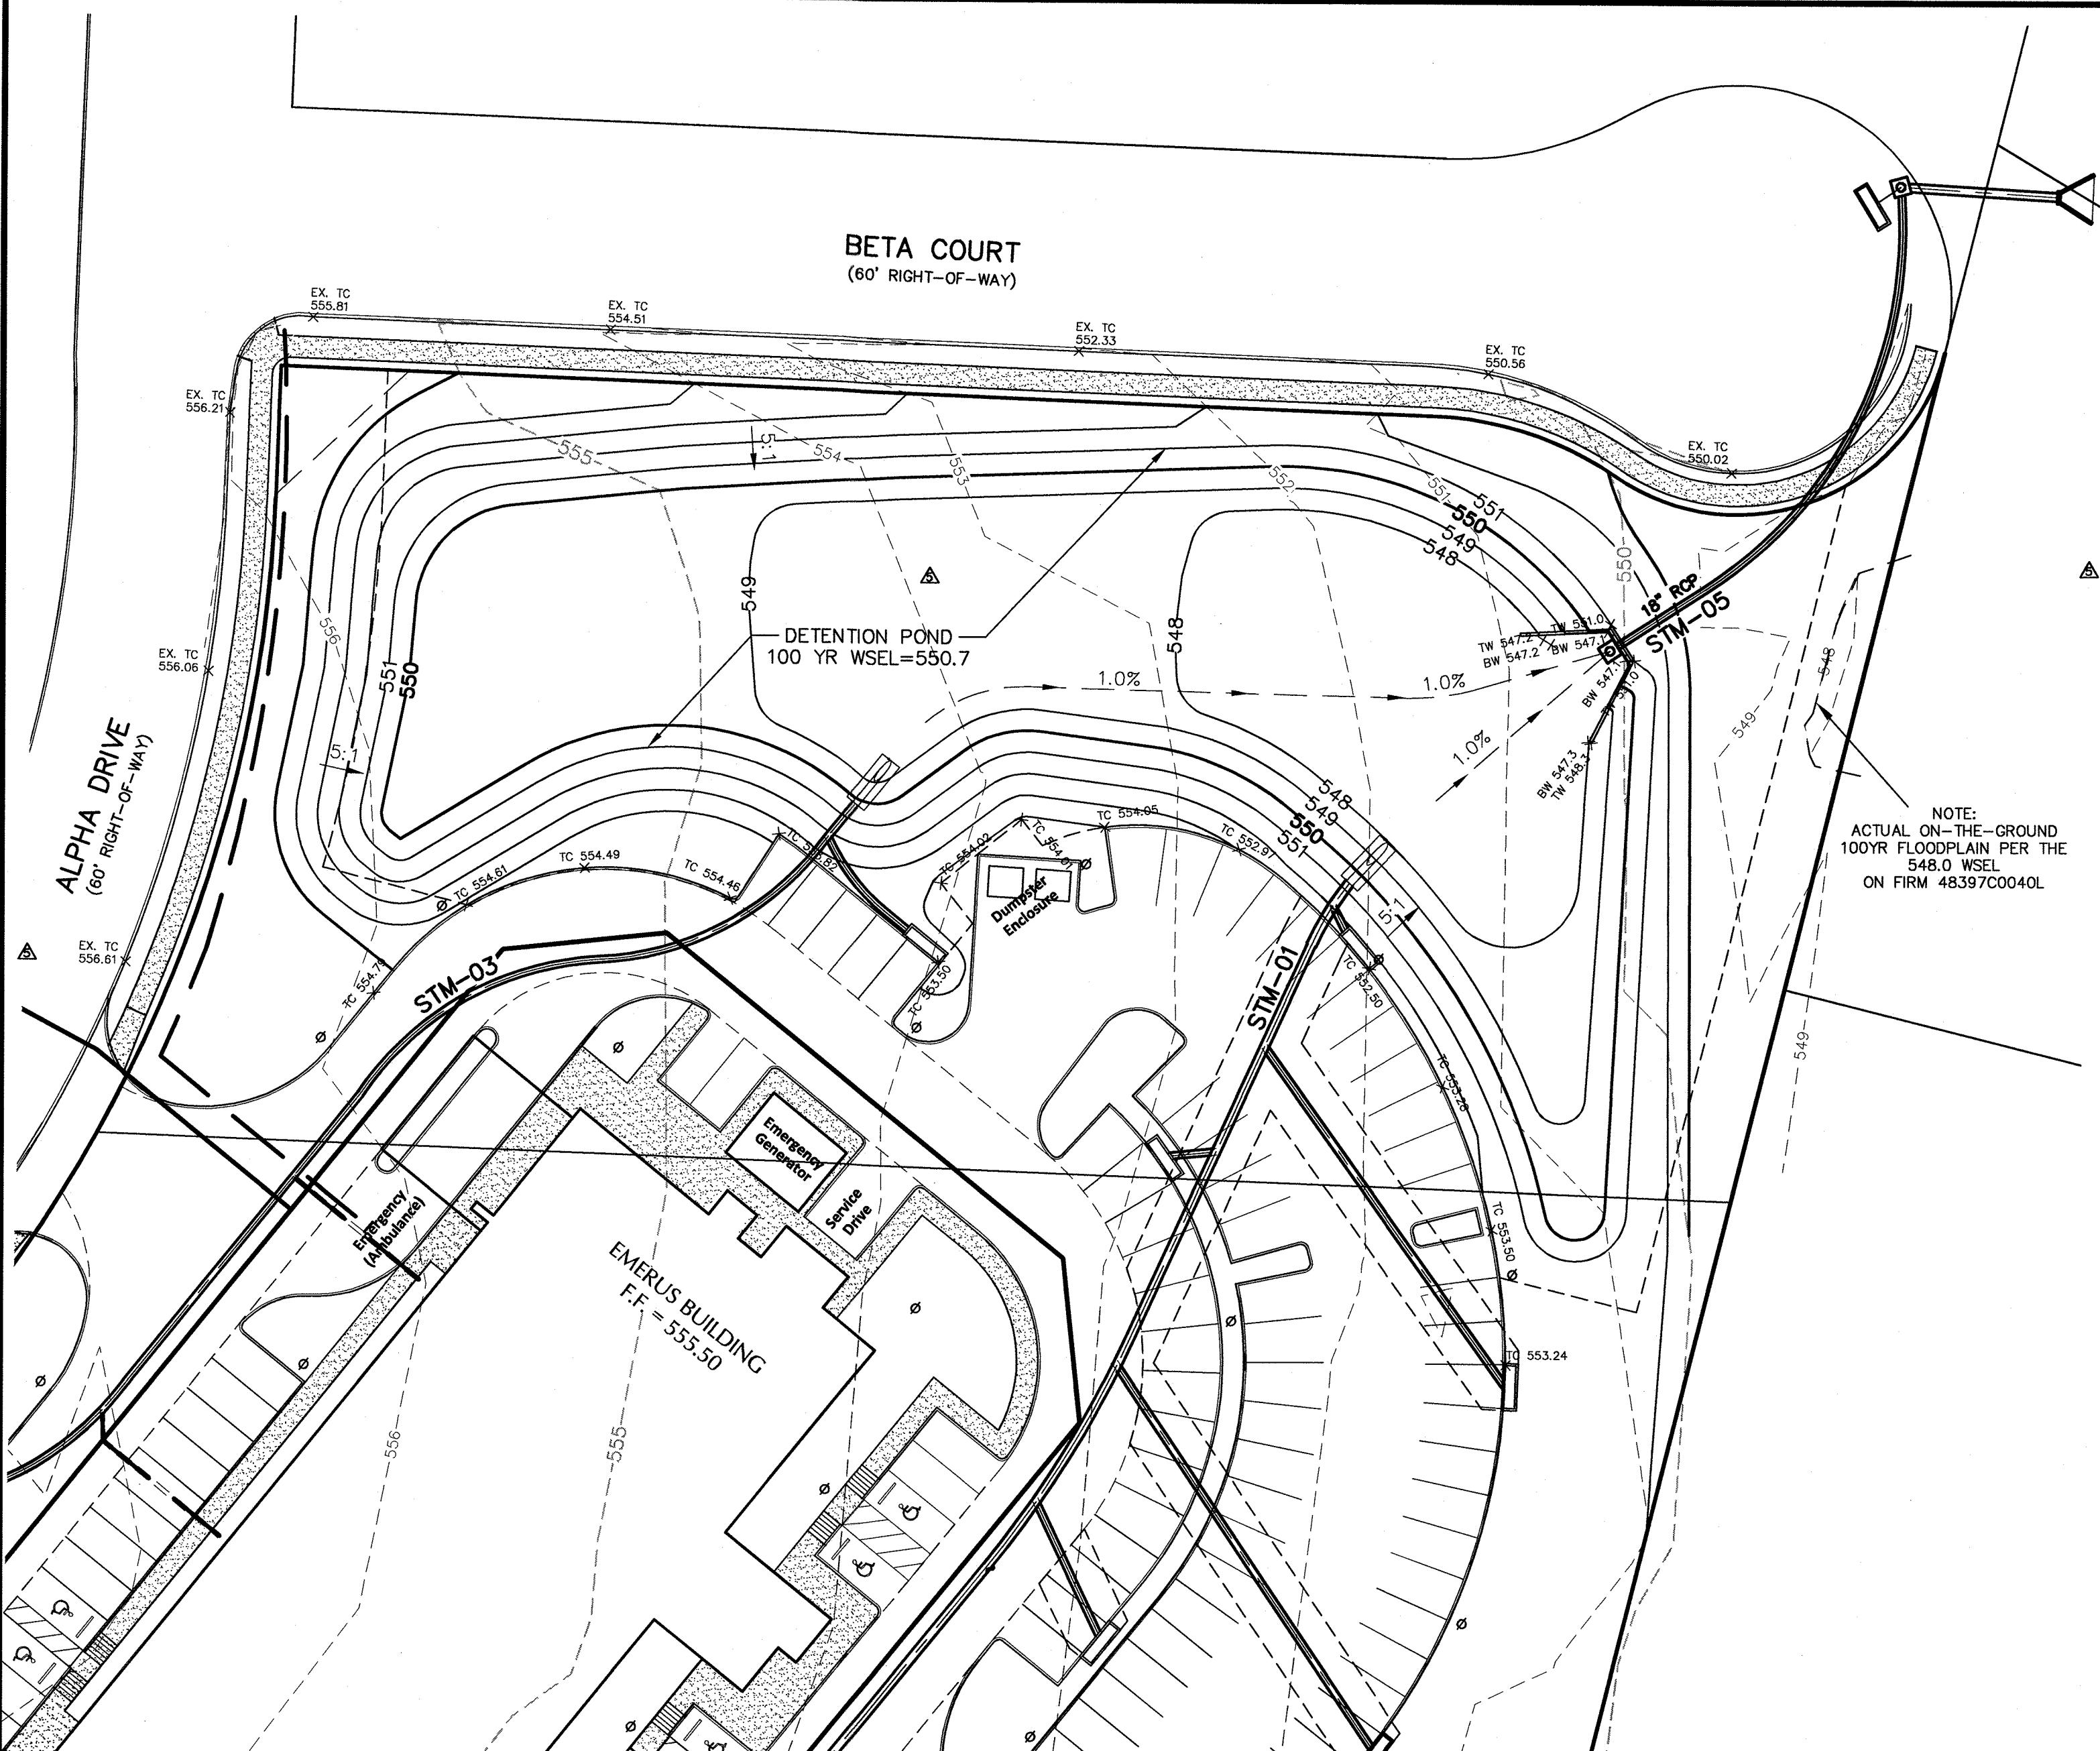


### DETENTION POND CALCULATION NOTES:

- EXISTING CONDITIONS GENERATE 12.2 CFS OF RUNOFF. PER THE DRAINAGE AREA MAP, 3.8 CFS (0.43AC) OF FULLY DEVELOPED FLOW WILL BYPASS THE POND. THIS YIELDS 12.2 - 3.8 = 8.4 CFS ALLOWABLE RELEASE.
- AS CAN BE SEEN IN THE MODIFIED RATIONAL DETENTION TABLE, THE MINIMUM REQUIRED 100 YR DETENTION VOLUME PER THE CALCULATION TABLE SHOWN IS 0.90 AC-FT WITH AN ALLOWABLE RELEASE RATE OF 8.4 CFS. PER THE STAGE-STORAGE-DISCHARGE TABLE ABOVE, THERE IS 1.05 AC-FT OF STORAGE PROVIDED AT THE 100YR WSEL OF 550.7. THE PEAK OUTFLOW FOR THE 100-YR STORM IS 6.24 CFS. THE 25-YR, 10-YR & 5-YR STORMS WERE ALSO DETAILED BACK TO PRE-DEVELOPED FLOWS.
- COMPARING THE MODIFIED RATIONAL VOLUME CALCULATION TABLE RESULTS WITH THE STAGE-STORAGE-DISCHARGE TABLE ABOVE, CONFIRMS THAT THE MINIMUM AMOUNT OF REQUIRED DETENTION VOLUME HAS BEEN PROVIDED FOR THE 100YR, 25YR, 10YR & 5YR STORMS WHILE NOT EXCEEDING THE PRE-DEVELOPED ALLOWABLE RELEASE RATES.

### BENCHMARKS:

CITY OF ROCKWALL MONUMENT R003: BRASS DISK IN CONCRETE SOUTH OF STATE HIGHWAY NO. 66 AND NORTH OF J.W. WILLIAMS MIDDLE SCHOOL, APPROXIMATELY 21' WEST OF A CORNER BACK OF CURB AND APPROXIMATELY 53.5' SOUTHWEST OF AN 8D NAIL IN SHINER IN POWER POLE.  
ELEVATION = 529.23' (FIELD) HOLD\* 529.23' (RECORD)

CITY OF ROCKWALL MONUMENT R005: BRASS DISK IN CONCRETE IN GRASS MEDIAN AT INTERSECTION OF FARM TO MARKET ROAD NO. 740 (RIDGE ROAD) AND SUMMIT RIDGE DRIVE, APPROXIMATELY 14' NORTHWEST OF A FIRE HYDRANT AND APPROXIMATELY 10' WEST OF A STREET SIGN.  
ELEVATION = 578.71' (RECORD) 578.63' (FIELD)

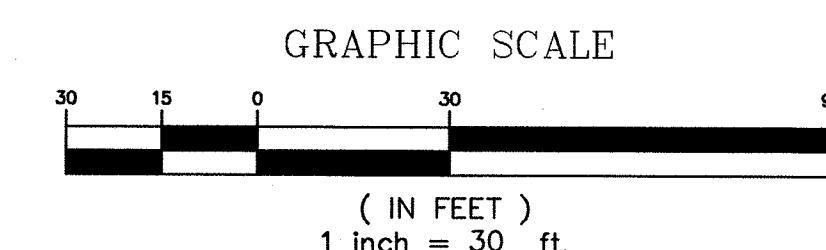

Emurus Rockwall  
Detention Pond  
DAA Job No. 12005  
Rockwall, Texas

### 100 Year Modified Rational Detention Calculations

Calculations for Proposed Detention Area K (100 year)= 1

Present Conditions

T<sub>r</sub> (min) I<sub>s</sub> (in/hr) Weighted C A (ac.) Q<sub>ac</sub> (cfs)

20 8.30 0.35 4.19 8.4

\*12.2 cfs minus 3.8 cfs (0.43ac) of bypass flow equals 8.4 cfs allowable release

Future Conditions

T<sub>r</sub> (min) I<sub>s</sub> (in/hr) Weighted C A (ac.) Q<sub>ac</sub> (cfs)

10 9.80 0.9 3.76 33.2

Check Various Storm Durations

Time (min) I<sub>s</sub> (in/hr) C A (ac.) Q<sub>ac</sub> (cfs)

10 9.80 0.9 3.76 33.2

15 9.00 0.9 3.76 30.5

20 8.30 0.9 3.76 28.1

30 7.50 0.9 3.76 23.3

40 6.70 0.9 3.76 19.6

50 6.00 0.9 3.76 16.9

60 5.40 0.9 3.76 15.2

70 4.80 0.9 3.76 13.5

80 4.20 0.9 3.76 12.5

90 3.50 0.9 3.76 11.8

100 3.40 0.9 3.76 11.5

120 3.20 0.9 3.76 10.1

150 2.90 0.9 3.76 8.0

180 2.50 0.9 3.76 5.6

210 2.10 0.9 3.76 4.1

Check Various Storm Durations

Time (min) I<sub>s</sub> (in/hr) C A (ac.) Q<sub>ac</sub> (cfs)

10 9.50 0.9 3.76 22.2

15 8.60 0.9 3.76 19.8

20 7.70 0.9 3.76 16.8

30 6.90 0.9 3.76 13.5

40 6.10 0.9 3.76 11.8

50 5.30 0.9 3.76 10.0

60 4.60 0.9 3.76 8.6

70 3.80 0.9 3.76 7.7

80 3.10 0.9 3.76 6.3

90 2.35 0.9 3.76 5.8

100 1.60 0.9 3.76 5.4

120 1.20 0.9 3.76 4.7

150 0.90 0.9 3.76 4.0

180 0.60 0.9 3.76 3.5

210 0.30 0.9 3.76 3.1

Emurus Rockwall  
Detention Pond  
DAA Job No. 12005  
Rockwall, Texas

### 25 Year Modified Rational Detention Calculations

Calculations for Proposed Detention Area K (25 year)= 1

Present Conditions

T<sub>r</sub> (min) I<sub>s</sub> (in/hr) Weighted C A (ac.) Q<sub>ac</sub> (cfs)

20 4.92 0.35 4.19 4.7

\*8.4 cfs minus 2.9 cfs (0.43ac) of bypass flow equals 5.5 cfs allowable release

Future Conditions

T<sub>r</sub> (min) I<sub>s</sub> (in/hr) Weighted C A (ac.) Q<sub>ac</sub> (cfs)

10 7.59 0.9 3.76 22.7

Check Various Storm Durations

Time (min) I<sub>s</sub> (in/hr) C A (ac.) Q<sub>ac</sub> (cfs)

10 7.59 0.9 3.76 22.2

15 6.61 0.9 3.76 20.0

20 5.72 0.9 3.76 16.7

30 4.99 0.9 3.76 13.5

40 4.18 0.9 3.76 11.8

50 3.45 0.9 3.76 10.0

60 2.62 0.9 3.76 8.6

70 1.80 0.9 3.76 7.7

80 1.00 0.9 3.76 6.3

90 0.19 0.9 3.76 5.8

100 0.08 0.9 3.76 5.4

120 0.02 0.9 3.76 4.7

150 0.01 0.9 3.76 4.0

180 0.00 0.9 3.76 3.5

210 0.00 0.9 3.76 3.1

Emurus Rockwall  
Detention Pond  
DAA Job No. 12005  
Rockwall, Texas

### 10 Year Modified Rational Detention Calculations

Calculations for Proposed Detention Area K (10 year)= 1

Present Conditions

T<sub>r</sub> (min) I<sub>s</sub> (in/hr) Weighted C A (ac.) Q<sub>ac</sub> (cfs)

20 4.92 0.35 4.19 4.7

\*7.2 cfs minus 2.5 cfs (0.43ac) of bypass flow equals 4.7 cfs allowable release

Future Conditions

T<sub>r</sub> (min) I<sub>s</sub> (in/hr) Weighted C A (ac.) Q<sub>ac</sub> (cfs)

10 5.66 0.9 3.76 22.2

Check Various Storm Durations

Time (min) I<sub>s</sub> (in/hr) C A (ac.) Q<sub>ac</sub> (cfs)

10 5.66 0.9 3.76 22.2

15 4.77 0.9 3.76 19.8

20 4.34 0.9 3.76 16.8

30 3.49 0.9 3.76 11.8

40 2.94 0.9 3.76 10.0