


Y:\12005\12005_DIM.dwg, Layout1 (2), 1/20/2014 4:57:55 PM, bjaffe, Dowdey, Anderson & Associates, Inc., BJ

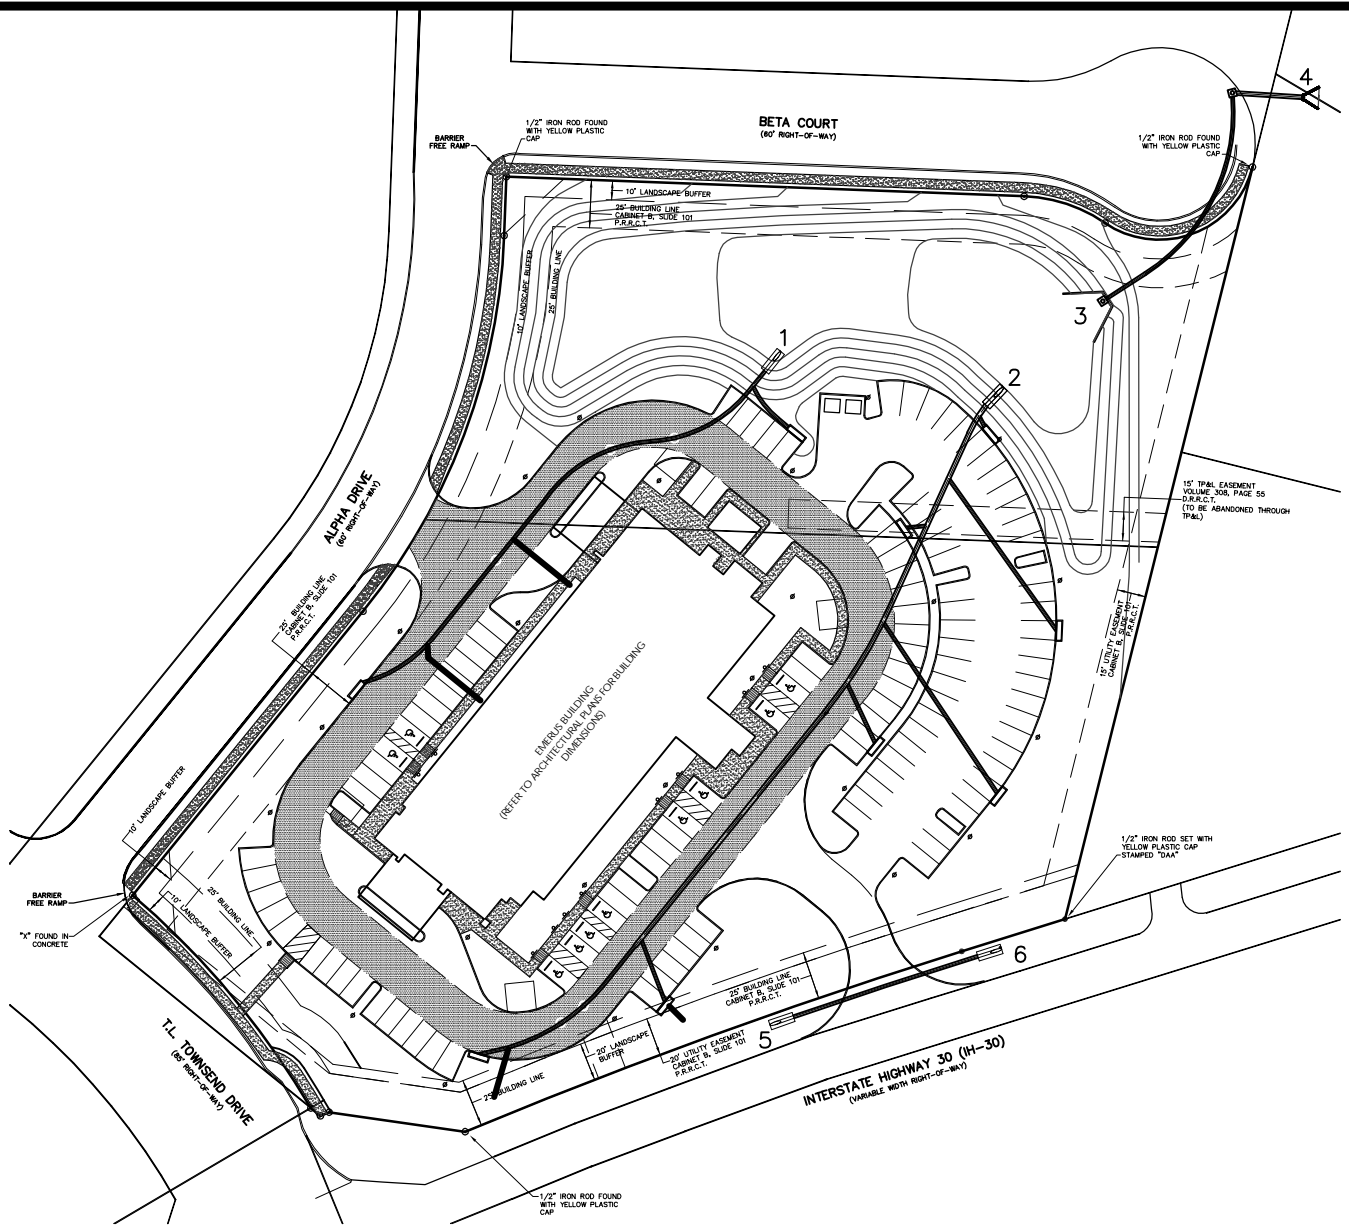

STORM SEWER OUTFALL COORDINATES TABLE			
OUTFALL #	NORTHING	EASTING	ELEVATION
1	7021869.26	2599254.61	549.16
2	7021847.19	2599365.42	548.19
3	7021899.69	2599422.98	547.16
4	7022007.49	2599530.13	543.94
5	7021526.57	2599258.17	551.58
6	7021563.12	2599369.71	550.99



DOWDEY, ANDERSON & ASSOCIATES, INC.
 5225 Village Creek Drive, Suite 200 Plano, Texas 75093
 Phone 972-931-0694 Fax 972-931-9538
 STATE REGISTRATION NUMBER: F-399

EMERUS EMERGENCY HOSPITAL – ROCKWALL