


CURVE	RADIUS	LENGTH	TANGENT	CHORD	BEARING	DELTA
C1	200.00'	97.09'	49.52'	96.14'	S79°33'11\"/>	



AS BUILT

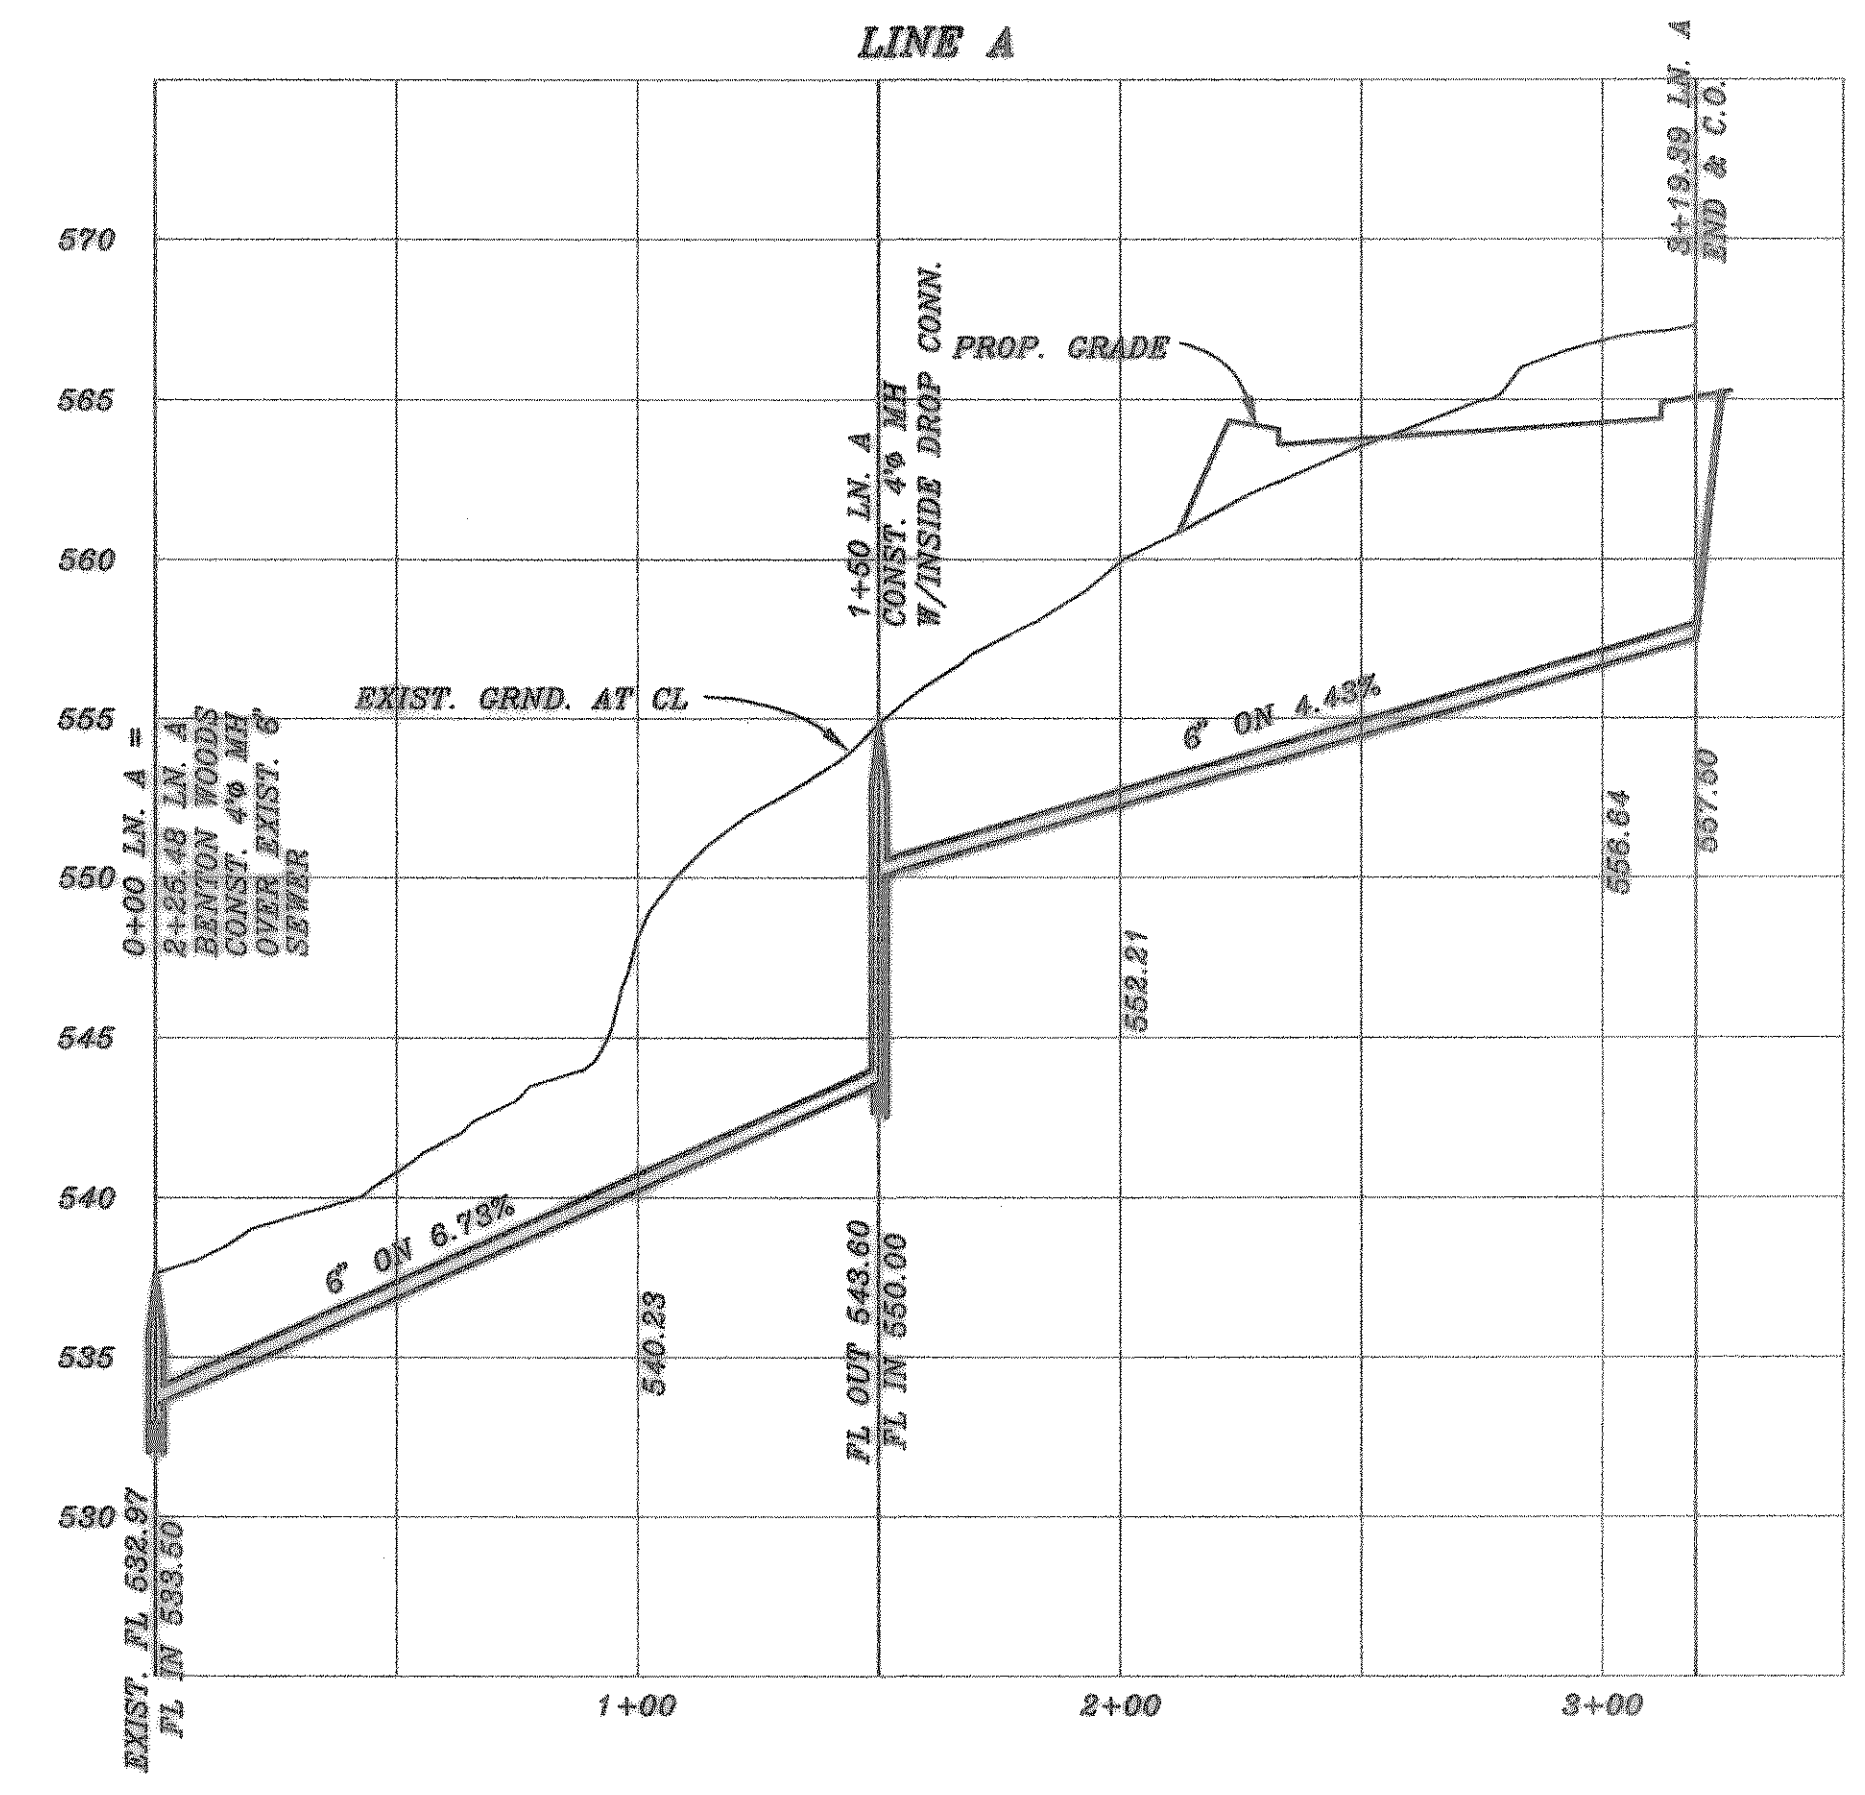

HAROLD L. EVANS CONSULTING ENGINEER P.O. BOX 28855 2331 CUS THOMASSON ROAD, SUITE 102 DALLAS, TEXAS 75228, (214) 328-8138		PROPOSED UTILITIES BENTON COURT E. TEAL SURVEY, ABSTRACT NO. 207 CITY OF ROCKWALL		SHEET NO. 5 / 6	
REV. PER CITY COMMENTS REV. PER CITY REVIEW NO. 2 REV. PER CITY REVIEW NO. 1	5/1/98 4/7/98 9/19/97	DATE 7/6/97	SCALE 1" = 40' 1" = 6'	DESIGN H.L.E.	DRAWN
REVISION DESCRIPTION 974752				JOB NO. 9747	