


AS BUILT

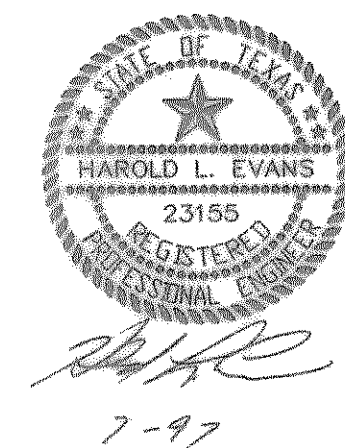

LOT GRADING AND

EROSION CONTROL PLAN

BENTON COURT

E. TEAL SURVEY, ABSTRACT NO. 207

CITY OF ROCKWALL

REV. PER CITY REVIEW NO. 1		DATE		SCALE		DESIGN		DRAWN		SHEET NO.	
		9/19/97		1" = 40'		H.L.E.				6	
HAROLD L. EVANS CONSULTING ENGINEER P.O. BOX 28985 2331 CUS THOMASSON ROAD, SUITE 102 DALLAS, TEXAS 75228, (214) 328-8133										JOB NO.	
										9747	