

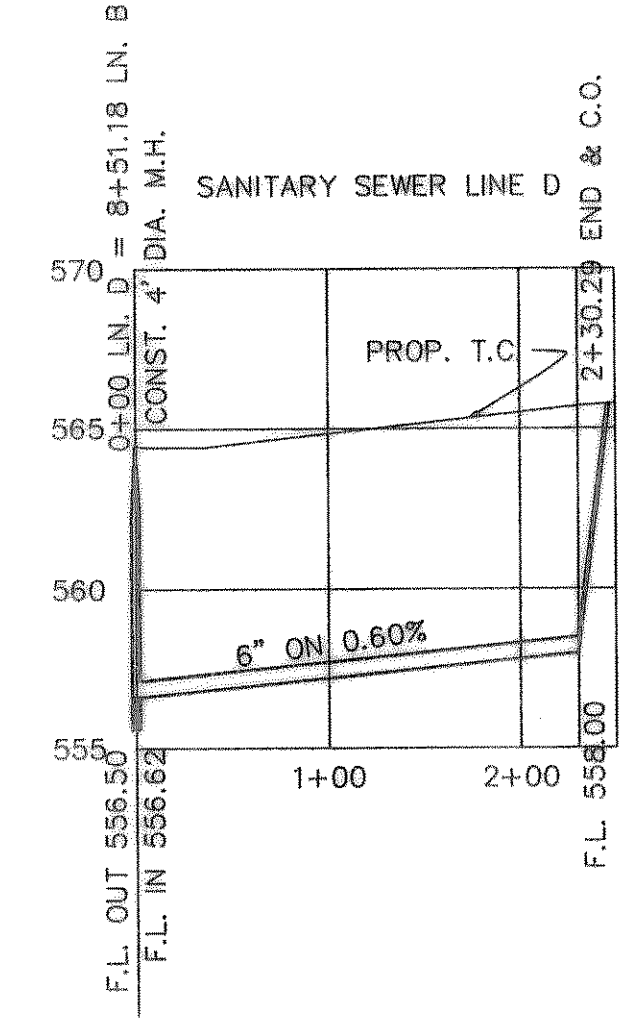
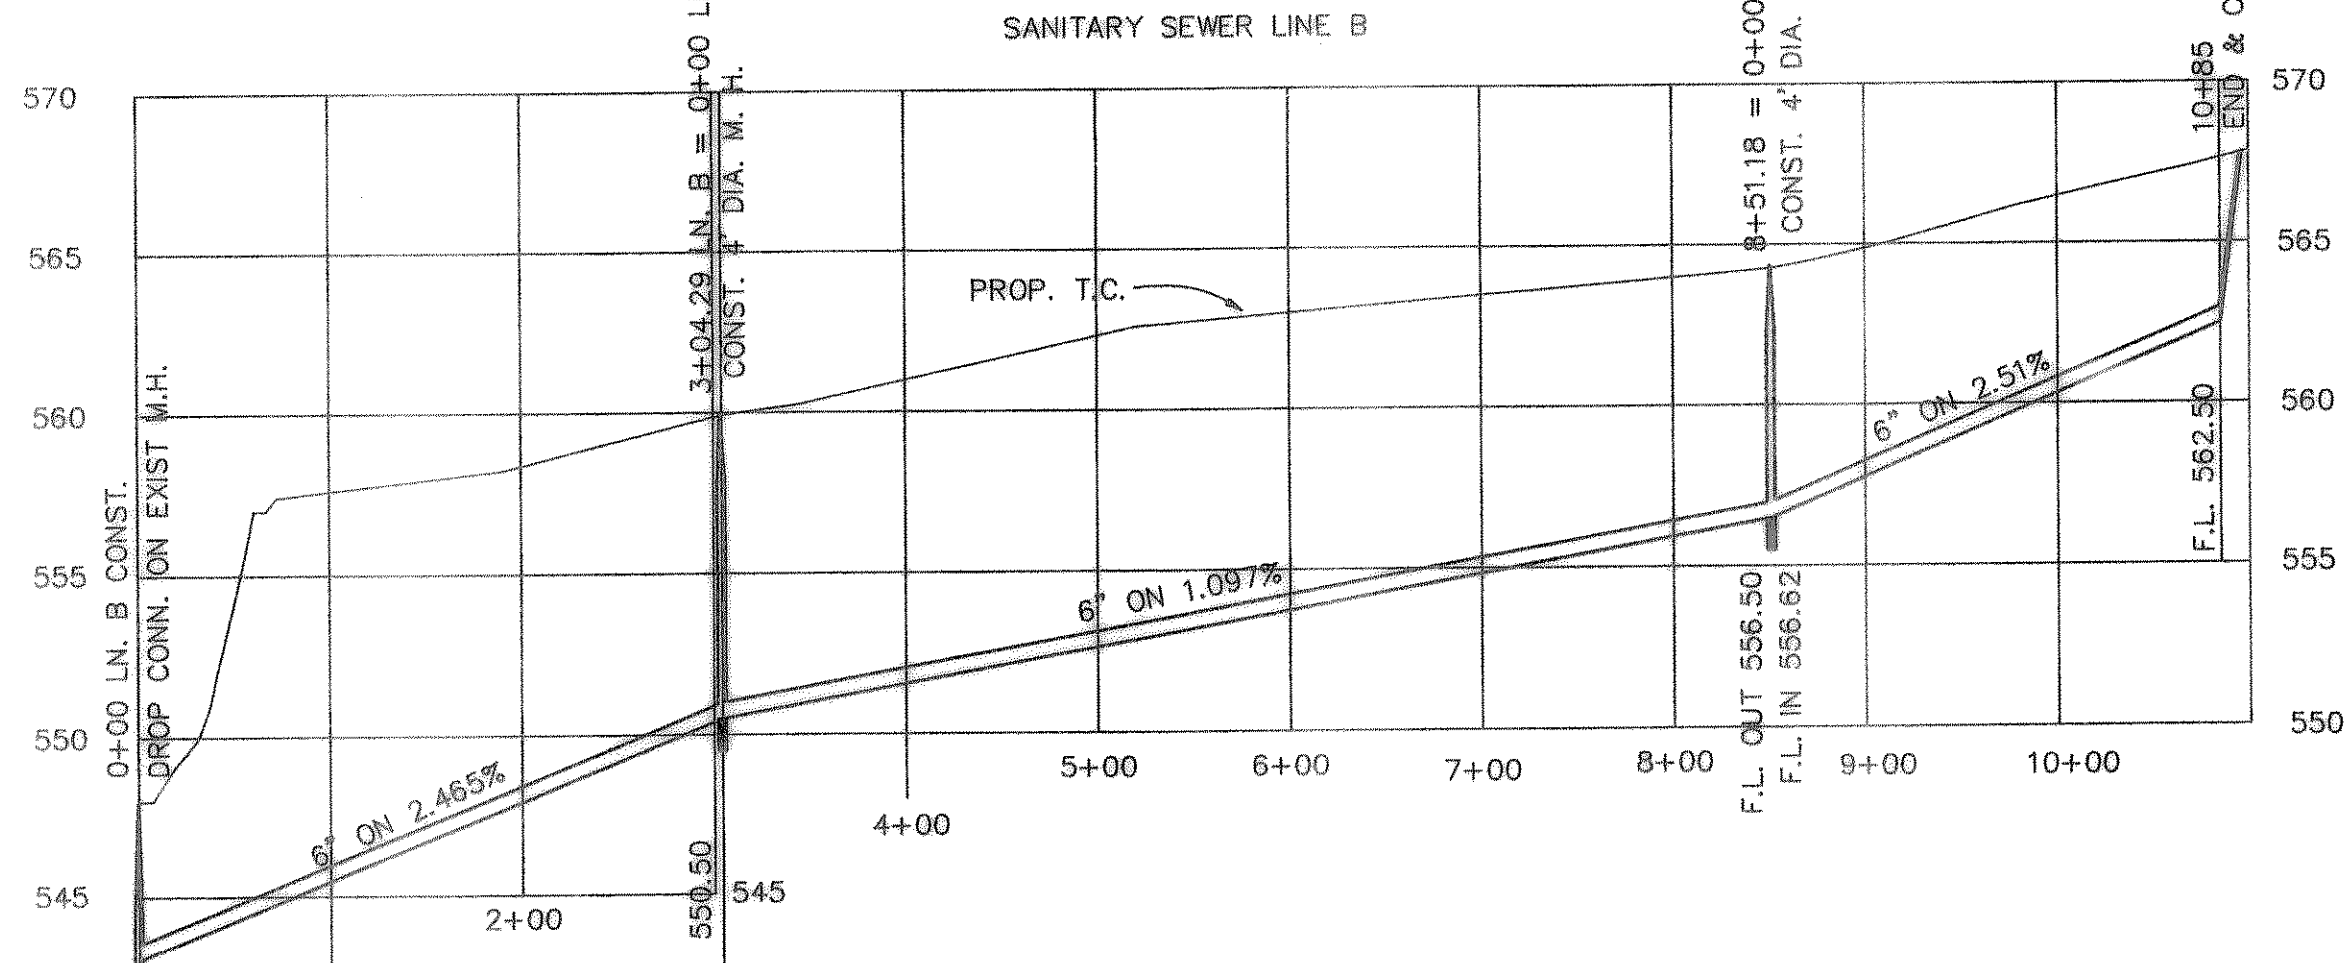
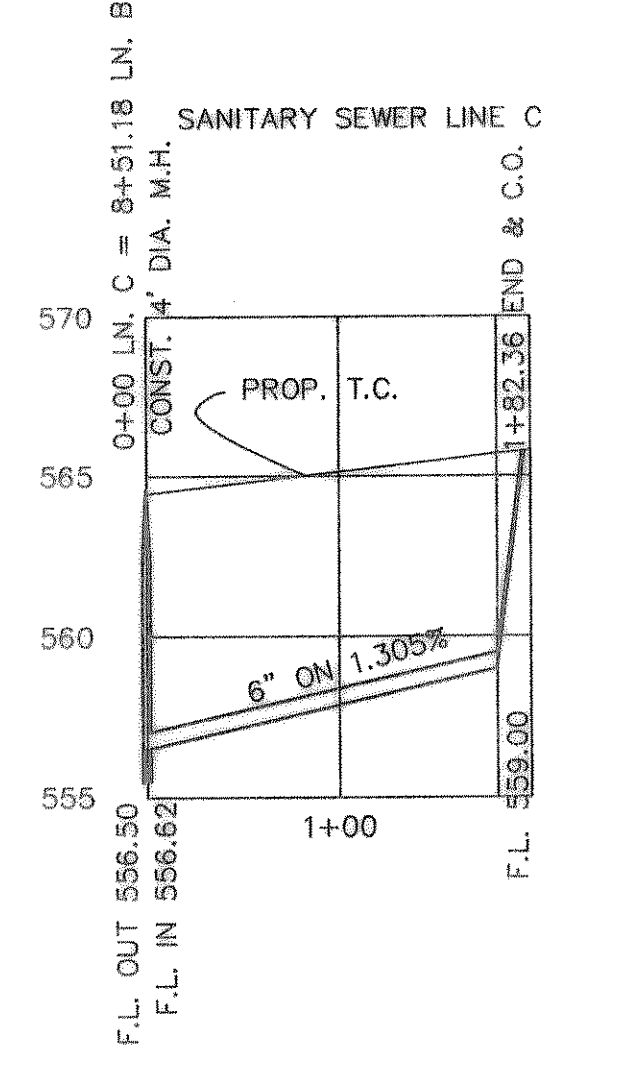
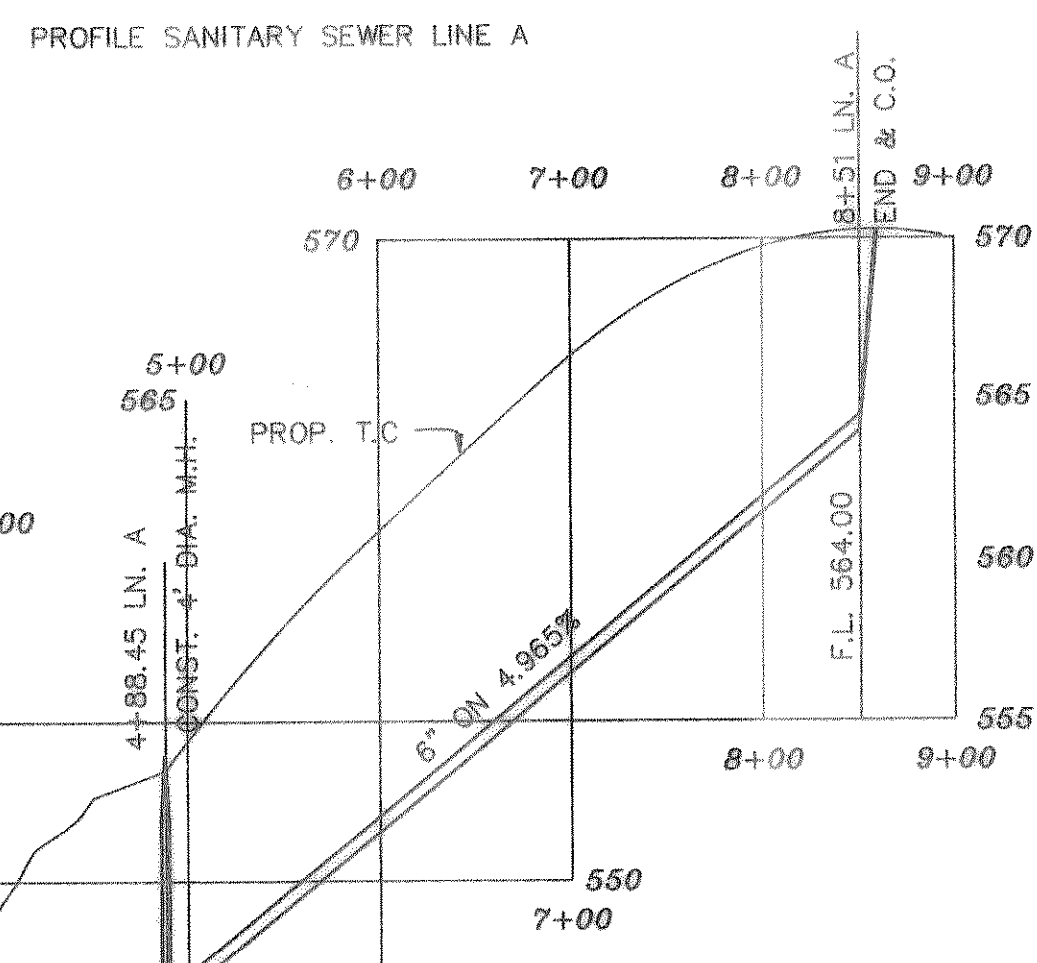
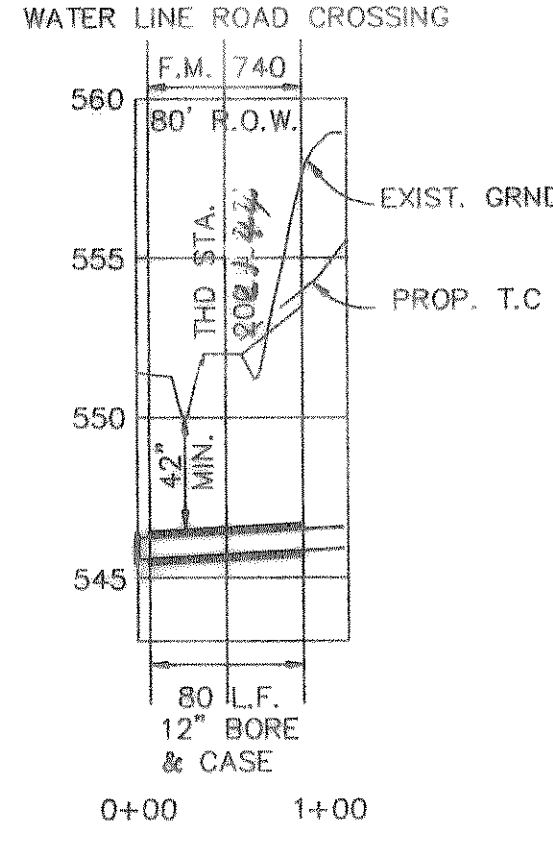
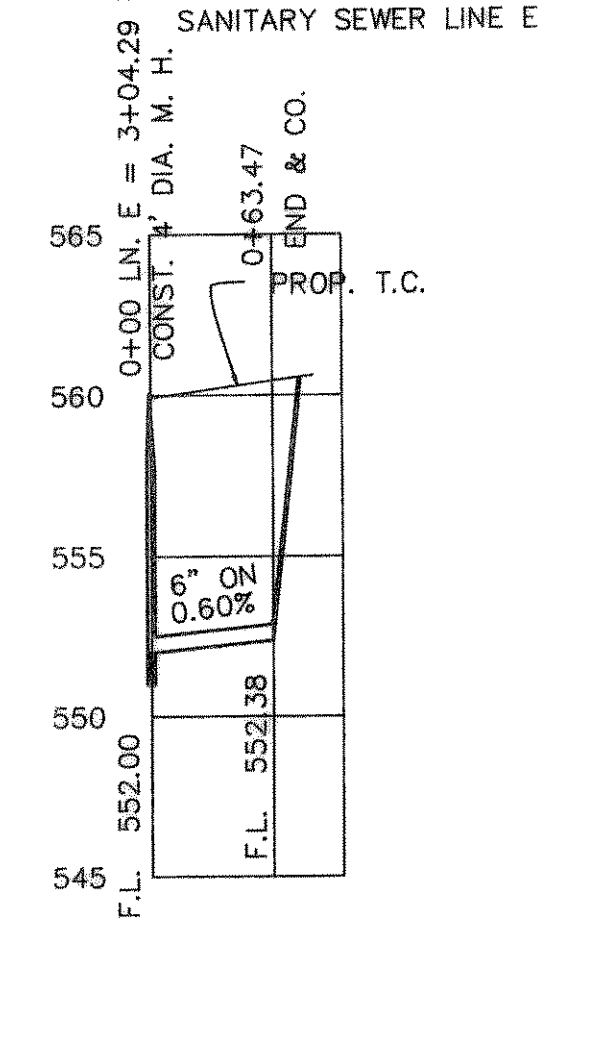
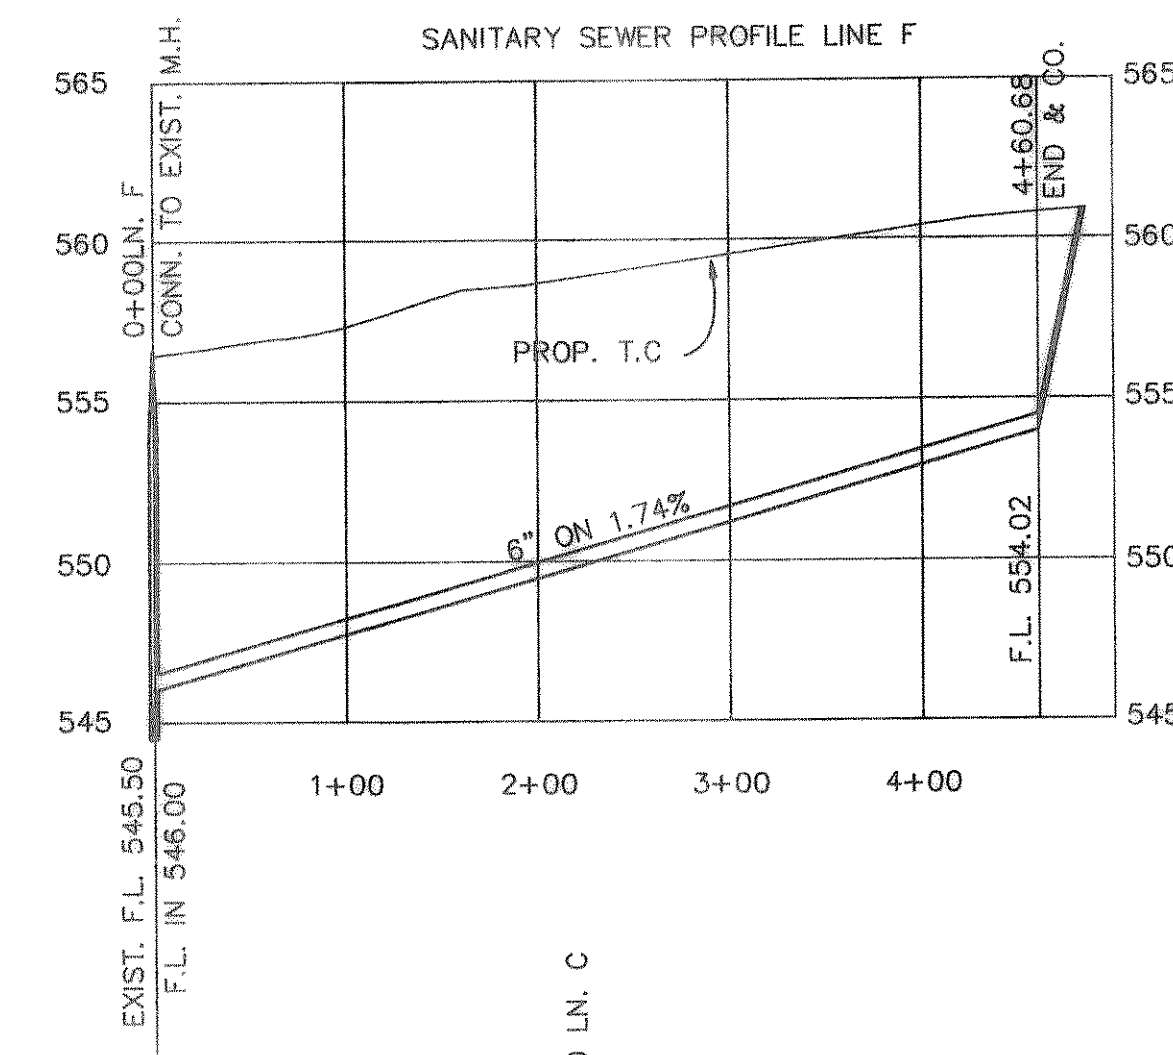


CURVE	RADIUS	LENGTH	TANGENT	CHORD	BEARING	DELTA
C1	496.50'	113.21'	56.85'	112.96'	N83°56'32" E	17°03'51"
C2	453.50'	59.28'	29.87'	59.22'	N87°29'14" E	7°29'14"
C3	193.67'	166.02'	88.53'	161.03'	N55°16'56" W	49°07'47"
C4	150.00'	234.12'	148.51'	211.07'	S45°19'43" E	89°26'35"
C5	203.50'	70.99'	35.86'	70.63'	S80°03'53" W	19°59'11"
C6	221.50'	64.90'	32.68'	64.66'	N78°28'07" E	16°47'13"
C7	224.88'	244.79'	138.13'	232.86'	S67°55'44" E	62°35'22"
C8	825.15'	61.72'	26.87'	61.71'	S01°10'18" W	03°34'26"
C9	150.00'	193.18'	112.80'	180.11'	N31°21'18" W	73°47'24"

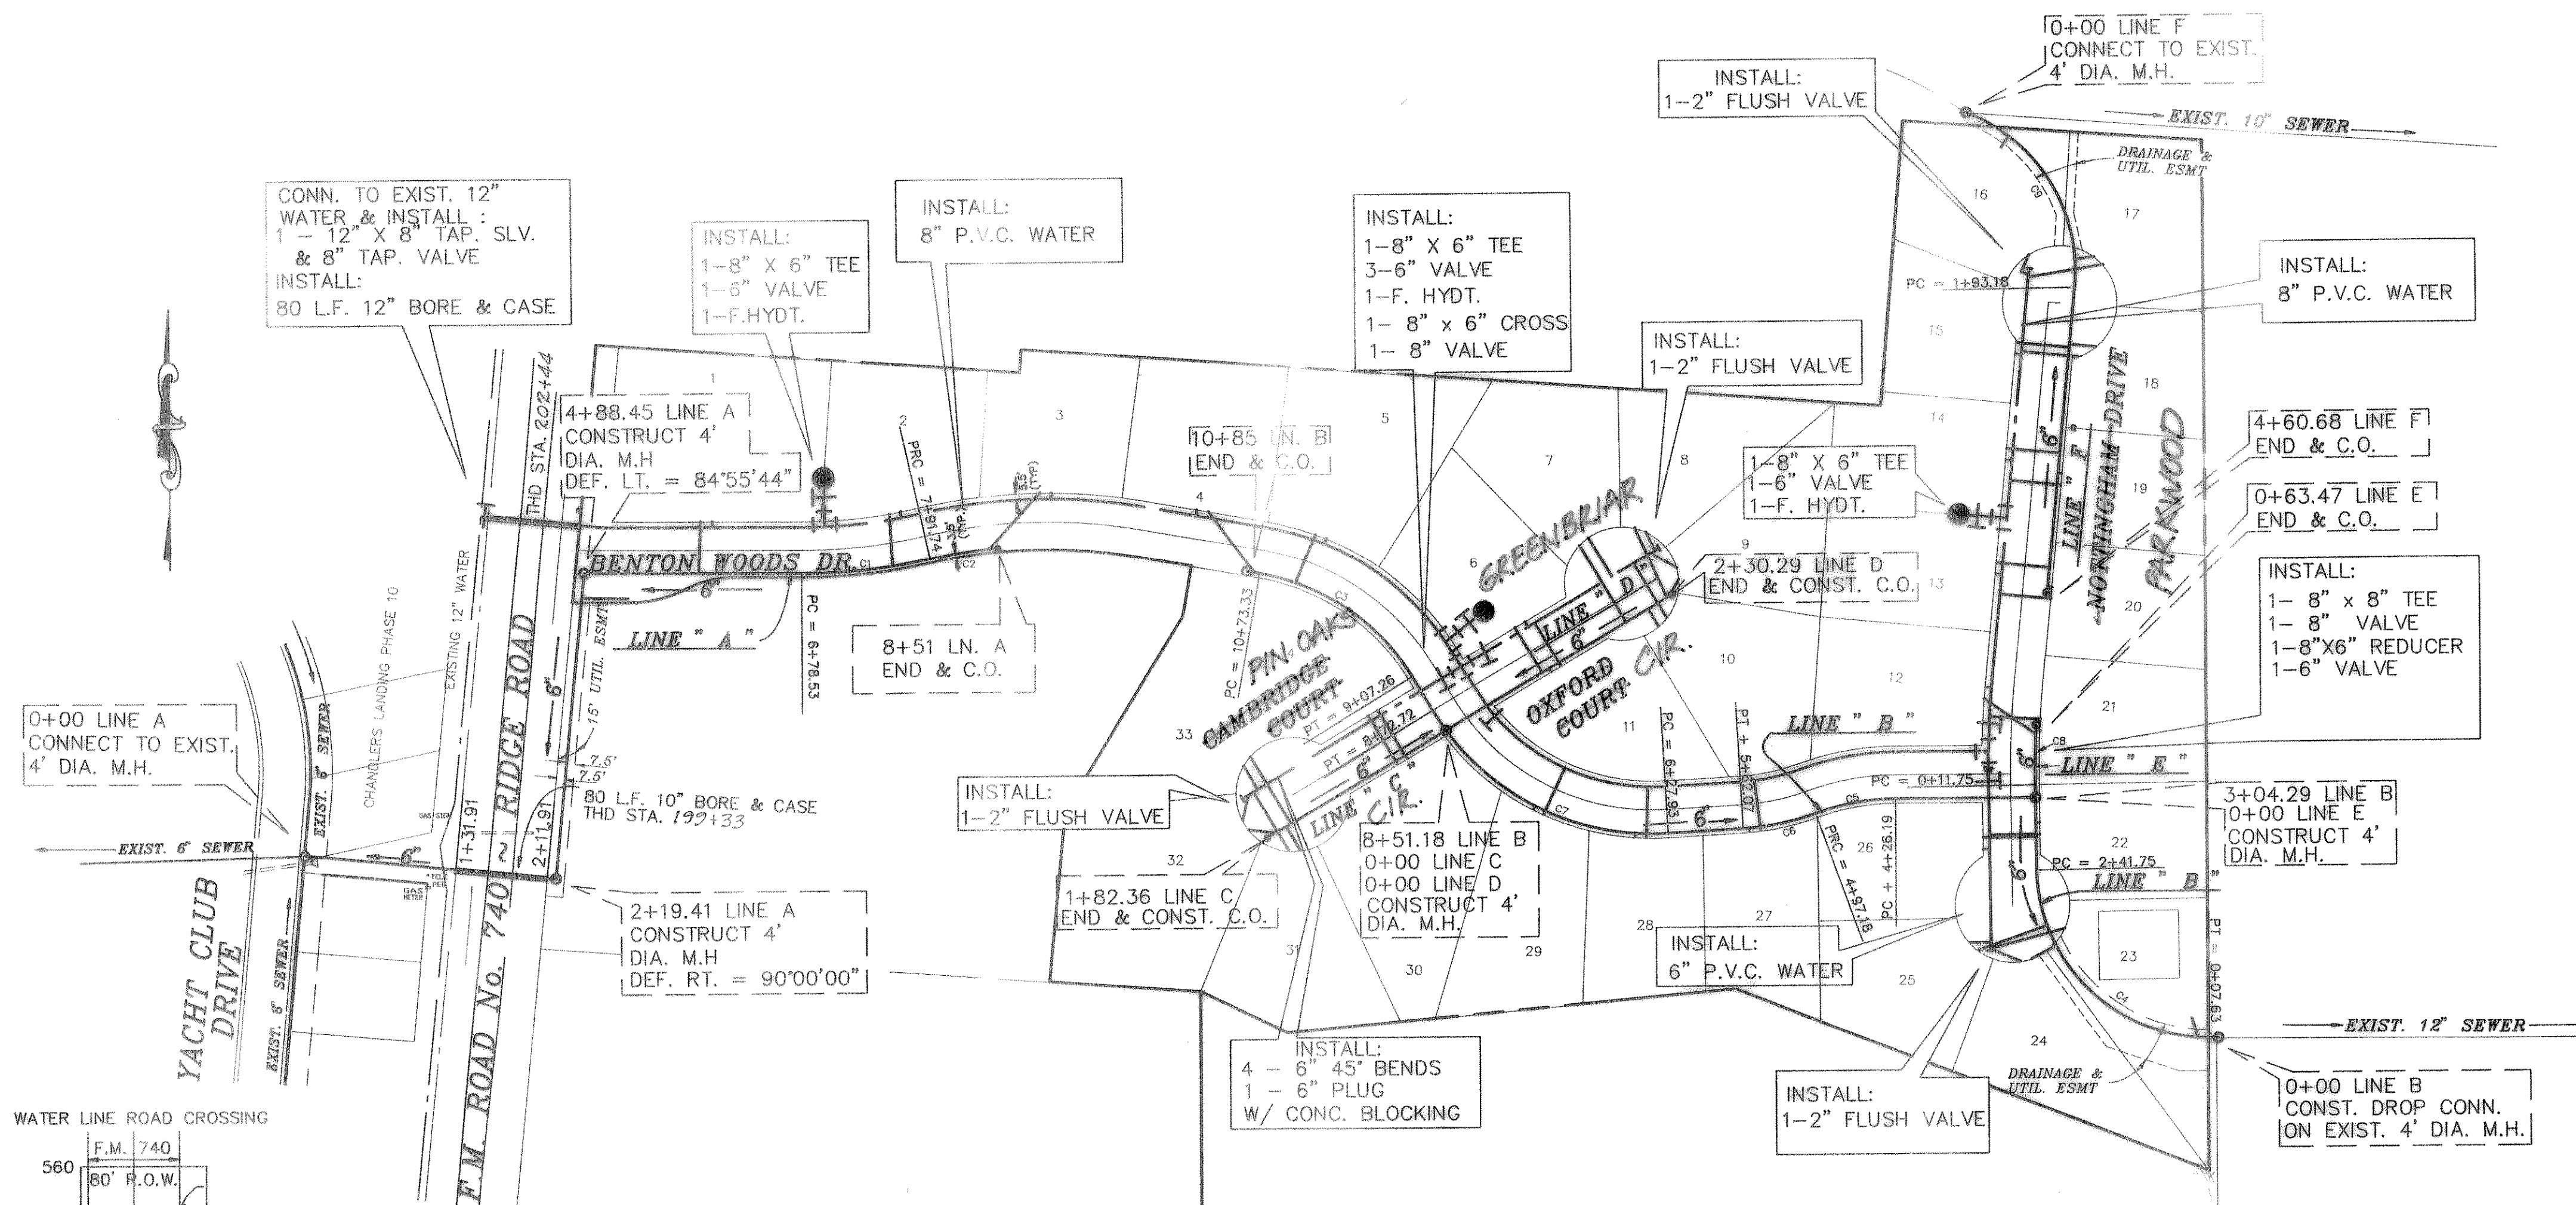

B.M.
60 D NAIL IN P.P. #2315/443/3512
LOCATED 35' +/- LT. OF PAV. STA. 0+41
BENTON WOODS
ELEVATION = 560.81

B.M.
60 D NAIL IN 15' ELM TREE 59' +/-
S.E. OF N.E. CORNER OF LOT B & 9,
BLOCK A.
ELEVATION = 564.07

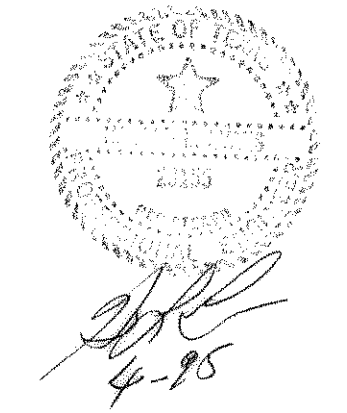

HAROLD L. EVANS CONSULTING ENGINEER P.O. BOX 28365 2331 GUS THOMASSON ROAD, SUITE 102 DALLAS, TEXAS 75228. (214) 328-8133		WATER & SANITARY SEWER BENTON WOODS CITY OF ROCKWALL	SHEET NO. 7 10 JOB NO. 9417
REVISION DESCRIPTION DATE 7/29/84	SCALE 1" = 100' 1" = 6'	DESIGN H.L.E.	DRAWN