


DRAINAGE TABLE

DRAINAGE AREA NO.	ACRES	T.C.	C	I 100 YR.	Q 100 YR.	SUM Q 100 YR.
1	2.40	10	0.5	9.8	11.76	
2	0.85	"	"	"	4.16	15.92
3	0.29	"	"	"	1.42	
4	2.29	"	"	"	11.22	
5	1.26	"	"	"	6.17	
6	0.74	"	"	"	3.63	
7	1.00	"	"	"	4.90	
8	1.21	"	"	"	5.93	
9	1.21	"	"	"	5.93	

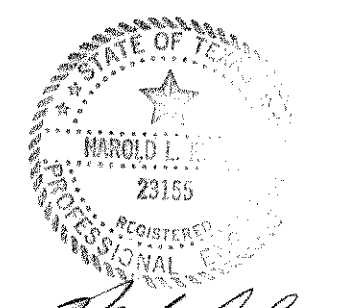

AS BUILT

*Handwritten signature*

HAROLD L. EVANS CONSULTING ENGINEER P.O. BOX 28355 2331 GUS THOMASSON ROAD, SUITE 102 DALLAS, TEXAS 75228. (214) 328-8133		<b>DRAINAGE AREA MAP</b> <b>BENTON WOODS</b> <b>CITY OF ROCKWALL</b>		SHEET NO. <b>8</b> 10	
REVISION DESCRIPTION REV. PER FIRST CITY REVIEW	DATE 7/28/94	SCALE 1" = 100'	DESIGN H.L.E.	DRAWN	JOB NO. 9417