



CURVE	RADIUS	LENGTH	TANGENT	CHORD	BEARING	DELTA
C1	100.00'	84.27'	50.97'	90.82'	S63°02'06"E	54°00'47"
C2	119.63'	73.94'	38.19'	72.27'	S18°19'19"E	39°24'48"
C3	100.00'	155.90'	98.83'	140.59'	N45°16'43"W	89°19'36"
C4	234.30'	81.73'	41.28'	81.31'	S80°03'55"W	19°59'08"
C5	190.70'	35.88'	28.14'	55.88'	N78°28'03"E	16°47'23"
C6	193.98'	111.40'	87.29'	109.88'	S76°40'46"E	32°55'18"
C7	100.00'	88.64'	30.19'	57.81'	N77°01'07"W	33°36'00"

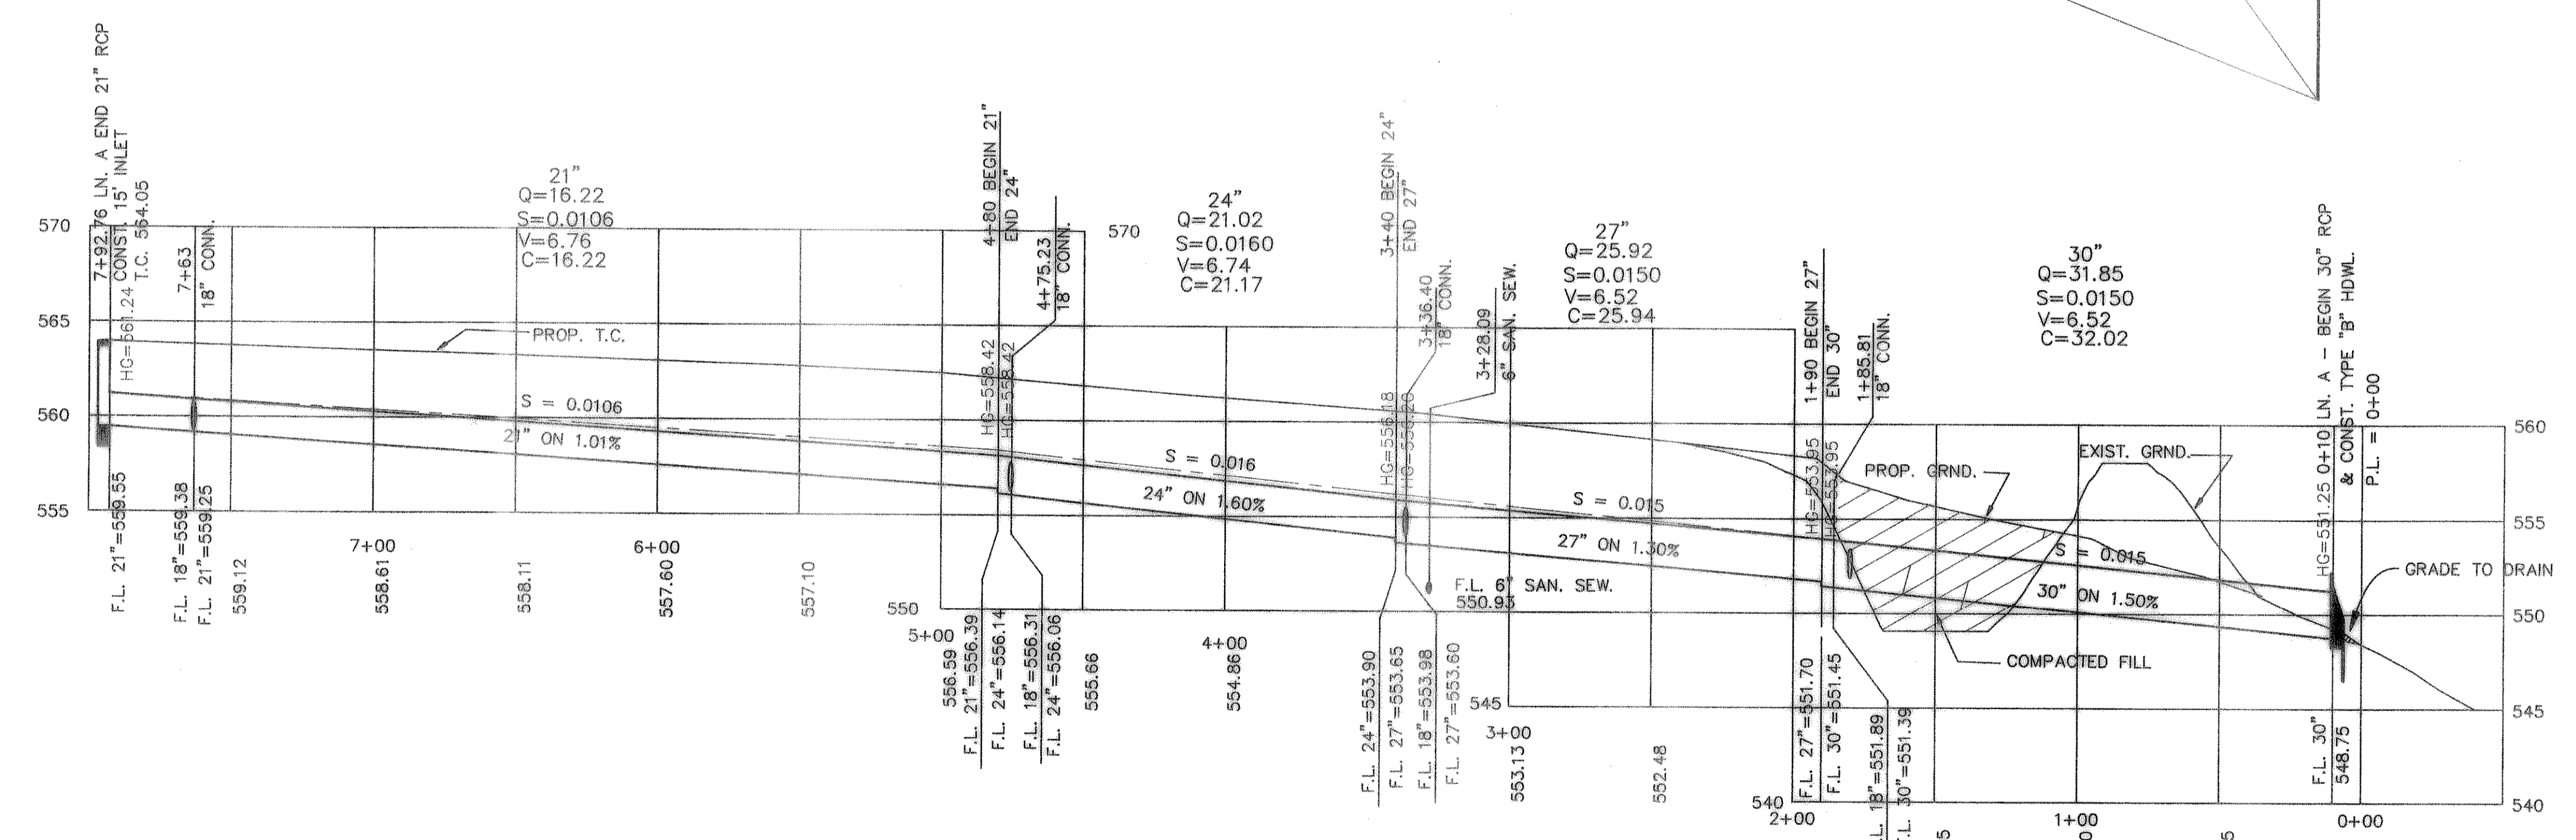

B.M.  
60 D NAIL IN P.P. #2815/448/3512  
LOCATED 35' +/- LT. OF PAV. STA. 0+11  
BENTON WAY  
ELEVATION = 560.81

B.M.  
60 D NAIL IN 15" ELM TREE 69' +/-  
S.E. OF N.E. CORNER OF LOT 8 & 9,  
BLOCK A  
ELEVATION = 564.07

AS BUILT

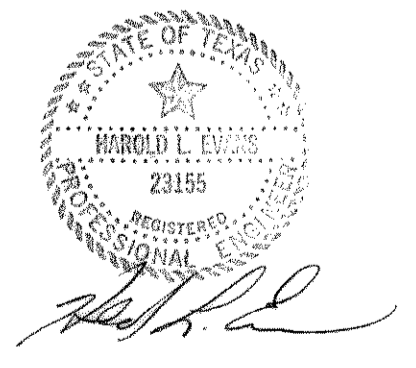

HAROLD L. EVANS CONSULTING ENGINEER P.O. BOX 28355 2331 CUS THOMASSON ROAD, SUITE 102 DALLAS, TEXAS 75228. (214) 328-8133		<b>STORM SEWER</b>		SHEET NO. 9
DATE: 7/29/94 SCALE: 1" = 40' 1" = 6'		DESIGN: H.L.E. DRAWN:		JOB NO. 9417
REVISION DESCRIPTION		BENTON WOODS CITY OF ROCKWALL		10