



F. M. 740 ≈ RIDGE ROAD

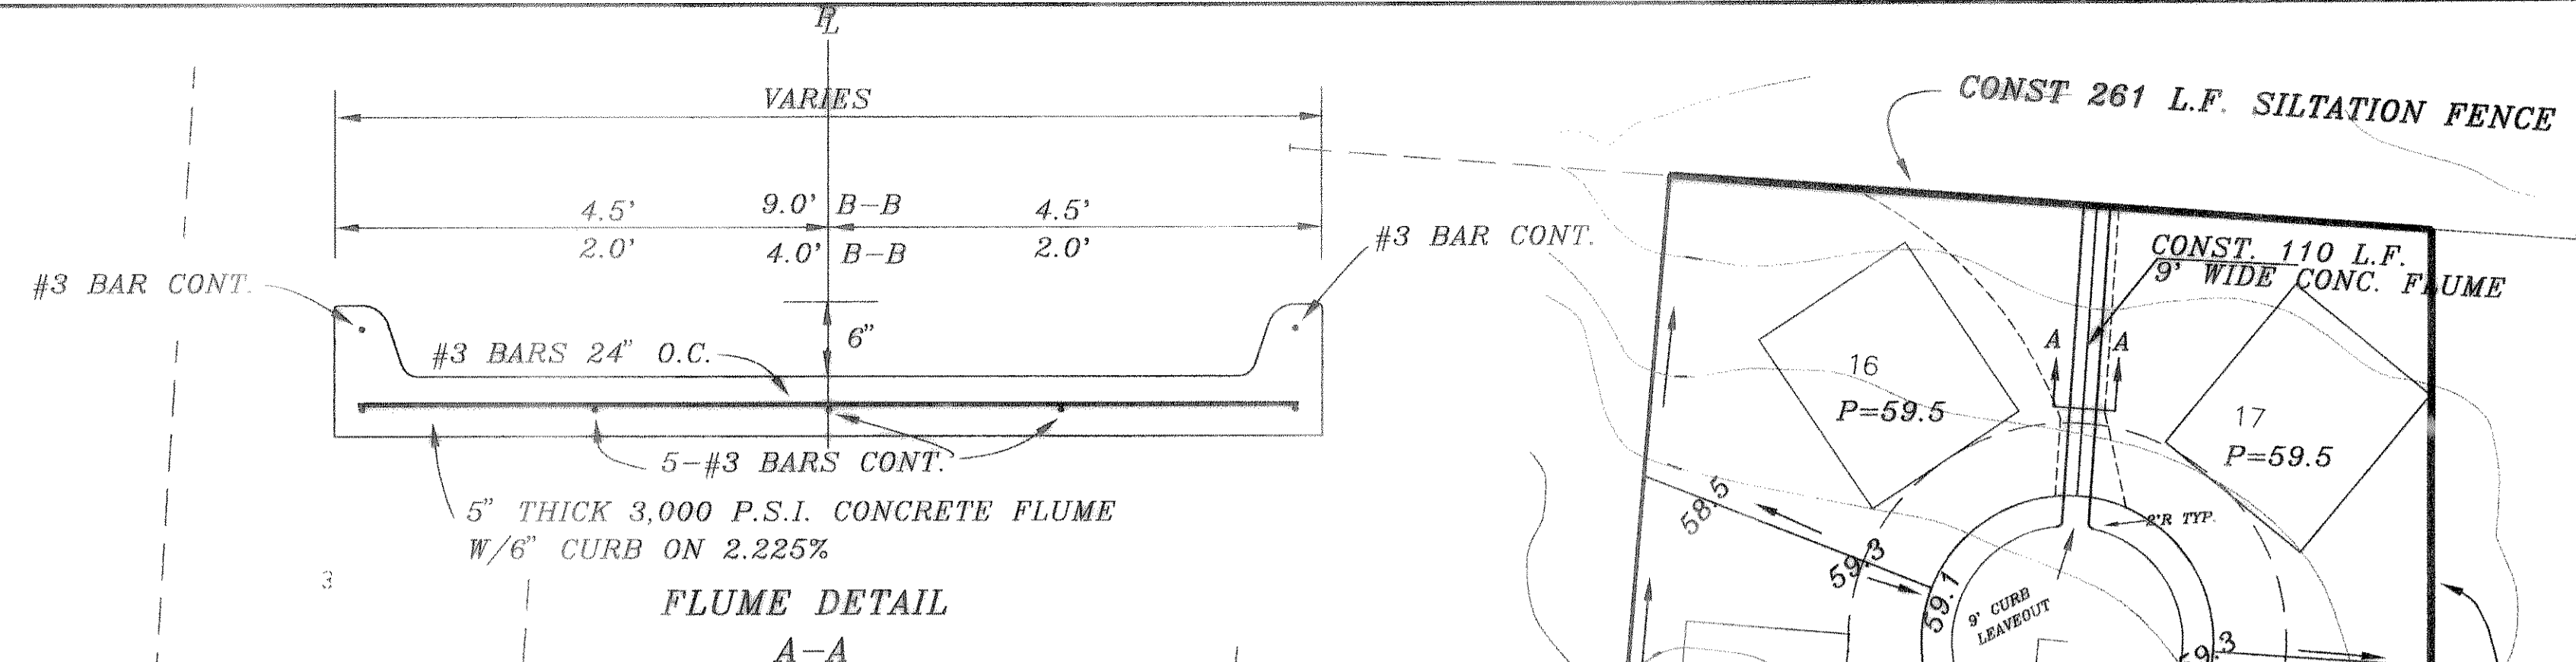

B.M.
60 D NAIL IN P.P. #2315/443/3512
LOCATED 35' +/- LT. OF PAV. STA. 0+41
BENTON WAY
ELEVATION = 560.81

B.M.
60 D NAIL IN 15' ELM TREE 59' +/-
S.E. OF N.E. CORNER OF LOT 8 & 9,
BLOCK A.
ELEVATION = 564.07

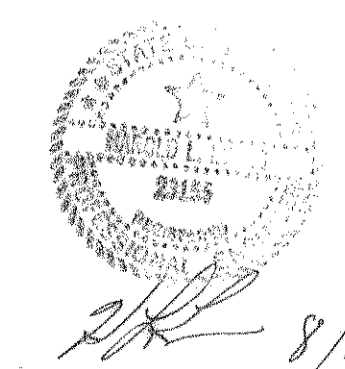

AS BUILT

941780		HAROLD L. EVANS CONSULTING ENGINEER P.O. BOX 28355 2831 GUS THOMASSON ROAD, SUITE 102 DALLAS, TEXAS 75228, (214) 328-0133		LOT GRADING PLAN BENTON WOODS		SHEET NO. 10	
REV. PER CITY FIRST REVIEW		DATE 7/29/94		SCALE 1" = 50'		JOB NO. 9417	
REV. 8/30/95		DESIGN H.L.E.		DRAWN		CITY OF ROCKWALL	