


1442  
163  
1279

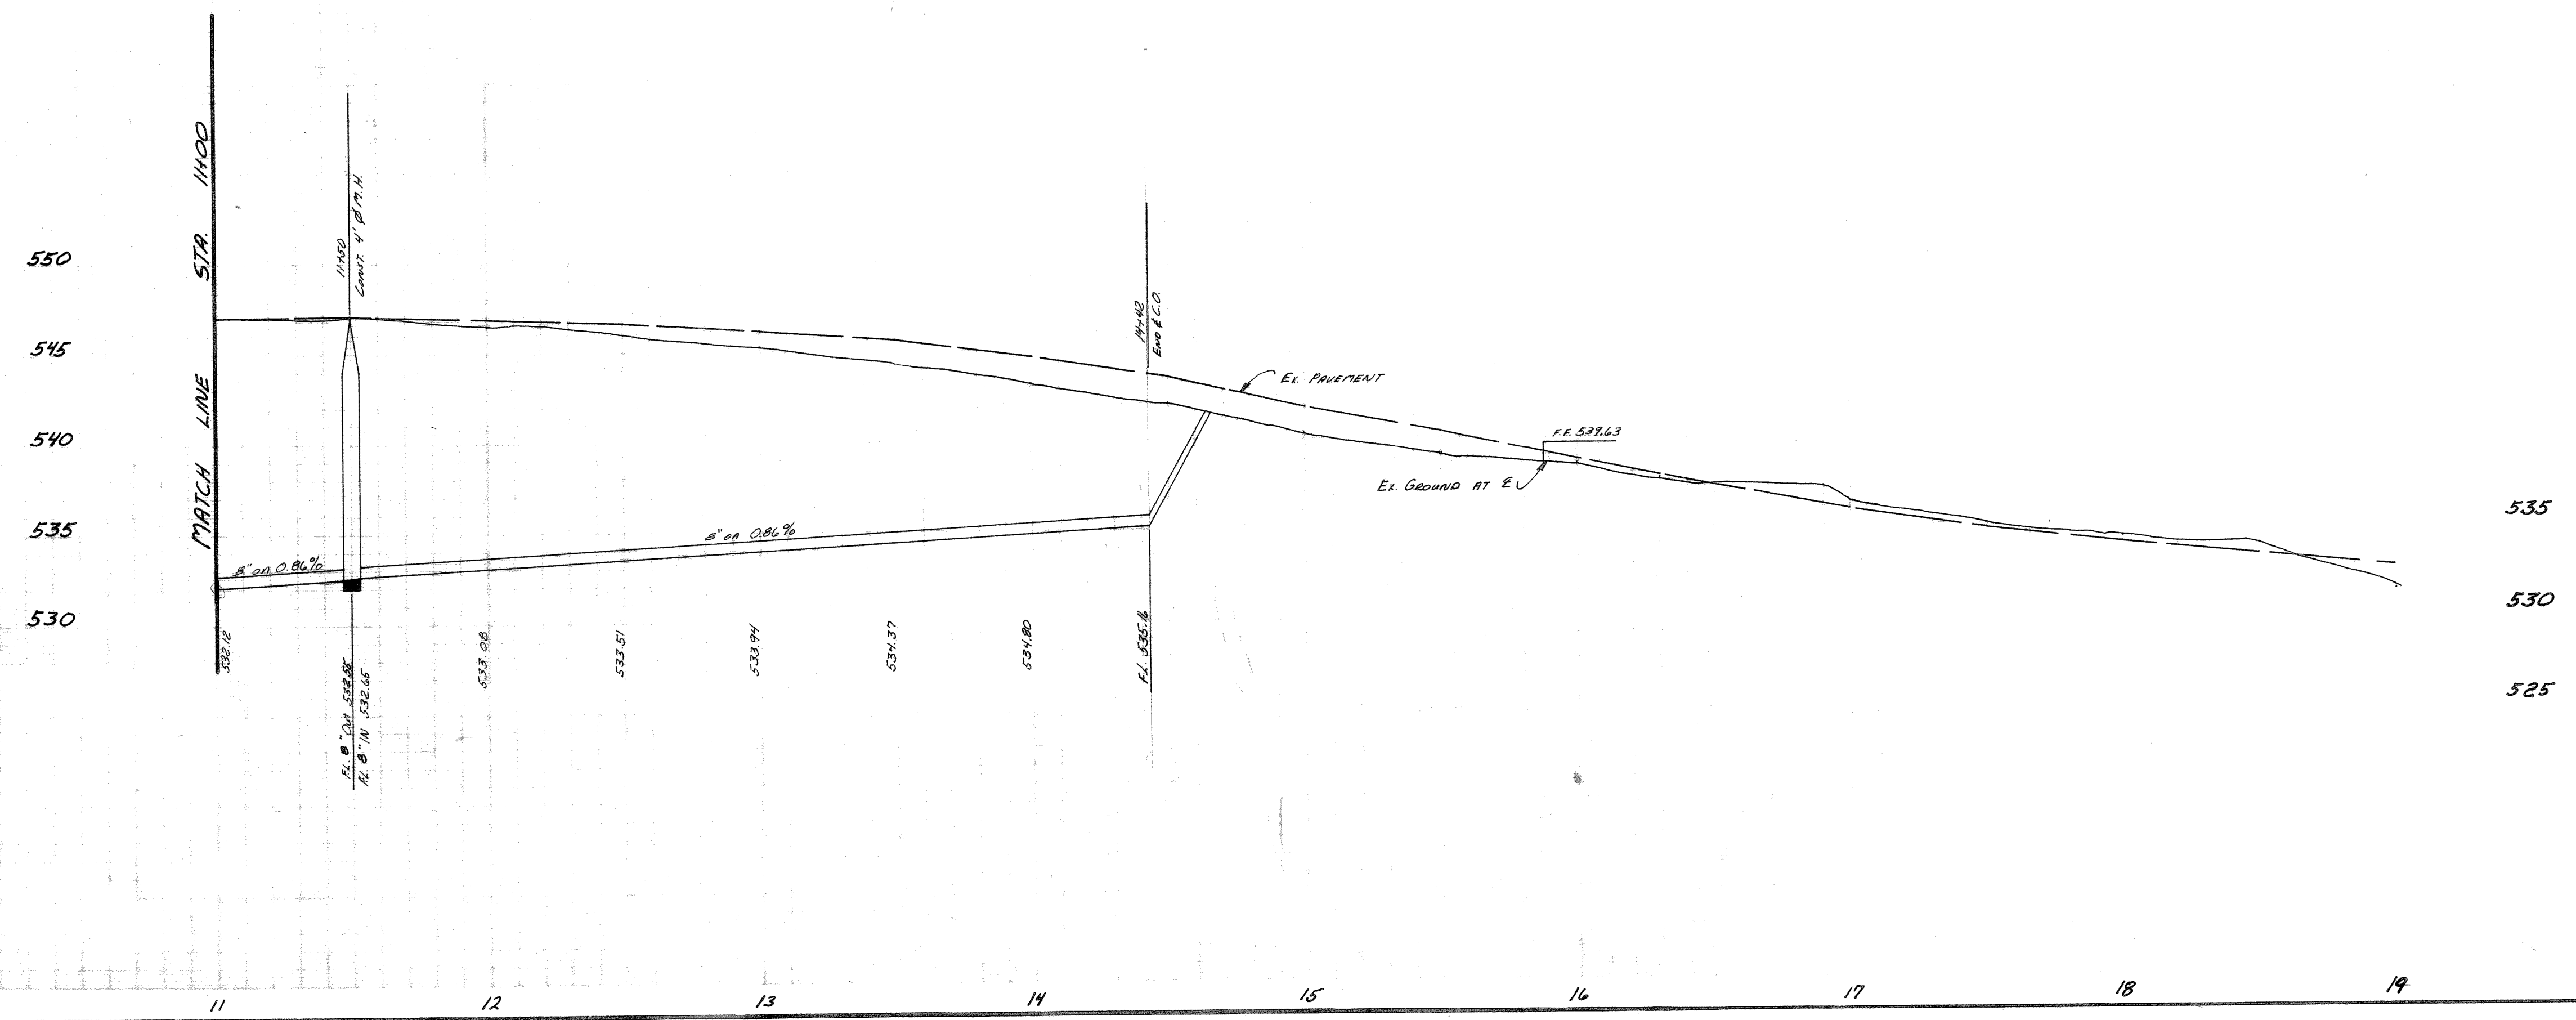

**AS BUILT**

<b>PROPOSED SANITARY SEWER</b>						
BODIN INDUSTRIAL TRACT						
CITY OF ROCKWALL						
HAROLD L. EVANS & CONSULTING ENGINEER						
DESIGN	DRAWN	DATE	SCALE	NOTES	FILE	NO.
	T.L.O.	7/15/83	1"=20'H. 1"=6'V.			78166