

INTERSTATE HIGHWAY NO. 30

0+00 Ln. "A" ~ Const. 4.0' Dia. M.H. Over Ex. 12" San. Sew.

CAUTION! LONE STAR GAS CO. LINE IN THIS AREA. VERIFY LOCATION IN FIELD PRIOR TO CONSTRUCTION.

Ex. Bldg. F.F. 541.66

Ex. Metal Bldg. F.F. 549.36

Install 50 L.F. By Boring

Ex. Brick Storage Bldg.

CAUTION! SOUTHWESTERN BELL TELEPHONE APPURTENANCES IN THIS AREA. VERIFY LOCATION IN FIELD PRIOR TO CONSTRUCTION

3+66.25 Ln. "A" Const. 4.0' Dia. M.H.


$\Delta = 1^{\circ}57'30"$
R: 626.50'
T = 11.20'
L = 23.81'

4+19.61 Ln. "A" Const. 4.0' Dia. M.H.

Ex. Metal Bldg. F.F. 550.19

3+36.89 Ln. "A" Const. 4.0' Dia. M.H.

NOTE: CONTRACTOR SHALL VERIFY LOCATION OF ALL EXIST. UTILITIES PRIOR TO BEGINNING CONSTRUCTION, PARTICULARLY IN THE AREA OF KRISTY LANE.

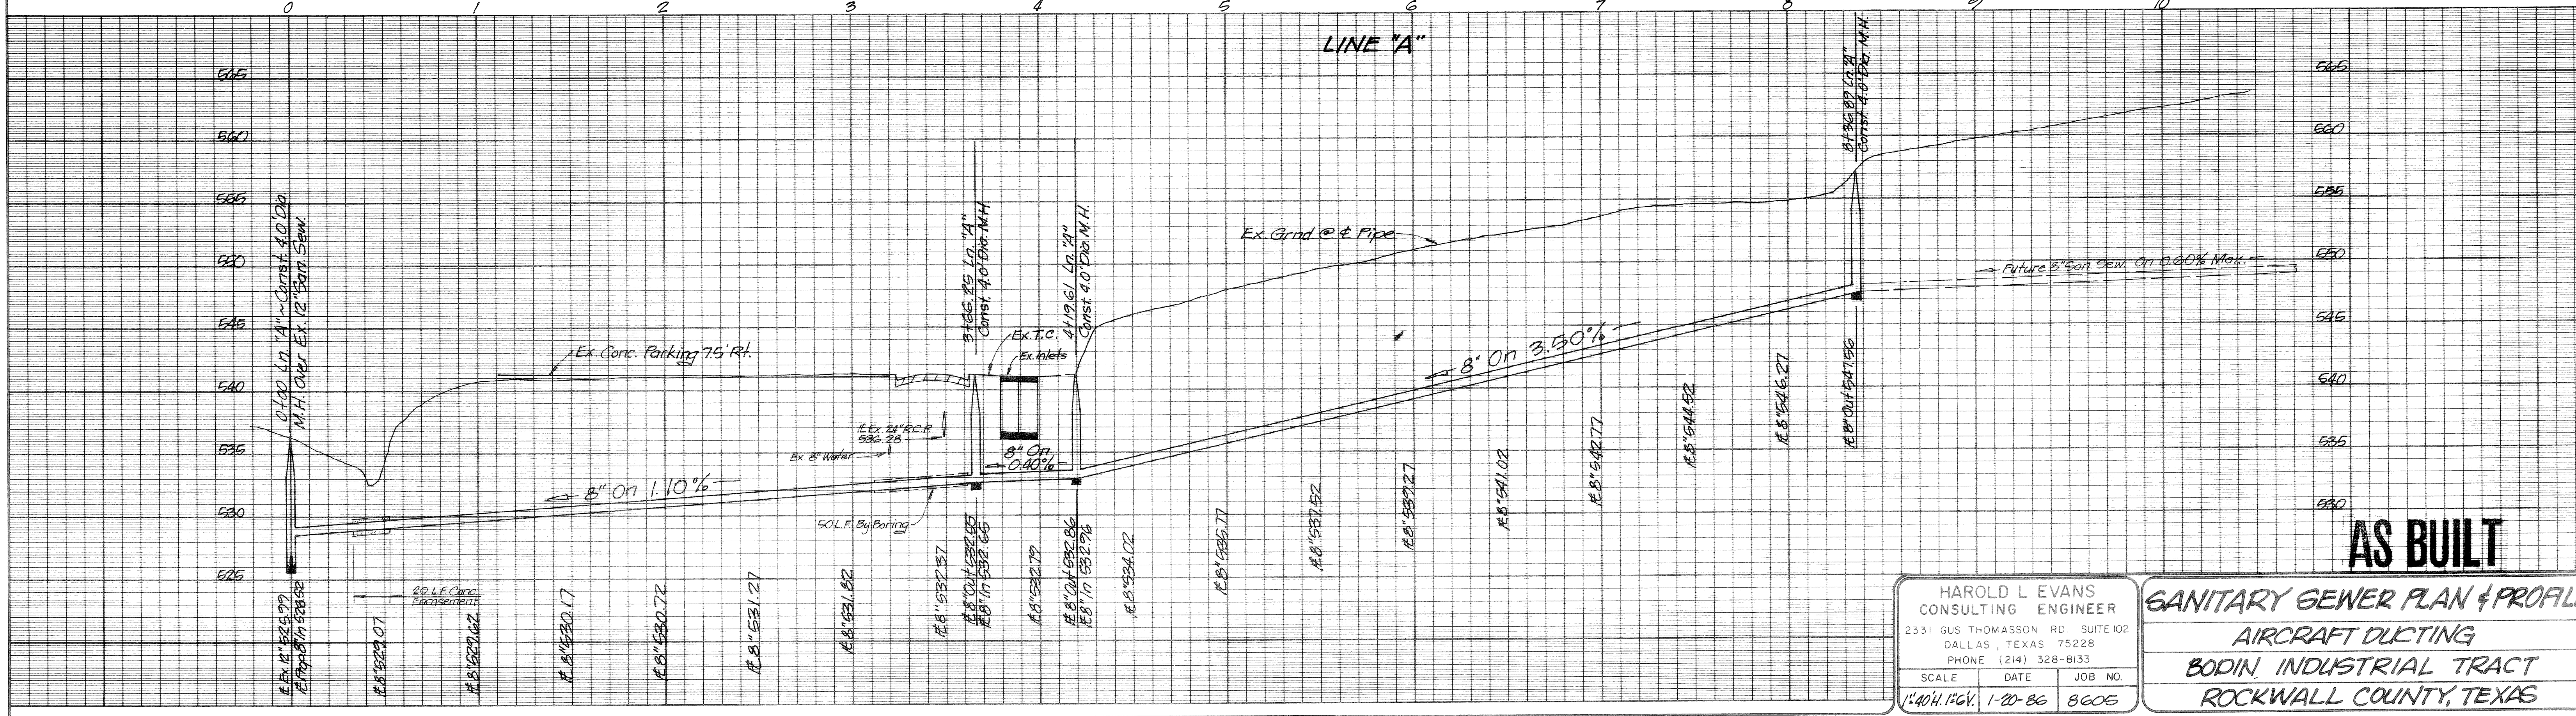

AS BUILT

HAROLD L EVANS
CONSULTING ENGINEER
2331 GUS THOMASSON RD. SUITE 102
DALLAS, TEXAS 75228
PHONE (214) 328-8133

SCALE	DATE	JOB NO.
1"=40'H. 1/4"=1'	1-20-86	8605

SANITARY SEWER PLAN & PROFILE
AIRCRAFT DUCTING
BODIN INDUSTRIAL TRACT
ROCKWALL COUNTY, TEXAS