



- 1. STONE SHALL BE 4 TO 6 INCH DIAMETER COARSE AGGREGATE. NO CRUSHED CONCRETE IS ALLOWED
- 2. MINIMUM LENGTH SHALL BE FIFTY (50) FEET, AND MINIMUM WIDTH SHALL BE TWENTY (20) FEET.
- 3. THE THICKNESS SHALL NOT BE LESS THAN 12 INCHES.
- 4. THE WIDTH SHALL BE NO LESS THAN THE FULL WIDTH OF ALL POINTS OF INGRESS OR EGRESS.
- 5. WHEN NECESSARY, VEHICLES SHALL BE CLEANED TO REMOVE SEDIMENT PRIOR TO ENTRANCE ONTO A PUBLIC ROADWAY. WHEN WASHING IS REQUIRED, IT SHALL BE DONE ON AN AREA STABILIZED WITH CRUSHED STONE WITH DRAINAGE FLOWING AWAY FROM BOTH THE STREET AND THE STABILIZED ENTRANCE. ALL SEDIMENT SHALL BE PREVENTED FROM ENTERING ANY STORM DRAIN, DITCH OR WATERCOURSE USING APPROVED METHODS.
- 6. THE ENTRANCE SHALL BE MAINTAINED IN A CONDITION WHICH WILL PREVENT TRACKING OR FLOWING OF SEDIMENT ONTO PAVED SURFACES. THIS MAY REQUIRE PERIODIC TOP DRESSING WITH ADDITIONAL STONE AS CONDITIONS DEMAND. ALL SEDIMENT SPILLED, DROPPED, WASHED, OR TRACKED ONTO PAVED SURFACES MUST BE REMOVED IMMEDIATELY.
- 7. THE ENTRANCE MUST BE PROPERLY GRADED OR INCORPORATE A DRAINAGE SWALE TO PREVENT RUNOFF FROM LEAVING THE CONSTRUCTION SITE.
- 8. PREVENT SHORTCUTTING OF THE FULL LENGTH OF THE CONSTRUCTION ENTRANCE BY INSTALLING BARRIERS AS NECESSARY.
- 9. INSPECTION SHALL BE AS SPECIFIED IN THE SWPPP.
- 10 NO CRUSHED CONCRETE IS ALLOWED

IU. NO CRI	JOHED CONCRETE IS ALLOWED.			
STARILIZED	CONSTRUCTION	Koope James on Proper Deputy and Proceed programs		
217011111111	CONTROCTOR	Taxasa	204	2.11 *
FN.	TRANCE	13.7 m		STANGARD CRAIMING NO.
F.14	IIIAIIOE	100	OCT. '04	10708

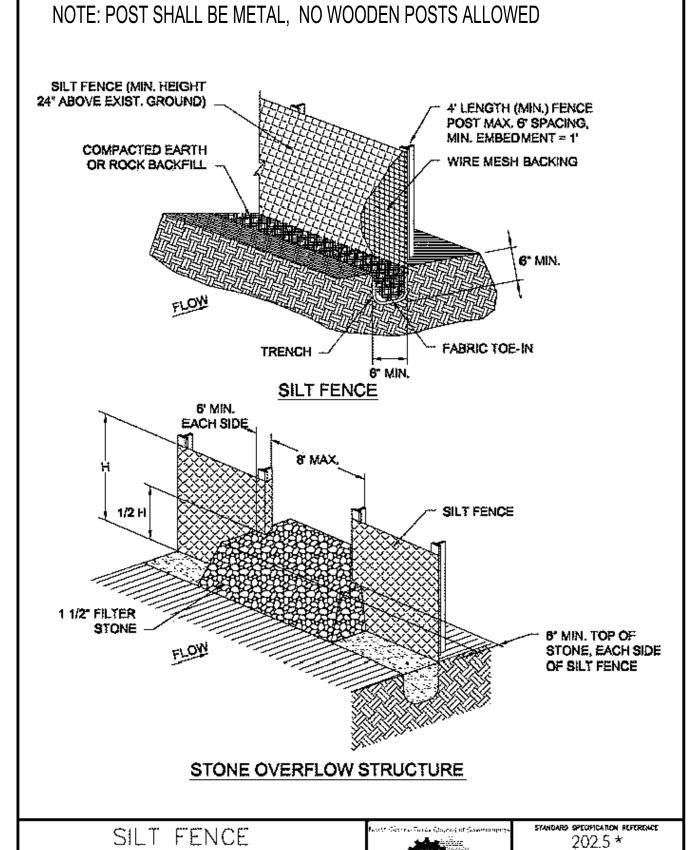

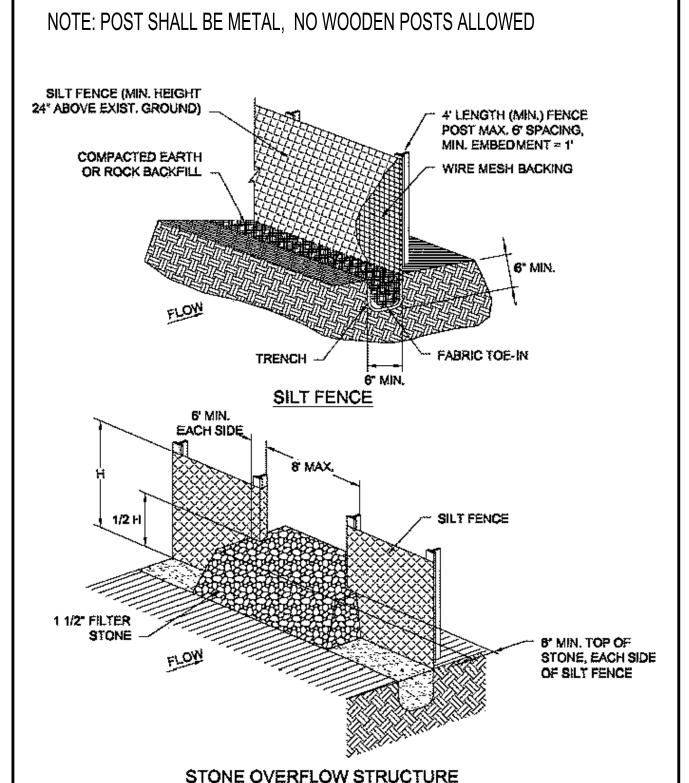

## SILT FENCE GENERAL NOTES: 1. POSTS WHICH SUPPORT THE SILT FENCE SHALL BE INSTALLED ON A SLIGHT ANGLE TOWARD THE ANTICIPATED RUNOFF SOURCE. POST MUST BE EMBEDDED A MINIMUM OF ONE FOOT. 2. THE TOE OF THE SILT FENCE SHALL BE TRENCHED IN WITH A SPADE OR MECHANICAL TRENCHER, SO THAT THE DOWNSLOPE FACE OF THE TRENCH IS FLAT AND PERPENDICULAR TO THE LINE OF FLOW. WHERE FENCE CANNOT BE TRENCHED IN (e.g. PAVEMENT), WEIGHT FABRIC FLAP WITH


FENCE.


3. THE TRENCH MUST BE A MINIMUM OF 6 INCHES DEEP AND 6 INCHES WIDE TO ALLOW FOR THE SILT FENCE FABRIC TO BE LAID IN THE GROUND AND BACKFILLED WITH COMPACTED MATERIAL.

ROCK ON UPHILL SIDE TO PREVENT FLOW FROM SEEPING UNDER


- 4. SILT FENCE SHOULD BE SECURELY FASTENED TO EACH SUPPORT POST OR TO WIRE BACKING, WHICH IN TURN IS ATTACHED TO THE FENCE POST. THERE SHALL BE A 3 FOOT OVERLAP, SECURELY FASTENED WHERE ENDS OF FABRIC MEET.
- 5. INSPECTION SHALL BE AS SPECIFIED IN THE SWPPP. REPAIR OR REPLACEMENT SHALL BE MADE PROMPTLY AS NEEDED.
- 6. SILT FENCE SHALL BE REMOVED WHEN FINAL STABILIZATION IS ACHIEVED OR ANOTHER EROSION OR SEDIMENT CONTROL DEVICE IS EMPLOYED.
- 7. ACCUMULATED SILT SHALL BE REMOVED WHEN IT REACHES A DEPTH OF HALF THE HEIGHT OF THE FENCE. THE SILT SHALL BE DISPOSED OF AT AN APPROVED SITE AND IN SUCH A MANNER AS TO NOT CONTRIBUTE TO ADDITIONAL SILTATION.
- 8. FILTER STONE SHALL BE WRAPPED IN FILTER FABRIC AND BURIED MINIMUM OF SIX (6) INCHES

SILT FENCE	Prints Central Cours Coursed of June institutes	standard specifi 202	*202.5 *	
		OCT. '04	STANDARD DRAMING MOD 1020B	

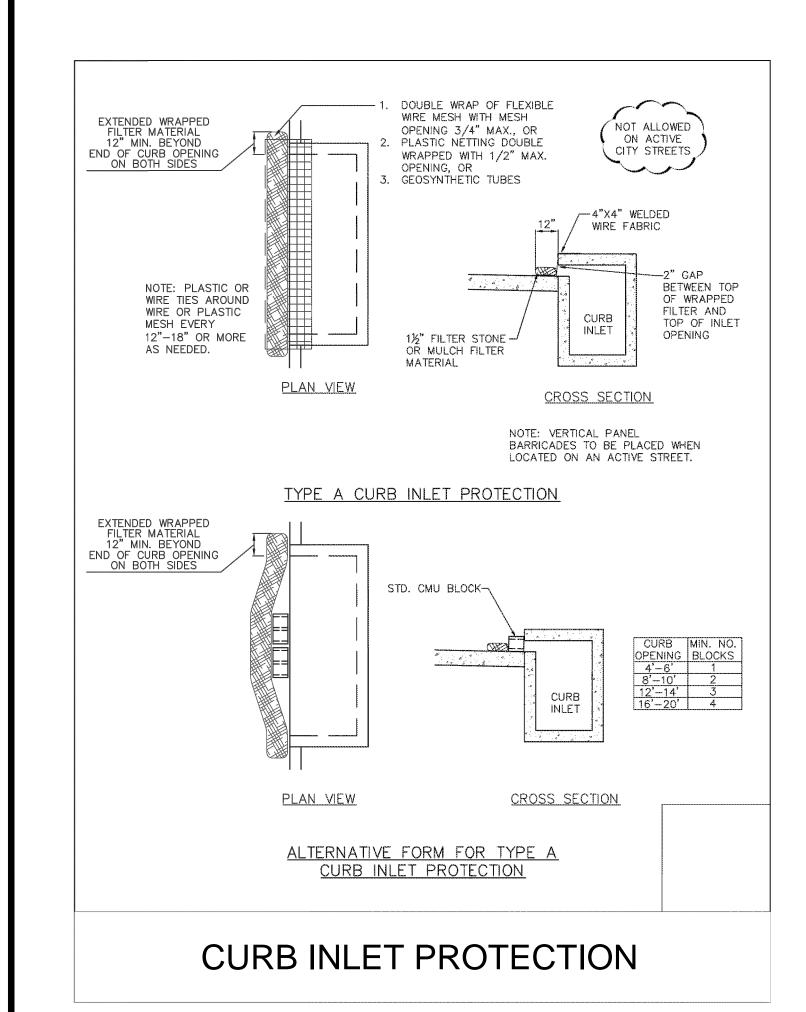

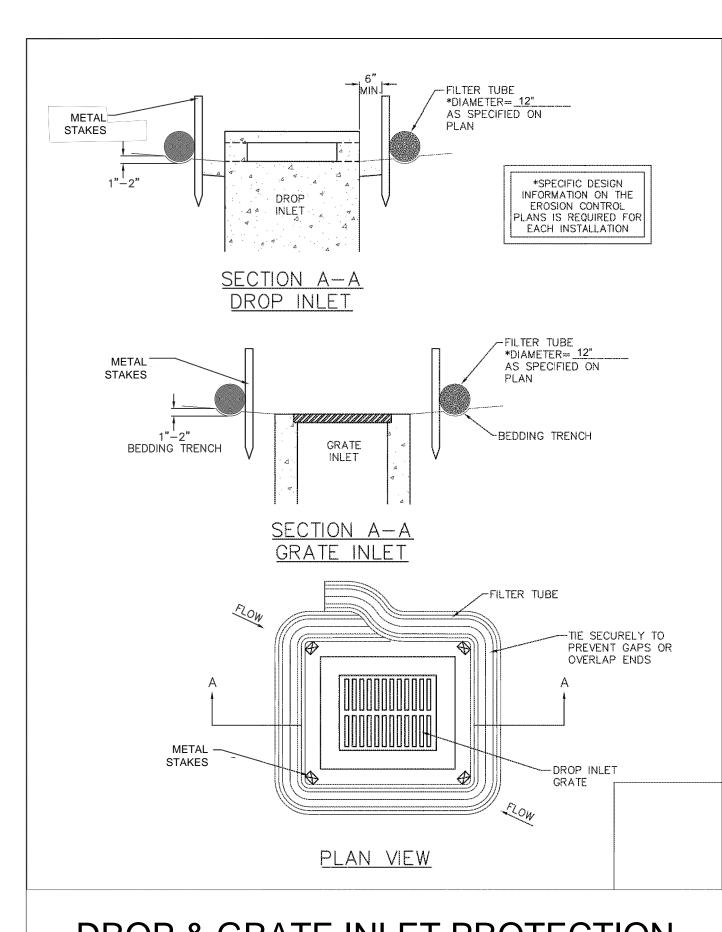




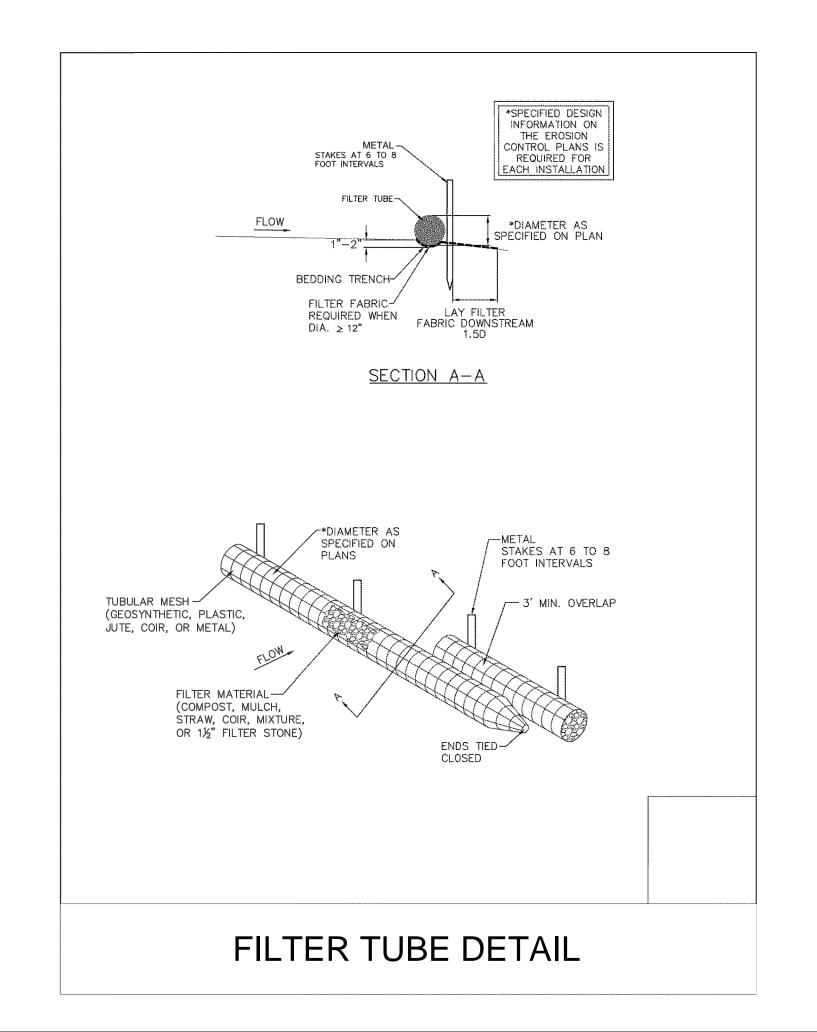

OCT. 104

1020A



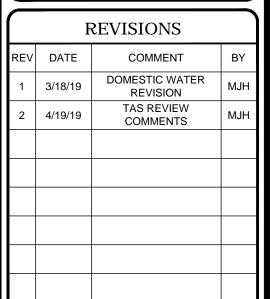



ASBUILT **RECORD DRAWING** 

DRAWN BY: CHECKED BY: SCALE:


CONSTRUCTION **DOCUMENTS** 

## brakes plus 🙈

LOCATION OF SITE 1902 S. GOLIAD ST LOTS 1 & 2, BLOCK A, BILLY PEOPLES ADDITION NO. 7 ROCKWALL, TX 75087 ROCKWALL COUNTY



**6017 MAIN STREET FRISCO, TX 75034** Phone: (469) 458-7300 TX@BohlerEng.com

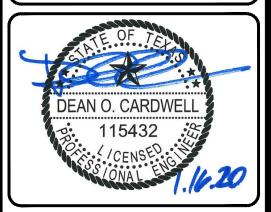

**EROSION & SEDIMENT** CONTROL **DETAILS** 

C-602

CASE NUMBER: SP2018-030