

CURB RAMPS NOTES:

(B.) CONCRETE SIDEWALKS AND RAMPS SHALL BE MINIMUM 4" THICK, 4000 PSI, 5 SACK CONCRETE, REINFORCED WITH #3 BARS AT 14" CENTERS BOTH WAYS, PLACED OVER: A 2" THICK SAND CUSHION EMBEDMENT. (C.) THE CONTRACTOR SHALL USE 1" PREMOLDED EXPANSION JOINT MATERIAL BETWEEN THE PROPOSED SIDEWALKS AND RAMPS AT THE BACK OF CURBS, AND AT JOINTS AT NO EXTRA PAY.

and Committee Country Server


STANDARD DRAWING N


OCT. '04 21258


(D.) DUMMY JOINT REQUIRED EVERY 4' IN 4' WIDE SIDEWALKS AND EVERY 5' IN 6' WIDE SIDEWALK.

CURB RAMPS


GENERAL REQUIREMENTS

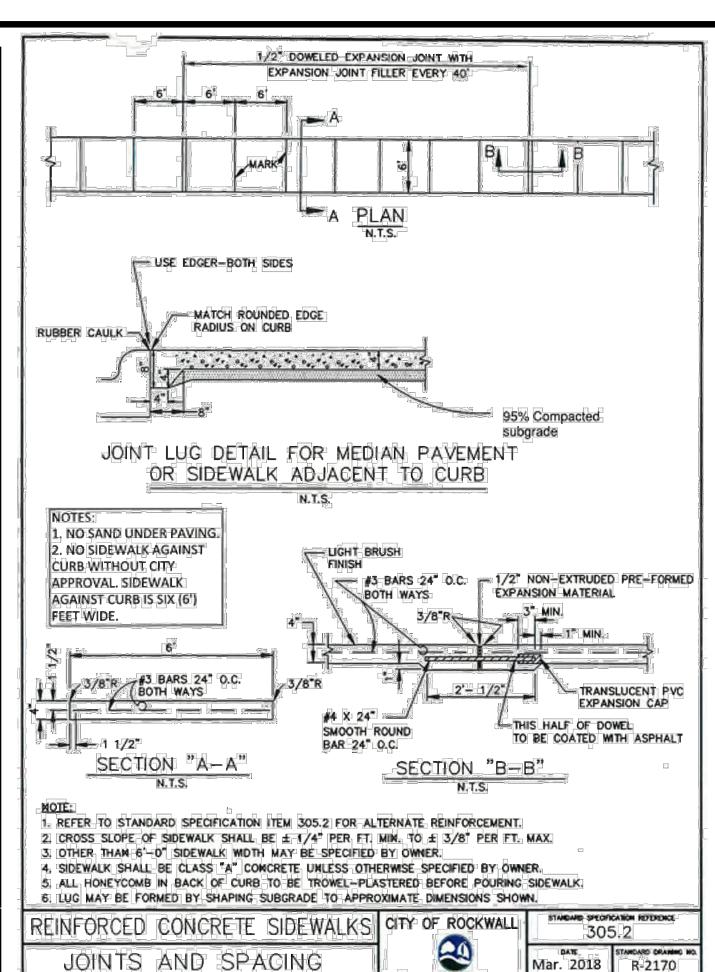


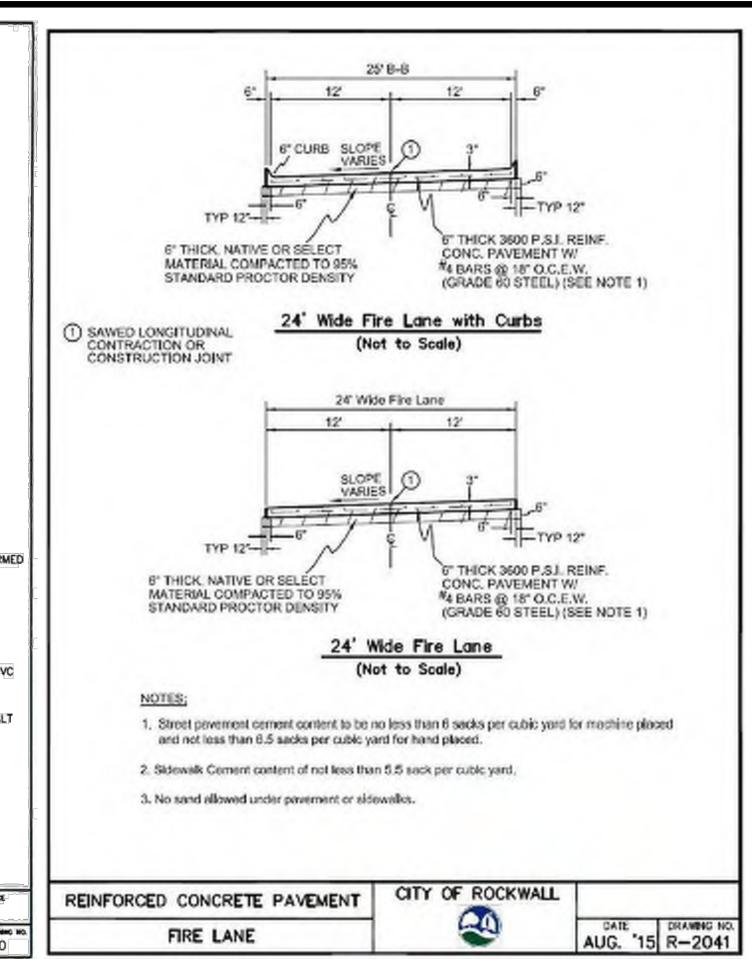


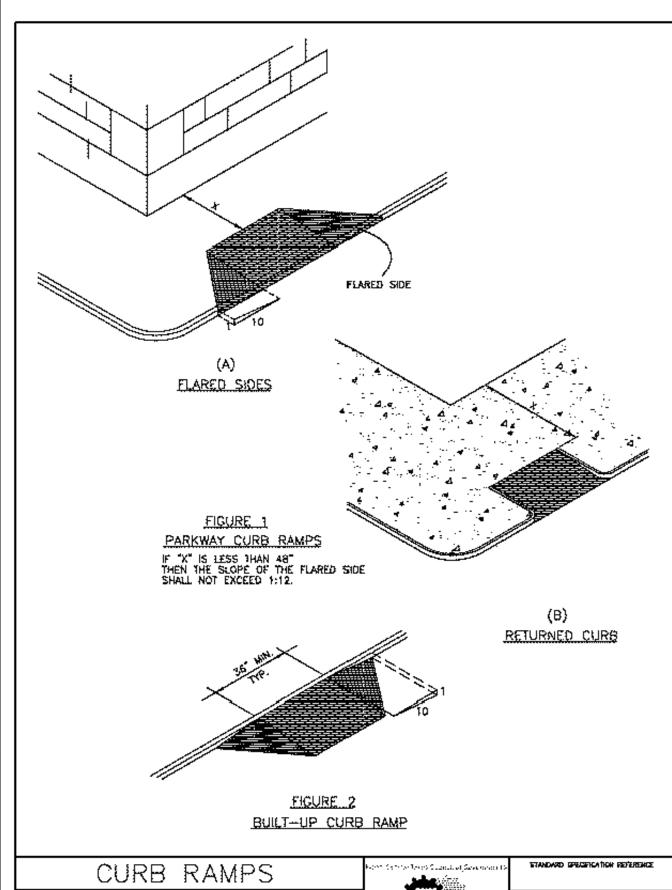


ANVAPPDATA\LOCAL\TEMP\ACPUBLISH_15860\TD180033SD2.DWG PRINTED BY: NKERAN 1.10.20 @ 3:18 PM LAST SAVED BY: NKERAN

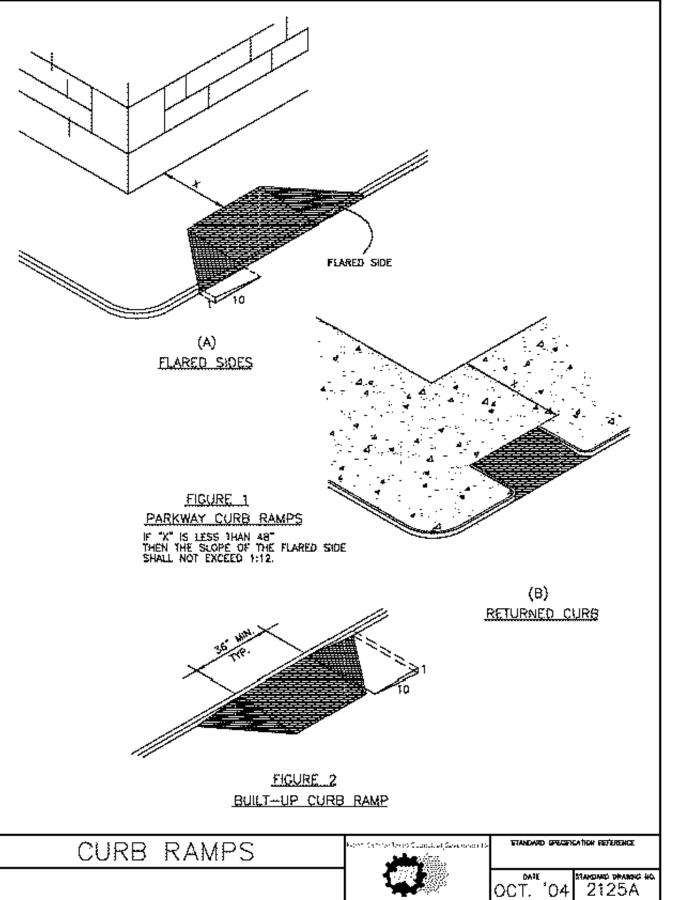

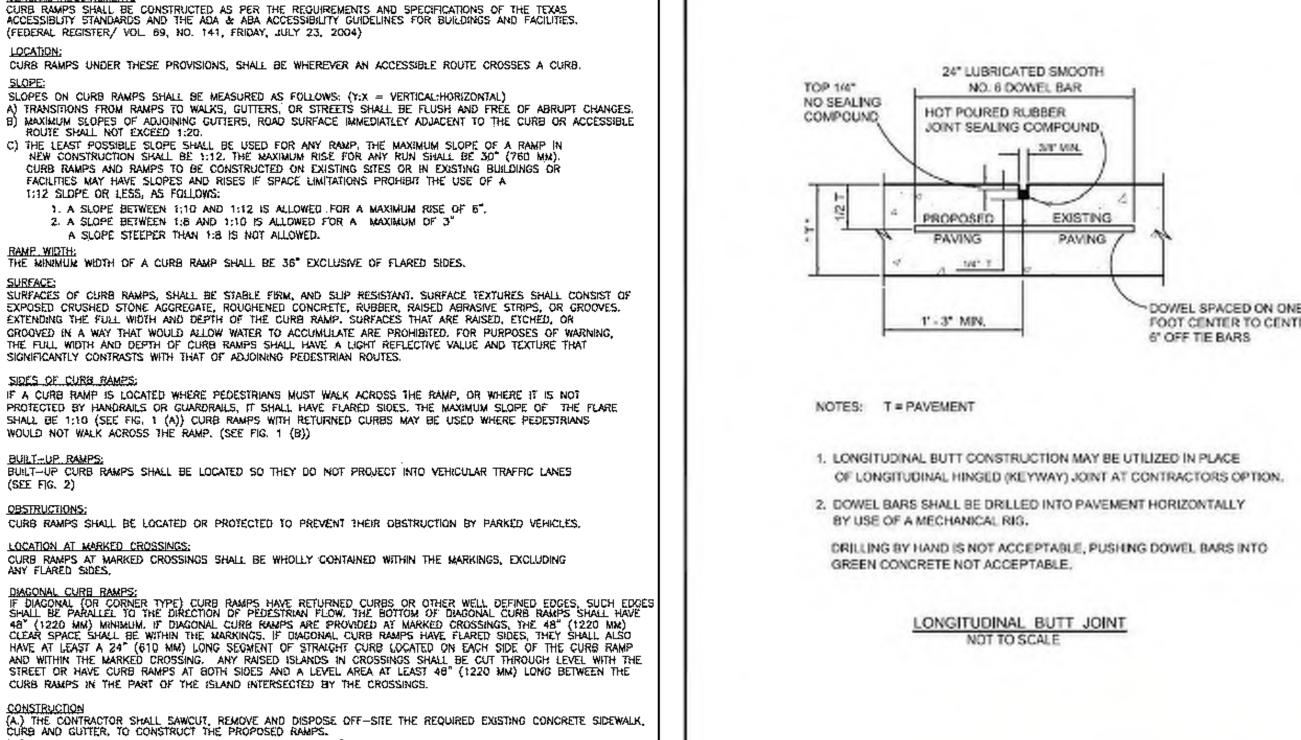

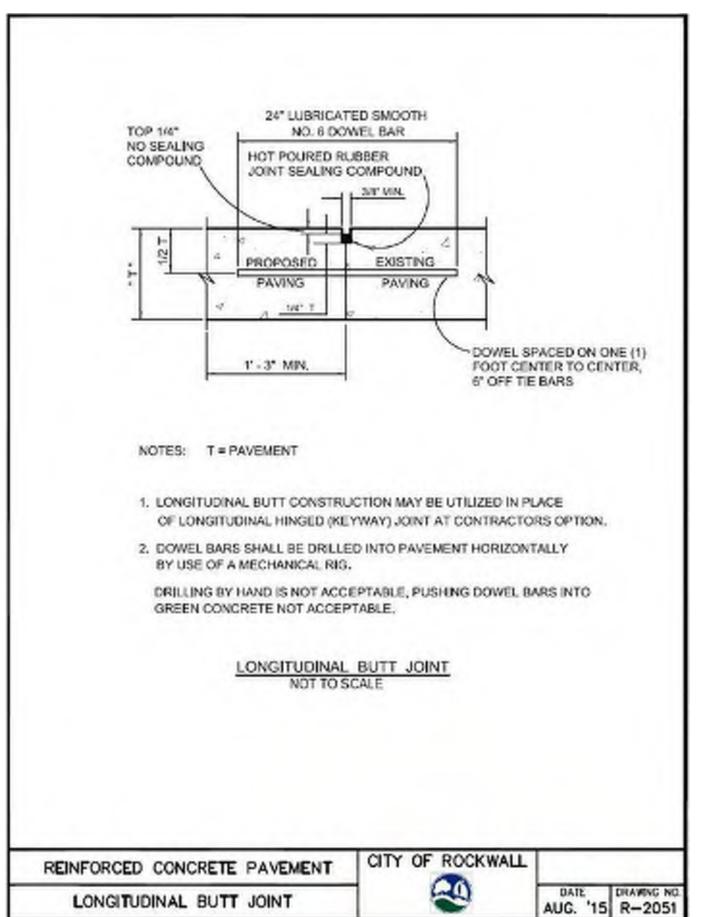



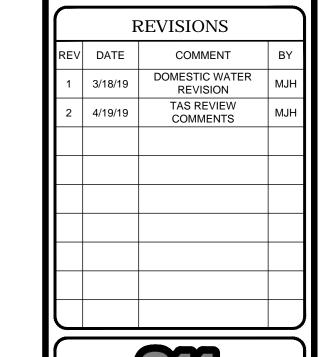



ASBUILT

It's fast. It's free. It's the law.

RECORD DRAWING DRAWN BY:

SCALE: CONSTRUCTION

DOCUMENTS


02/25/2019

brakes plus

LOCATION OF SITE 1902 S. GOLIAD ST LOTS 1 & 2, BLOCK A, BILLY PEOPLES ADDITION NO. 1 ROCKWALL, TX 75087 ROCKWALL COUNTY

BOHLER

6017 MAIN STREET **FRISCO, TX 75034** Phone: (469) 458-7300 TX@BohlerEng.com

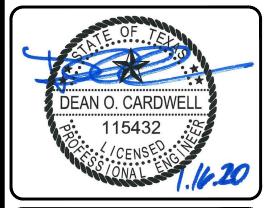

CONSTRUCTION **DETAILS**

CASE NUMBER: SP2018-030