



C:\USERS\NKERAN\APPDATA\LOCAL\TEMP\ACPUBLISH\_15860\TD180033SD2.DWG PRINTED BY: NKERAN 1.10.20 @ 3:19 PM LAST SAVED BY: NKERAN

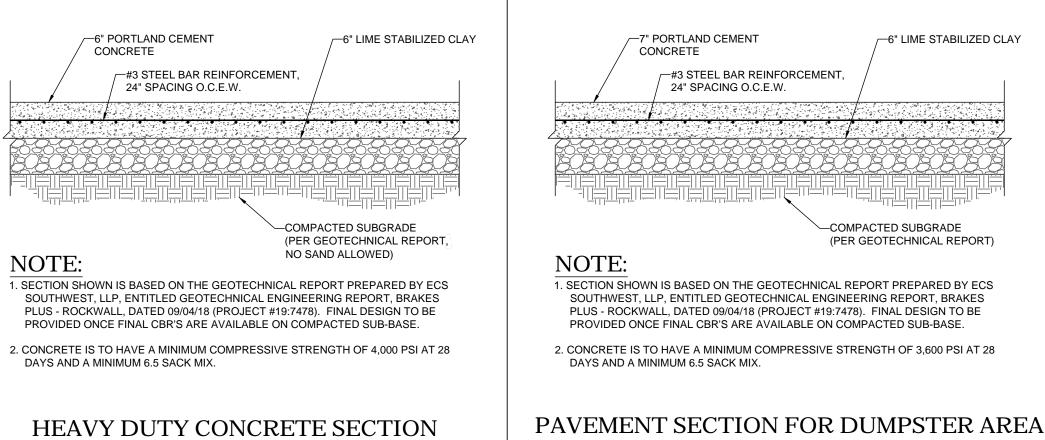

NOT TO SCALE

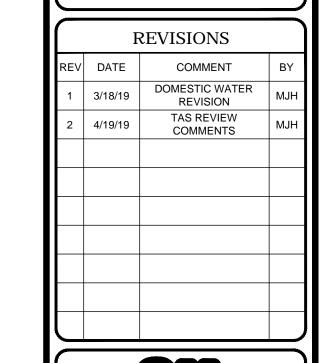

\*\*\*\*

SUSTAL

CUSTAL

CONTROL

CONTR



**BEFORE YOU DIG** It's fast. It's free. It's the law.

ASBUILT RECORD DRAWING

DRAWN BY: SCALE: CAD I.D.

> CONSTRUCTION DOCUMENTS


02/25/2019 N/A

## brakes plus

LOCATION OF SITE 1902 S. GOLIAD ST LOTS 1 & 2, BLOCK A, BILLY PEOPLES ADDITION NO. 1 ROCKWALL, TX 75087 ROCKWALL COUNTY



**6017 MAIN STREET** FRISCO, TX 75034 Phone: (469) 458-7300 TX@BohlerEng.com

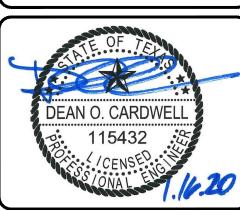

CONSTRUCTION **DETAILS** 

C-903

CASE NUMBER: SP2018-030