


DEVELOPMENT PLANS FOR BREEZY HILL AMENITY CENTER CITY OF ROCKWALL, TEXAS

INDEX

- 1 TITLE
- 2 SITE PLAN
- 3 DRAINAGE AREA MAP
- 4 PAVING PLAN
- 5 WATER & SEWER PLAN
- 6 GRADING PLAN
- 7 EROSION CONTROL PLAN

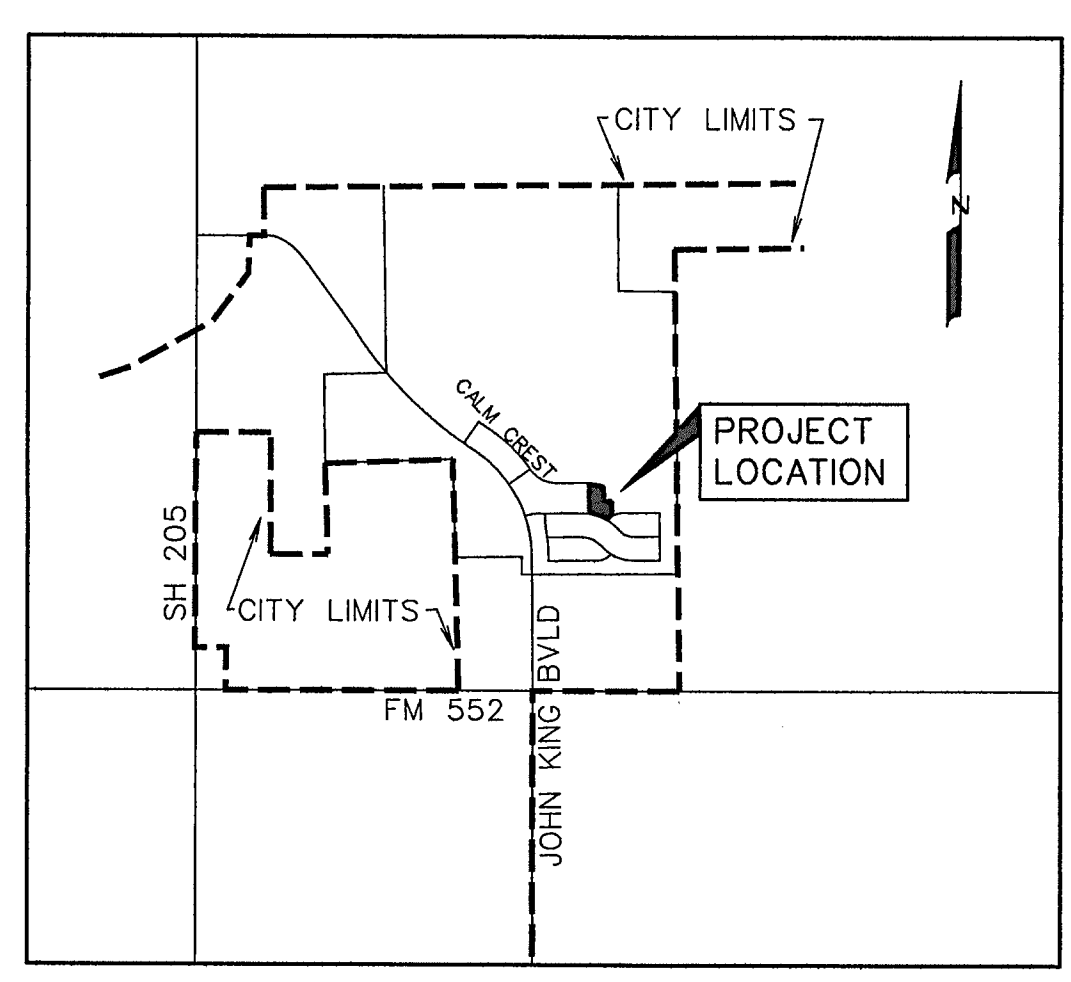

VICINITY MAP
NOT TO SCALE

PREPARED FOR
BH AMC, LTD.

8214 WESTCHESTER DRIVE, SUITE 710 DALLAS, TEXAS 75225

CORWIN ENGINEERING, INC. — CONSULTING ENGINEERS

200 W. BELMONT, SUITE E


TBPE FIRM #5951

ALLEN, TEXAS 75013

NOTE:

CITY OF ROCKWALL STANDARDS
AND NCTCOG 3rd ADDITION STANDARDS
SHALL BE USED FOR REFERENCE.

AS-BUILT NOVEMBER 2016
INFORMATION PROVIDED
BY CONTRACTORS
(NOT FIELD VERIFIED)

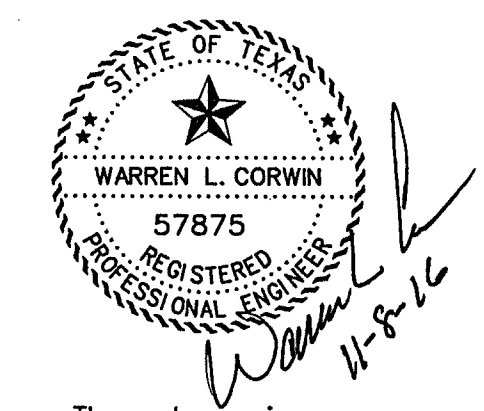

The seal appearing on
this document was
authorized by
Warren L. Corwin,
P.E. 57875, on
November 8, 2016

NO.	REVISIONS	BY	DATE