
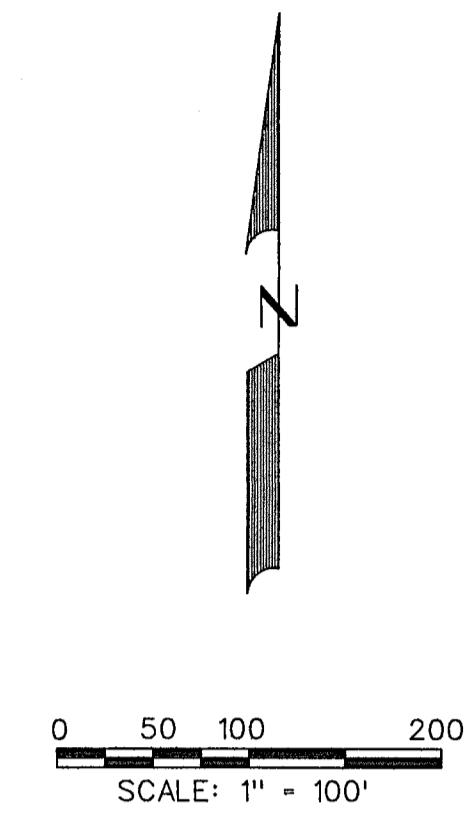


LOCATION MAP  
N.T.S.

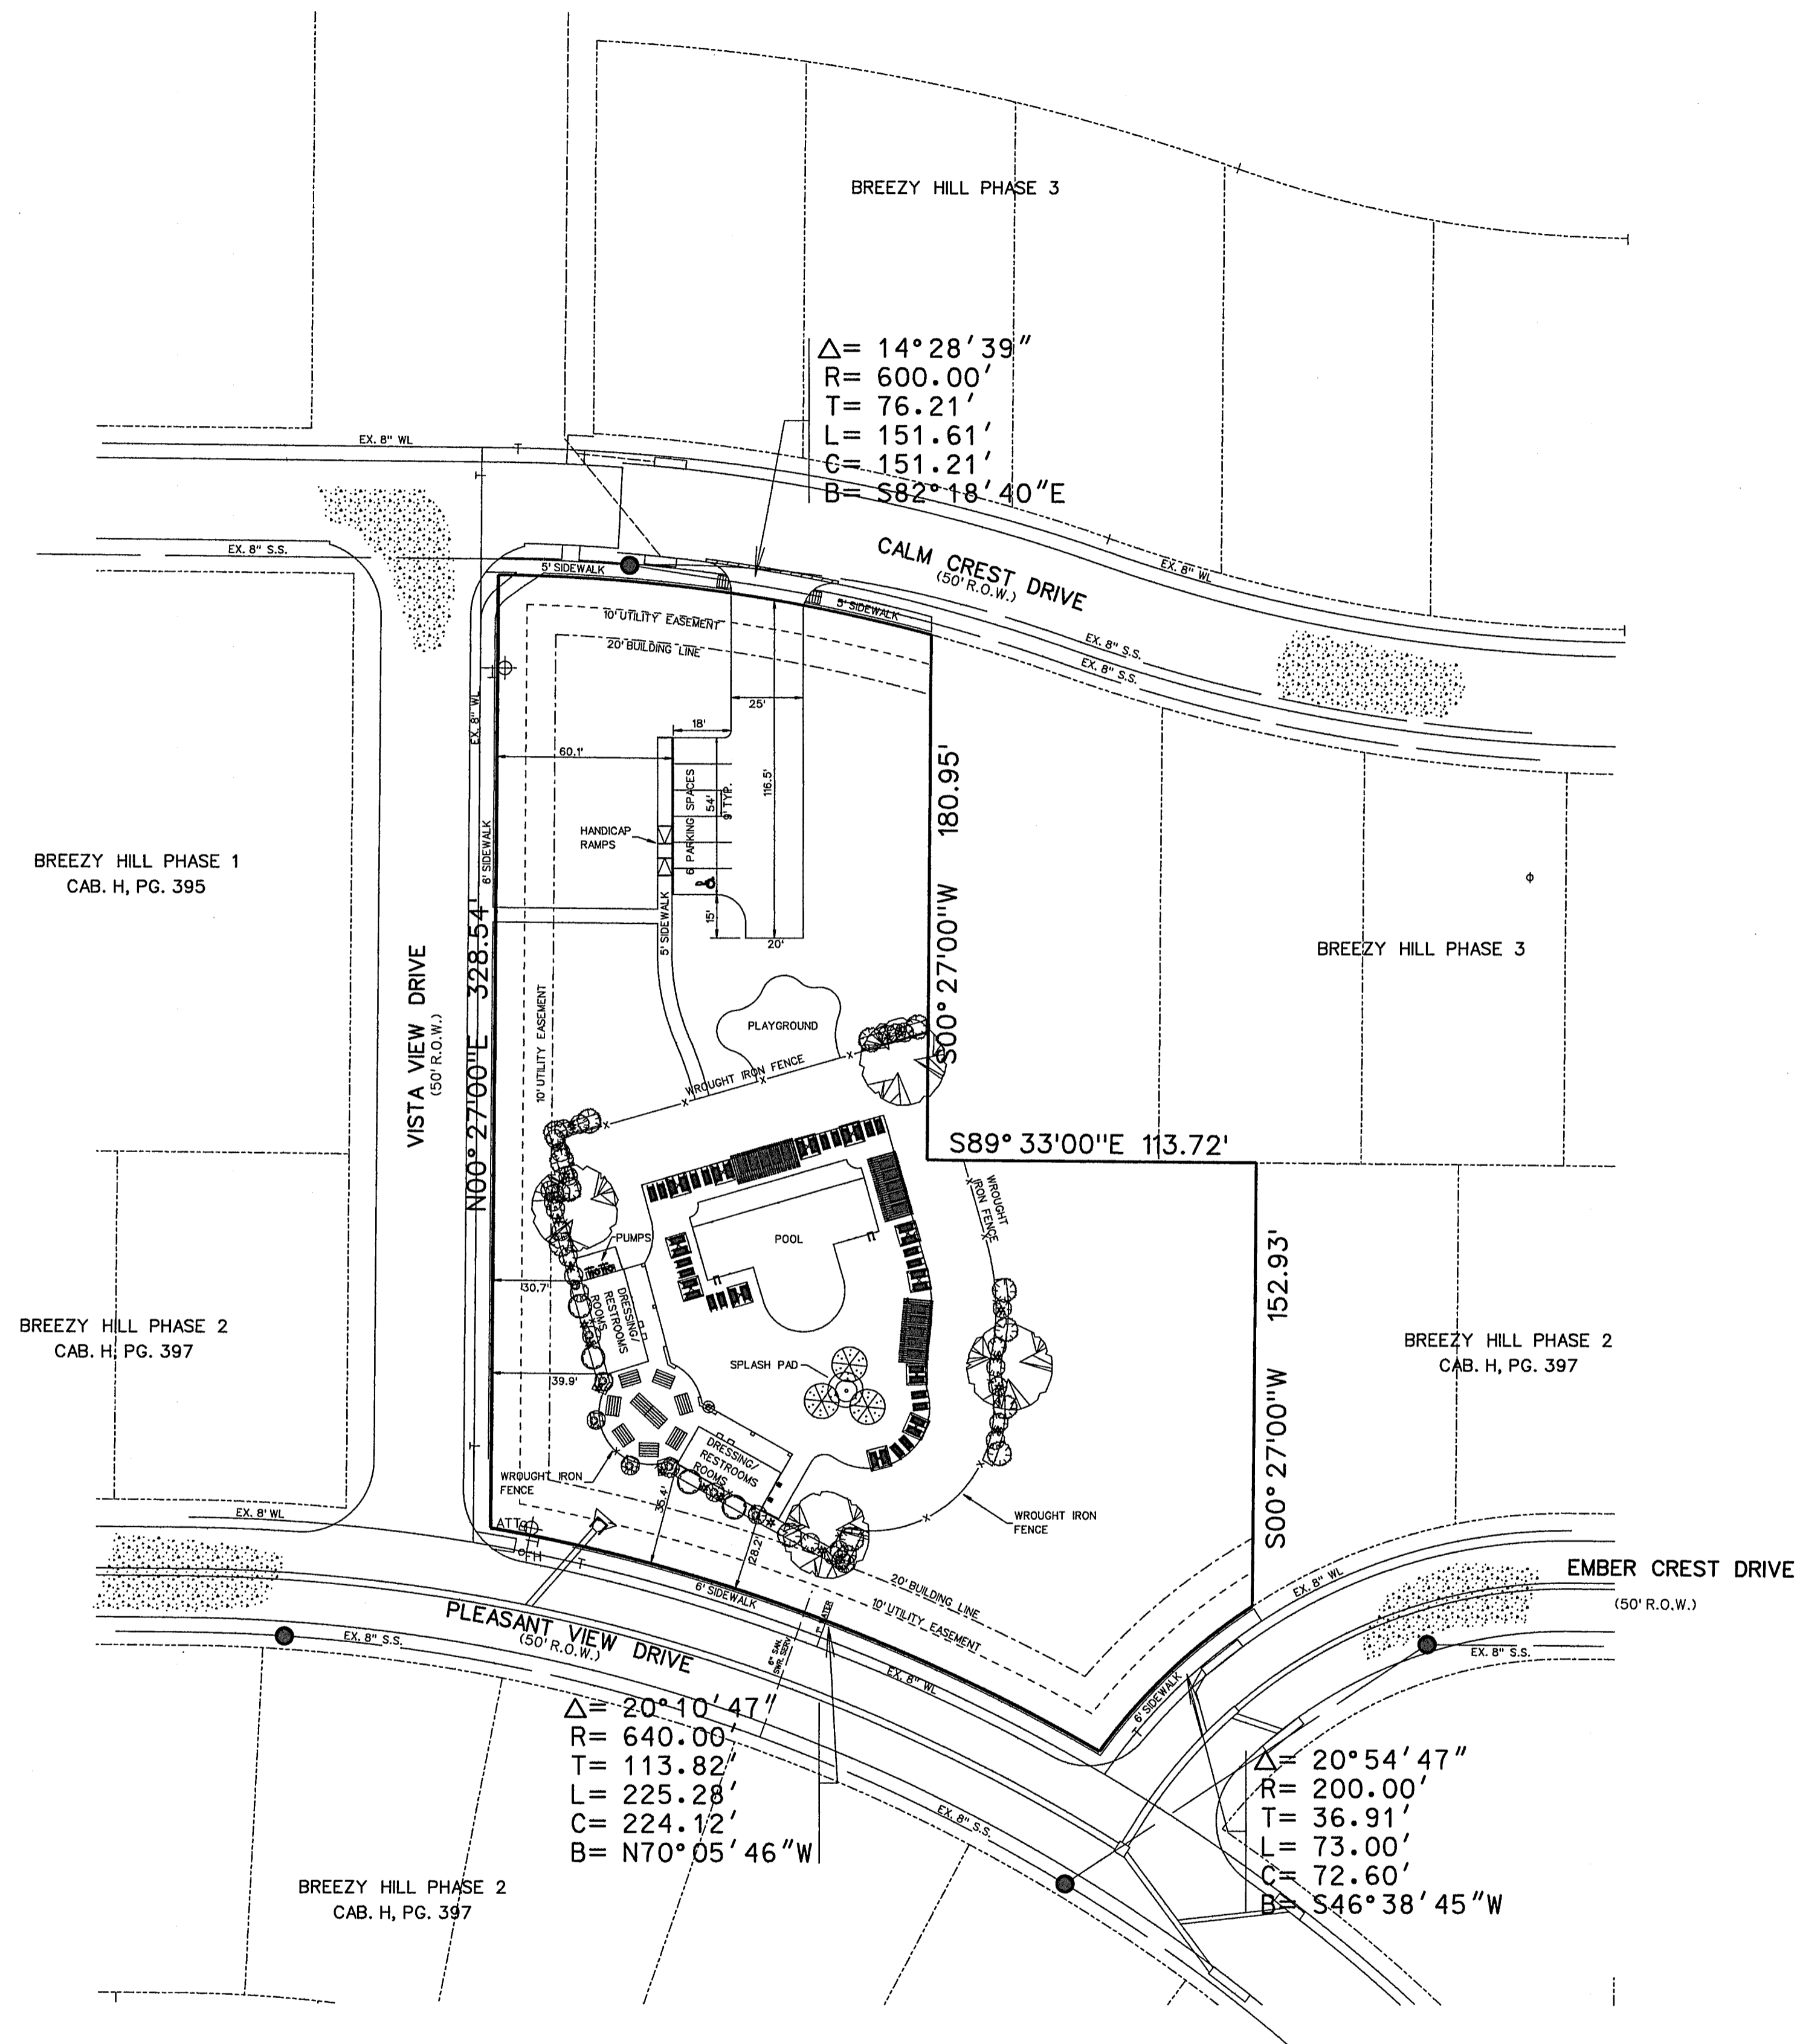

NOTE:  
ENGINEERING PLANS ARE REQUIRED  
PRIOR TO BUILDING.

SITE PLAN  
OF  
**BREEZY HILL  
AMENITY CENTER**

71 LOTS, BEING 48.250 ACRES  
SITUATED IN THE  
J. STRICKLAND SURVEY, ABSTRACT NO. 187  
IN THE

CITY OF ROCKWALL  
ROCKWALL COUNTY, TEXAS  
PREPARED BY  
CORWIN ENGINEERING, INC.

200 W. BELMONT, SUITE E  
ALLEN, TEXAS 75013  
972-396-1200

OWNER

**BH AMC, LTD**  
8214 WESTCHESTER DRIVE, SUITE 710  
DALLAS, TEXAS 75225  
214-522-4945

JANUARY 2015 SCALE 1" = 100'

AS-BUILT NOVEMBER 2016  
INFORMATION PROVIDED  
BY CONTRACTORS  
(NOT FIELD VERIFIED)

SERVICE SCHEDULE		
TYPE	SIZE	NO.
SANITARY	6"	1
WATER	1"	1
IRRIGATION	1"	1

TOTAL ACRES **1.648**

CASE NO. SP2014-032