


DEVELOPMENT PLANS FOR BREEZY HILL PHASE I CITY OF ROCKWALL, TEXAS

INDEX


1	TITLE
2	PLAT
3	DRAINAGE AREA MAP
4	DRAINAGE CALCULATIONS
5	COZY VIEW DRIVE
6	CALM CREST DRIVE
7	CALM CREST DRIVE
8	PLEASANT BLUFF DRIVE
9	WATER AND SANITARY SEWER PLAN
10	SANITARY SEWER PROFILES
11	SANITARY SEWER PROFILES
12	SANITARY SEWER PROFILES
13	BLANK SHEET
14	BLANK SHEET
15	STORM SEWER PLAN AND PROFILE LINES 'D-1' AND 'D-2'
16	DETENTION POND PLAN
16B	DETENTION POND DETAILS
17	GRADING PLAN
18	EROSION CONTROL PLAN

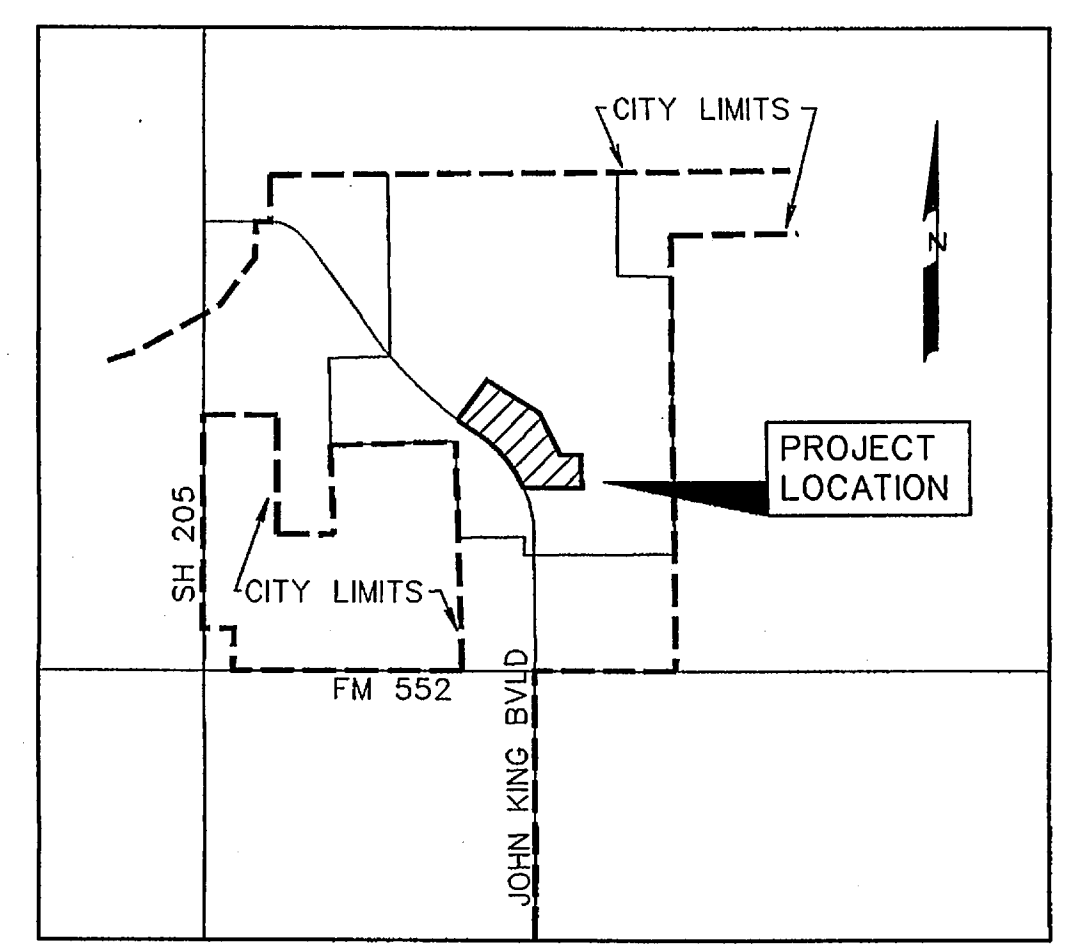

VICINITY MAP
NOT TO SCALE

PREPARED FOR
BH PHASE 1 SF, LTD.
8214 WESTCHESTER DRIVE, SUITE 710 DALLAS, TEXAS 75225

CORWIN ENGINEERING, INC. — CONSULTING ENGINEERS
200 W. BELMONT, SUITE E ALLEN, TEXAS 75013

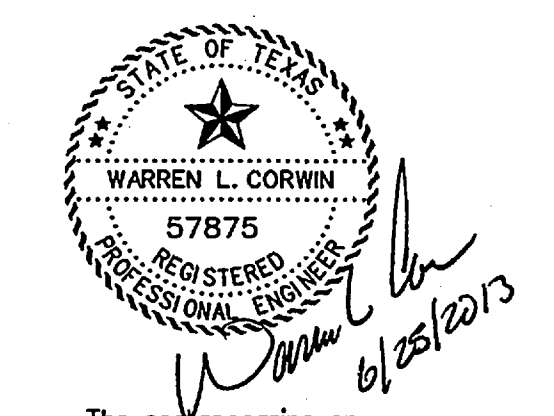

The seal appearing on this document was authorized by Warren L. Corwin, P.E. 57875, on June 25, 2013

AS-BUILT APRIL 2014
INFORMATION PROVIDED BY CONTRACTORS
(NOT FIELD VERIFIED)

NO.	COMMENTS	BY	DATE
2	COMMENTS	DS	6-6-13
1	PER CITY COMMENTS	DS	1-9-13
	REVISIONS		

NOTE:
CITY OF ROCKWALL STANDARDS
AND NCTCOG 3rd ADDITION STANDARDS
SHALL BE USED FOR REFERENCE.