

1+00.00 LINE 'S-2'  
 CONST. STD. 4" DIA.  
 INSIDE DROP M.H.  
 T. RIM = 467.00

LINE 'S-2'

F.L. 8" OUT +450.00  
 F.L. 8" IN +456.17

FL+459.17

8" S.S. @ 3.00%


FL+462.17

FL+465.17

FL+468.17

F.L. 8" OUT +471.17  
 F.L. 8" IN +471.37

6+00.00 LINE 'S-2'  
 2+30.00 LINE 'S-1'  
 0+00.00 LINE 'S-3'  
 CONST. STD. 4" DIA. M.H.  
 T. RIM = 478.90

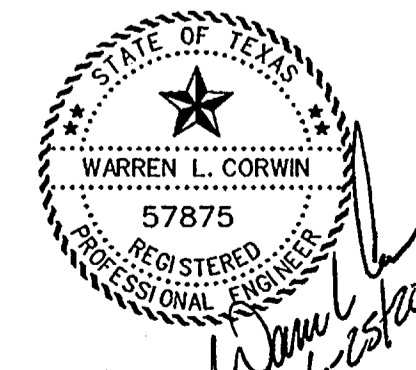

The seal appearing on this document was authorized by Warren L. Corwin, P.E. 57875, on June 25, 2013

**AS-BUILT APRIL 2014**  
 INFORMATION PROVIDED BY CONTRACTORS  
 (NOT FIELD VERIFIED)

**CORWIN ENGINEERING, INC.**  
 200 W. BELMONT, SUITE E  
 ALLEN, TEXAS 75013 (972)396-1200  
 TBPE FIRM #5951

DEVELOPMENT PLANS FOR  
**BREZY HILL**  
 PHASE I  
 ROCKWALL, TEXAS

SANITARY SEWER PROFILES

DRAWN BY	DESIGNED BY	CHECKED BY	SHEET NO. 11 of 18
JOB NUMBER 12003	DATE OCTOBER 2012	SCALE: HOR: 1"=40' VER: 1"=4'	