
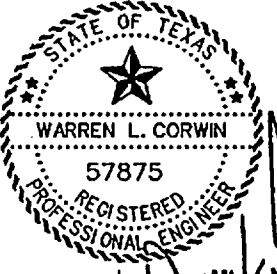


DRAINAGE AREA BASIN		
PHASE I	PHASE II	OFFSITE
155 LOTS	503 LOTS	
97 AC.	244 AC.	128 AC.

 <b>CORWIN ENGINEERING, INC.</b> 200 W. BELMONT, SUITE E ALLEN, TEXAS 75013 (972)396-1200 TBPE FIRM #5951			
DEVELOPMENT PLANS FOR <b>BREEZY HILL</b> <b>PHASE I</b> ROCKWALL, TEXAS			
LIFT STATION DRAINAGE BASIN MAP			
DRAWN BY	DESIGNED BY	CHECKED BY	SHEET NO.
JOB NUMBER	DATE	SCALE	
12003	APRIL 2013		1 OF 1

  
 The seal appearing on this document was authorized by Warren L. Corwin, P.E. 57875, on June 21, 2013.

**AS-BUILT APRIL 2014**  
 INFORMATION PROVIDED BY CONTRACTORS  
 (NOT FIELD VERIFIED)